L'EPT. OF INSPECTIONS, LICENSES AND PERMITS

1/30 COURT HOUSE DRIVE

ELLICOTT CITY, MD 21043
PÉRMITS (410) 313-2455
INSPECTIONS (410) 313-1810

AUTOMATED INFORMATION (410) 313-3800 HOWARD COUNTY FERMIT NUMBER PERMIT APPLICATION Building Address 4606 (410) 313-3800 Property Owner's Name Daven port James

Address H606 Westhill RD

City G11 cott cityState mD Zip Code 21043

Home Phone 443-630-903 Work Phone Westhill RD Ellicott City. MD 21043 Suite/Apt. #: _____ SDP/WP/Petition #:_ Applicant's Name & Mailing Address, (if other than stated herein): Census Tract Subdivision_ Nelson Flores Gaylor RD Section Area Burnie, MD 21060 ___ Parcel _ Tax Map ___ Grid Phone 301-797-2518 Fax Map Coordinates Lot Size 23, 958SF Contractor Company Marylund Deck Existing Use SFHD Contact Person Nclson Flores Proposed Use Estimated Construction Cost \$ 8.900 Address 361 Gaylor RD City Glen Rurnic State MD Zip Code 21060

License No. MHTC 126508

Phone 301-792-2518 Fax Description of Work Construct an open Deck W/ steps to grade. 20X12 3F+ H. WOOD X Install 155LF. picket Gence Occupant or Tenant Engineer or Architect Company Contact Name Contact Person_ Address Address State Zip Code State City City Phone BUILDING DESCRIPTION - COMMERCIAL BUILDING DESCRIPTION - RESIDENTIAL Building Characteristics
SF Dwelling
SF Townhouse **Building Characteristics Utilities** Utilities Water Supply: Water Supply: Height: ____Public Public <u>Depth</u> Width 1st floor: 2nd floor: Private Private No. of stories: Sewage Disposal: Sewage Disposal: Basement: Gross area, sq. ft. per floor: ____Public Public Private Finished Basement


Unfinished Basement

Crawl space

Slab on Grade


No. of Bedrooms Use group: Electric Electric Yes □ No □ Yes □ No □ Construction type:
_____ Reinforced Concrete Yes □ No □ Gas Yes □ No □ Gas Multi-family dwellings: Structural Steel Heating System: Heating System: No. of efficiency units: Oil Oil Masonry Electric Electric No. of 1 BR units: Wood Frame Natural Gas Natural Gas No. of 2 BR units: Propane Gas Propane Gas No. of 3 BR units: State Certified Modular Sprinkler system: N/A Sprinkler system: N/A _ Full Other Structure: NFPA #13D Dimensions: _ Partial NFPA #13R Footings: _ Other Suppression Other: Roof: # of Heads Tree proje State Certified Modular permit NO Manufactured Home THE UNDERSIGNED HEREBY CERTIFIES AND AGREES AS FOLLOWS: (1) THAT HE/SHE IS AUTHORIZED TO MAKE THIS APPLICATION; (2) THAT THE INFORMATION IS CORRECT; (3) THAT HE/SHE WILL COMPLY WITH ALL REGULATIONS OF HOWARD COUNTY WHICH ARE APPLICABLE THERETO; (4) THAT HE/SHE WILL PERFORM NO WORK ON THE ABOVE REFERENCED PROPERTY NOT SPECIFICALLY DESCRIBED IN THIS APPLICATION; (5) THAT HE/SHE GRANTS COUNTY OFFICIALS THE RIGHT TO ENTER ONTO THIS PROPERTY FOR THE PURPOSE OF INSPECTING THE WORK PERMITTED AND POSTING NOTICES. Nelson Applicant's Signature info@bestmdb Email Address Bu. 1 Marxland Title/Company Checks payable to: DIRECTOR OF FINANCE OF HOWARD COUNTY **PLEASE WRITE NEATLY AND LEGIBLY.**
- FOR OFFICE USE ONLY -AGENCY D Land Development, DPZ **DPZ SETBACK INFORMATION** PROPERTY ID# DATE SIGNATURE APPROVAL Filing fee State Highways Permit fee Rear: Building Officials Side: Excise tax Dev. Engineering, DPZ Side St.: Add'l per fee \$ Health 3-26-14 All minimum setbacks met? TOTAL FEES \$ Fire Protection YES D NO D Sub-total paid \$ Is Sediment Control approval required prior to issuance? Is Entrance Permit Required? Balance due YES D NO D YES D NO D Check Historic District? Validation YES | NO | CONTINGENCY CONSTRUCTION START:

□ Lot Coverage for New Town Zone Accepted by_ ONE STOP SHOP: □ SDP/Red-line approval date Distribution of Copies White: Building Officials Green: LDD, DPZ Yellow: DED, DPZ Pink: Health Gold: SHA T:\Operations\Updated forms

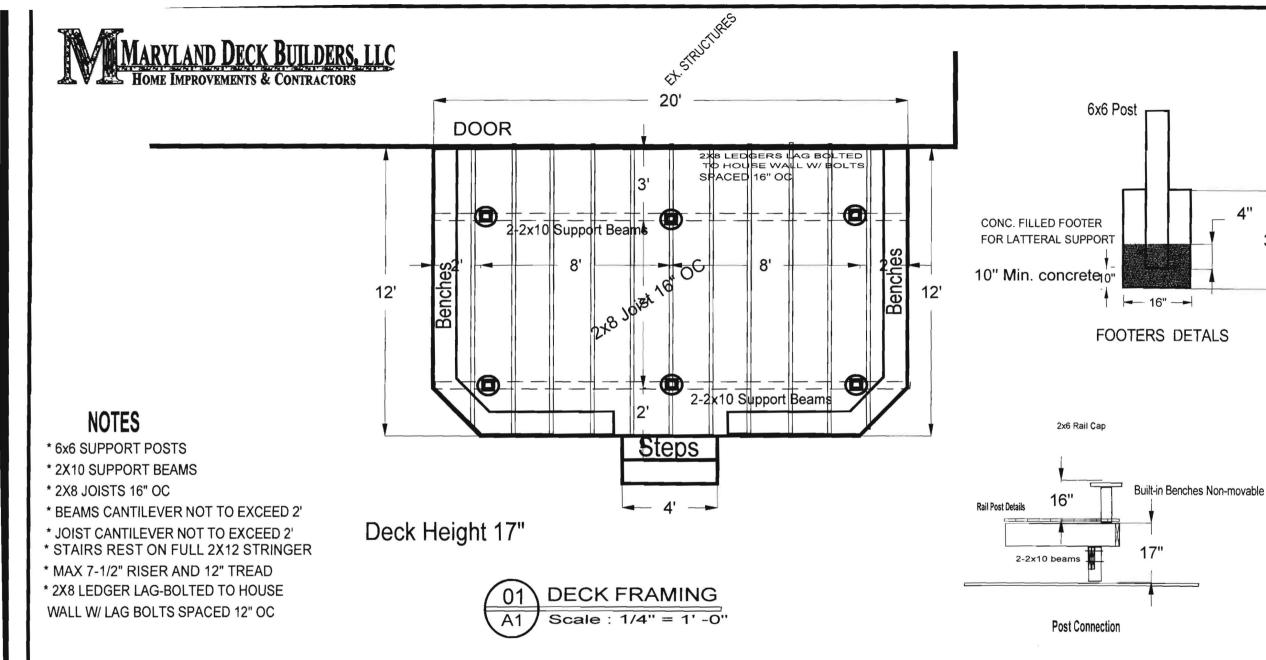

30"

	CUSTOMER'S INFORMATION	CONTRACTOR	DRAWN BY	COUNTY	SCALE	DATE	DRAWING
-	DAVENPORT JAMES 4606 Westhill Rd Ellicott City, MD 21043	MARYLAND DECK BUILDERS, LLC MHIC LIC. 126508	Mr. Flores	Howard Co.	1/4"=1' 0"	03/17/2014	A1

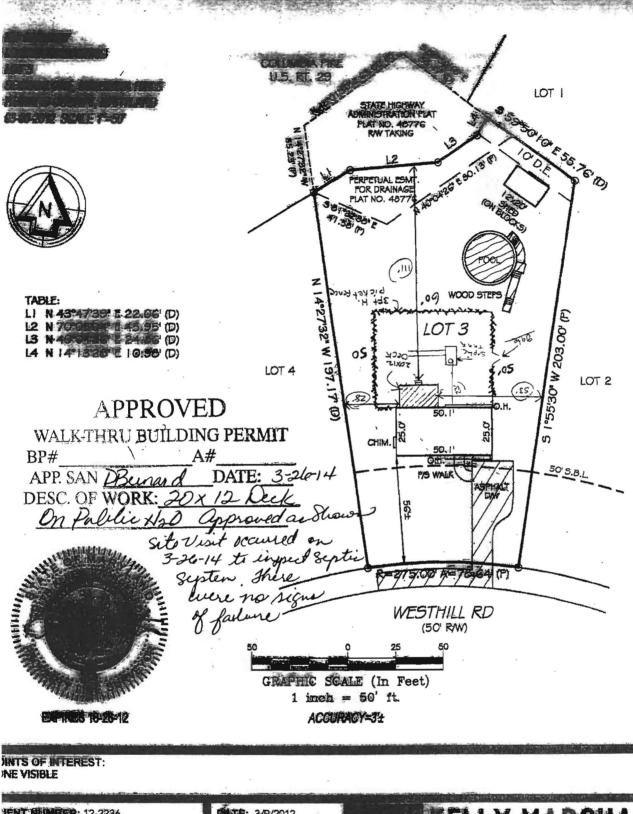

INTS OF INTEREST:

JENT NUMBER: 12-2236

DATE: 3/9/2012

MER. JAMES DAVENPORT

LLER: BONNIE MARIE TREY

ORT; TITLE RITE SERVICES, INC.; NAVY FEDERAL

KELLY MARSHALL

WAN THE SHALL WOOD TEAM FOR REVIEW

EXACTA

LB#21535