



Building Permit Application

Howard County Maryland
Department of Inspections, Licenses and Permits
3430 Court House Drive
Permits: 410-313-2455
www.howardcountymd.gov

Date Received: 7-22-14

Permit No.: B14002524

Building Address: <u>4501 RUTHERFORD WAY</u> City: <u>DAYTON</u> State: <u>MD</u> Zip Code: <u>21036</u> Suite/Apt. #: _____ SDP/WP/BA #: _____ Census Tract: _____ Subdivision: _____ Section: _____ Area: _____ Lot: <u>1</u> Tax Map: <u>0028</u> Parcel: <u>0075</u> Grid: <u>0002</u> Zoning: _____ Map Coordinates: _____ Lot Size: <u>4.22 AC</u>		Property Owner's Name: <u>JOHN GUYER</u> Address: <u>4501 RUTHERFORD WAY</u> City: <u>DAYTON</u> State: <u>MD</u> Zip Code: <u>21036</u> Phone: <u>410-531-9277</u> Fax: _____ Email: _____	
Existing Use: <u>SFD</u> Proposed Use: <u>SFD WITH SOLAR</u> Estimated Construction Cost: \$ <u>51,000.00</u> Description of Work: <u>INSTALL 51 SOLAR PANELS, 13.005 KW</u>		Applicant's Name & Mailing Address, (If other than stated herein) Applicant's Name: <u>SOLAR ENERGY WORLD/JEFF PROVINI</u> Address: <u>5681 MAIN ST.</u> City: <u>GLADDOCK</u> State: <u>MD</u> Zip Code: <u>21075</u> Phone: <u>443-616-1388</u> Fax: _____ Email: <u>JPROVINI@SOLAREWORLD.COM</u>	
Occupant or Tenant: _____ Was tenant space previously occupied? ☐ Yes ☐ No Contact Name: _____ Address: _____ City: _____ State: _____ Zip Code: _____ Phone: _____ Fax: _____ Email: _____		Contractor Company: <u>SOLAR ENERGY WORLD</u> Contact Person: <u>JEFF MURKIN</u> Address: <u>5681 MAIN ST.</u> City: <u>GLADDOCK</u> State: <u>MD</u> Zip Code: <u>21075</u> License No.: <u>127353</u> Phone: <u>410-575-2009</u> Fax: _____ Email: _____	
Engineer/Architect Company: _____ Responsible Design Prof.: _____ Address: _____ City: _____ State: _____ Zip Code: _____ Phone: _____ Fax: _____ Email: _____		Utilities <u>Water Supply</u> ☐ Public ☒ Private <u>Sewage Disposal</u> ☐ Public ☒ Private Electric: ☐ Yes ☐ No Gas: ☐ Yes ☐ No <u>Heating System</u> ☐ Electric ☐ Oil ☐ Natural Gas ☐ Propane Gas ☐ Other: _____ <u>Sprinkler System:</u> ☐ Yes ☐ No Grading Permit Number: _____ Building Shell Permit Number: _____	

Commercial Building Characteristics	Residential Building Characteristics
Height: _____	☒ SF Dwelling ☐ SF Townhouse
No. of stories: _____	Depth _____ Width _____
Gross area, sq. ft./floor: _____	1 st floor: _____
Area of construction (sq. ft.): _____	2 nd floor: _____
Use group: _____	Basement: _____
Construction type: _____	☐ Finished Basement
☐ Reinforced Concrete	☐ Unfinished Basement
☐ Structural Steel	☐ Crawl Space
☐ Masonry	☐ Slab on Grade
☐ Wood Frame	No. of Bedrooms: _____
☐ State Certified Modular	Multi-family Dwelling
	No. of efficiency units: _____
	No. of 1 BR units: _____
	No. of 2 BR units: _____
	No. of 3 BR units: _____
	Other Structure: _____
	Dimensions: _____
☒ Roadside Tree Project Permit	Footings: _____
☐ Yes ☒ No	Roof: _____
Roadside Tree Project Permit # _____	☐ State Certified Modular
	☐ Manufactured Home

THE UNDERSIGNED HEREBY CERTIFIES AND AGREES AS FOLLOWS: (1) THAT HE/SHE IS AUTHORIZED TO MAKE THIS APPLICATION; (2) THAT THE INFORMATION IS CORRECT; (3) THAT HE/SHE WILL COMPLY WITH ALL REGULATIONS OF HOWARD COUNTY WHICH ARE APPLICABLE THERETO; (4) THAT HE/SHE WILL PERFORM NO WORK ON THE ABOVE REFERENCED PROPERTY NOT SPECIFICALLY DESCRIBED IN THIS APPLICATION; (5) THAT HE/SHE GRANTS COUNTY OFFICIALS THE RIGHT TO ENTER ONTO THIS PROPERTY FOR THE PURPOSE OF INSPECTING THE WORK PERMITTED AND POSTING NOTICES.

Applicant's Signature: JEFF PROVINI
 Email Address: JPROVINI@SOLAREWORLD.COM
 Title/Company: SOLAR ENERGY WORLD

Print Name: JEFFREY J. PROVINI JR
 Date: 7-18-14

Checks Payable to: DIRECTOR OF FINANCE OF HOWARD COUNTY

PLEASE WRITE NEATLY & LEGIBLY

FOR OFFICE USE ONLY

AGENCY	DATE	SIGNATURE OF APPROVAL
State Highways		
Building Officials		
PSZA (Zoning)		
PSZA (Engineering)		
Health	8/16/14	R/10

Is Sediment Control approval required for issuance? ☐ Yes ☐ No
☐ CONTINGENCY CONSTRUCTION START

DPZ SETBACK INFORMATION
Front: _____
Rear: _____
Side: _____
Side St.: _____
All minimum setbacks met? ☐ Yes ☐ No
Is Entrance Permit Required? ☐ Yes ☐ No
Historic District? ☐ Yes ☐ No
Lot Coverage for New Town Zone: _____
SDP/Red-line approval date: _____

Filing Fee	\$
Permit Fee	\$
Tech Fee	\$
Excise Tax	\$
PSFS	\$
Guaranty Fund	\$
Add'l per Fee	\$
Total Fees	\$
Sub-Total Paid	\$
Balance Due	\$
Check #	11512

Distribution of Copies: White: Building Officials

Green: PSZA,Zoning

Yellow: PSZA,Engineering

Pink: Health

Gold: SHA

T:\Operations\Updated Forms\Building appimp 8.2012.docx



SolarEnergyWorld
Tomorrow's Energy Today
Solar Energy World LLC.
5681 Main Street
Elkridge, MD 21075
(888) 497-3233

Project Name and Address

Guyer Residence
4501 Rutherford Way
Dayton, MD 21036
13.005 kW

Drawn by

MUA

Date


14-JUL-2014

Scale

1" = 80'

Sheet

01

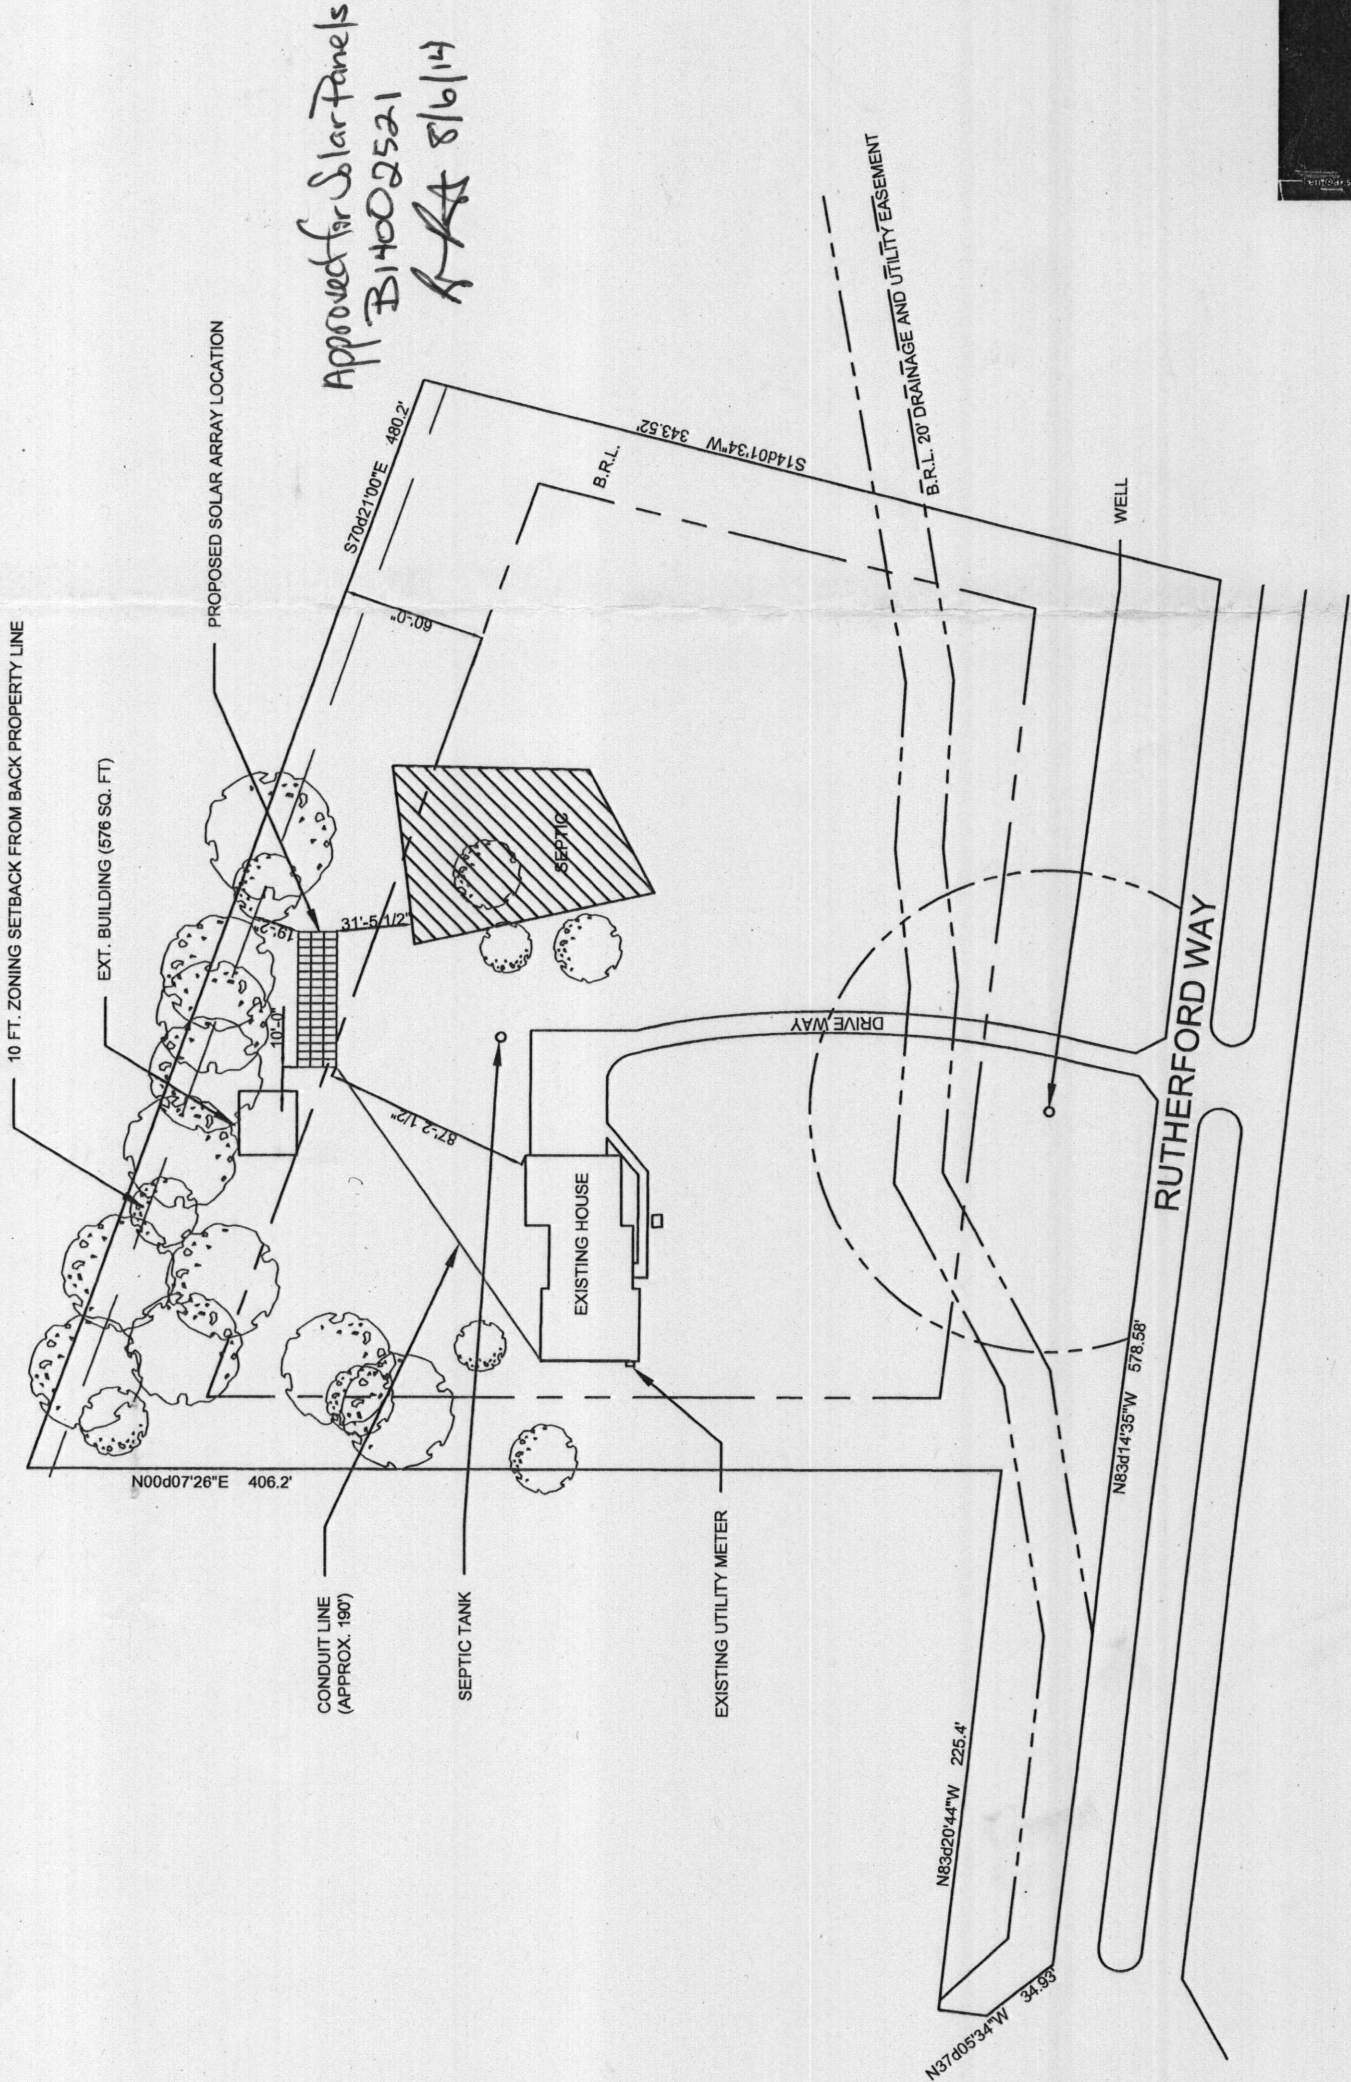

PROPOSED ADDITIONAL ARRAY LOCATION



SITE PLAN

NOTES:

1. THIS DRAWING IS TO PROVIDE REFERENCE FOR THE INSTALLATION OF GROUND MOUNT PHOTOVOLTAIC ARRAYS.
2. THE SYSTEM SHALL INCLUDE 51 CANADIAN SOLAR 255W MODULES (DIMENSIONS: 84.5 (L) x 38.7(W) x 1.57 (D)) AND WEIGHING 41.9LBS (PANEL DEAD LOAD = 2.41 PSF).
3. PROPOSED SOLAR ARRAY LOCATION PLACED IN ACCORDANCE WITH HOWARD COUNTY ZONING REGULATIONS SECTION 105.0 AND 128.0 A-12.