

Sheppard Manor
lots 8&9

COUNTY #

SOIL PROFILE
633

org red
brn
1m

tan brn
50 mi
1m
10-15%
frags

635


orge
brn
red
hv 1/4 m
to 1 m

brn tan
sa mica
to am
10% frags
pockets
at 25%

635A/637

DEGE brn
hvysalm 636

brn
pink
tan
sa mi 1m
10-15%
frags

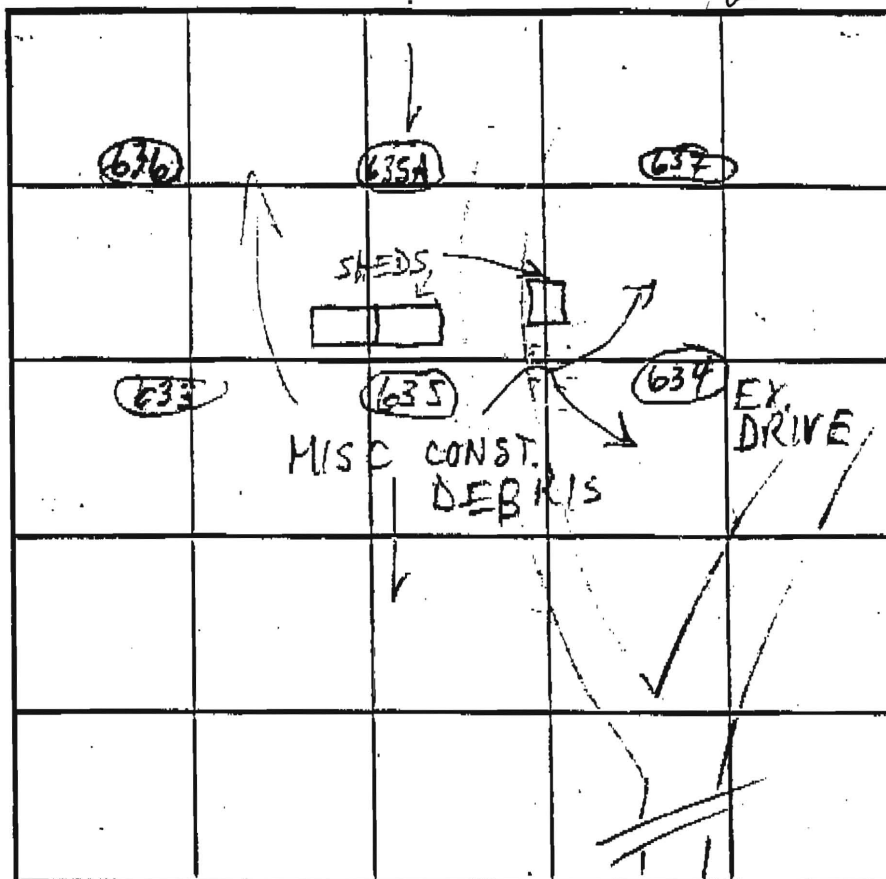

SOIL PROFILE
634

0' hv orge
brn 1m

3 1/2' tan brn
hv mi
1m

6-9' tan brn
mi salm
5-10%
frags

14'

INDICATE NORTH - NAME ADJOINING ROADWAY AS BASE LINE.

SHEPPARD LA

DATE	TEST NO.	DEPTH	PRE-WET		TEST - 1" DROP		TIME
			START	STOP	START	STOP	
5/30/03	633 ✓	13	OK				
	635 ✓	12' 4"	11:22	11:29	11:29	11:37	8
	637 ✓	12	11:44	11:42	11:42	11:50	2
	634 ✓	14	OK				
	636 ✓	12 1/2	OK				
	635A ✓	12	11:30 11:35:30	11:37:00	11:37:00	11:39:30	FAST 2

REMARKS

TYPE OF SOIL

TESTED BY M. Reikin

ALSO PRESENT Hatfield's

TRENCH DESIGN DATA: AVERAGE PERCOLATION TIME

TRENCH WIDTH

INLET DEPTH

MAXIMUM BOTTOM DEPTH

SQ. FT./BEDROOM

Signed per att

CHB2

365°55'14"E 1218 ⁴⁶⁰

LOT 8
44,316sf±

47,320sf + 9

10-17-13-10

G1 D2

LOT 14
49.814sf±

LOT 13
49,650sf+

LOT 12
47,980sqft

LOT 11650

NON-

723 MgC3

40-44
MaB2

GEORGE AND JAN

HUGH AND RUTH

GREGORY

Ex. Well 100' R

PARCEL 51 LOT