

MARYLAND DEPARTMENT OF THE ENVIRONMENT, WATER MANAGEMENT ADMINISTRATION
2500 BROENING HIGHWAY, BALTIMORE, MARYLAND 21224, (410) 631-3784

WATER WELL ABANDONMENT-SEALING REPORT FORM

SUBMIT COPIES OF COMPLETED FORM TO:

- * COUNTY ENVIRONMENT AGENCY (contact MDE, WMA if address needed)
- * WELL OWNER
- * MDE, WATER MANAGEMENT ADMINISTRATION, WELL PROGRAM

DATE WELL ABANDONED: 7-16-01 (month/day/year)

* PERMIT NUMBER OF ABANDONED WELL (if any) _____


* PERMIT NUMBER OF REPLACEMENT WELL _____

* PERSON ABANDONING WELL: George Eastarday WELL DRILLERS LICENSE NUMBER: 040
CIRCLE: MWD/MSD/MGD

* OWNER'S NAME: Winchester Homes

SITE LOCATION MAP

* WELL LOCATION:
COUNTY: Howard
NEAREST TOWN: FULTON
TAX MAP _____ BLOCK _____ PARCEL _____
SUBDIVISION: CHERRY TREE PARK
SECTION: _____ LOT: _____
NEAREST ROAD: 11149 Scaggsville Rd

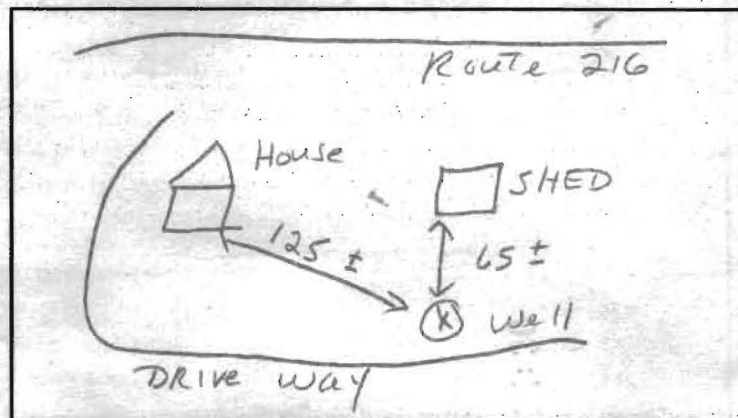

* TYPE OF WELL BEING ABANDONED:

_____ DRILLED _____ JETTED
_____ BORED/AUGERED ☒ HAND DUG
_____ OTHER (specify) _____

* USE CODE:

☒ DOMESTIC _____ MUNICIPAL/PUBLIC
_____ IRRIGATION _____ INDUSTRIAL
_____ TEST/OBSERVATION _____ GEOTHERMAL

* TYPE OF CASING:

_____ STEEL _____ PLASTIC
☒ CONCRETE _____ OTHER (specify) _____

* SIZE OF CASING: 42 INCHES IN DIAMETER

* DEPTH OF WELL: 50 FEET DEEP

* WAS ANY CASING REMOVED? _____ YES ☒ NO
if yes, length removed, in feet: _____

* WAS CASING RIPPED OR PERFORATED? _____ YES ☒ NO

LOG OF SEALING MATERIAL

MATERIAL	FEET	
	FROM	TO
Cement	50	20
DIRT (TO BE FILLED)	20	17
TO BE EXCAVATED OUT	17	0
VOLUME OF MATERIAL USED		
6 yards		

SIGNATURE-MASTER WELL DRILLER OR SUPERVISING SANITARIAN

LICENSE #

CIRCLE ONE

DATE