
3430 COURT HOUSE DRIVE ELLICOTT CITY, MD 21043 PERMITS (410) 313-2455 INSPECTIONS (410) 313-1810 AUTOMATED INFORMATION (410) 313-3800

HOWARD COUNTY PERMIT APPLICATION

151/00303 PERMIT NUMBER

Building Address 3560 CLARKS TILE M	TREADELPHIA HILL R	Property Owner's Name Address	A Z. AFRA, ATE
		City State	Zip Code
Suite/Apt. #: SI	OP/WP/Petition #:	Home Phone	Work Phonedress, (if other than stated herein):
Census Tract	Subdivision	— Applicant's Name & Manning Aut	ness, (if other than stated herein).
Section	Area Lot		
Tax Map Parce	el Grid	Phone Fax	
Zoning Map Coord	dinates Lot Size		
Existing Use			The state of the s
Proposed Use	\$	Address_	VK n was f
Estillated Construction Cost	Φ	City State	Zip Code
Description of Work INST	allaloso GALLON US	License No	
Occupant or Tenant		Engineer or Architect Company_	
Contact Name		Contact Person	
Address		Address	
CityState	eZip Code	CityState	Zip Code
Phone Fa	x	Phone Fax	
	CRIPTION – <u>COMMERCIAL</u>		PTION - RESIDENTIAL
Building Characteristics Height:	Water Supply:	Building Characteristics SF Dwelling □ SF Townhouse □	Water Supply:
L _{qt} .	Public	Depth 1st floor:	Public Private
No. of stories:	Private Sewage Disposal:	2 nd floor:	Sewage Disposal:
Gross area, sq. ft. per floor:	Public Private	Basement:	Public Private
Use group:	riivate	Finished Basement Unfinished Basement C	
Construction type:	Electric Yes □ No □ Gas Yes □ No □	space □ Slab on Grade □ No. of Bedrooms	Electric Yes \square No \square Gas Yes \square No \square
Reinforced Concrete	Gas Tes I NO I		
Structural Steel	Heating System: Electric □ Oil □	Multi-family dwellings: No. of efficiency units:	Heating System: Electric □ Oil □
Masonry Wood Frame	Natural Gas	No. of 1 BR units:	Natural Gas □
State Certified Modular	Propane Gas	No. of 2 BR units: No. of 3 BR units:	Propane Gas
State Certified Woddian	Sprinkler system: N/A □	Other Structure:	Sprinkler system: N/A □
	Full Partial	Dimensions:	NFPA #13D NFPA #13R
	Other Suppression	Footings:	Other:
	# of Heads	Roof:	
		State Certified Modular Manufactured Home	
CORRECT; (3) THAT HE/SHE WILL ON THE ABOVE REFERENCED PRO	COMPLY WITH ALL REGULATIONS OF HO	THAT HE/SHE IS AUTHORIZED TO MAKE THIS AP WARD COUNTY WHICH ARE APPLICABLE THERETO THIS APPLICATION; (5) THAT HE/SHE GRANTS COU	O; (4) THAT HE/SHE WILL PERFORM NO WORK
A A		En A. m.	2 × 11/
Applicant's Signature		Print Name	7 1 1 1 1 2 1 2 1 1 1 5
TO WELL THOU AND	117		
Title/Company		Date	C. Carrier (Section 4)
		CTOR OF FINANCE OF HOWARD COUNTY	
		RITE NEATLY AND LEGIBLY.** FOR OFFICE USE ONLY -	
AGENCY DATE Land Development, DPZ	SIGNATURE APPROVAL	DPZ SETBACK INFORMATION	Filing fee \$ PROPERTY ID #
		Front:	
State Highways	<u>and the state of </u>	Rear:	Permit fee \$
Building Officials	a description of the second	Side:	Excise tax \$
Dev. Engineering, DPZ		Side St.:	Add'l per fee \$
Health 10-21-11	Heid Sout	All minimum setbacks met?	TOTAL FEES \$
Fire Protection		YES D NO D	Sub-total paid \$
Is Sediment Control approval rec	juired prior to issuance?	Is Entrance Permit Required?	Balance due \$
YES 🗆 NO 🗆		YES □ NO □ Historic District?	Check # ////
		YES D NO D	
CONTINGENCY ONE STOP	CONSTRUCTION START: □	Lot Coverage for New Town Zone SDP/Red-line approval date	Accepted by
	s - White: Building Officials		Pink: Health Gold: SHA

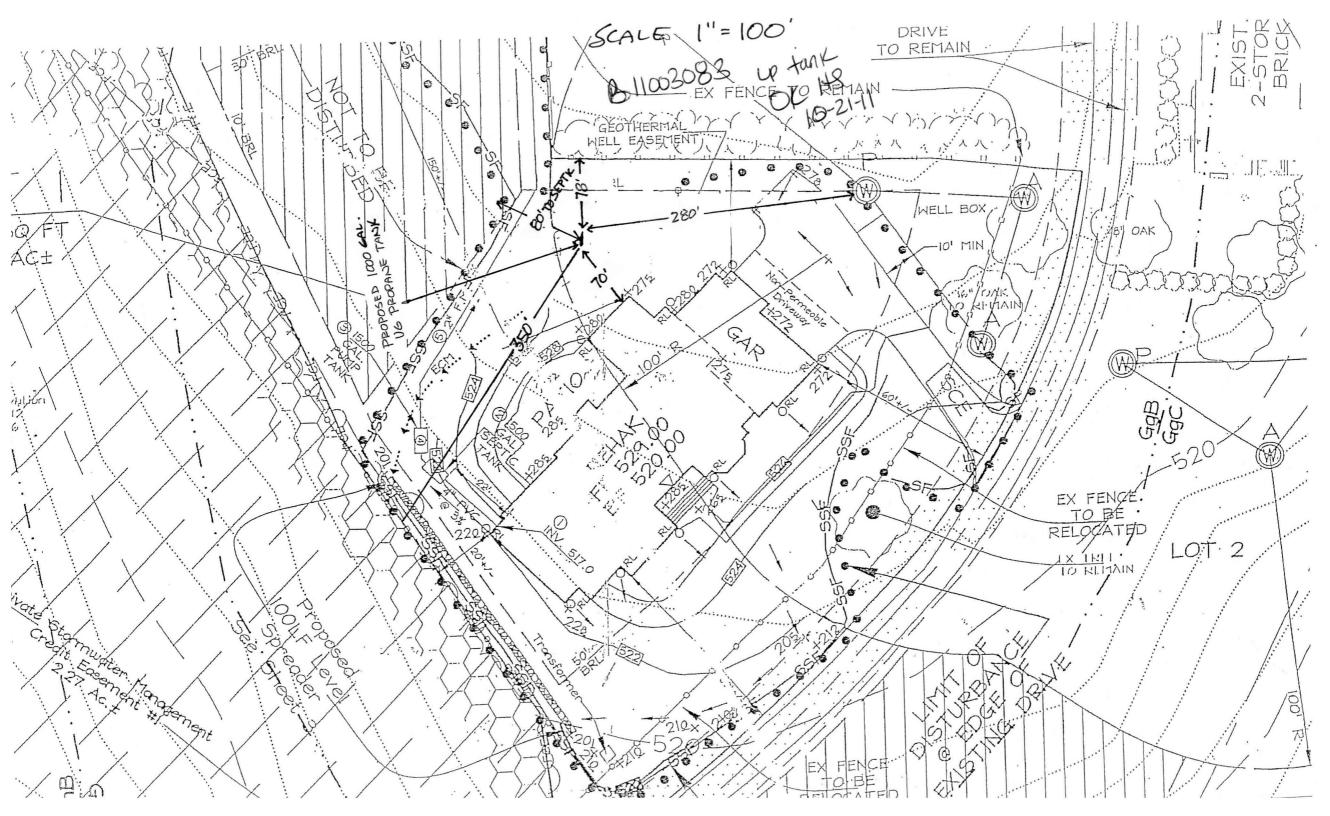

DEPT, OF INSPECTIONS, LICENSES AND PERMITS PERMIT NUMBER HOWARD COUNTY 3430 COURT HOUSE DRIVE PERMIT APPLICATION ELLICOTT CITY, MD 21043 D10003807 PERMITS (410) 313-2455 INSPECTIONS (410) 313-1810 AUTOMATED INFORMATION (410) 313-3800 Property Owner's Name Louis Rehak
Address 13779 Lakeside Dr
City Clarksville State MD
Home Phone 301802,050 Work Phone Trindelphia Mill Road Building Address 13360 Clarksville MD 21029 SDP/WP/Petition #: Applicant's Name & Mailing Address, (if other than stated herein):

Ben Harrison: 6466 roup Lto Subdivision Census Tract Nursery Rd Area Section Westminster MD 21167 Grid Parcel_ Tax Map Fax 410 840 9211 Phone 410 840 0800 Map Coordinates Lot Size Zoning Contractor Company Syc Group Ltd Existing Use None Contact Person Mark Koski Proposed Use 5FD Address GII Nursery Rd City Westminster State MD Estimated Construction Cost \$ 1,190,000 - 60 Description of Work Construct Custom SFD 4Bed 4 Borth, 2-12 Borth, 3 Floor Elevator, 6 FP. 2 Story License No. 125 Engineer or Architect Company Peter W Ratelitte Occupant or Tenant Contact Person Peter Ratel: He Contact Name_ Address 10404 Stevenson Address City Shevenson State MO Zip Code 21153 Zip Code_ State City_ Fax 410 484 Phone 410 484 7010 Fax Phone BUILDING DESCRIPTION - RESIDENTIAL BUILDING DESCRIPTION - COMMERCIAL **Utilities** Building Characteristics ing ✓ SF Townhouse □ Utilities **Building Characteristics** Water Supply: SF Dwelling M Water Supply: Height: Public Private Width Depth 1st floor: Public 1" floor: 2nd floor: 44' ×96' Basement: 63 ×115 Private No. of stories: Sewage Disposal: Sewage Disposal: Public Public Gross area, sq. ft. per floor: Private Finished Basement
Unfinished Basement Crawl space
Slab on Grade
No. of Bedrooms Private Yes No 🗆 Use group: Electric Yes □ No □ Electric Yes 🗆 No 🗷 Yes □ No □ Construction type: Gas Reinforced Concrete Multi-family dwellings: Heating System: Electric Heating System: Structural Steel No. of efficiency units: Oil Masonry No. of 1 BR units: Natural Gas Natural Gas Wood Frame No. of 2 BR units: Propane Gas Propane Gas No. of 3 BR units: State Certified Modular Sprinkler system: N/A Sprinkler system: N/A □ Other Structure: NFPA #13D Dimensions: NFPA #13R Partial Footings: Other: Other Suppression Roof: # of Heads State Certified Modular Manufactured Home THE UNDERSIGNED HEREBY CERTIFIES AND AGREES AS FOLLOWS: (1) THAT HE/SHE IS AUTHORIZED TO MAKE THIS APPLICATION; (2) THAT THE INFORMATION IS CORRECT; (3) THAT HE/SHE WILL COMPLY WITH ALL REGULATIONS OF HOWARD COUNTY WHICH ARE APPLICABLE THERETO; (4) THAT HE/SHE WILL PERFORM NO WORK ON THE ABOVE REFERENCED PROPERTY NOT SPECIFICALLY DESCRIBED IN THIS APPLICATION; (5) THAT HE/SHE GRANTS COUNTY OFFICIALS THE RIGHT TO ENTER ONTO THIS PROPERTY FOR THE PURPOSE OF INSPECTING THE WORK PERMITTED AND POSTING NOTICES. Ben Harrison Print Name Applicant's Signature Email Address SYC Group Ltd Date Title/Company Checks payable to: DIRECTOR OF FINANCE OF HOWARD COUNTY **PLEASE WRITE NEATLY AND LEGIBLY.**
- FOR OFFICE USE ONLY -PROPERTY ID # **DPZ SETBACK INFORMATION** SIGNATURE APPROVAL Filing fee Permit fee Rear: State Highways Side: **Building Officials** Add'l per fee \$ Side St.: Dev. Engineering, DPZ TOTAL FEES \$_ All minimum setbacks met? Health Sub-total paid \$ YES D NO D Balance due Is Entrance Permit Required? Is Sediment Control approval required prior to issuance? 21856 YES 🗆 NO 🗆 YES Y

> CONTINGENCY CONSTRUCTION START: ONE STOP SHOP:

NO 🗆

Distribution of Copies

White: Building Officials

Green: LDD, DPZ

Historic District? YES □ NO □

Lot Coverage for New Town Zone

SDP/Red-line approval date


Yellow: DED, DPZ

Pink: Health

Validation

Gold: SHA

Accepted by

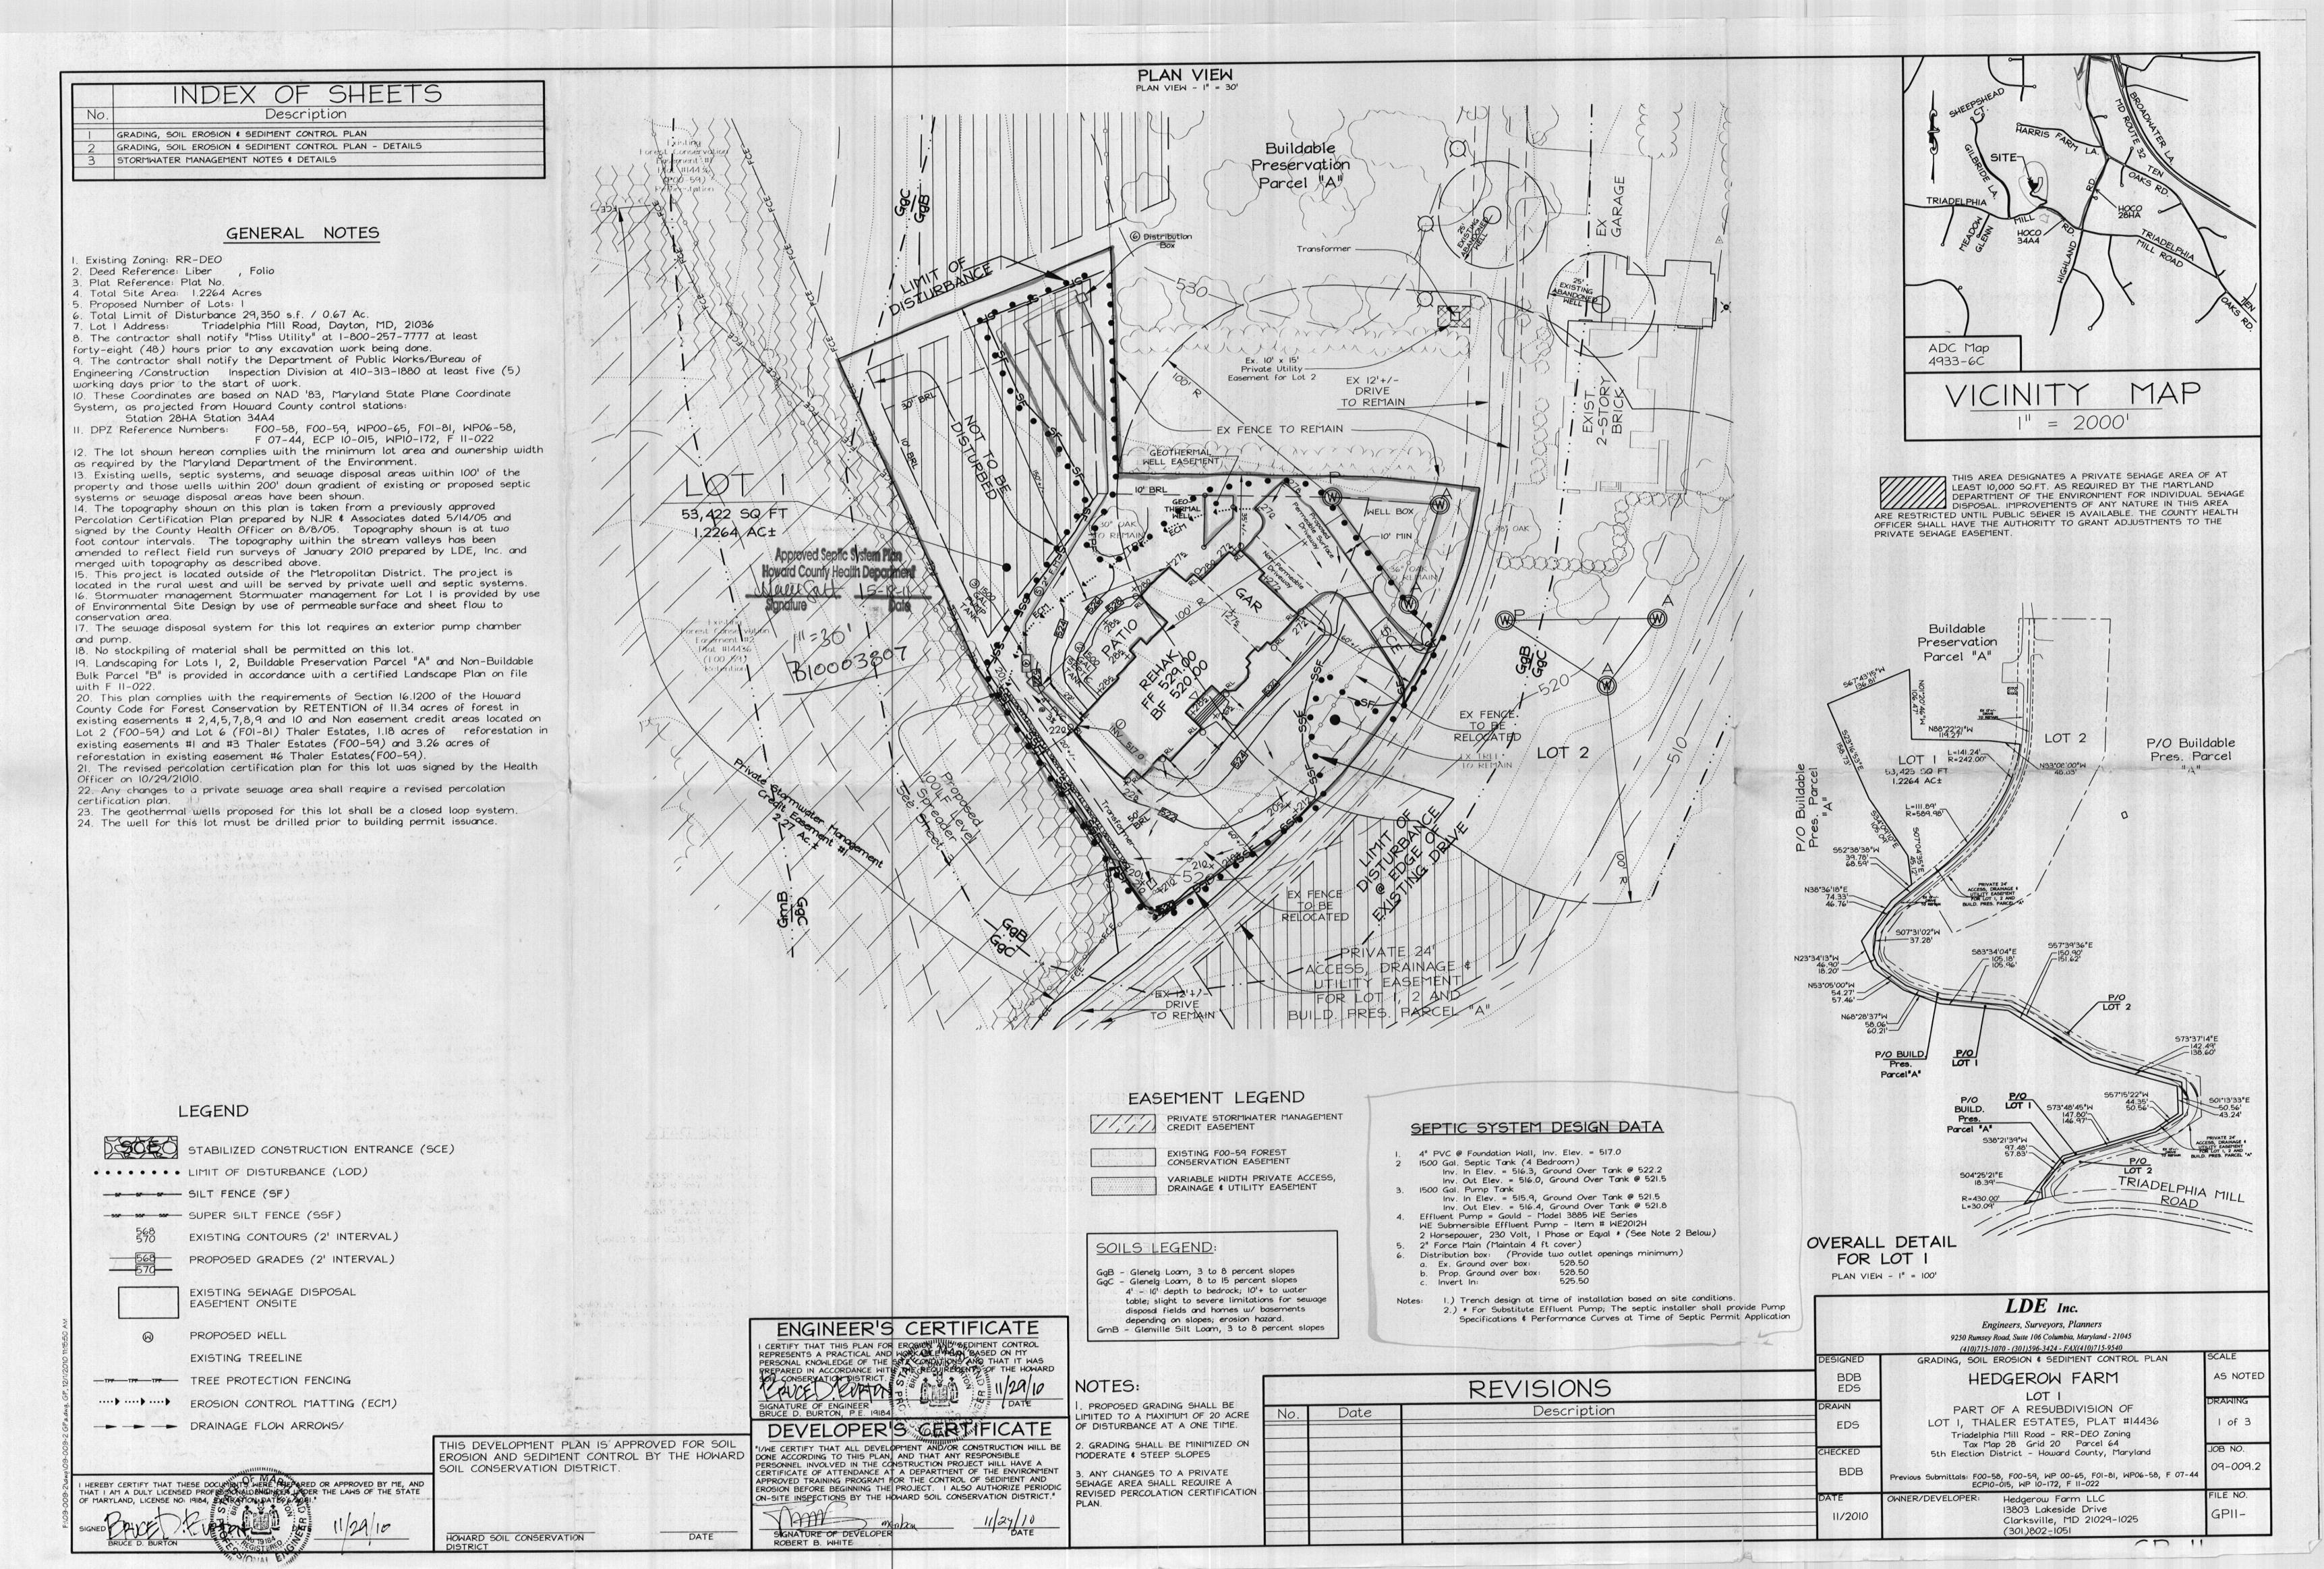



FRONT ELEVATION

REHAK RESIDENC

REHAK RESIDENCE - PLAN VIEW SCALE I" =20'

INSPECTION CHART FOR PERMEABLE SURFACES

	Engineer's Approval	
STAGE	Initials	Date
1. Inspection of excavation to subgrade. Surrounding site shall be stabilized.		
 Inspection during placement and backfill of the drainage distribution system. (See Appendix B.4.) 		
 Inspection during placement of subbase material. Aggregate shall be clean, washed and free of fines with a porosity (n) of 30%. Material shall be placed in lifts and lightly rolled according to the specifications (See Appendix B.4.) 		
 Inspection during placement of surface material conforming to specifications found in Appendix B.4. 		
 Inspection upon the completion of final grading \$ establishment of permanent stabilization. 		

Please notify certifying engineer 48 hours prior to commencing construction

Engineer's Name: LDE, Inc.
Phone Number: 410-715-1070

SCALE . N.T.S

Date: 03-18-10

MAINTENANCE CRITERIA FOR PERMEABLE SURFACES

I. PAVEMENTS SHOULD BE USED WHEN REGULAR MAINTENANCE CAN BE PERFORMED TO ENSURE LONG TERM PERFORMANCE.

2. MAINTENANCE TO INCLUDE, SWEPT AND VACUMING TO REMOVE SEDIMENT ACCUMULATION TO ENSURE SURFACE POROSITY. SWEEPING SHOULD BE COMPLETED TWICE ANNUALLY WITH A COMMERCIAL CLEANING UNIT. DO NOT USE COMPRESSED AIR OR WASHING SYSTEMS.

3. DRAINAGE PIPES, INLETS, STONE EDGES AND ANY OTHER STRUCTURES WITHIN OR DRAINING TO THE SUBBASE SHOULD BE CLEANED REGULARLY. 4. AVOID TRUCKS FROM TRACKING AND SPILLING MATERIALS WHICH CAN BE GROUND INTO THE

5. DEICERS SHOULD BE USED IN MODERATION. DEICERS SHALL BE NON TOXIC AND ORGANIC. PLOWING SHALL BE DONE CAREFULLY WITH BLADES SET I" HIGHER THAN NORMAL. SNOW PILE SHALL NOT BE PLACED ON THE PERMEABLE PAVEMENT.

B.4.B Specifications for Permeable Surfaces

These specifications include information on acceptable materials for typical applications and are not exclusive or limiting.

1. Pervious Concrete Specifications

I HEREBY CERTIFY THAT THESE DO

Design Thickness - Pervious concrete applications shall be designed so that the thickness of the concrete slab shall support the traffic and vehicle types that will be carried. Applications may be designed using either standard pavement procedures (e.g., AASHTO, ACI 325.9R, ACI 330R) or using structural values derived from flexible pavement design

Mix \$ Installation - Traditional Portland cements (ASTM C 150, C 1157) may be used in pervious concrete applications. Phosphorus admixtures may also be used. Materials should be tested (e.g., trial batching) prior to construction so that critical properties (e.g., settling time, rate of strength development, porosity, permeability) can be determined.

Aggregate - Pervious concrete contains a limited fine aggregate content. Commonly used gradations include ASTM C 33 No. 67 (3/4 in. to No. 4), No. 8 (3/8 in. to No. 16) and No. 89 (3/8 in. to No. 50) sieves. Single-sized aggregate (up to I inch) may also be used.

Water Content - Water-to-cement ratios between 0.27 and 0.30 are used routinely with proper inclusion of chemical admixtures. Water quality should meet ACI 30a. As a general rule, potable water should be used although recycled concrete production water meeting ASTM C 94 or AASHTO M 157 may also be used.

Admixtures - Chemical admixtures (e.g., retarders or hydration-stabilizers) are used to obtain special properties in pervious concrete. Use of admixtures should meet ASTM C 494 (chemical admixtures) and ASTM C 260 (air entraining admixtures) and closely follow manufacturer s recommendations.

Base Course - The base course shall be AASHTO No. 3 or 4 course aggregate with an assumed open pore space of 30%


2. Permeable Interlocking Concrete Pavements (PICP)

Paver Blocks - Blocks should be either 3 in. or 4 in. thick, and meet ASTM C 936 or CSA A231.2 requirements. Applications should have 20% or more (40% preferred) of the surface area open. Installation should follow manufacturers instructions, except that infill and base course materials and dimensions specified in this Appendix shall be followed.

Infill Materials and Leveling Course - Openings shall be filled with ASTM C-33 graded sand or sandy loam. PICP blocks shall be placed on a one-inch thick leveling course of ASTM C-33 sand.

Base Course - The base course shall be AASHTO No. 3 or 4 course aggregate with an assumed open pore space of 30% (n = 0.30).

TYPICAL SECTION - PERMEABLE SURFACES

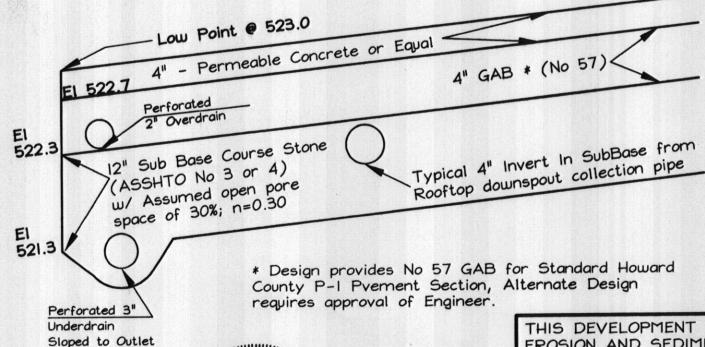

THIS DEVELOPMENT PLAN IS APPROVED FOR SOIL DONE ACCORDING TO THIS PLAN, AND THAT ANY RESPONSIBLE EROSION AND SEDIMENT CONTROL BY THE HOWARD PERSONNEL INVOLVED IN THE CONSTRUCTION PROJECT WILL HAVE A SOIL CONSERVATION DISTRICT. CERTIFICATE OF ATTENDANCE AT A DEPARTMENT OF THE ENVIRONMENT APPROVED TRAINING PROGRAM FOR THE CONTROL OF SEDIMENT AND EROSION BEFORE BEGINNING THE PROJECT. I ALSO AUTHORIZE PERIODIC

DATE

1/29/10 HOWARD SOIL CONSERVATION DISTRICT

FOR PERMEABLE SURFACES

CONSTRUCTION CRITERIA

Final grading for installation should not take place until surrounding site is stabilized. If this can not be accomplished, runoff from disturbed areas shall be diverted around proposed povernent location.

2. Sub soils shall not be compacted. Construction should be performed with lightweight, wide tracked equipment to minimize compaction. Excavated materials should be placed in a contained area.

4. Subbase aggregate shall be clean and free of fines. The subbase shall be placed in lifts and lightly rolled according to the specifications

LDE, Inc. provides that listed in Appendix B.4. of the 2000 Maryland Stormwater Design Manual Volume 2 as guidelines to contractor and guidance in the shown overdrain \$ underdrain system. The contractor shall provide verification that the materials used meet the specifications shown within Appendix B.4.

REHAK

FF 529.00

BF 520.00

Per Howard County SWM Seminar Example Packet - April 2010;

"MDE has indicated that ... For residential detached developments with small amounts of impervious areas the impervious areas should be treated at the source using ESD practices. If the ESD practices address the calculated Pe for the site impervious area and the ESDv, then the remaining grass areas of the site shall be considered adequate and no further treatment will be required."

No additional management required for Septic Area portion of site.

SWM LEGEND

NON-ROOFTOP DISCONNECTION AREA
NON-PERMEABLE SURFACE
EXCLUSION ZONE

ENGINEER'S CERTIFICATE

REPRESENTS A PRACTICAL AND WORKABLE PLAN BASED ON MY
PERSONAL KNOWLEDGE OF THE SISTE CONTINUOUS AND THAT IT WAS
PREPARED IN ACCORDANCE WITH THE REQUIREMENTS OF THE HOWARD
SOIL CONSERVATION DISTRICT.

I/WE CERTIFY THAT ALL DEVELOPMENT AND/OR CONSTRUCTION WILL E

-SITE INSPECTIONS BY THE HOWARD SOIL CONSERVATION DISTRICT."

> member


NATURE OF DEVELOPER


ROBERT B. WHITE

20.0


NON-ROOFTOP DISCONNECTI
NON-PERMEABLE SURFACE
EXCLUSION ZONE (SWM PRACTICES NOT PERMITTED)
PERMEABLE SURFACE

TYPICAL SECTION OVERDRAIN / UNDERDRAIN LOCATIONS

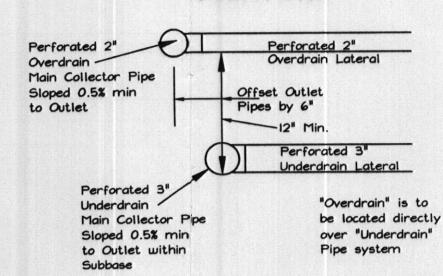

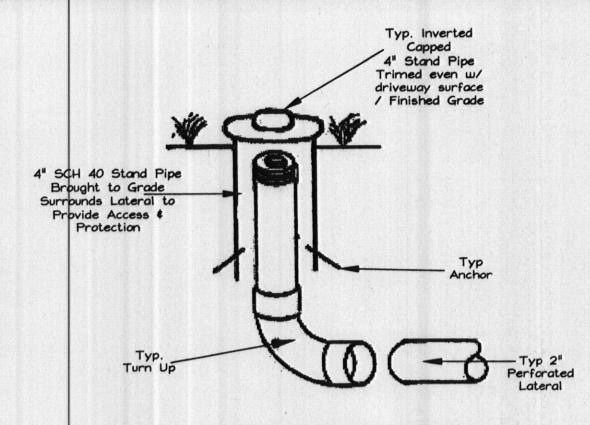

TYPICAL CLEANOUT 2" OVERDRAIN LATERAL SCALE: N.T.S.

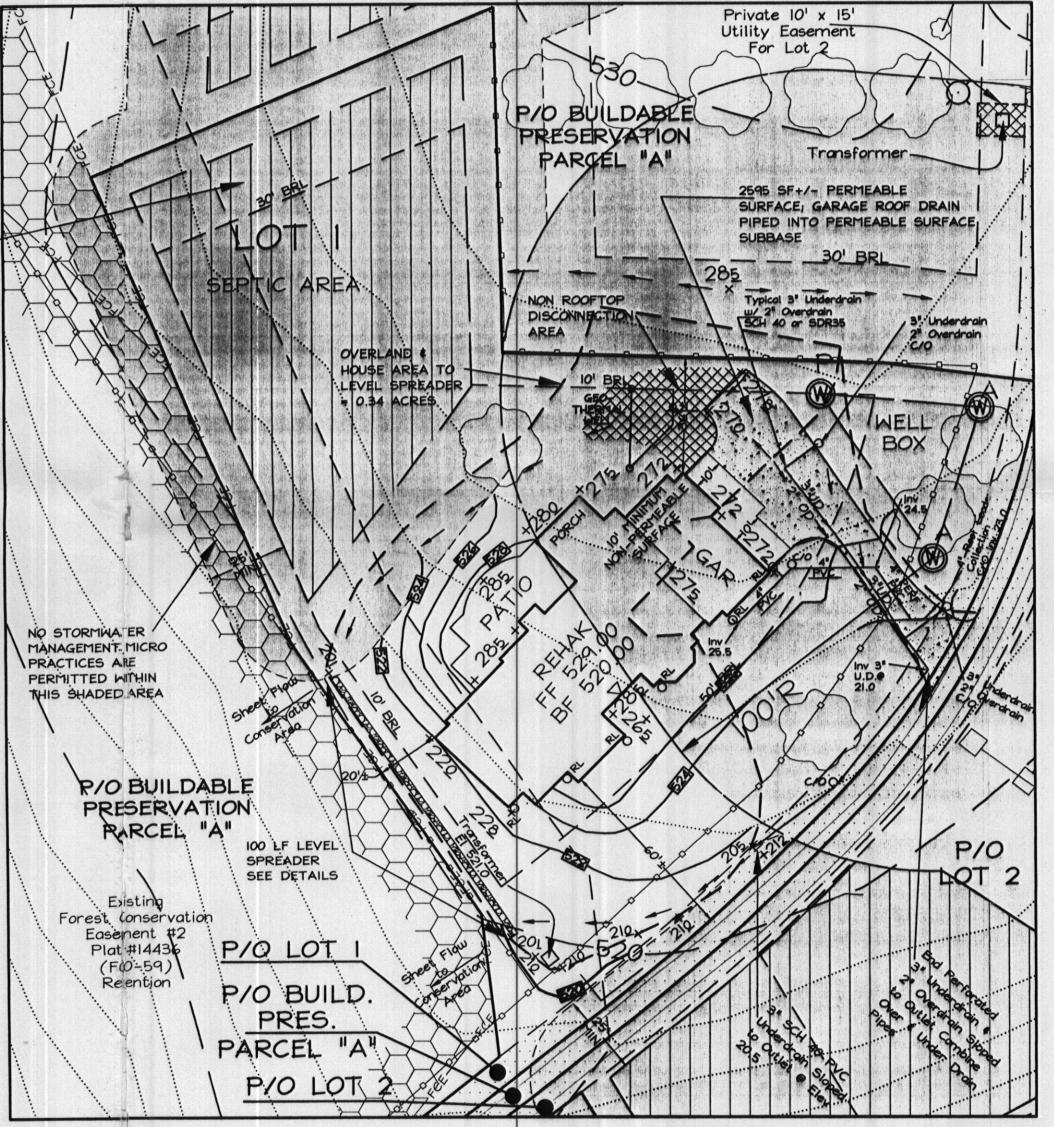

SHEET FLOW CONSERVATION AREA / PERMEABLE SURFACE PLAN VIEW - 1" = 30"

INSPECTION CHART FOR SHEET FLOW TO CONSERVATION AREA

Engineer's Approval STAGE Date 1. Buffer/FCE clearly marked along Lot 1 to ensure no disturbance 2. Prior to Use \$ Occupancy, verify area measurements to level spreaders 3. Prior to Use \$ Occupancy, verify permanent stabilization has been established

> *Please notify certifying engineer 48 hours prior to commencing construction*

Engineer's Name: Phane Number: 410-715-1070

Level Spreader - Sequence of Construction

1. Once the individual house has been constructed and the final lot grading is complete, contact the LDE, Inc./ certifying professional engineer/professional land surveyor (LDE, Inc./ 100-715-1070)). Once the certifying professional has given his/her approval proceed as 2. Construct Level Spreader and connect downspout conveyance pipes per details herean under supervision of the certifying professional.

OPERATION AND MAINTENANCE SCHEDULE FOR LEVEL SPREADERS


1. LEVEL SPREADERS shall be installed after the contributing site has been stabilized unless filter fabric is placed over the device immediately after construction to divert sediment from entering the device.

2. After the site has been stabilized and with the inspector's approval, the fabric may be removed

3. Maintenance shall be performed on a level spreader by the lot / homeowner when sediment is visually apparent within the stone voids. The portion of the stones that are affected shall be removed and replaced by the lot / homeowner with clean stone.

MAINTENANCE CRITERIA FOR SHEET FLOW TO CONSERVATION AREA

CONSERVATION AREAS SHALL REMAIN UNMANAGED OTHER THAN ROUTINE DEBRIS REMOVAL AND REPAIRING AREAS OF CONCENTRATED FLOW. INVASIVE AND NOXIOUS PLANT REMOVAL AND BI-ANNUAL MOWING FOR MEADOW AREAS MAY BE NEEDED.

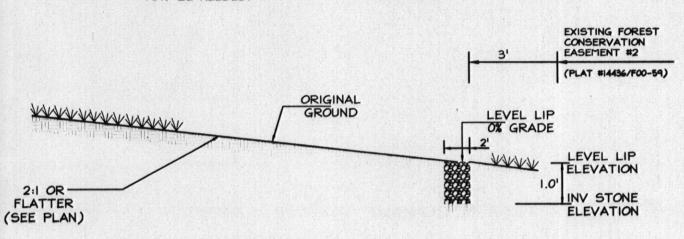


PROFILE

LEVEL SPREADER NUMBER	TOP STONE ELEV	INV STONE ELEV	LEVEL LIF
1 ,	520.1	519.1	520.1

LEVEL SPREADER (Sheet Flow to Conservation Area)

> NOTE: THE STORMWATER MANAGEMENT DESIGN SHOWN WITH THIS PLAN PROVIDES COMPLIANCE WITH ENVIRONMENTAL SITE DESIGN AS REQUIRED BY 5/5/10. FINAL DESIGN OF ALL STORMWATER CONTROLS AND FEATURES SHALL BE PROVIDED PRIOR TO BUILDING PERMIT ISSUANCE.

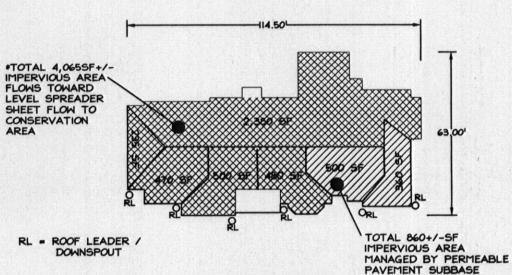

REHAK HOUSE ROOF LEADERS SCALE: 1"=30"

			LDE Inc. Engineers, Surveyors, Planners 9250 Rumsey Road, Suite 106 Columbia, Maryland - 21045 (410)715-1070 - (301)596-3424 - FAX(410)715-9540	
		DESIGNED	STORMWATER MANAGEMENT NOTES & DETAILS	SCALE
	REVISIONS	BDB EDS	HEDGEROW FARM	AS SHOWN
No. Date	Description	DRAMN	PART OF A RESUBDIVISION OF	DRAWING
		EDS	LOT I, THALER ESTATES, PLAT #14436 Triadelphia Mill Road - RR-DEO Zoning	3 of 3
		CHECKED	Tax Map 28 Grid 20 Parcel 64 5th Election District - Howard County, Maryland	JOB NO.
		BDB	Previous Submittals: F00-58, F00-59, WP 00-65, F01-81, WP06-58, F 07-44 ECP10-015, WP 10-172, F 11-022	09-009.2
		II/2010	OWNER/DEVELOPER: Hedgerow Farm LLC 13803 Lakeside Drive Clarksville, MD 21029-1025 (301)802-1051	GPII-

GP-11-

DEPARTMENT OF INSPECTIONS, LICENSES & PERMITS 3430 COURT HOUSE DRIVE ELLICOTT CITY, MD 21043 PERMITS (410) 313-2455 INSPECTIONS (410) 313-1850


HOWARD COUNTY RESIDENTIAL HEATING-VENTILATION-AIR CONDITIONING AND REFRIGERATION PERMIT APPLICATION

HVACR PERMIT# 111000782 BUILDING PERMIT# B10003507

BUILDING ADDRESS: 13560 Trindulphia (2) Clorks ville M.D. 2029 SUBDIVISION: CENSUS TRACT: SECTION: LOT: TAX MAP: 28 PARCEL: BLOCK: ZONE: PROPERTY ID: MAP COORDINATES: 477817 TYPE OF IMPROVEMENTS: USE:	OWNERS NAME: LOUIS REMIK ADDRESS: 13779 Lake Sicle Dr CITY: Clarks ville STATE: MD ZIP CODE: 41029 HOME PHONE: WORK PHONE:
CHECK ONE HOW MANY SINGLE FAMILY DWELLING 3 ZONES SINGLE FAMILY TOWNHOUSE DECOMES MULTI-FAMILY / HOTEL/MOTEL DECOMES ASSISTED LIVING HOMES DECOMES (16 OR FEWER RESIDENTS)	COMPANY NAME: A QUALITY HVAC LICENSEE NAME: JOSTHUA A DIETZ ADDRESS: 1824 Ridge ED CITY: Westminster STATE: MD ZIP CODE: PHONE: 407519700 HVACR LICENSE NO: 48393
Replacement Heating Air Conditioning Heating and Air Conditioning	ting System Only tless Mini Splits Additions and Alterations Heating Air Conditioning Heating and Air Conditioning Heating and Air Conditioning
Zones Permit Fee = # of Zones x \$40 = \frac{120}{12}. Technology Fee (10% of Permit Fee) = \frac{12}{550.00}. Total Fees Due = \frac{182}{182}.	Rooms Permit Fee = # of Rooms x \$80 = Technology Fee (10% of Permit Fee) = Plus Application Fee \$50 Total Fees Due =
I HAVE CAREFULLY EXAMINED AND READ THIS APPLICATION A AND CORRECT. THE WORK DESCRIBED HEREIN WILL BE PERFO LICENSED PERSON(S), AND ALL WORK WILL BE PERFORMED IN APPLICABLE CODES AND STANDARDS OF HOWARD COUNTY THI MARYJAND	RMED BY A STATE HVACK COMPLIANCE WITH

Make check payable to: DIRECTOR OF FINANCE OF HOWARD COUNTY

Word doc: T:\Updated Forms\hvac application Rev:10.2009

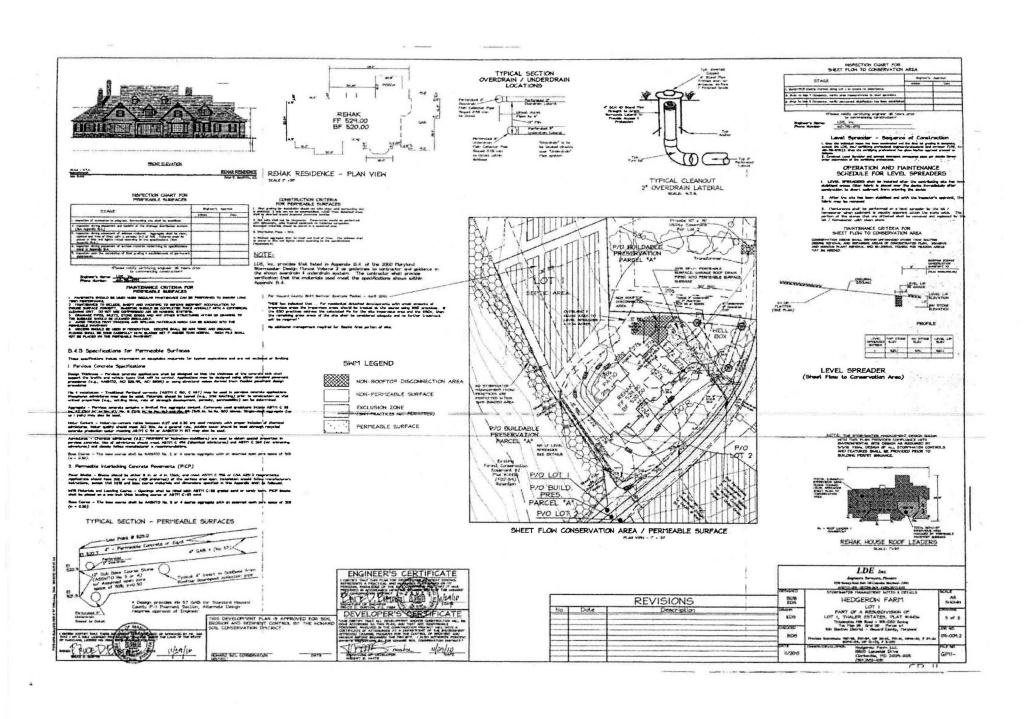

E8000111W