

11/14/80
as soon as possible

05-385431

APPROVED
10/14/80 RH
P 30949

PERMIT

A 26030

SEWAGE DISPOSAL SYSTEM

MARYLAND STATE DEPARTMENT OF HEALTH

HOWARD COUNTY

ELLICOTT CITY

DISTRICT 5th

INDEXED

DATE 9/22/80

Jack Fyock, Jr.

IS PERMITTED TO INSTALL ☒ ALTER

ADDRESS 13775 Triadelphia Road, Glenelg, Maryland 21737 PHONE 988-9270

SUBDIVISION Mildred Brown ROAD 14695 Triadelphia Mill LOT 2

PROPERTY OWNER Thomas O. Brown

ADDRESS

SPECIFICATIONS 3 Bedrooms

SEPTIC TANK CAPACITY 1000 GALLONS DRY WELL AND TRENCH

DRAIN FIELD DEPTH FEET, BOTTOM AREA SQ. FT.

DEEP TRENCH DEPTH FEET, BOTTOM AREA SQ. FT.

Dry Well SEE PAGE PITS ☒ ABSORBENT SIDE-WALL AREA 140 SQ. FT. per bedroom

INLET PIPE 4 FT. BELOW ORIGINAL GRADE. MAXIMUM DEPTH 10 FT. BELOW ORIGINAL GRADE

EFFECTIVE DEPTH AT FT. BELOW ORIGINAL GRADE.

LOCATE DISPOSAL AREA FT. FROM LOT LINE AND FT. FROM LOT LINE AS SEEN WHEN

FACING LOT FROM

Location of dry well - Place the dry well 317.0' from right (160.87 lot line) and 135 feet from rear (1101.46 ft. long) side line as seen when facing the property from Triadelphia Mill Road. Start the trench after a 5 foot earth buffer with the dry well, and proceed to dig it on level ground, the required distance. NOTE: Call for inspection of trench before gravel is installed. and after.

PLANS APPROVED BY Frank Skinner DATE 11/3/77

COVER NO WORK UNTIL INSPECTED AND APPROVED.

NEITHER THE HOWARD COUNTY COUNCIL NOR THE HEALTH DEPARTMENT IS RESPONSIBLE FOR THE SUCCESSFUL OPERATION OF ANY SYSTEM.

NOTE: IF TRENCH IS USED CALL FOR INSPECTION BEFORE PLACING GRAVEL IN TRENCH.

NOTE: NO DRY WELL SHALL EXCEED 15 FOOT IN DIAMETER.

NOTE: ALL PIPE FROM HOUSE TO DISPOSAL AREA MUST BE CAST IRON.


PERMIT VOID AFTER THREE YEARS.

NOTE: INSTALL STAND PIPE ON SEPTIC TANK AND DRY WELL. STAND PIPES MUST BE 6 INCHES IN DIAMETER. CAST IRON, CONCRETE OR TERRA COTTA ACCEPTED.

*INSTALLER IS RESPONSIBLE FOR OBTAINING FINAL APPROVAL ON THIS PERMIT.

A 26030

1102 FT LINE

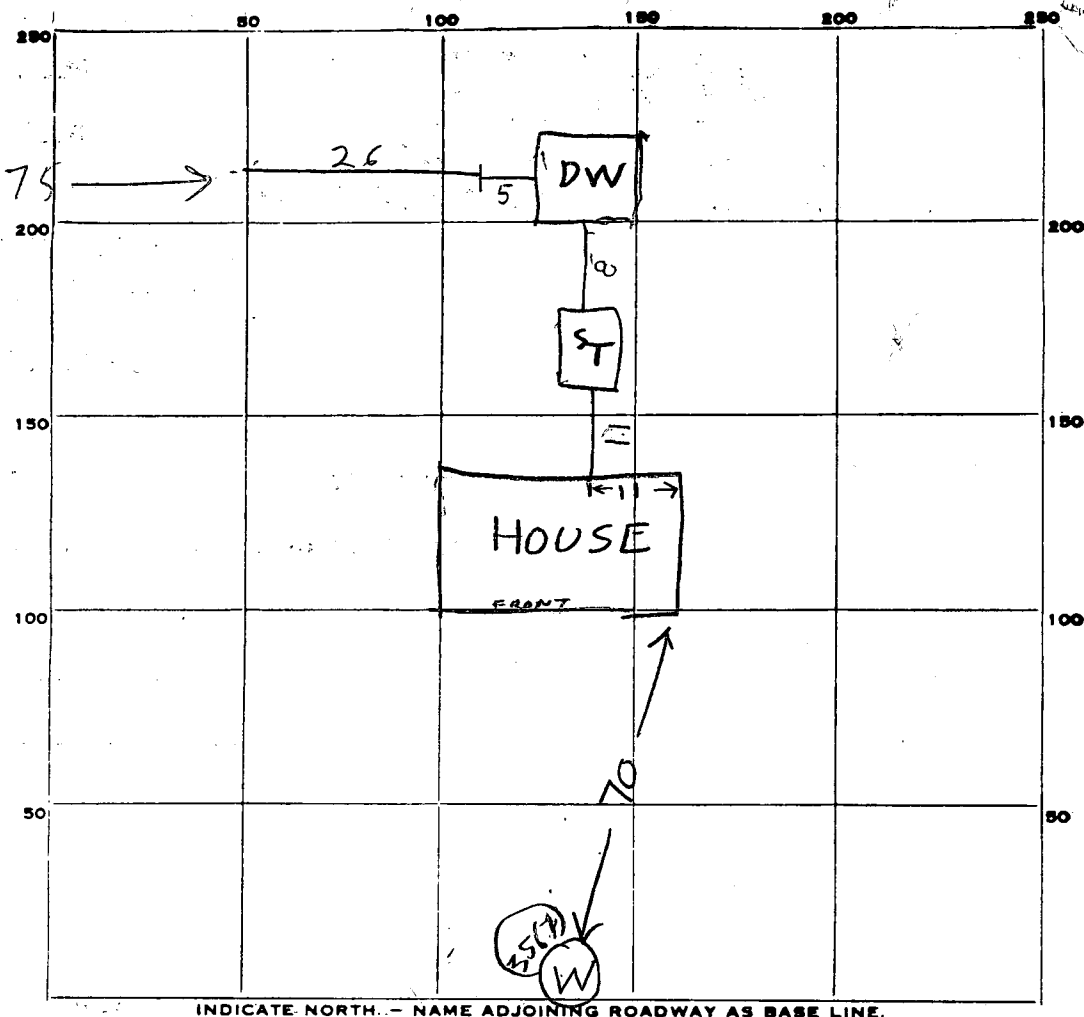

31
5

PERMIT CARD _____

ST	DW
----	----

SEPTIC TANK, LEVEL OK 1600

CLEANOUTS OK OK

DISTRIBUTION BOX, LEVEL _____

TILE FIELD, DEPTH 10-10 1/2 FT. TRENCH WIDTH 2 FT.

GRAVEL DEPTH 6 FT IN. TOTAL LENGTH 26 FT.

NUMBER OF TRENCHES 1 TOTAL ^{ONE SIDE} ~~SECTION~~ AREA 156

SEEPAGE PITS, INSIDE ^{PERIMETER} ~~DIAMETER~~ 46 FT. DEPTH BELOW INLET 6.5 FT.

ABSORBENT AREA 299 SQ. FT.

REMARKS 10/14/80 DW INLET 4 FT BELOW GRADE

DITCH INLET 4 FT BELOW GRADE

LOCATION OK PER PLANS

299 + 156 = 455 SQ FT, 420 SQ FT NEEDED
STONE ADDED AT TIME OF INSPECTION

DATE SYSTEM APPROVED 10/14/80

INSPECTOR Raymond Hodge

WASHINGTON SUBURBAN
SANITARY COMMISSION
NO DEED REFERENCE

FRANCIS M. BROWN
450-200

TRIADDELPHIA MILL RD

TAX MAP 27

LOCATION MAP
SCALE: 1"=800'

ASSUMED COORDINATES TABLE		
NO.	NORTH	EAST
1.	5000.00	2000.00
2.	4756.73	2444.87
3.	4654.63	2580.56
4.	4868.43	2723.64
5.	4787.13	2772.09
6.	4644.47	2913.84
7.	4633.81	2936.51
8.	4424.18	2863.44
9.	4318.92	2869.80
10.	4363.15	1769.23
11.	4471.87	1830.93

CURVE DATA					
CURVE	R	L	Δ	T	LCB
A	294.00	25.37'	4°56'35"	12.65'	S62°20'41"E 25.37'
B	294.00	179.88'	35°03'21"	92.85'	S42°20'41"E 177.88'
C	545.00	93.75'	9°51'23"	46.79'	S50°44'41"E 93.75'
D	575.00	110.48'	11°00'33"	55.41'	S50°41'17"E 110.48'
E	264.00	184.31'	40°00'00"	96.09'	S44°49'00"E 184.31'

NOTE: THIS AREA DESIGNATES A PRIVATE SEWAGE EASEMENT OF APPROXIMATELY 10,000' AS REQUIRED BY THE MARYLAND STATE DEPARTMENT OF HEALTH AND MENTAL HYGIENE FOR INDIVIDUAL SEWAGE DISPOSAL. IMPROVEMENTS OF ANY NATURE IN THIS AREA ARE RESTRICTED UNTIL PUBLIC SEWER IS AVAILABLE AND SERVICING ANY RESIDENTIAL STRUCTURE CONSTRUCTED ON THIS BUILDING SITE. THIS EASEMENT SHALL BECOME NULL AND VOID UPON CONNECTION TO A PUBLIC SEWERAGE SYSTEM.

TABULATION

AREA LOT 1 7.924 Act
AREA LOT 2 3.812 Act
DEDICATION ROAD 0.228 Act
TOTAL 11.424 Act

NOTES:
EXISTING STRUCTURE ON LOT 1

SURVEYOR'S CERTIFICATE

I HEREBY CERTIFY THAT THE FINAL PLAT SHOWN HEREON IS CORRECT THAT IT IS A SUBDIVISION OF PART OF LANDS CONVEYED BY BERTHA M. BROWN, WIDOW, UNTO MILDRED V. BROWN BY A DEED DATED FEB. 26, 1966 AND RECORDED AMONG THE LAND RECORDS OF HOWARD COUNTY IN LIBER 450 FOLIO 202, AND THAT ALL MONUMENTS ARE IN PLACE AS SHOWN IN ACCORDANCE WITH THE ANNOTATED CODE OF MARYLAND AS AMENDED.

OWNER'S CERTIFICATE

I, MILDRED V. BROWN, OWNER OF THE LAND SHOWN AND DESCRIBED HEREON HEREBY ADOPT THIS PLAN OF SUBDIVISION, AND IN CONSIDERATION OF THE APPROVAL OF THIS FINAL PLAT BY THE OFFICE OF PLANNING & ZONING, ESTABLISH THE MINIMUM BUILDING RESTRICTION LINES & GRANT UNTO HOWARD COUNTY, MD, ITS SUCCESSORS & ASSIGNS, (1) THE RIGHT TO LAY, CONSTRUCT & MAINTAIN SEWERS, DRAINS, WATER PIPES & OTHER MUNICIPAL UTILITIES & SERVICES, IN & UNDER ALL ROADS & STREET RIGHT OF WAYS & THE SPECIFIC EASEMENT ARE AS SHOWN HEREON; (2) DEDICATE TO PUBLIC USE THE BEDS OF THE STREETS & /OR ROADS & FLOOD PLAINS & OPEN SPACE WHERE APPLICABLE, & FOR ONE DOLLAR (\$1.00) CONSIDERATION HEREBY GRANT THE RIGHT & OPTION TO HOWARD COUNTY TO ACQUIRE THE FEE SIMPLE TITLE TO THE BEDS OF THE STREETS & OR ROADS AND FLOOD PLAINS & OPEN SPACE WHERE APPLICABLE; (3) THAT NO BUILDING OR SIMILAR STRUCTURE OF ANY KIND SHALL BE ERRECTED ON OR OVER THE SAID EASEMENTS & RIGHT OF WAYS & (4) IT IS FURTHER AGREED THAT THE MAINTENANCE OF ALL WATERWAYS, DRAINAGE EASEMENTS & /OR FLOOD PLAINS SHOWN HEREON ARE THE RESPONSIBILITY OF THE PROPERTY OWNER ITS SUCCESSORS & ASSIGNS. WITNESS OUR HAND THIS 1977

RECORDED AS PLAT # 4005 ON MAY 15, 1978 AMONG THE LAND RECORDS OF HOWARD COUNTY, MARYLAND

LOTS 1 & 2
PROPERTY OF
MILDRED V. BROWN
ELECTION DISTRICT 5
HOWARD COUNTY, MD.
SCALE: 1"=100' SEPT. 6, 1977

APPROVED: FOR PRIVATE WATER & PRIVATE SEWERAGE SYSTEMS, HOWARD COUNTY HEALTH DEPARTMENT.
Joseph M. Brydus 5-11-78
COUNTY HEALTH OFFICER DATE

APPROVED: HOWARD COUNTY OFFICE OF PLANNING & ZONING.
Thomas L. Harvath 5-15-78
DIRECTOR DATE

APPROVED: FOR STORM DRAINAGE SYSTEMS & PUBLIC ROADS HOWARD CO. DEPT. OF PUBLIC WORKS.
1/14/1977
DATE

Walter Park
WALTER PARK REG. L.S. #5539
HUDKINS ASSOCIATES

APPLICATION

A 26030

SEWAGE DISPOSAL TESTING

P. _____

STATE OF MARYLAND - DEPARTMENT OF HEALTH AND MENTAL HYGIENE

HOWARD COUNTY HEALTH DEPARTMENT
ENVIRONMENTAL HEALTH SERVICES
P. O. BOX 476, ELLICOTT CITY, MARYLAND 21043
TELEPHONE: 465-5000, EXT. 356

DISTRICT 5thDATE 6-8-77

TO: THE COUNTY HEALTH OFFICER
ELLICOTT CITY, MARYLAND

I, HEREBY, APPLY FOR THE NECESSARY TEST IN ORDER TO CONSTRUCT (OR RECONSTRUCT) A SEWAGE DISPOSAL SYSTEM.

PROPERTY OWNER Mildred V. BrownADDRESS 14705 Triadelphia Mill Rd. PHONE 286-2764
DAYTON md. 21036

PROPERTY LOCATION:

SUBDIVISION _____ LOT NO. 2ROAD AND DESCRIPTION 14705 TRIADELPHIA MILL Rd. - S.W. corner of
existing 11.387 acres plot.SIZE OF LOT ± 3 acres TYPE BLDG. 3
NUMBER OF BEDROOMS

IF NOT SINGLE RESIDENCE DESCRIBE _____



THE SYSTEM INSTALLED UNDER THIS APPLICATION IS ACCEPTABLE ONLY UNTIL PUBLIC FACILITIES BECOME AVAILABLE.

SIGNATURE OF APPLICANT Thomas D. BrownAPPROVED BY _____ FOR _____ DATE _____
(KIND OF SYSTEM)REJECTED BY Frank Skinner FOR _____ DATE 11/7/77
(KIND OF SYSTEM)

HOLD PENDING FURTHER TESTS _____ DATE _____

REASONS FOR REJECTION OR HOLDING Hold for Septoid hole creation for S.
holes apparently on wrong lot T.S.

THIS IS NOT A PERMIT

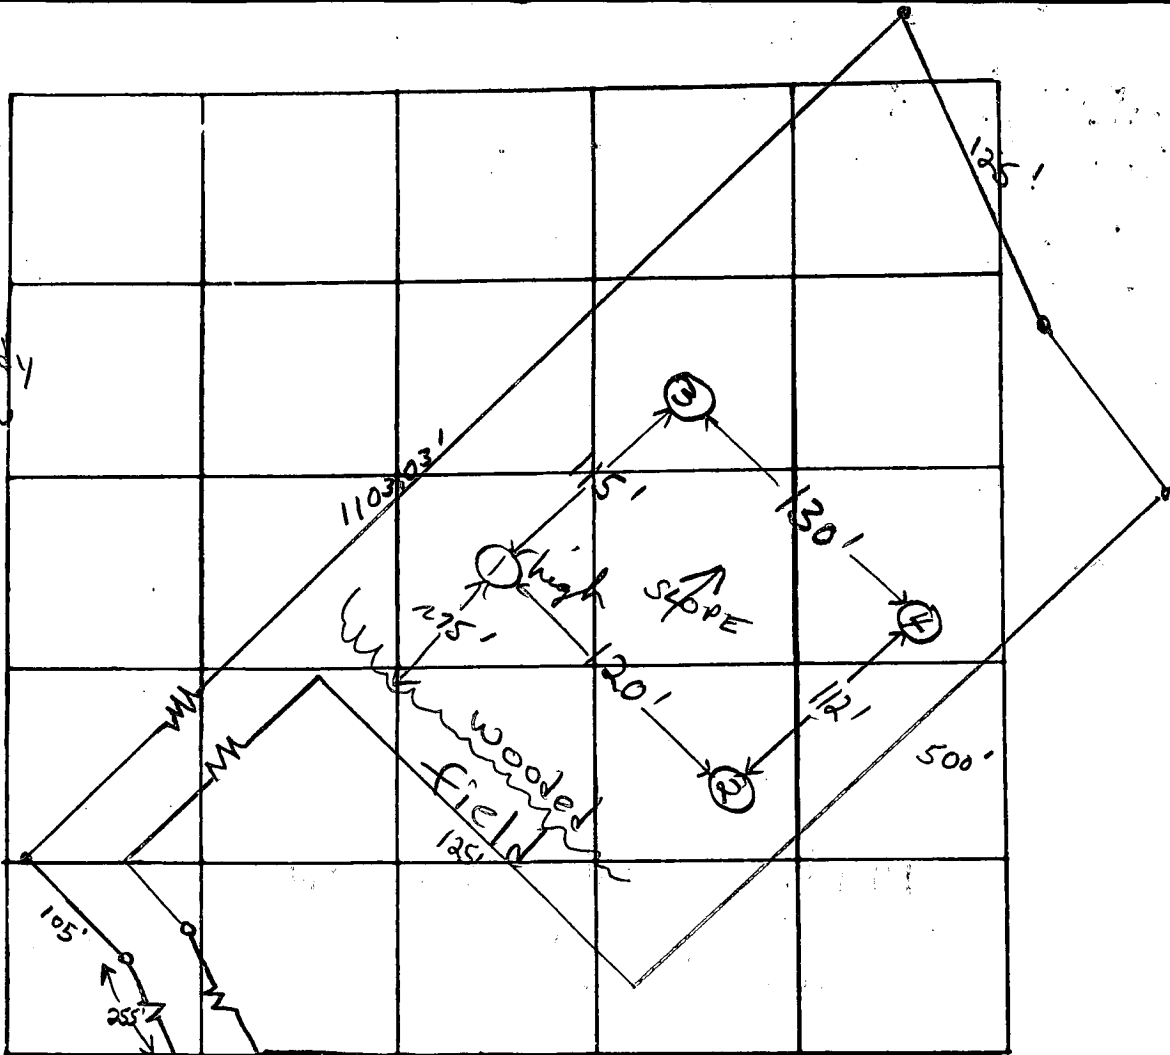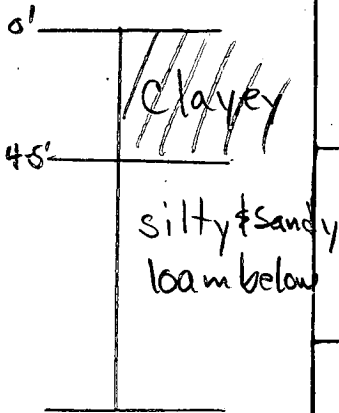

INDICATE NORTH. - NAME ADJOINING HIGHWAY AS BASE LINE

Triadelphia Mill Rd.

DATE	TEST NO.	DEPTH	PRE-WET		TEST - 1" DROP		TIME
			START	STOP	START	STOP	
6/24/77	1 high	3'	11:15	pulled peg	11:22	11:24	FAILS
	1A	13'	11:15	11:17	11:17	11:22	5 min
	1B	4'	11:26	11:30	11:30	11:38	8 min
	2	12'	Clayey to 3' silty loam below				
	3	5'	11:39	11:47	11:47	pulled peg	
	3A	13'	11:38	11:40	11:40	11:45	5 min
	4	5'	11:52	11:53	11:53	11:55	2 min
	4A	13'	11:52	11:53	11:53	11:55	2 min
	3B	5 1/2'	11:59	12:02	12:02	12:08	6 min

REMARKS Wooded lot - Cert. by hole locations

TYPE OF SOIL Clayey to 4' 5' silty & sandy loam below

TESTED BY F.S.

ALSO PRESENT: Brown, Fyock & Co.

LIBER 0751 Folio 368

LIBER 450 Folio 200

DWELLING

LIBER 302 Folio 373

check your text

→ see P 13437
A 13148

11.387 Acres

HOOS

324

KIMBURTHILL INC.
TAX MAP 27 B1 23 PARCEL 23
LIER 675 FOLIO 399

APPLICATION

10/10/77
Well not drilled
No elevation A 26030

SEWAGE DISPOSAL TESTING

P _____

STATE OF MARYLAND - DEPARTMENT OF HEALTH AND MENTAL HYGIENE

HOWARD COUNTY HEALTH DEPARTMENT 3 B.R. | 4 B.R. DISTRICT 5th
ENVIRONMENTAL HEALTH SERVICES 1000 gal. Septic tank | 1250 gal. Septic tank
P. O. BOX 476, ELLICOTT CITY, MARYLAND 21043
TELEPHONE: 465-5000, EXT. 356
DATE 6/8/77

Drywell & trench system to have 140 SQ. FT. effective
sidewall absorption area per bedroom, to begin below the top
4 ft. of non-porous soil. Maximum depth permitted for drywell or
trench is 10 ft. below original grade. Place the drywell ^{189.27} ~~225~~ ft. from
the ~~front~~ ^{135 ft. 33} lot line and 50 ft. from the ~~left~~ ^{rear}
corner (1101.46 ft. long) side line as seen when facing the property from
Triadelphia Mill Road. Start the trench after a 5 foot north buffer
with the drywell, and proceed to dig it on level
ground, the required disposal.

NOTE: Call for inspection of trench before gravel is installed

I, HEREBY, APPLY FOR THE NECESSARY TEST IN ORDER TO CONSTRUCT (OR RECONSTRUCT) A SEWAGE
DISPOSAL SYSTEM.

Serial No. 41541

PROPERTY OWNER MILDRED V. BROWN

ADDRESS 14705 TRIADELPHIA MILL Rd. PHONE 286-2764
DARTON Md. 21036

PROPERTY LOCATION:

SUBDIVISION _____ LOT NO. 2
14695 Triadelphia Mill Road,
ROAD AND DESCRIPTION S.W. CORNER OF 14705 TRIADELPHIA MILL Rd.

SIZE OF LOT ± 3 ACRES TYPE BLDG. 3 Bedroom
NUMBER OF BEDROOMS

IF NOT SINGLE RESIDENCE DESCRIBE _____

THE SYSTEM INSTALLED UNDER THIS APPLICATION IS ACCEPTABLE ONLY UNTIL PUBLIC
FACILITIES BECOME AVAILABLE.

SIGNATURE OF APPLICANT Mildred V. Brown BLDG. PERMIT SIGNED
AND RETURNED 6/18/80
Serial # 43496

APPROVED BY Frank Skinner FOR Drywell & trench DATE 11/8/77
(KIND OF SYSTEM)


REJECTED BY _____ FOR _____ DATE _____
(KIND OF SYSTEM)

HOLD PENDING FURTHER TESTS _____ DATE _____

REASONS FOR REJECTION OR HOLDING _____

THIS IS NOT A PERMIT

1" = 100'

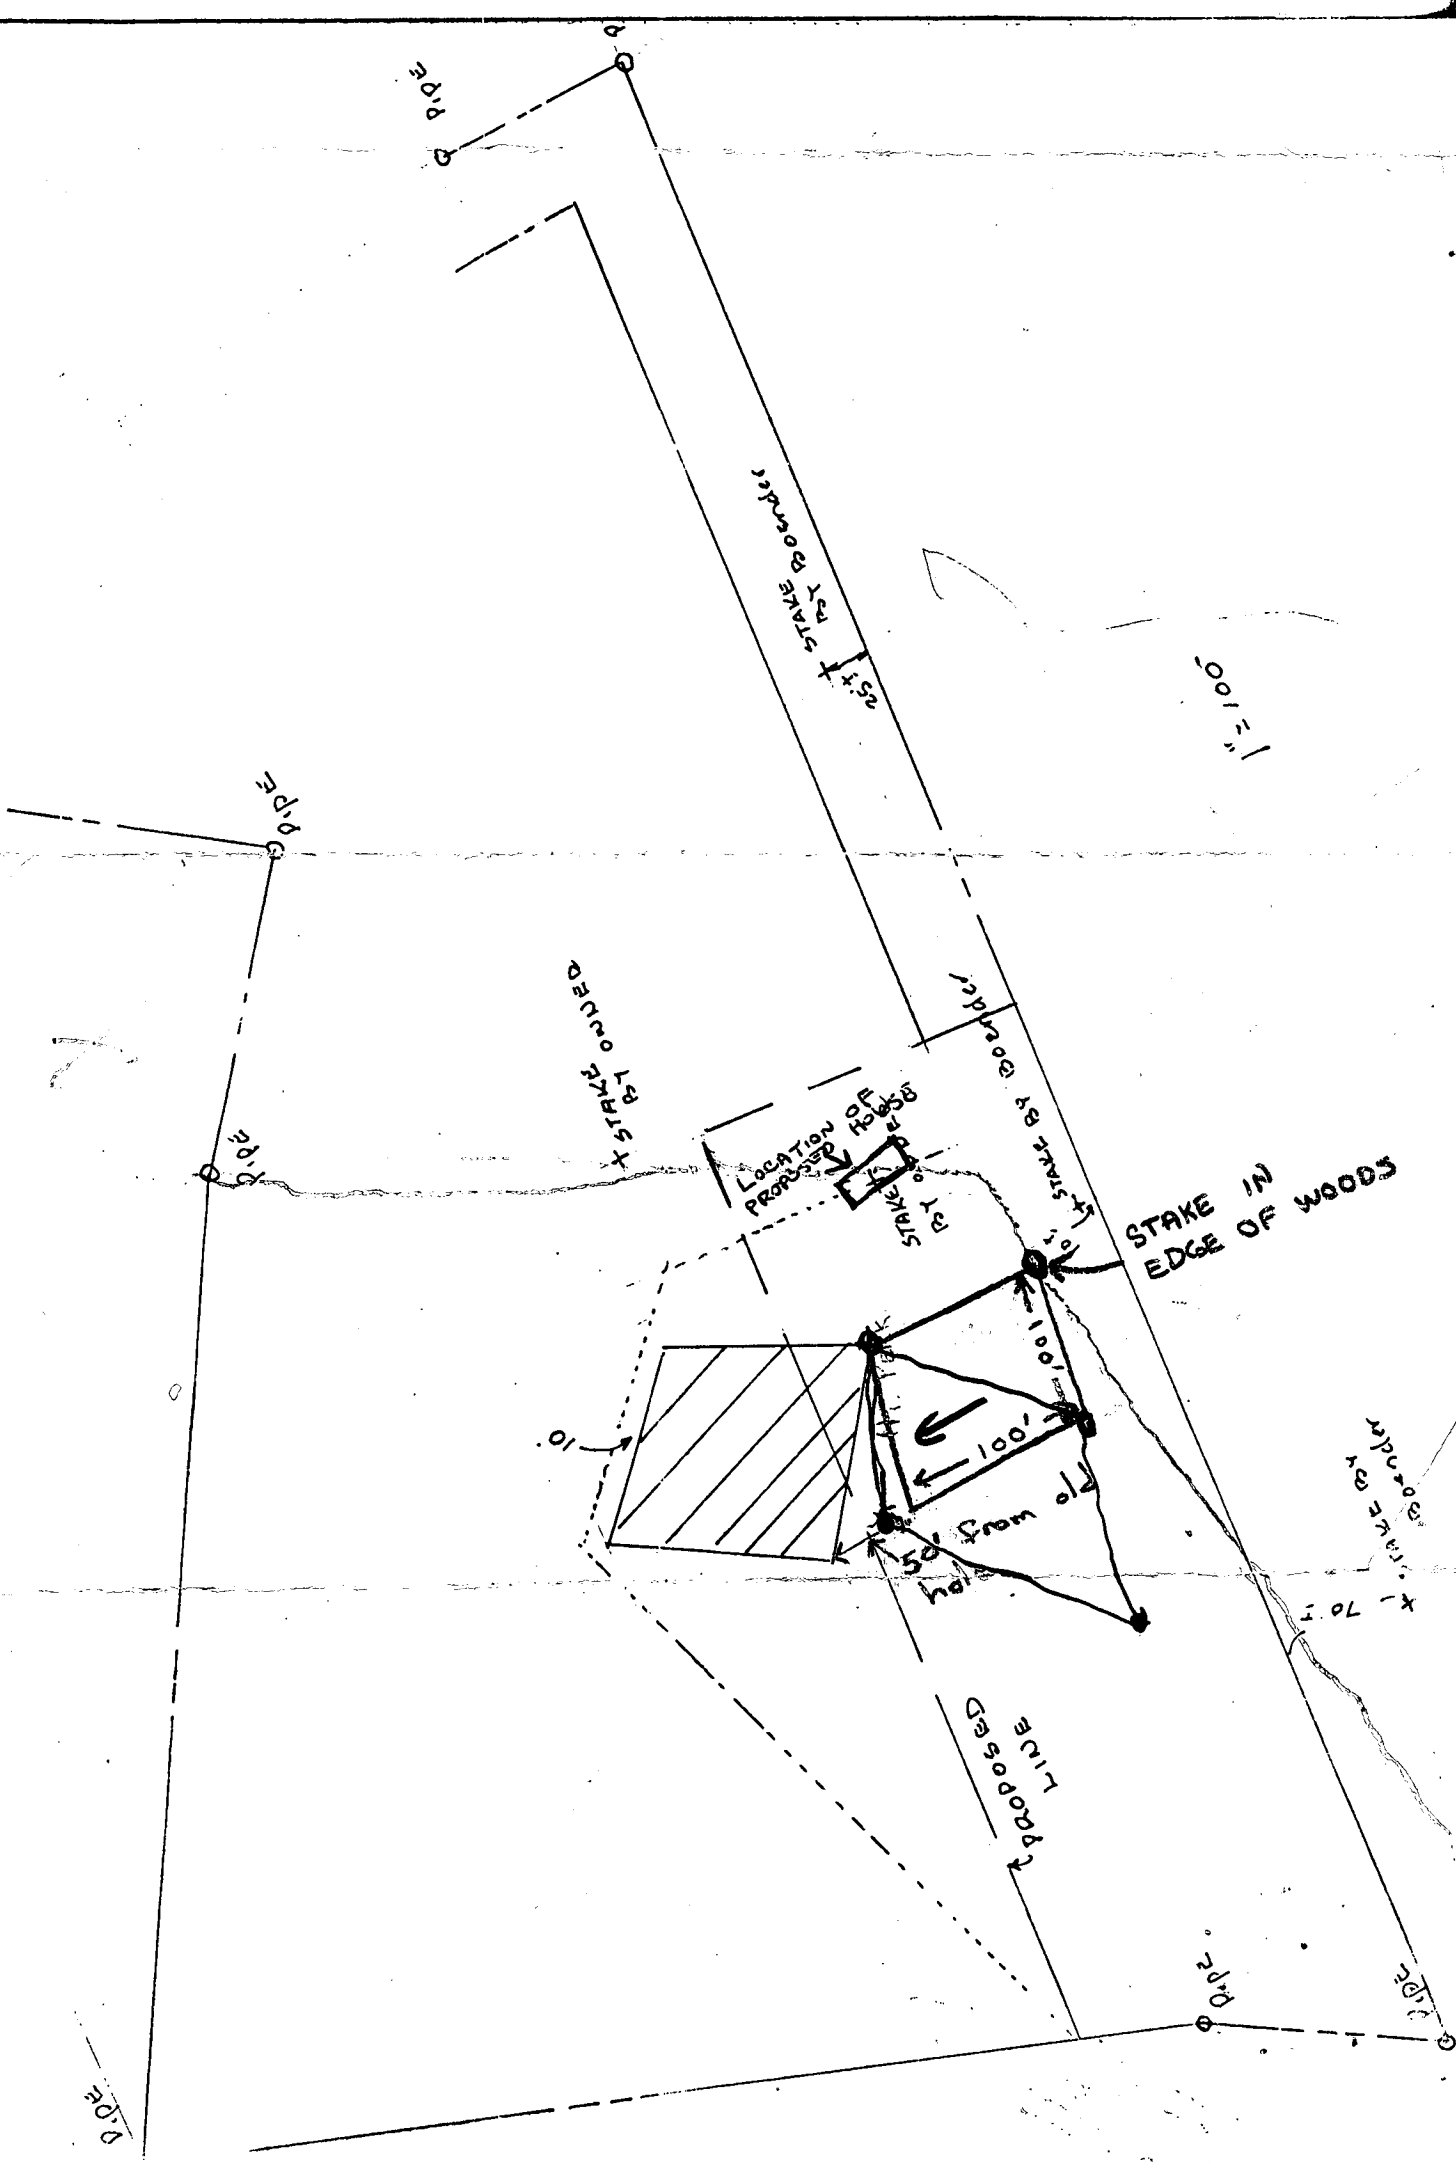

B 1	0698	SEQUENCE NO. (WRA USE ONLY)	STATE OF MARYLAND WATER RESOURCES ADMINISTRATION TAWES STATE OFFICE BLDG., ANNAPOLIS, MARYLAND 21401 APPLICATION FOR PERMIT TO DRILL WELL	WRA PERMIT NUMBER 110-73-3567
1 2 3 (SEQ. NO.) 6 (THIS NUMBER IS TO BE PUNCHED IN COLS. 3-6 ON ALL CARDS)			FILL IN THIS FORM COMPLETELY	

DATE RECEIVED (WRA USE ONLY) 3/3/80 9:30 AM	<table style="width:100%;"> <tr> <td style="width:10%;">OWNER</td> <td colspan="3"><i>Brookman, Thomas</i></td> </tr> <tr> <td>COL 15 LAST NAME</td> <td>COL 34 FIRST NAME</td> <td>COL 36</td> <td>COL 55</td> </tr> <tr> <td colspan="4">STREET OR RFD <i>5480 Ten Oaks Rd.</i></td> </tr> <tr> <td>COL 57</td> <td colspan="3">POST OFFICE <i>Chickensville Md. 21029</i></td> </tr> </table>	OWNER	<i>Brookman, Thomas</i>			COL 15 LAST NAME	COL 34 FIRST NAME	COL 36	COL 55	STREET OR RFD <i>5480 Ten Oaks Rd.</i>				COL 57	POST OFFICE <i>Chickensville Md. 21029</i>		
OWNER	<i>Brookman, Thomas</i>																
COL 15 LAST NAME	COL 34 FIRST NAME	COL 36	COL 55														
STREET OR RFD <i>5480 Ten Oaks Rd.</i>																	
COL 57	POST OFFICE <i>Chickensville Md. 21029</i>																

B 1	CONTINUED	DRILLER INFORMATION
1 2 3 (SEQ. NO.) 6		
DATE <i>Feb 13, 1980</i>		LICENSE NUMBER <i>238</i>
FIRST NAME <i>Joseph C. Maigne</i>		LAST NAME
SIGNATURE <i>Joseph C. Maigne</i>		

B 2	WELL INFORMATION
1 2 3 (SEQ. NO.) 6	
MAXIMUM PUMPING RATE (GALLONS PER MINUTE) <i>5</i>	
AVERAGE DAILY QUANTITY NEEDED (GALLONS PER DAY) <i>150</i>	
USE FOR WATER (CIRCLE APPROPRIATE BOX) ☒ HOME (SINGLE OR DOUBLE HOUSEHOLD UNIT ONLY) ☐ FARMING, AGRICULTURE, IRRIGATION ☐ INDUSTRIAL, COMMERCIAL, STATE AND FEDERAL GOVERNMENT. ☐ MUNICIPAL WATER SUPPLY ☐ PRIVATE WATER COMPANY } MUST HAVE STATE HEALTH DEPT. APPROVAL ☐ TEST	

B 3	LOCATION OF WELL
1 2 3 (SEQ. NO.) 6	
COUNTY <i>Howard</i>	
SUBDIVISION <i>Middlebrook Brown prng</i>	
SECTION <i>1</i> LOT <i>2</i>	
NEAREST TOWN <i>Dayton</i>	
MILES FROM TOWN (ENTER 0 IF IN TOWN) <i>3 1/2</i>	

B 4	DIRECTION FROM TOWN (CIRCLE APPROPRIATE BOX)
1 2 3 (SEQ. NO.) 6	
NEAR WHAT ROAD <i>Frederickville Mill Rd</i> ON WHICH SIDE OF ROAD (CIRCLE APPROPRIATE BOX) NORTH ☐ SOUTH ☒ EAST ☐ WEST ☐ DISTANCE FROM ROAD (ENTER DISTANCE AND CIRCLE APPROPRIATE BOX) <i>1100</i>	

B 4	HEALTH DEPARTMENT APPROVAL
1 2 3 (SEQ. NO.) 6	
STATE HEALTH (CIRCLE BOX) <i>S</i>	
COUNTY NAME <i>Howard</i> COUNTY NO. <i>2</i>	
DATE <i>2-2-80</i>	
APPROVED BY <i>Joseph C. Maigne</i>	

B 5	SPECIAL CONDITIONS 8-63 (WRA USE ONLY)
1 2 3 (SEQ. NO.) 6	
APPROPRIATION PERMIT NUMBER <i>54</i> ENGINEER REVIEW DISTRICT NO. <i>63</i> FORCE <i>67</i> WRITE INITIALS IN BOX <i>68</i> CONDITIONS <i>70 71 72 73 74 75 76 77 78 79</i>	

B 4	DIRECTION FROM TOWN (CIRCLE APPROPRIATE BOX)
1 2 3 (SEQ. NO.) 6	
NEAR WHAT ROAD <i>Frederickville Mill Rd</i> ON WHICH SIDE OF ROAD (CIRCLE APPROPRIATE BOX) NORTH ☐ SOUTH ☒ EAST ☐ WEST ☐ DISTANCE FROM ROAD (ENTER DISTANCE AND CIRCLE APPROPRIATE BOX) <i>1100</i>	

DRAW A SKETCH BELOW SHOWING LOCATION OF WELL IN RELATION TO NEARBY TOWNS, ROADS AND STREAMS WITH NORTH IN THE DIRECTION OF THE ARROW, AND GIVE DISTANCE FROM WELL TO NEAREST ROAD JUNCTION OR STREAM CROSSING SHOWN ON THE SKETCH. ALSO SHOW, BY MEANS OF AN "X", THE WELL LOCATION IN THE BOX BELOW AND THE BOX NUMBER FROM THE WELL LOCATION MAP.

B 4	HEALTH DEPARTMENT APPROVAL
1 2 3 (SEQ. NO.) 6	
STATE HEALTH (CIRCLE BOX) <i>S</i>	
COUNTY NAME <i>Howard</i> COUNTY NO. <i>2</i>	
DATE <i>2-2-80</i>	
APPROVED BY <i>Joseph C. Maigne</i>	

C 1	3011	SEQUENCE NO. (WRA USE ONLY)	STATE OF MARYLAND WATER RESOURCES ADMINISTRATION TAWES STATE OFFICE BLDG., ANNAPOLIS, MD. 21401 WELL COMPLETION REPORT	THIS REPORT MUST BE SUBMITTED WITH- IN 30 DAYS AFTER WELL COMPLETION
1 2 3 (SEQ. NO.) 6 (THIS NUMBER IS TO BE PUNCHED IN COLS. 3-6 ON ALL CARDS)				
DATE RECEIVED (WRA USE ONLY)		DEPTH OF WELL 22 (TO NEAREST FOOT) 26		PERMIT NO. FROM "PERMIT TO DRILL WELL" 40-73-3-67 28 29 30 31 32 33 34 35 36 37
DATE WELL COMPLETED Mar. 3 1988		DRILLERS IDENTIFICATION NO. 238		

OWNER <u>James E. Haggard</u> LAST NAME	FIRST NAME
STREET OR RFD <u>5430 The Capital Hill</u>	POST OFFICE <u>Chesapeake</u>

WELL LOG	GROUTING RECORD	PUMPING TEST
STATE THE KIND OF FORMATIONS PENETRATED, THEIR COLOR, DEPTH, THICKNESS, AND IF WATER BEARING	WELL HAS BEEN GROUTED (CIRCLE APPROPRIATE BOX) YES ☒ NO ☐ TYPE OF GROUTING MATERIAL (CIRCLE BOX) CEMENT ☒ BENTONITE CLAY ☐ NO. OF BAGS <u>18</u> NO. OF POUNDS <u>1662</u> GALLONS OF WATER <u>108</u> DEPTH OF GROUT SEAL (TO NEAREST FOOT) FROM <u>0</u> FT. TO <u>63</u> FT. (ENTER 0 IF FROM SURFACE)	HOURS PUMPED (TO NEAREST HOUR) <u>3</u> PUMPING RATE (GALLONS PER MINUTE TO NEAREST GALLON) <u>15</u> METHOD USED TO MEASURE PUMPING RATE <u>air</u> WATER LEVEL: (DISTANCE FROM LAND SURFACE) BEFORE PUMPING <u>53</u> (NEAREST FOOT) WHEN PUMPING <u>3</u> (NEAREST FOOT) TYPE OF PUMP USED (CIRCLE APPROPRIATE BOX) (FOR PUMPING TEST) ☒ AIR ☐ PISTON ☐ TURBINE ☐ CENTRIFUGAL ☐ ROTARY ☐ OTHER (DESCRIBE BELOW) ☐ JET ☐ SUBMERSIBLE

DESCRIPTION (USE ADDITIONAL SHEETS IF NECESSARY) Brown Sand 0 50 Sand 50 64 Clay 64 115	FEET FROM TO 0 50 50 64 64 115	CHECK IF WATER BEARING YES NO 0 50 50 64 64 115
--	--	---


Casing Types INSERT APPROPRIATE CODE BELOW MAIN CASING TYPE <u>ST</u> NOMINAL DIAMETER TOP (MAIN) CASING (NEAREST INCH) <u>6</u> TOTAL DEPTH OF MAIN CASING (NEAREST FOOT) <u>70</u>	CASING RECORD STEEL ☒ CONCRETE ☐ PLASTIC ☐ OTHER ☐	PUMP INSTALLED TYPE OF PUMP (WRITE APPROPRIATE LETTER IN BOX - SEE ABOVE: A, C, J, P, R, S, T, O) DRILLER WILL INSTALL PUMP (CIRCLE APPROPRIATE BOX) YES ☒ NO ☐ CAPACITY: GALLONS PER MINUTE (TO NEAREST GALLON) <u>31</u> PUMP HORSE POWER <u>37</u> PUMP COLUMN LENGTH (NEAREST FOOT) <u>43</u>
--	---	---

OTHER CASING (IF USED) DIAMETER (INCH) <u>6</u> DEPTH (FEET) FROM <u>0</u> TO <u>70</u>	SCREEN RECORD INSERT APPROPRIATE CODE BELOW STEEL ☒ BRASS OR BRONZE ☐ OPEN HOLE ☐ PLASTIC ☐ OTHER ☐	CASING HEIGHT (CIRCLE APPROPRIATE BOX AND ENTER CASING HEIGHT) ABOVE ☒ BELOW ☐ LAND SURFACE <u>2</u> (NEAREST FOOT) 49 50 51
--	--	--

CIRCLE APPROPRIATE BOXES ☐ A WELL WAS ABANDONED AND SEALED WHEN THIS WELL WAS COMPLETED ☐ E ELECTRIC LOG OBTAINED ☐ P TEST WELL CONVERTED TO PRODUCTION WELL	EACH SCREEN 1 <u>110</u> <u>61</u> <u>115</u> 2 <u>23</u> <u>24</u> <u>26</u> <u>30</u> <u>32</u> <u>36</u> 3 <u>38</u> <u>39</u> <u>41</u> <u>45</u> <u>47</u> <u>51</u> SLOT SIZE 1. <u>2</u> 2. <u>3</u> 3. <u>4</u>	LOCATION OF WELL ON LOT SHOW PERMANENT STRUCTURE SUCH AS BUILDINGS, SEPTIC TANKS, AND/OR OTHER LAND MARKS AND INDICATE NOT LESS THAN TWO DISTANCES (MEASUREMENTS TO WELL). 35 ft well 20 ft 30 ft front lot line
--	---	--

I HEREBY CERTIFY THAT I HAVE COMPLIED WITH ALL CONDITIONS STATED ON THE ABOVE-CAPTIONED "PERMIT TO DRILL WELL", AND THAT INFORMATION CONTAINED IN THIS REPORT IS TRUE, ACCURATE, AND COMPLETE TO THE BEST OF MY KNOWLEDGE, INFORMATION AND BELIEF. DRILLERS NAME <u>Joseph L. Haggard</u> (PLEASE PRINT)	WRA USE ONLY (NOT TO BE FILLED IN BY DRILLER) T ☒ E.R.O.S. ☐ W O ☐ 70 72 74 75 76 TELESCOPE LOG OTHER DATA CASING INDICATOR AVAILABLE	DIAMETER OF SCREEN <u>56</u> (NEAREST INCH) FROM <u>56</u> TO <u>60</u> GRAVEL PACK <u>68</u> IF WELL DRILLED WAS A FLOWING WELL CIRCLE BOX ☒
--	---	--

HEALTH

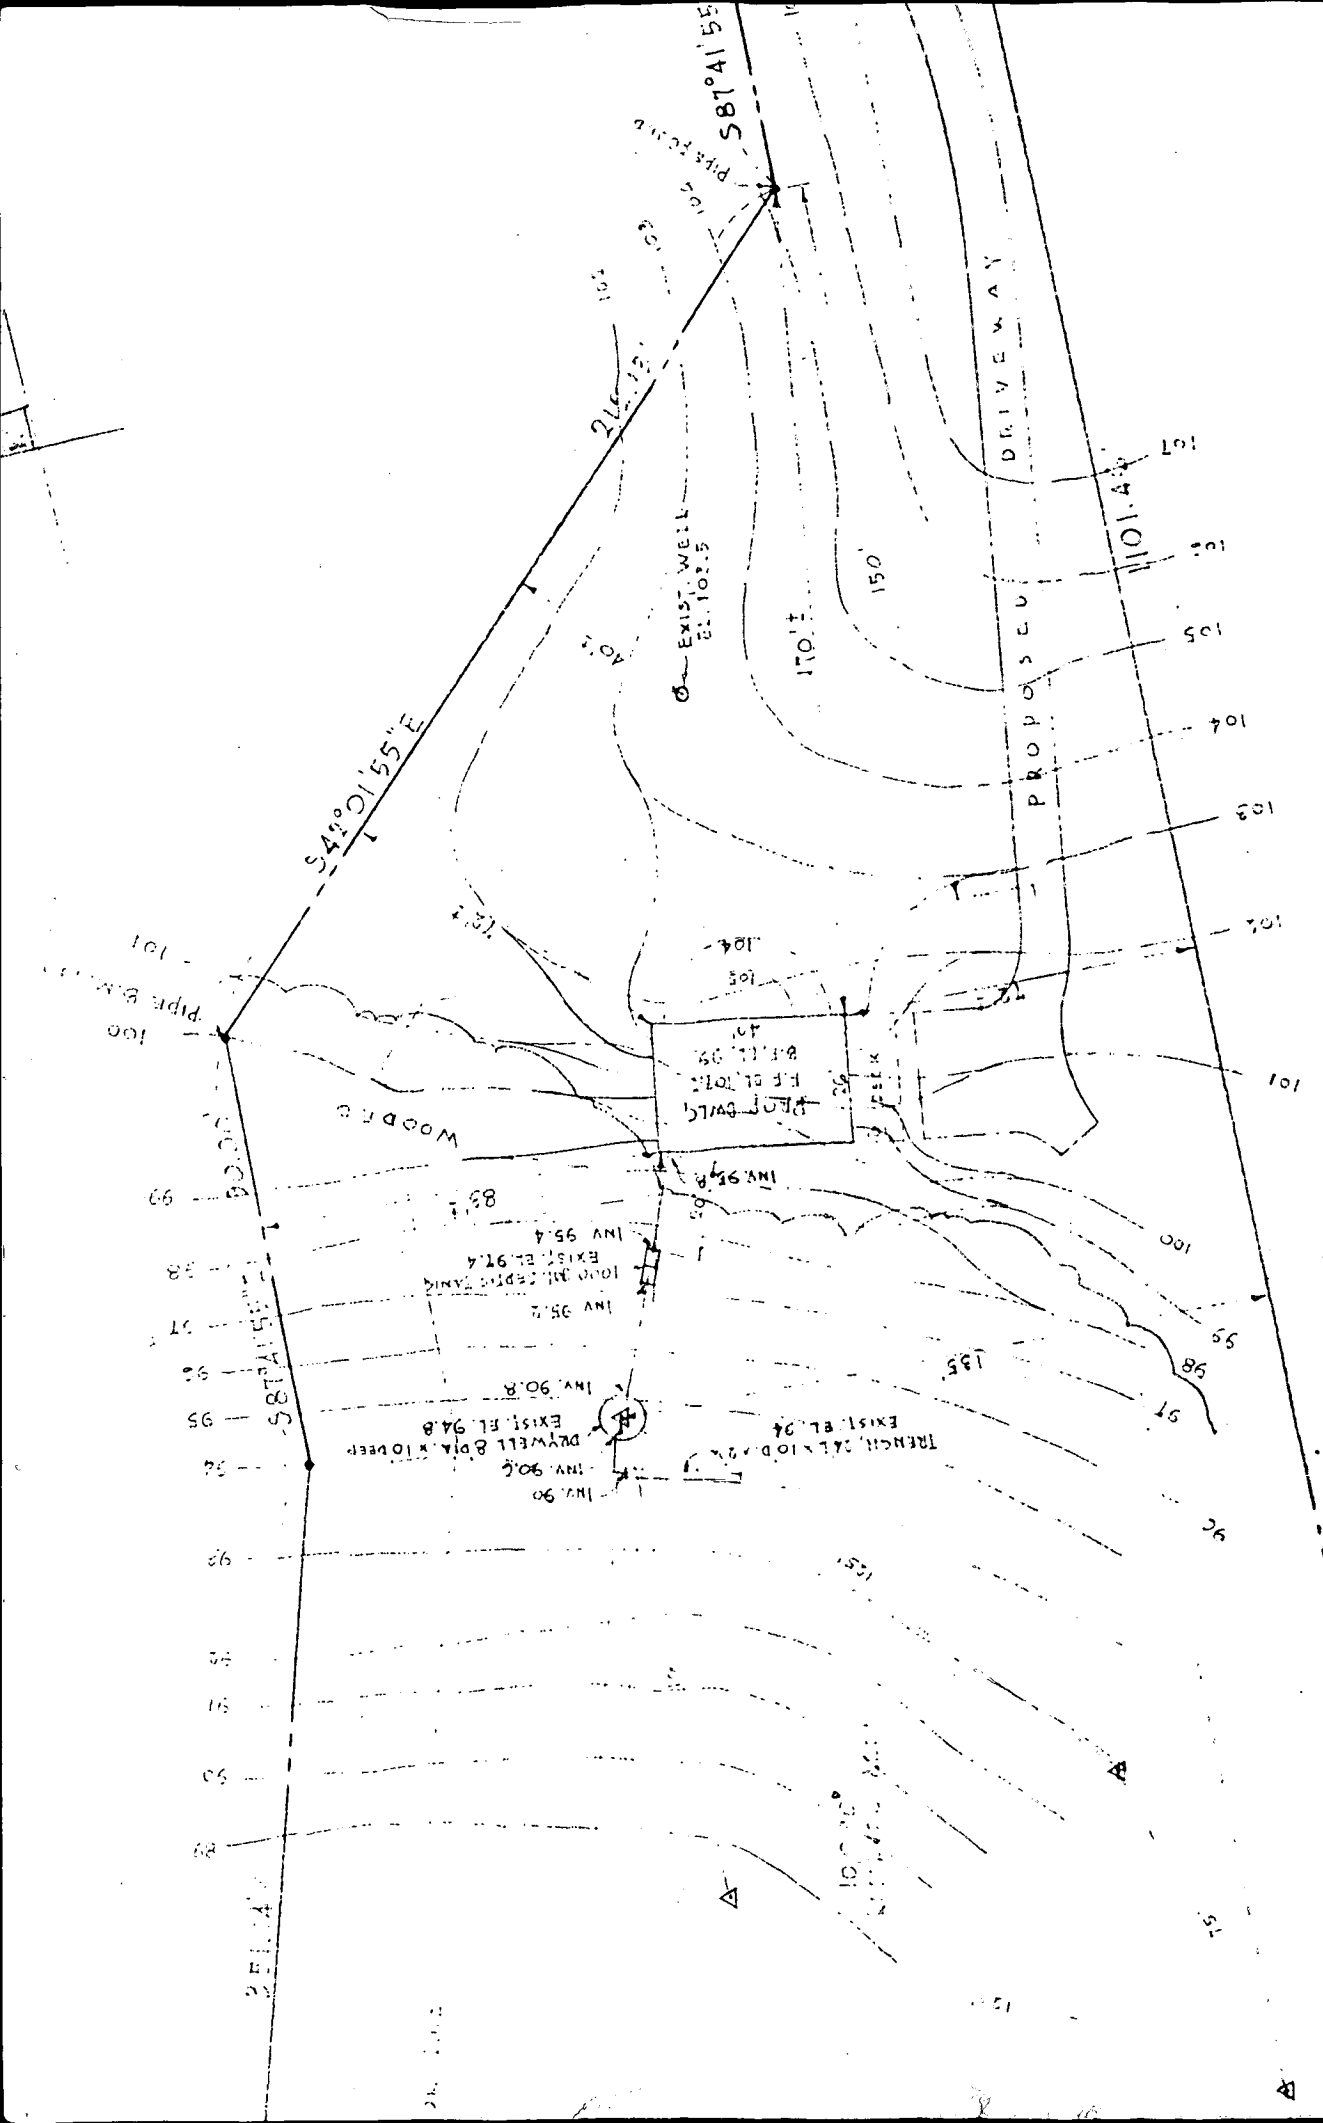

NOTE:
SEWER SYSTEM BY OWNER