

5-23-86
10/23/86

WPT

5-23-86

approved
S. Abel

PERMIT

P 36760

A 26166

SEWAGE DISPOSAL SYSTEM

MARYLAND STATE DEPARTMENT OF HEALTH

HOWARD COUNTY

BUREAU OF ENVIRONMENTAL HEALTH

461-9933

04-337492

INDEXED

ELLICOTT CITY

DISTRICT 4th

DATE 4/4/86

Olen Ketterman

IS PERMITTED TO INSTALL ☒ ALTER ☐

ADDRESS 14960 Frederick Road, Woodbine, MD 21797 PHONE 442-1336

SUBDIVISION Brantly ROAD 3334 Brantly Road LOT 7

PROPERTY OWNER John Hunter Robert Aylward

ADDRESS

IF GARBAGE GRINDER IS USED INCREASE SEPTIC TANK CAPACITY BY 50% AND ABSORPTION AREA BY 22%.

GARBAGE GRINDER? YES ☐ NO ☒

SEPTIC TANK CAPACITY 1000 GALLONS NUMBER OF BEDROOMS 3

BLDG. PERMIT SIGNED
AND RETURNED 9/30/86

Serial # BR 102356
2nd floor addition

TRENCHES - 270 sq. ft. per bedroom. Trench to be 2 feet wide. Inlet 4 feet below original grade. Bottom maximum depth 9 feet below original grade. Effective area begins at 4 feet below original grade. 5 feet of stone below distribution pipe.

LOCATION - Start the trench at a point 60 feet from the front lot line and 95 feet from the left sideline as seen when facing the lot from Brantly Road. Run the trench toward the right side of the lot.

NOTE - No trench to exceed 100 feet in length. If more than one trench used, a distribution box is required. Call for inspection of trench(s) before and after gravel is installed. Provide 6" - 8" diameter cleanout and cap to grade or above on septic tank.

4-4-86 WPT PIPES 42" below GRADE; well line 42-48" below GRADE

5-23-86 OK TO START TRENCH #2 - CAVING IN. S. Abel

PLANS APPROVED BY Raymond Hodges DATE 10/21/85

COVER NO WORK UNTIL INSPECTED AND APPROVED.

NEITHER THE HOWARD COUNTY COUNCIL NOR THE HEALTH DEPARTMENT IS RESPONSIBLE FOR THE SUCCESSFUL OPERATION OF ANY SYSTEM.

NOTE: IF TRENCH IS USED CALL FOR INSPECTION BEFORE AND AFTER PLACING GRAVEL IN TRENCH.

NOTE: NO DRY WELL SHALL EXCEED 15 FOOT IN DIAMETER. NO ABSORPTION TRENCH TO EXCEED 100 FEET IN LENGTH.

NOTE: ALL PIPE FROM HOUSE TO SEPTIC TANK MUST BE CAST IRON OR SCHEDULE 40 PVC OR ABS.

PERMIT VOID AFTER THREE YEARS.

NOTE: INSTALL STAND PIPE ON SEPTIC TANK AND DRY WELL. STAND PIPES MUST BE 6 INCHES IN DIAMETER. CAST IRON, CONCRETE OR TERRA COTTA, OR PVC OR ABS ACCEPTED. IF TOP OF SEPTIC TANK IS DEEPER THAN 3 FEET MANHOLE TO GRADE REQUIRED.

BLDG. PERMIT SIGNED
AND RETURNED 4-24-86

Serial # BR 111205


deck

*INSTALLER IS RESPONSIBLE FOR OBTAINING FINAL APPROVAL ON THIS PERMIT

*CALL 99-2330 FOR INSPECTION OF SEPTIC SYSTEMS.

EH - 2-1082

adelle

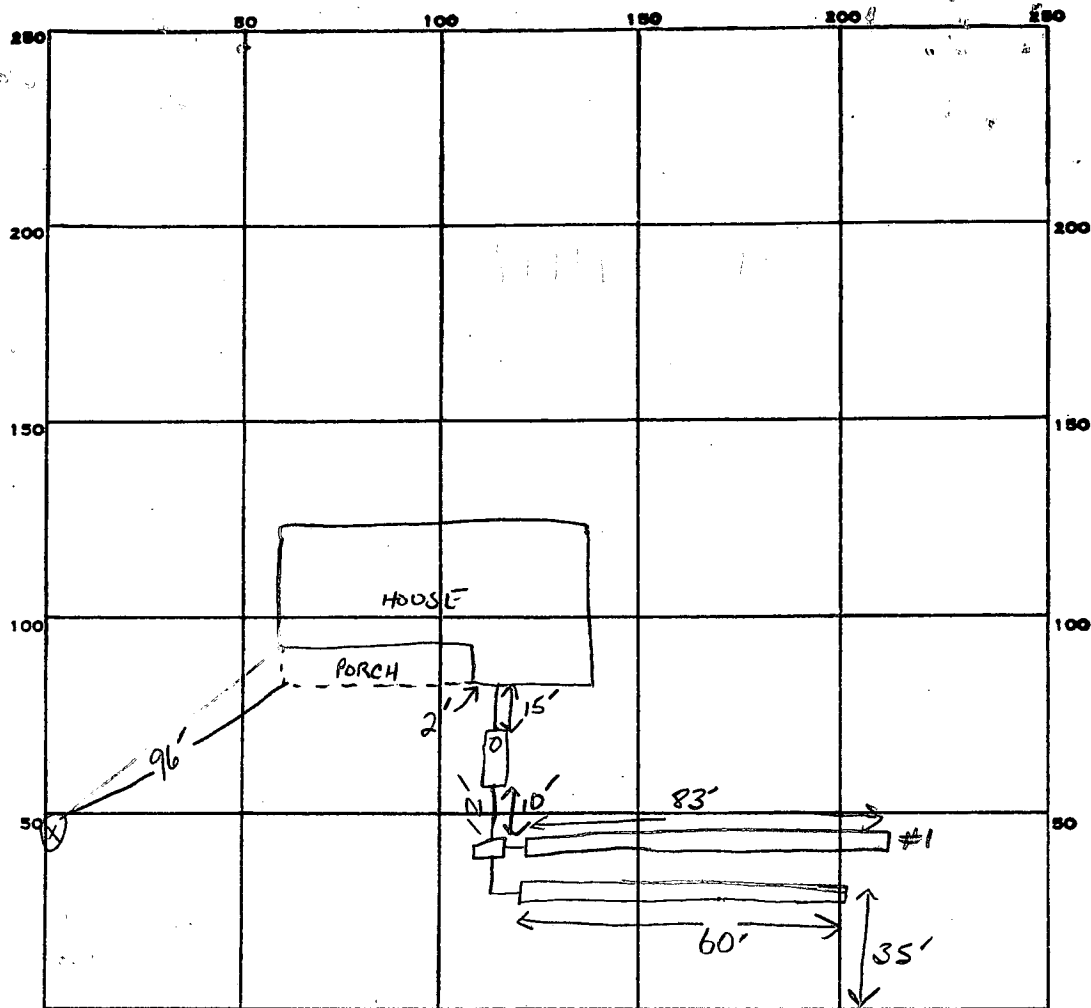

INDICATE NORTH. - NAME ADJOINING ROADWAY AS BASE LINE.

BRANTLY Rd.

PERMIT CARD ☒

SEPTIC TANK, LEVEL ☒ 1000 GAL

CLEANOUTS ☒ ST

DISTRIBUTION BOX, LEVEL ☒

TILE FIELD, DEPTH 10 FT. TRENCH WIDTH 2 FT.

INLET 4"

GRAVEL DEPTH 6 Ft IN. TOTAL LENGTH 83 ^① 60 ^② FT. TOTAL 143'

NUMBER OF TRENCHES 2 ONE SIDEWALL TOTAL BOTTOM AREA 858 ϕ

SEEPAGE PITS, INSIDE DIAMETER FT. DEPTH BELOW INLET FT.

ABSORBENT AREA 858 SQ. FT.

REMARKS 4-4-86 OK TO COVER HOUSE TO ST. S. Abel

5-22-84 OK TO COVER TRENCH #1 S. Abel

5-23-84 OK TO COVER ALL WORK

DATE SYSTEM APPROVED

5-23-86

INSPECTOR

S. Abel

APPLICATION

A 26166P 0

SEWAGE DISPOSAL TESTING

STATE OF MARYLAND - DEPARTMENT OF HEALTH AND MENTAL HYGIENE

HOWARD COUNTY HEALTH DEPARTMENT
ENVIRONMENTAL HEALTH SERVICESP. O. BOX 476, ELLICOTT CITY, MARYLAND 21043
TELEPHONE: 465-5000, EXT. 356DISTRICT 3 & 4DATE 6-21-77TO: THE COUNTY HEALTH OFFICER
ELLICOTT CITY, MARYLAND

I, HEREBY, APPLY FOR THE NECESSARY TEST IN ORDER TO CONSTRUCT (OR RECONSTRUCT) A SEWAGE DISPOSAL SYSTEM.

PROPERTY OWNER Brantly Associates John HunterADDRESS 218 Teachers Bldg PHONE 730-0810
Columbia Md. 21044PROPERTY LOCATION:
SUBDIVISION Brantly Sec 2 LOT NO. 7ROAD AND DESCRIPTION # 3334 Brantly RoadSIZE OF LOT 75,000 TYPE BLDG. 3 or 4
NUMBER OF BEDROOMS

IF NOT SINGLE RESIDENCE DESCRIBE _____

THE SYSTEM INSTALLED UNDER THIS APPLICATION IS ACCEPTABLE ONLY UNTIL PUBLIC FACILITIES BECOME AVAILABLE.

SIGNATURE OF APPLICANT Brantly Assoc. by James I Newburn
NewburnAPPROVED BY _____ FOR _____ DATE _____
(KIND OF SYSTEM)REJECTED BY _____ FOR _____ DATE _____
(KIND OF SYSTEM)


HOLD PENDING FURTHER TESTS _____ DATE _____

REASONS FOR REJECTION OR HOLDING 7/14/77 Final Plat OK for
Health Officer's sign BP 68059

THIS IS NOT A PERMIT

HIGH HOLES
USE EITHER
FOR DW

(H) = HIGH HOLE
(L) = LOW HOLE

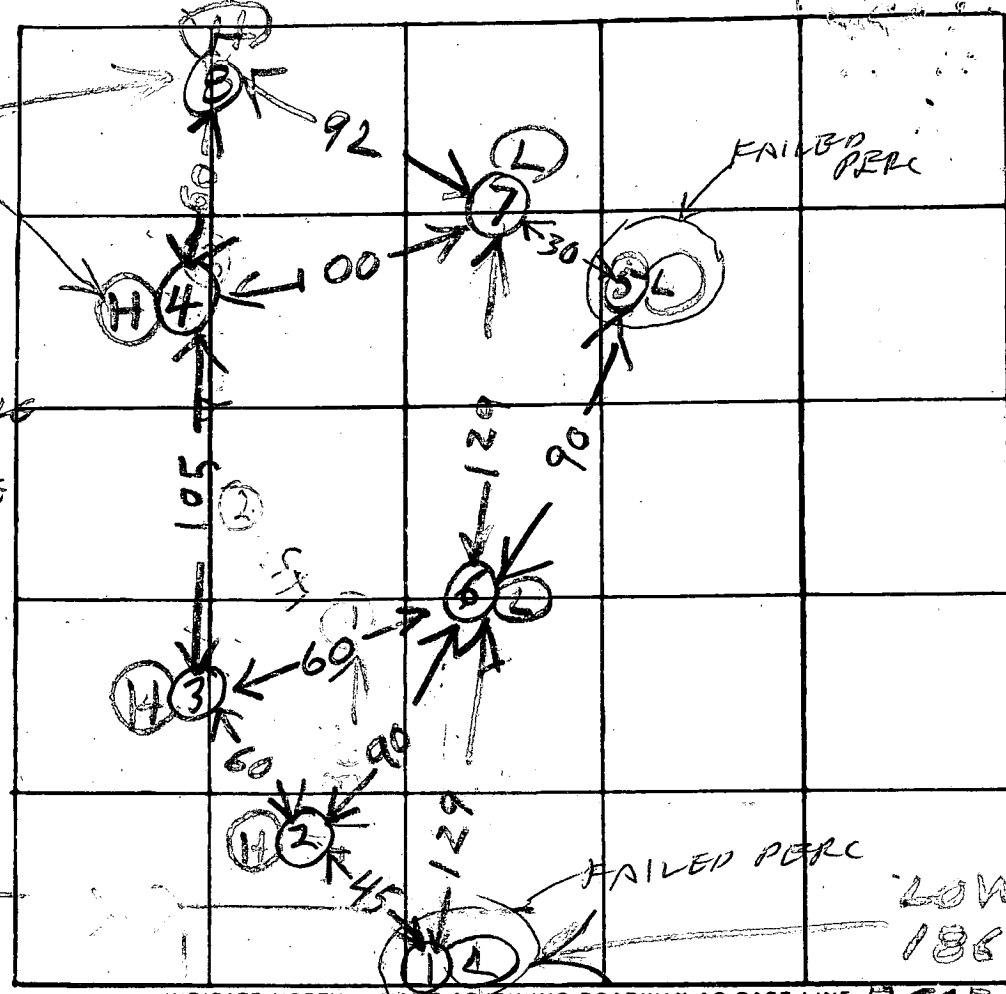

INDICATE NORTH - NAME ADJOINING ROADWAY AS BASE LINE

LOW HOLE
186 FT FROM
DEAD END BRANLEY
RD NEAR LOT 5B

DATE	TEST NO.	DEPTH	PRE-WET		TEST - 1" DROP		TIME
			START	STOP	START	STOP	
8/2/77	1D	14	1018	1027	1027	1037	10
	1S	6 1/2	1020	1107	little per failure		
	2S	5	1025	1032	1037	1052	20
	2D	13	1034	1037	1037	1047	10
	3S	5	1047	1054	1054	1102	8
	3D	14	1148	1150	1150	1156	6
	4D	13	1053	1100	1100	1115	15
	4S	3 1/2	1057	1100	1100	1107	7
	5D	12 1/2	1130	1200	1st inch 30 min failure		
8/2/77	5S	4 1/2	1132	1139	1139	1155	16
	6S	4	1226	1227	1227	1229	2

REMARKS 6D 13 1226 1244 Backhoe filled in hole

TYPE OF SOIL 7S 13 1244 100 100 118 18

TESTED BY 08V 14 139 146 146 158 10

08V 13 120 120 135 15

all sand ALSO PRESENT:

R HODGES

RICK OF BRITINGHAM RD
21M NEWBORN

7/25/84

APPLICATION FOR PITLESS ADAPTER, WELL PUMP AND PRESSURE TANK INSTALLATION

Howard County Health Department
Bureau of Environmental Health
3525-H Ellicott Mills Drive
Court House Square
Ellicott City, Md. 21043
461-9933

New Installation X
Replacement _____

Receipt # 36521
Date 2/11/84

Name of Installer Pipe-Rite Plumbing & Heating

Telephone 788-3080

License number 2214

Certified Well Pump Installer _____ Well Driller _____ Registered Plumber X

Name of Property Owner John Hunter

Telephone _____

Subdivision Brantly Lot # 7A Well tag # HO - 73 - 2947

Site Address 3334 Brantly Road

Pump

1. Type
a. Deep well jet _____
b. Shallow well jet _____
c. Submersible _____

2. Make _____

3. Model # _____

4. Capacity _____ GPM

5. Pump exceeds well capacity Yes _____ No _____

6. If Yes, is low pressure cutoff switch installed? Yes _____ No _____

7. What methods are used to protect the pump and electrical wiring from vibrations? Torque arrestors _____ Cable guards _____ Other _____

Motor

1. Horsepower _____
2. RPM _____
3. Voltage _____
a. 110 _____
b. 220 _____

Pitless Adapter

1. Make _____
2. Model # _____
3. Depth _____

Tank

1. Capacity _____
2. Pressure relief valve? _____

Piping

1. Type _____
2. Size _____
3. NSF and/or BOCA Code approved _____
4. Depth of supply line _____

Well data

1. Depth _____ ft.
2. Yield _____ GPM
3. Static water level _____ ft.
4. Will water supply be disinfected by installer? _____

7/25/85

PITLESS & LIVE SEE SEPTIC PERMIT; OODN LOCKED CANNOT APPROVE INSIDE WORK S-HR

I understand that it is my responsibility to notify the Howard County Health Department when the installation is ready for inspection (otherwise this permit is null and void).

All information given above is true to the best of my knowledge.



Signature of Applicant: _____

Date: _____

Note: A sticker indicating approval/status of the installation will be placed on the well casing at the time of the inspection.

C 1	2405	SEQUENCE NO. (WRA USE ONLY)	STATE OF MARYLAND WATER RESOURCES ADMINISTRATION TAWES STATE OFFICE BLDG., ANNAPOLIS, MD. 21401 WELL COMPLETION REPORT		THIS REPORT MUST BE SUBMITTED, WITHIN 30 DAYS, AFTER WELL COMPLETE FILL IN THIS FORM COMPLETELY COUNTY NUMBER
1 2 3 (SEQ. NO.) 6 (THIS NUMBER IS TO BE PUNCHED IN COLS. 3-6 ON ALL CARDS)		DATE RECEIVED (WRA USE ONLY) <u>Nov. 8 1978</u>		DEPTH OF WELL <u>125</u> 22 (TO NEAREST FOOT) 26	
DATE WELL COMPLETED		PERMIT NO. FROM "PERMIT TO DRILL WELL" <u>HC-77-2947</u> 28 29 30 31 32 33 34 35 36 37		DRILLERS IDENTIFICATION NO. <u>233</u>	
OWNER <u>Montgomery Building Corporation</u> LAST NAME <u>Montgomery</u> FIRST NAME <u>Corporation</u> STREET OR RFD <u>118</u> POST OFFICE <u>Columbia Md.</u>					
WELL LOG			GROUTING RECORD		
STATE THE KIND OF FORMATIONS PENETRATED, THEIR COLOR, DEPTH, THICKNESS AND IF WATER BEARING (USE ADDITIONAL SHEETS IF NECESSARY)			WELL HAS BEEN GROUTED (CIRCLE APPROPRIATE BOX) ☒ YES ☐ NO TYPE OF GROUTING MATERIAL (CIRCLE BOX) CEMENT ☒ BENTONITE CLAY ☐ NO. OF BAGS <u>12</u> NO. OF POUNDS <u>1128</u> GALLONS OF WATER <u>72</u> DEPTH OF GROUT SEAL (TO NEAREST FOOT) FROM <u>0</u> FT. TO <u>30</u> FT. (ENTER 0 IF FROM SURFACE)		
DESCRIPTION (USE ADDITIONAL SHEETS IF NECESSARY) <u>Sand</u> <u>45 125</u>			FEET FROM TO <u>0 48</u> <u>45 125</u>		
C 3			PUMPING TEST		
CHECK IF WATER BEARING			HOURS PUMPED (TO NEAREST HOUR) <u>2</u> PUMPING RATE (GALLONS PER MINUTE TO NEAREST GALLON) <u>11</u> METHOD USED TO MEASURE PUMPING RATE <u>LINE</u> WATER LEVEL: (DISTANCE FROM LAND SURFACE) BEFORE PUMPING <u>45</u> (NEAREST FOOT) WHEN PUMPING <u>5</u> (NEAREST FOOT) TYPE OF PUMPED USED (CIRCLE APPROPRIATE BOX) ☒ AIR ☐ PISTON ☐ TURBINE ☐ CENTRIFUGAL ☐ ROTARY ☐ OTHER (DESCRIBE BELOW) ☐ JET ☐ SUBMERSIBLE		
C 2			PUMP INSTALLED		
C 2 (SEQ. NO.) 6 DEPTH (NEAREST WHOLE FOOT) FROM <u>51</u> TO <u>125</u> 8 9 10 100			TYPE OF PUMP (WRITE APPROPRIATE LETTER IN BOX - SEE ABOVE: A, C, J, P, R, S, T, O) DRILLER WILL INSTALL PUMP (CIRCLE APPROPRIATE BOX) ☒ YES ☐ NO CAPACITY: GALLONS PER MINUTE (TO NEAREST GALLON) <u>31</u> <u>35</u> PUMP HORSE POWER <u>37</u> <u>41</u> PUMP COLUMN LENGTH (NEAREST FOOT) <u>43</u> <u>47</u>		
C 2			SCREEN RECORD		
SCREEN TYPE OR OPEN HOLE INSERT APPROPRIATE CODE BELOW ☒ STEEL ☐ BRASS OR BRONZE ☐ OPEN HOLE ☐ PLASTIC ☐ OTHER			C 2 (SEQ. NO.) 6 DEPTH (NEAREST WHOLE FOOT) FROM <u>51</u> TO <u>125</u> 8 9 10 100		
C 2			C 2		
C 2 (SEQ. NO.) 6 DEPTH (NEAREST WHOLE FOOT) FROM <u>51</u> TO <u>125</u> 8 9 10 100			C 2 (SEQ. NO.) 6 DEPTH (NEAREST WHOLE FOOT) FROM <u>51</u> TO <u>125</u> 8 9 10 100		
C 2			C 2		
C 2 (SEQ. NO.) 6 DEPTH (NEAREST WHOLE FOOT) FROM <u>51</u> TO <u>125</u> 8 9 10 100			C 2 (SEQ. NO.) 6 DEPTH (NEAREST WHOLE FOOT) FROM <u>51</u> TO <u>125</u> 8 9 10 100		
C 2			C 2		
C 2 (SEQ. NO.) 6 DEPTH (NEAREST WHOLE FOOT) FROM <u>51</u> TO <u>125</u> 8 9 10 100			C 2 (SEQ. NO.) 6 DEPTH (NEAREST WHOLE FOOT) FROM <u>51</u> TO <u>125</u> 		

GLENWOOD ESTATES SECTION TWO PLAT 3500

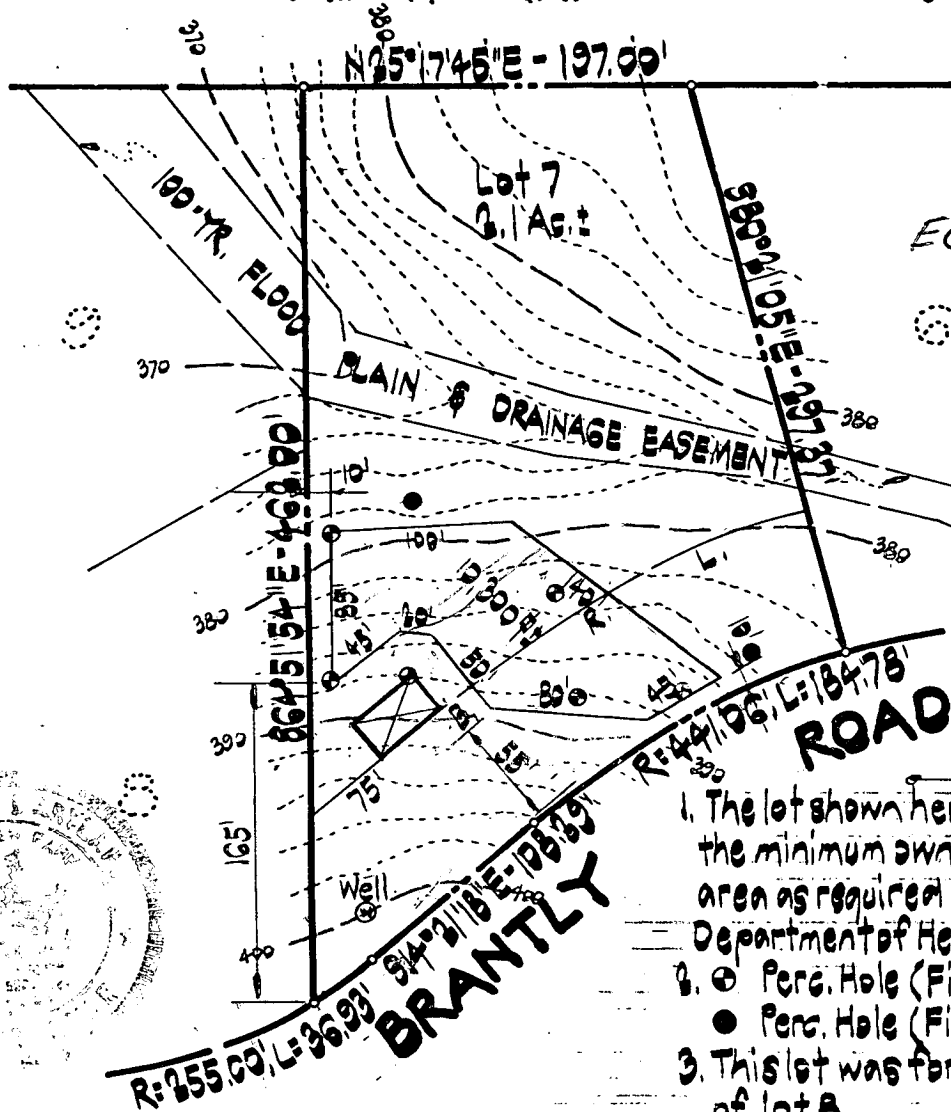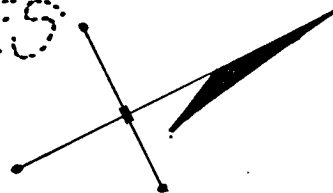

ELEVATIONS IN
DOUBT PER
FIELD RUN PLAT
BY FISHER, COLLINS, CARTER
11/20/85 CWL
SITE VERY RESTRICTED.

Notes

1. The lot shown hereon complies with the minimum ownership width and lot area as required by the Maryland State Department of Health and Mental Hygiene.
2. Perc. Hole (Field location)
 Perc. Hole (Field location) Bad Test
3. This lot was formerly lot 7 and part of lot 8.

I certify the measurements for the sewage disposal area and the sewage disposal area for this property is as designated.

APPROVED: For private water and private sewerage systems. Howard County Health Dept.

Walter Park

Walter Park, Md. Reg. No. 5539

5/26/1978

Date

Walter Park
County Health Officer

7-17-78

Date

GROVO & ASSOC., INC.

CIVIL ENGINEERING
LAND SURVEYING

8669 OAK ROAD
BALTIMORE, MD. 21234
301-661-9373

BRANTLY

SECTION TWO

BLOCK (A)

LOT 7

4TH ELECTION DIST. HOWARD CO., MD.
MAY 24, 1978 SCALE: 1"=100'

GLENWOOD ESTATES
SECTION TWO
PLAT # 3500
LOT 7

