

APPROVED
113180
RHJS
P 30108
A 26589

PERMIT

SEWAGE DISPOSAL SYSTEM

MARYLAND STATE DEPARTMENT OF HEALTH

HOWARD COUNTY

04-339 525

ELLICOTT CITY

DISTRICT 4th

DATE 12/10/79

INDEXED

Paul
Mr. Schissler

IS PERMITTED TO INSTALL ☒ ALTER ☐

ADDRESS 7311 Brangles Road, Marriottsville, Md. 21104 PHONE

SUBDIVISION Westcliffe Manor ROAD 13762 Barberry Way LOT 28

PROPERTY OWNER Howard Buckholtz

ADDRESS 10001 Paxton Road, Randallstown, Md.

SPECIFICATIONS 3 bedrooms-1000 gal. tank
4 bedrooms-1250 gal. tank

SEPTIC TANK CAPACITY GALLONS

DRAIN FIELD DEPTH FEET, BOTTOM AREA SQ. FT.

DEEP TRENCH DEPTH FEET, BOTTOM AREA SQ. FT.

SEEPAGE PITS ☒ ABSORBENT SIDE-WALL AREA 125 SQ. FT. per bedroom in system.

INLET PIPE 3 FT. BELOW ORIGINAL GRADE. MAXIMUM DEPTH 11 FT. BELOW ORIGINAL GRADE

EFFECTIVE DEPTH AT FT. BELOW ORIGINAL GRADE.

LOCATE DISPOSAL AREA 110 FT. FROM XXXXXXXX 175 FT. FROM right LOT LINE AS SEEN WHEN
FACING LOT FROM Barberry Way.

If dry well and trench are used, need a 5 ft. earth buffer between dry well and
trench. Trench is to follow the contour of the land.

PLANS APPROVED BY C.B. Streaker DATE 1978

COVER NO WORK UNTIL INSPECTED AND APPROVED.

NEITHER THE HOWARD COUNTY COUNCIL NOR THE HEALTH DEPARTMENT IS RESPONSIBLE FOR THE SUCCESSFUL OPERATION OF ANY SYSTEM.

NOTE: IF TRENCH IS USED CALL FOR INSPECTION BEFORE PLACING GRAVEL IN TRENCH.

NOTE: NO DRY WELL SHALL EXCEED 15 FOOT IN DIAMETER.

NOTE: ALL PIPE FROM HOUSE TO DISPOSAL AREA MUST BE CAST IRON.

PERMIT VOID AFTER THREE YEARS.

NOTE: INSTALL STAND PIPE ON SEPTIC TANK AND DRY WELL. STAND PIPES MUST BE 6 INCHES IN DIAMETER. CAST IRON, CONCRETE OR TERRA
COTTA ACCEPTED.


*INSTALLER IS RESPONSIBLE FOR OBTAINING FINAL APPROVAL ON THIS PERMIT.

OLD PERMIT SIGNED
3/23/2000
B00126104
DECK

A 26589

44
 $\frac{8}{352}$
 $\frac{184}{536}$
 23
 $\frac{8}{184}$

125
 $\frac{4}{500}$

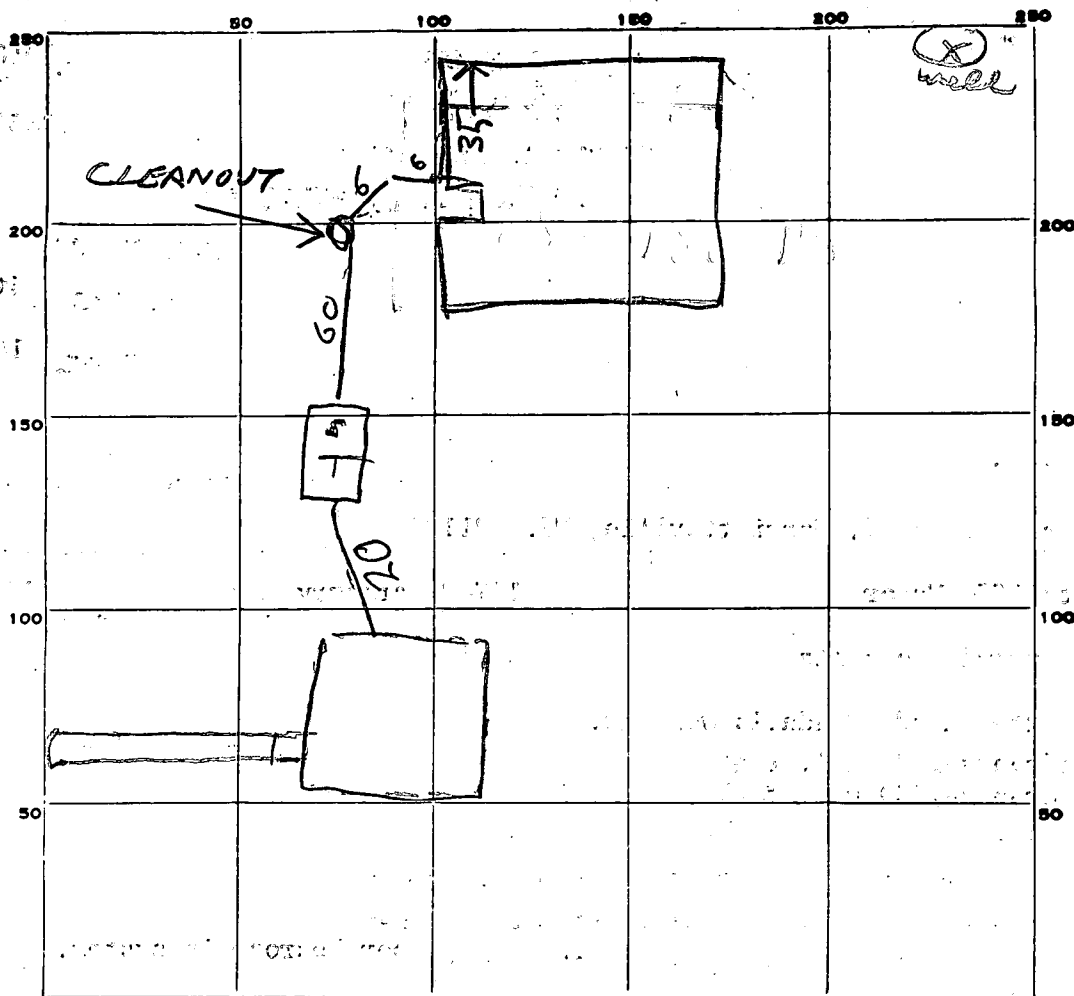

INDICATE NORTH - NAME ADJOINING ROADWAY AS BASE LINE.

Barberry Way

PERMIT CARD

SEPTIC TANK, LEVEL 1500

CLEANOUTS

ST	DW
OK	OK

DISTRIBUTION BOX, LEVEL

TILE FIELD, DEPTH 11 FT. TRENCH WIDTH 2 FT.

GRAVEL DEPTH 8 FT IN. TOTAL LENGTH 23 FT.

NUMBER OF TRENCHES 1 TOTAL BOTTOM AREA 184

SEEPADE PITS, INSIDE DIAMETER 45 FT. DEPTH BELOW INLET 8 FT.

ABSORBENT AREA 360 SQ. FT.

REMARKS 112180 OK to add gravel in trench.
112180 LOCATION OK. 4 BR 500 SPFT NEEDED
360 + 184 SPFT = 544 SPFT REQUIRED

DATE SYSTEM APPROVED

112180

INSPECTOR

Raymond Hodges & Jim Stayer

11
 12
 11
 5

PRELIMINARY

(C.B.D. write spec)

APPLICATION

New #28 ✓

A 26589

P _____

SEWAGE DISPOSAL TESTING

STATE OF MARYLAND - DEPARTMENT OF HEALTH AND MENTAL HYGIENE

HOWARD COUNTY HEALTH DEPARTMENT
ENVIRONMENTAL HEALTH SERVICESP. O. BOX 476, ELLICOTT CITY, MARYLAND 21043
TELEPHONE: 465-5000, EXT. 356

DISTRICT 4TH

DATE 8/15/77

Old #29, #30, #31

Septic Tank { 1-3 Bedrooms 1000 gallons
4 Bedrooms 1250 gallons* Dry well to have 125 sq. ft. effective
absorbent sidewall area per bedroom below
inlet. Inlet to be 3' below original grade and
maximum depth 11'. Location per plat:110' from Barbary Way and 175' from right
property line which faces lot from
Barbary WayTO: THE COUNTY HEALTH OFFICER
ELLICOTT CITY, MARYLANDI, HEREBY, APPLY FOR THE NECESSARY TEST IN ORDER TO CONSTRUCT (OR RECONSTRUCT) A SEWAGE
DISPOSAL SYSTEM.

PROPERTY OWNER J & B Partnership

ADDRESS 5632 Stevens Forest Rd., Apt. 254, Columbia 21045

PHONE Any questions call Ron Carter - 837-0194

PROPERTY LOCATION:

SUBDIVISION Westcliffe Manor

ROAD AND DESCRIPTION off Underwood Road 13762 Barbary Way

SIZE OF LOT 42,500 sq. ft.

TYPE BLDG. 3 or 4 bedrooms

NUMBER OF BEDROOMS

IF NOT SINGLE RESIDENCE DESCRIBE _____

THE SYSTEM INSTALLED UNDER THIS APPLICATION IS ACCEPTABLE ONLY UNTIL PUBLIC
FACILITIES BECOME AVAILABLE.

SIGNATURE OF APPLICANT /s/ Ron Carter

APPROVED BY C. B. D. Thacker FOR Dry well + 100' trench DATE 1/1/78
(KIND OF SYSTEM)REJECTED BY _____ FOR _____ DATE _____
(KIND OF SYSTEM)

HOLD PENDING FURTHER TESTS _____ DATE _____


REASONS FOR REJECTION OR HOLDING _____

BLDG. PERMIT SIGNED
AND RETURNED 8/14/79

Serial # 40949

THIS IS NOT A PERMIT

Terry Drive

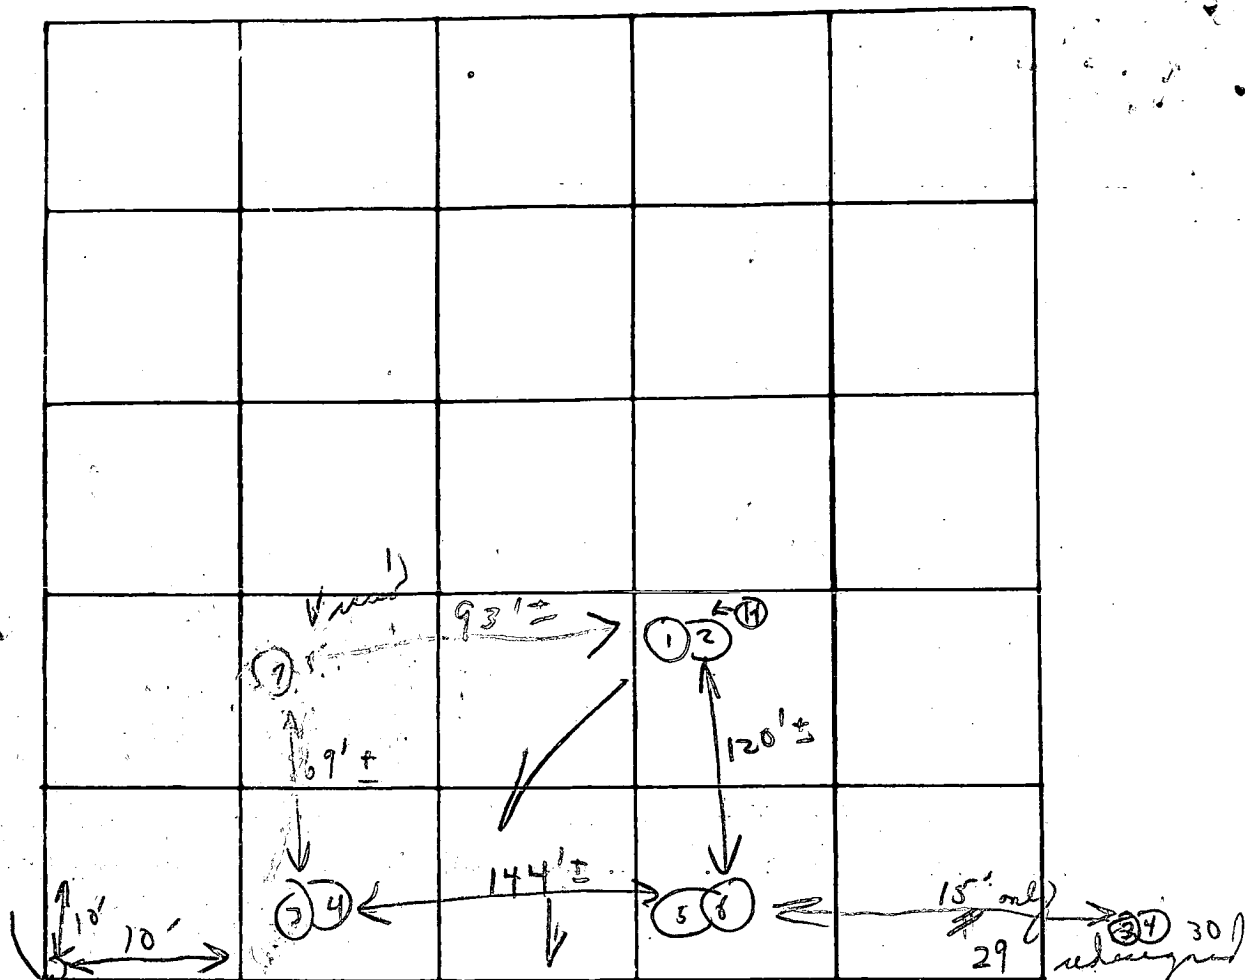

INDICATE NORTH - NAME ADJOINING ROADWAY AS BASE LINE

Barberry Way Jennifer Coast

New name

Soil Profile

DATE	TEST NO.	DEPTH	PRE-WET		TEST - 1" DROP		TIME
			START	STOP	START	STOP	
9/1/77	1	3'	1:44	1:46	1:46	1:50	4m
	2	11 1/2'	1:45	1:49	1:47	1:54	7m
	3	3 1/2'	1:49	1:53	1:53	1:59	6m
	④ 4	13'	1:49	1:53	1:53	1:58	5m
	5	4'	1:47	1:50	1:50	1:57	2m
	⑥ 6	11 1/2'	1:47	1:50	1:50	1:56	6m
	7	11 1/2'	Visual	sun in	to other		
							35

Below
day
look

ended 3'

6m

REMARKS

Open for

TYPE OF SOIL

TESTED BY

C. B. d

ALSO PRESENT:

Fyock 3m

PRELIMINARY

APPLICATION

A 26590

SEWAGE DISPOSAL TESTING

P _____

STATE OF MARYLAND - DEPARTMENT OF HEALTH AND MENTAL HYGIENE

HOWARD COUNTY HEALTH DEPARTMENT
ENVIRONMENTAL HEALTH SERVICES

DISTRICT 4th

P. O. BOX 476, ELLICOTT CITY, MARYLAND 21043
TELEPHONE: 465-5000, EXT. 356

DATE 8/15/77

TO: THE COUNTY HEALTH OFFICER
ELLICOTT CITY, MARYLAND

I, HEREBY, APPLY FOR THE NECESSARY TEST IN ORDER TO CONSTRUCT (OR RECONSTRUCT) A SEWAGE DISPOSAL SYSTEM.

PROPERTY OWNER J & B Partnership

ADDRESS 5632 Stevens Forest Rd., Apt. 254, Columbia 21045 PHONE Ron Carter - 837-0194

Any questions call

PROPERTY LOCATION:

SUBDIVISION Westcliffe Manor

old LOT NO. 50 *lot redesignated*
piece area

ROAD AND DESCRIPTION off Underwood Road

SIZE OF LOT 40,000 sq. ft.

TYPE BLDG. 3 or 4 bedrooms

NUMBER OF BEDROOMS

IF NOT SINGLE RESIDENCE DESCRIBE _____

THE SYSTEM INSTALLED UNDER THIS APPLICATION IS ACCEPTABLE ONLY UNTIL PUBLIC FACILITIES BECOME AVAILABLE.

SIGNATURE OF APPLICANT /s/ Ron Carter

APPROVED BY _____ FOR _____ DATE _____
(KIND OF SYSTEM)

REJECTED BY _____ FOR _____ DATE _____
(KIND OF SYSTEM)

HOLD PENDING FURTHER TESTS _____ DATE _____

REASONS FOR REJECTION OR HOLDING _____

THIS IS NOT A PERMIT

PRELIMINARY

APPLICATION

A 26596

SEWAGE DISPOSAL TESTING

P. _____

STATE OF MARYLAND - DEPARTMENT OF HEALTH AND MENTAL HYGIENE

HOWARD COUNTY HEALTH DEPARTMENT
ENVIRONMENTAL HEALTH SERVICES

P. O. BOX 476, ELLICOTT CITY, MARYLAND 21043
TELEPHONE: 465-5000, EXT. 356

DISTRICT 4th

DATE 8/16/77

TO: THE COUNTY HEALTH OFFICER
ELLICOTT CITY, MARYLAND

I, HEREBY, APPLY FOR THE NECESSARY TEST IN ORDER TO CONSTRUCT (OR RECONSTRUCT) A SEWAGE DISPOSAL SYSTEM.

PROPERTY OWNER J & B Partnership

ADDRESS 5632 Stevens Forest Rd., Apt. 254, Columbia 21045 PHONE Any questions call Ron Carter - 837-0194

PROPERTY LOCATION:

SUBDIVISION Westcliffe Manor LOT NO. old 31

ROAD AND DESCRIPTION off Underwood Road

SIZE OF LOT 41,500 sq. ft. TYPE BLDG. 3 or 4 bedrooms
NUMBER OF BEDROOMS

IF NOT SINGLE RESIDENCE DESCRIBE _____

THE SYSTEM INSTALLED UNDER THIS APPLICATION IS ACCEPTABLE ONLY UNTIL PUBLIC FACILITIES BECOME AVAILABLE.

SIGNATURE OF APPLICANT /s/ Ron Carter

APPROVED BY _____ FOR _____ DATE _____
(KIND OF SYSTEM)

REJECTED BY _____ FOR _____ DATE _____
(KIND OF SYSTEM)

HOLD PENDING FURTHER TESTS _____ DATE _____

REASONS FOR REJECTION OR HOLDING _____

THIS IS NOT A PERMIT

B 1	7966	SEQUENCE NO. (WRA USE ONLY)	STATE OF MARYLAND WATER RESOURCES ADMINISTRATION TAWES STATE OFFICE BLDG., ANNAPOLIS, MARYLAND 21401 APPLICATION FOR PERMIT TO DRILL WELL	WRA PERMIT NUMBER H0 73 3267
1 2 3 (SEQ. NO.) 6 (THIS NUMBER IS TO BE PUNCHED IN COLS. 3-6 ON ALL CARDS)			FILL IN THIS FORM COMPLETELY	

DATE RECEIVED (WRA USE ONLY) 5/23/79 1:30	<table style="width:100%;"> <tr> <td style="width:10%;">OWNER</td> <td style="width:40%; font-size: 1.2em; font-family: cursive;">BUCK HOLTZ</td> <td style="width:10%; text-align: center;">COL 15</td> <td style="width:10%; text-align: center;">LAST NAME</td> <td style="width:10%; text-align: center;">FIRST NAME</td> <td style="width:10%; text-align: center;">COL 34</td> </tr> <tr> <td colspan="6" style="border-top: 1px solid black;"></td> </tr> <tr> <td>STREET OR RD.</td> <td style="font-size: 1.2em; font-family: cursive;">10001 Paxton Rd.</td> <td style="text-align: center;">COL 36</td> <td colspan="3" style="text-align: center;">COL 55</td> </tr> <tr> <td colspan="6" style="border-top: 1px solid black;"></td> </tr> <tr> <td>POST OFFICE</td> <td style="font-size: 1.2em; font-family: cursive;">Randallstown, Md. 21133</td> <td style="text-align: center;">COL 57</td> <td colspan="3" style="text-align: center;">COL 76</td> </tr> </table>	OWNER	BUCK HOLTZ	COL 15	LAST NAME	FIRST NAME	COL 34							STREET OR RD.	10001 Paxton Rd.	COL 36	COL 55									POST OFFICE	Randallstown, Md. 21133	COL 57	COL 76		
OWNER	BUCK HOLTZ	COL 15	LAST NAME	FIRST NAME	COL 34																										
STREET OR RD.	10001 Paxton Rd.	COL 36	COL 55																												
POST OFFICE	Randallstown, Md. 21133	COL 57	COL 76																												

B 1	CONTINUED	DRILLER INFORMATION
1 2 3 (SEQ. NO.) 6		
DATE	5-1-79	COL 77
LICENSE NUMBER	290	COL 80
FIRST NAME	C. C. Campbell & Co. Inc.	COL 80
SIGNATURE	Charles C. Campbell	COL 80

B 2	WELL INFORMATION
1 2 3 (SEQ. NO.) 6	
MAXIMUM PUMPING RATE (GALLONS PER MINUTE)	
COL 77	
AVERAGE DAILY QUANTITY NEEDED (GALLONS PER DAY)	
COL 77	
USE FOR WATER (CIRCLE APPROPRIATE BOX)	
☒ HOME (SINGLE OR DOUBLE HOUSEHOLD UNIT ONLY) ☐ FARMING, AGRICULTURE, IRRIGATION ☐ INDUSTRIAL, COMMERCIAL, STATE AND FEDERAL GOVERNMENT. ☐ MUNICIPAL WATER SUPPLY ☐ PRIVATE WATER COMPANY ☐ TEST	
MUST HAVE STATE HEALTH DEPT. APPROVAL	

APPROXIMATE DEPTH OF WELL	COL 24	COL 26	FEET
APPROXIMATE DIAMETER OF WELL	COL 24	(NEAREST INCH)	

METHOD OF DRILLING USED (CIRCLE APPROPRIATE METHOD)		
BORED (OR AUGERED)	JETTED	DRIVEN
30-37 AIR-ROTARY	AIR-PERCUSSION	ROTARY (HYDRAULIC ROTARY)
CABLE	REVERSE-ROTARY	DRIVE-POINT
OTHER (DESCRIBE)		

REPLACEMENT OR DEEPEMED WELLS (CIRCLE APPROPRIATE BOX)	
☒ THIS WELL WILL NOT REPLACE AN EXISTING WELL. ☐ THIS WELL WILL REPLACE A WELL THAT WILL BE ABANDONED AND SEALED ☐ THIS WELL WILL REPLACE A WELL THAT WILL BE USED AS A STANDBY ☐ THIS WELL WILL DEEPEMED AN EXISTING WELL PERMIT NUMBER OF WELL TO BE REPLACED OR DEEPEMED (IF AVAILABLE)	

NOT TO BE FILLED IN BY DRILLER (WRA USE ONLY)	
APPROPRIATION PERMIT NUMBER	ENGINEER REVIEW DISTRICT NO.
COL 54	COL 65
FORCE	CONDITIONS
COL 67	COL 70

B 4	HEALTH DEPARTMENT APPROVAL
1 2 3 (SEQ. NO.) 6	
STATE HEALTH (CIRCLE BOX)	
COL 41	
DATE	5/9/79
APPROVED BY	Donald W. Monaghan

B 5	SPECIAL CONDITIONS 8-63 (WRA USE ONLY)
1 2 3 (SEQ. NO.) 6	

B 3	LOCATION OF WELL
1 2 3 (SEQ. NO.) 6	
COUNTY	Howard
COL 81	
SUBDIVISION	Westcliff MANOR
COL 81	
SECTION	28
COL 81	
NEAREST TOWN	Sykesville
COL 81	
MILES FROM TOWN (ENTER 0 IF IN TOWN)	3
COL 81	

B 4	DIRECTION FROM TOWN (CIRCLE APPROPRIATE BOX)
1 2 3 (SEQ. NO.) 6	
☒ NORTH ☐ EAST ☐ NE ☐ SE ☐ S ☐ SW ☐ W ☐ NW	
COL 81	
NEAR WHAT ROAD	Underwood Rd
COL 81	
ON WHICH SIDE OF ROAD (CIRCLE APPROPRIATE BOX)	S
COL 81	
DISTANCE FROM ROAD (ENTER DISTANCE AND CIRCLE APPROPRIATE BOX)	100
COL 81	


DRAW A SKETCH BELOW SHOWING LOCATION OF WELL IN RELATION TO NEARBY TOWNS ROADS AND STREAMS WITH NORTH IN THE DIRECTION OF THE ARROW, AND GIVE DISTANCE FROM WELL TO NEAREST ROAD JUNCTION OR STREAM CROSSING SHOWN ON THE SKETCH. ALSO SHOW, BY MEANS OF AN "X", THE WELL LOCATION IN THE BOX BELOW AND THE BOX NUMBER FROM THE WELL LOCATION MAP.

Forsythe Rd Underwood Rd Paxton Rd	5/23/79 94 WELL OK RH SEE OTHER SIDE
--	--

NORTH COORDINATE	EAST COORDINATE
COL 57	COL 57
ELEVATION AT WELL HEAD (FEET)	COL 57

A 26589

HEALTH

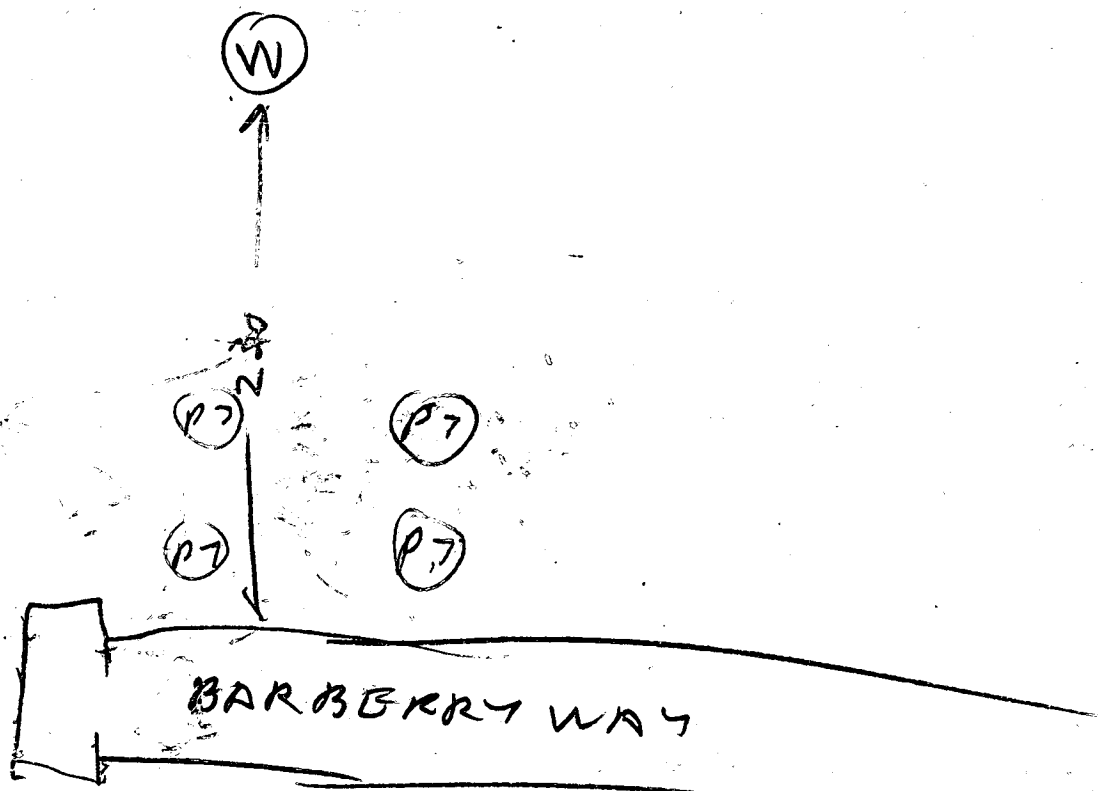


- ① 40' CASING WITH 2' OUT OF GROUND
- ② LOCATION OK
- ③ 37 FT OPEN HOLE
- ④ 8 BAGS USED
- ⑤ WELL OK

5/23/79

HOWARD COUNTY
HEALTH DEPT.
ELLIOTT CITY, MD.

MAY 14 1 46 PM '79

RECEIVED

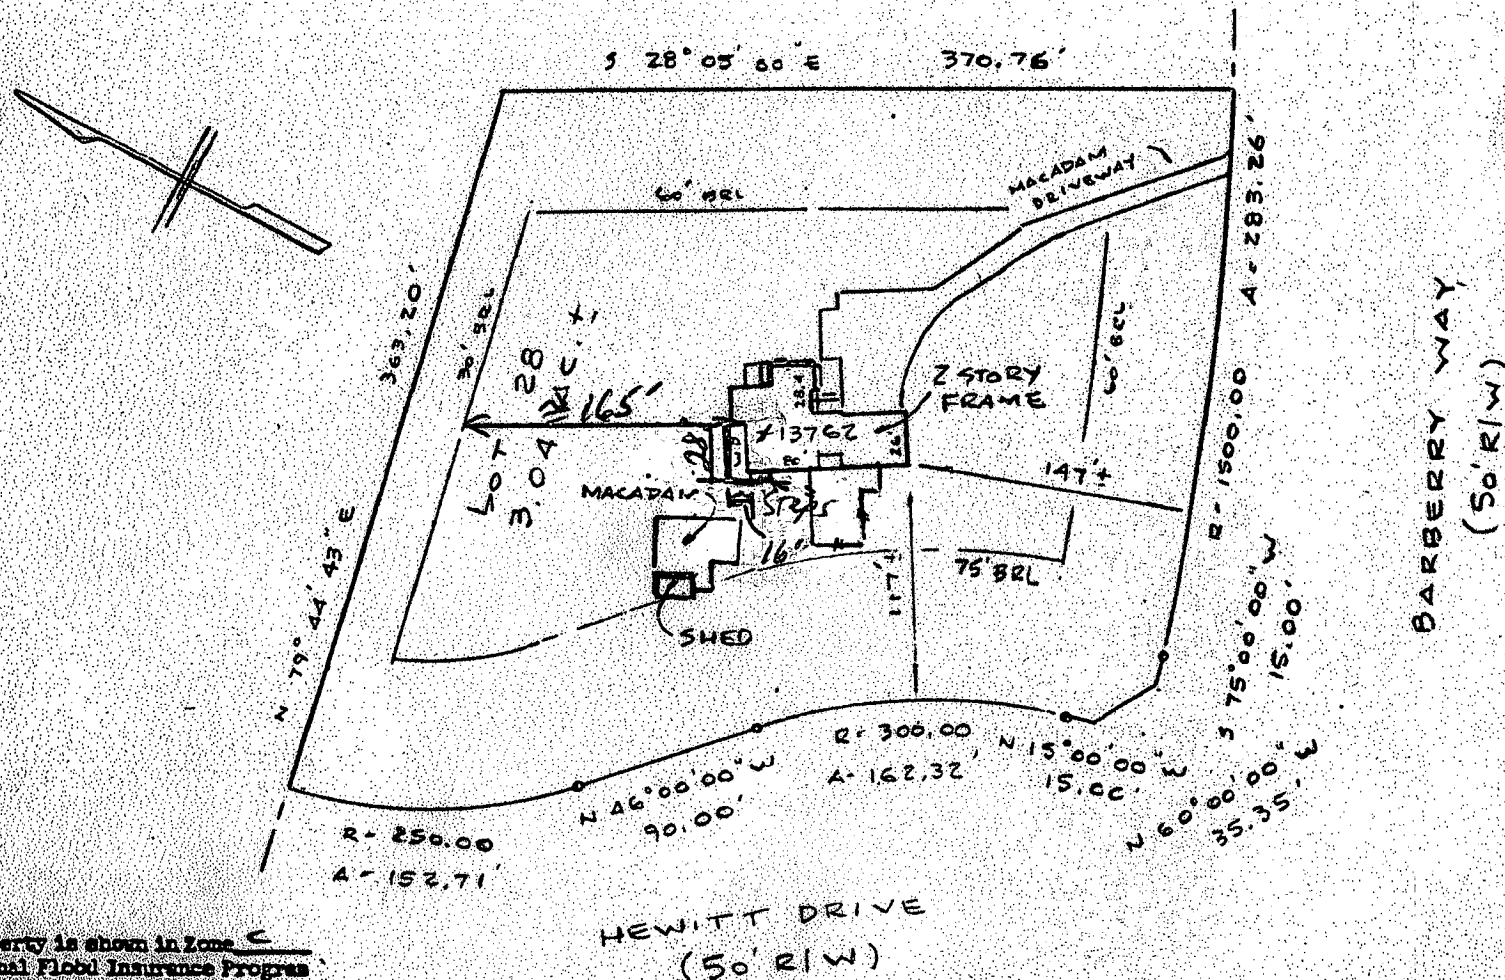

Subject property is shown in Zone C
 on the National Flood Insurance Program
 Flood Insurance Rate Map of HOWARD
 County, Maryland. Panel #
 Community Panel # PA080
 Effective Date: 1/1/00

This is to certify that I have surveyed the property
 known as Lot 28
 13762 BARBERRY WAY
 sheet of recorded PLAT NO. 4045 among the
 Land Records of HOWARD County, Maryland for the
 purpose of locating the improvements thereon.

THIS PLAT SHOWS ONLY THAT THE IMPROVEMENTS ARE
 CONTAINED WITHIN THE OUTLINES OF THE LOT AND IS
 NOT TO BE USED TO ESTABLISH PROPERTY LINES.





J. Carl Hudgins PLS#96

LOCATION SURVEY

13762 BARBERRY WAY
 WESTCLIFFE MANOR
 4th ELECTION DISTRICT
 HOWARD COUNTY, MD.

NTT ASSOCIATES, INC.
 16205 Old Frederick Road
 Mt. Airy, Maryland 21771
 Phone 442-2031

Scale	1" = 100'
Date	OCTOBER 15, 1998
Field By	JCH
Drawn By	JCH
Drawing #	C984552C

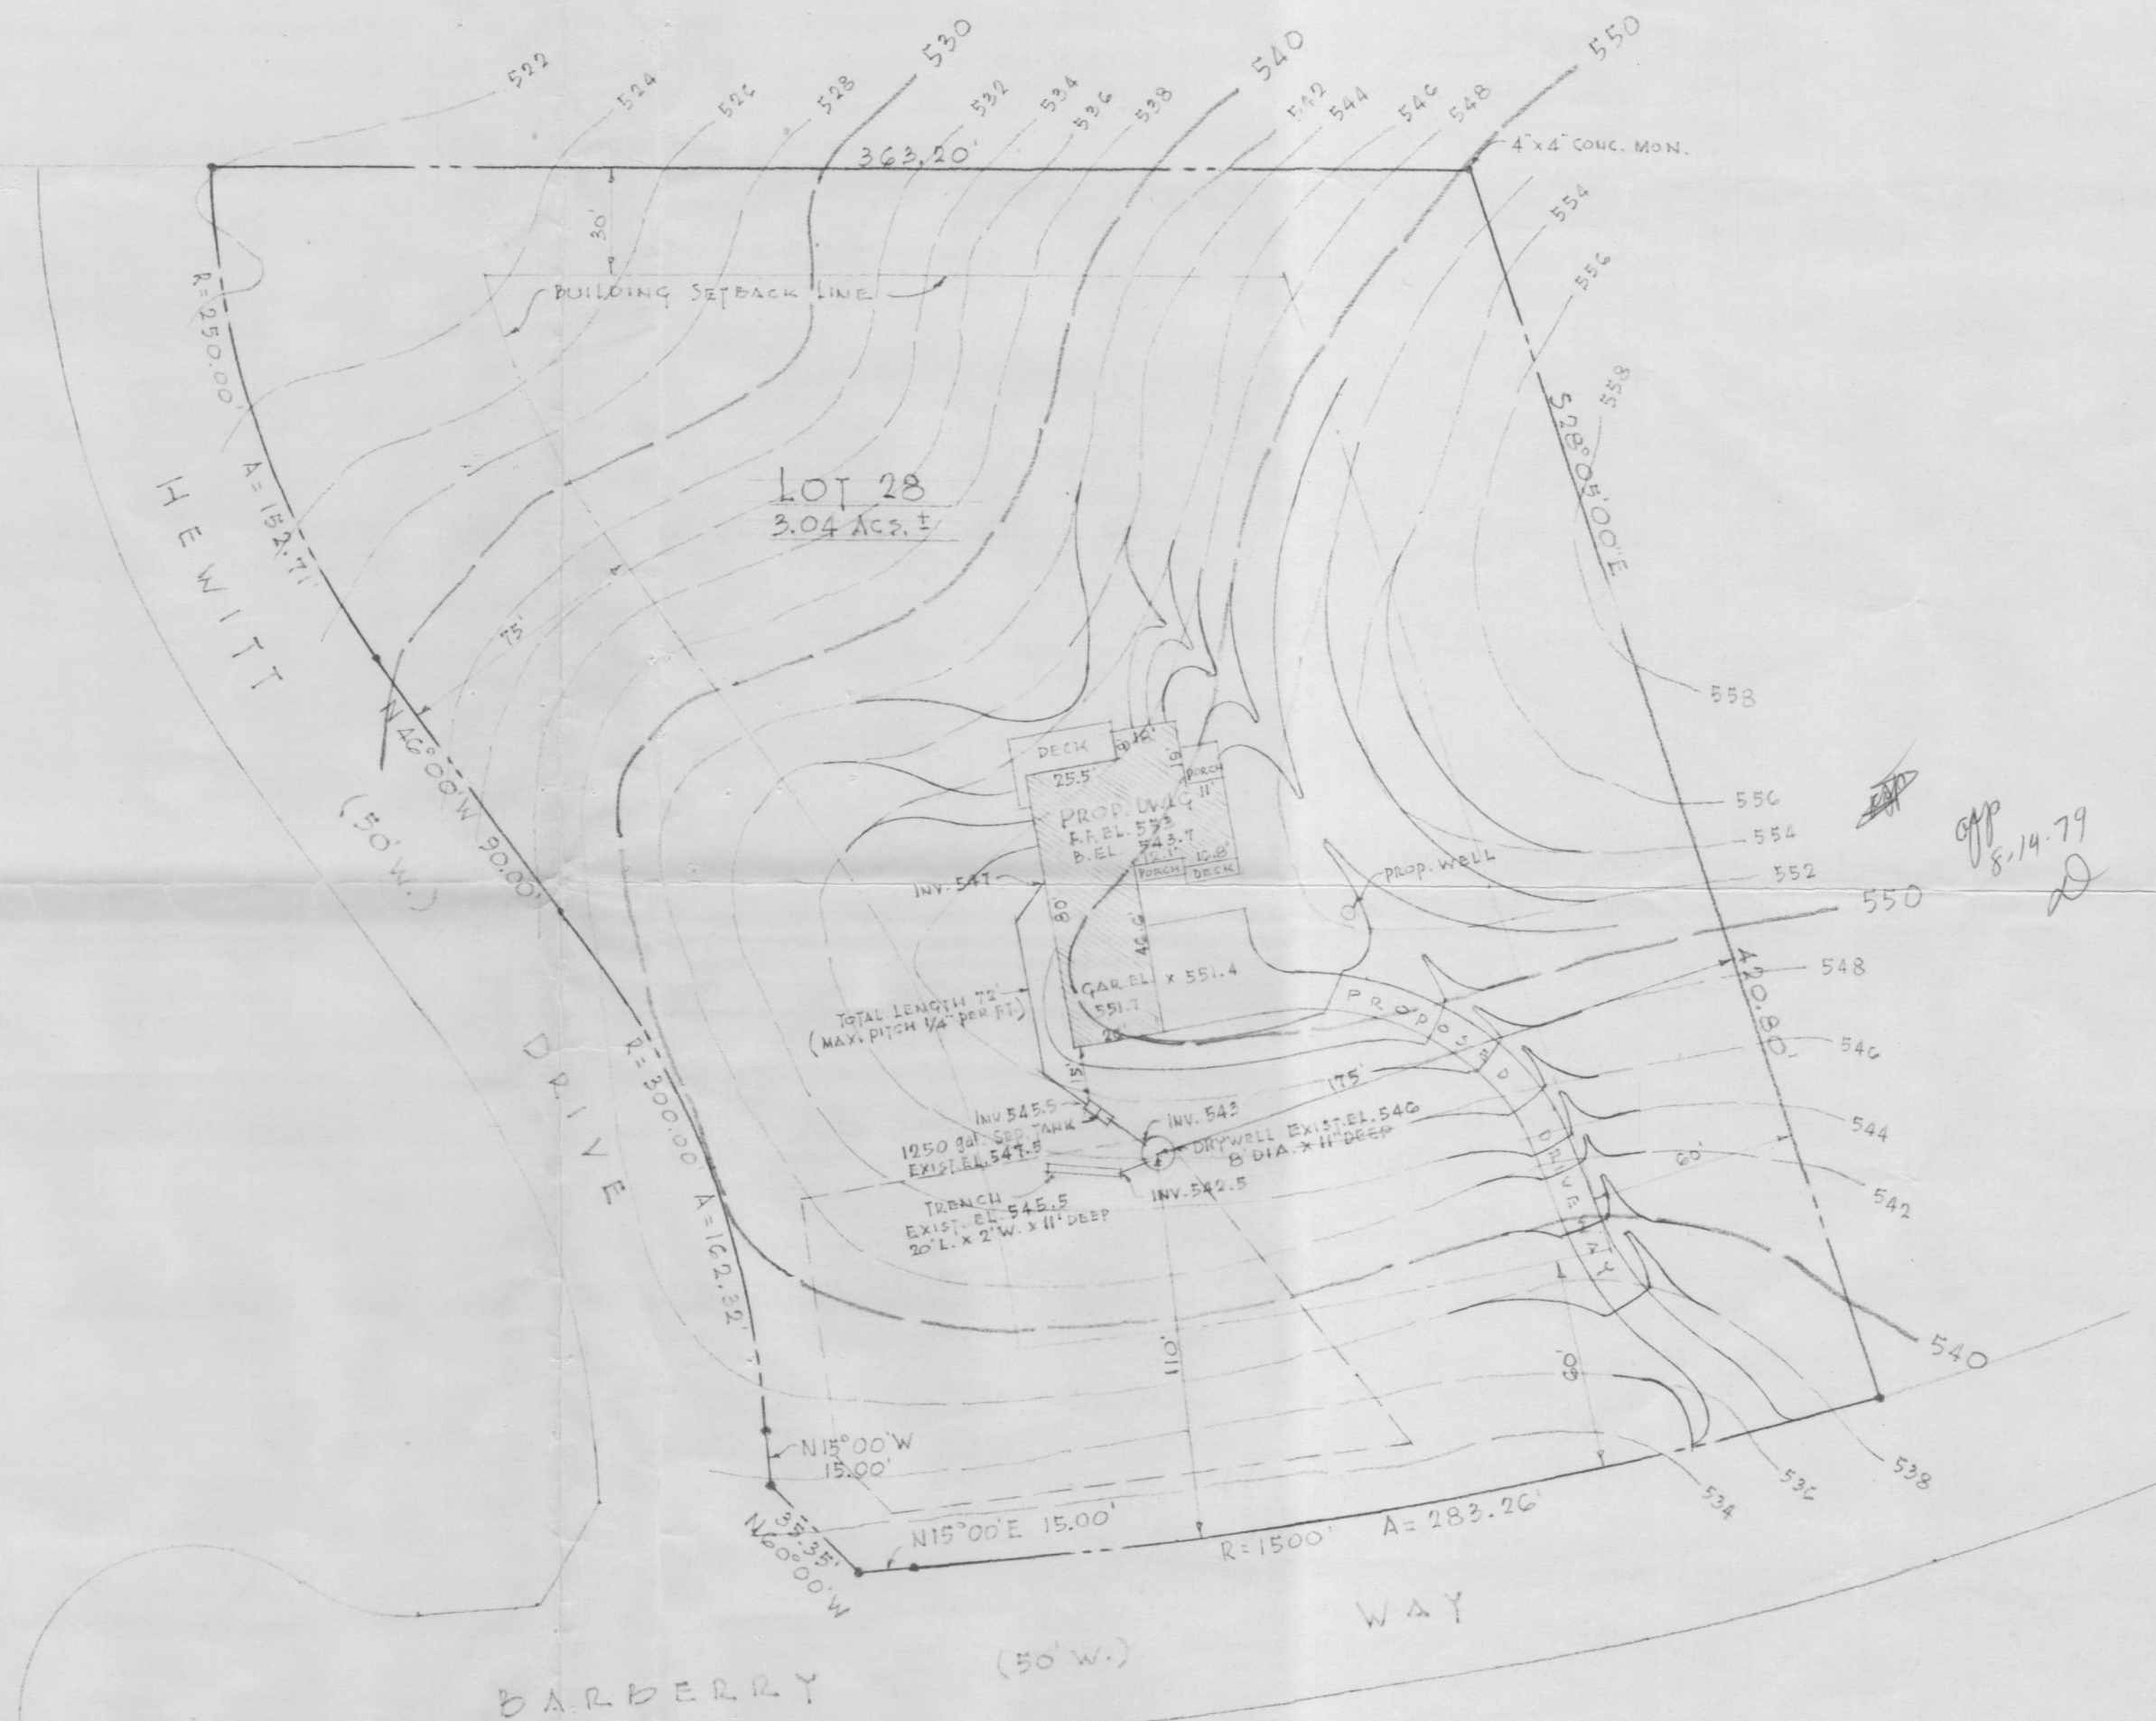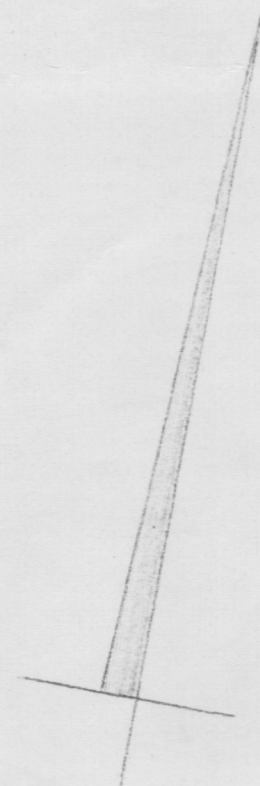

PLOT PLAN
SCALE: 1" = 50'

PROPERTY OF
MR. & MRS. HOWARD BUCKHOLTZ
"WESTCLIFFE MANOR"
4TH ELEC. DIST., HOWARD COUNTY, MD.
LIBER 0913, FOLIO 057

7/27/79 g/a