

LAYOUT 7/9/02 1:00 INSP 4
LAYOUT 7/11/02 11:00 INSP 5
INSP 3 8/12/02 PU 11-12 INSP 6

05-388848

ISSUE DATE: 7/8/2002

APPROVAL DATE: 8/2/02

**PERMIT
INDEXED**

P 517353

A 26644

**ON-SITE SEWAGE DISPOSAL SYSTEM
HOWARD COUNTY HEALTH DEPARTMENT
BUREAU OF ENVIRONMENTAL HEALTH**

Fogle's Septic Clean, Inc. IS PERMITTED TO INSTALL ☒ ALTER ☐

ADDRESS: 580 Obrecht Rd., 21784 PHONE NUMBER: 410-795-5670

SUBDIVISION: Simpson Woods LOT NUMBER: 13

ADDRESS: 7326 Meadowood Way PROPERTY OWNER: Saslow Homes, Inc.

SEPTIC TANK CAPACITY (GALLONS): 1250 OUTLET BAFFLE FILTER REQUIRED ☐

PUMP CHAMBER CAPACITY (GALLONS): N/A COMPARTMENTED TANK REQUIRED ☐

NUMBER OF BEDROOMS: 4

SQUARE FEET PER BEDROOM: 180

LINEAR FEET OF TRENCH REQUIRED: 240 HOUSE SERVED BY PUBLIC WATER ☐

TRENCHES:	Trench to be 3.0 feet wide. Inlet 3.0 feet below original grade. Bottom maximum depth 5.0 feet below original grade. Effective area begins at 4.0 feet below original grade. 2.0 feet of stone below distribution pipe.
LOCATION:	Place the distribution box as shown on the approved site plan. Run trenches on contour.
NOTES:	

PLANS APPROVED: Frank Skinner SKR 7/10/02 DATE: 5/31/2002

NOTES: PERMIT VOID AFTER 2 YEARS

CONTRACTOR IS RESPONSIBLE FOR SCHEDULING A PRE-CONSTRUCTION INSPECTION FOR ALL INSTALLATIONS

WATERTIGHT SEPTIC TANKS REQUIRED

ALL PARTS OF SEPTIC SYSTEM SHALL BE 100 FEET FROM ANY WATER WELL UNLESS SPECIFICALLY AUTHORIZED

MANHOLE RISERS REQUIRED ON ALL SEPTIC TANKS AND PUMP CHAMBERS UNLESS SPECIFICALLY AUTHORIZED


CONTRACTOR RESPONSIBLE FOR COMPLIANCE WITH APPLICABLE REGULATIONS, GUIDELINES AND THE TERMS OF THIS PERMIT

**NEITHER THE HOWARD COUNTY COUNCIL NOR THE HEALTH DEPARTMENT IS
RESPONSIBLE FOR THE SUCCESSFUL OPERATION OF ANY SYSTEM
PERMITTEE RESPONSIBLE FOR OBTAINING FINAL APPROVAL ON THIS PERMIT
BUILDING PERMIT SIGNED 13-2640 FOR INSPECTION OF SEPTIC SYSTEM
AND RETURNED**

11/22/03 B00140016 1000 gal ug Propane Tank

A26644

NOT TO SCALE

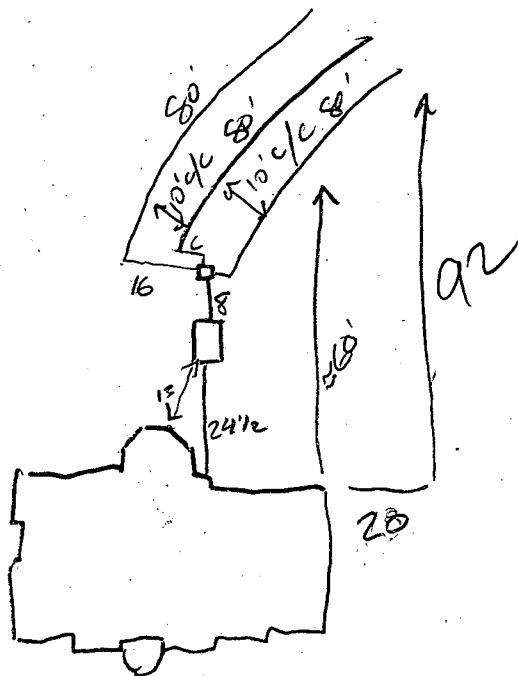

ROAD

TRENCH/DRAINFIELD DATA		
WIDTH	INLET	BOTTOM
3	3	50
NUMBER OF TRENCHES		3
TOTAL LENGTH		240
ABSORPTION AREA		720
DISTRIBUTION BOX LEVEL		✓
DISTRIBUTION BOX BAFFLE		✓
DISTRIBUTION BOX PORT		N/A

SEPTIC TANK DATA	
SEPTIC TANK 1 LEVEL	
CAPACITY	1250 GAL
SEAM LOC	46
TANK LID DEPTH	21 1/2
BAFFLES	✓
BAFFLE FILTER	N/A
MANHOLE LOC	middle
6" PORT LOC	front
WATERTIGHT TEST	N/A
SEPTIC TANK 2 LEVEL	
CAPACITY	N/A
SEAM LOC	
TANK LID DEPTH	
BAFFLES	
BAFFLE FILTER	
MANHOLE LOC	
6" PORT LOC	
WATERTIGHT TEST	

PRE-CONSTRUCTION

7/11/02 Lot staked, Layout per B.P. Pile of dirt needs to be moved off SRA (SC)

INSTALLATION

8/2/02 installed 3-80' trenches w/ 7' edge to edge
O.K. backfill (SB)

BUILDING PERMIT SIGNED
AND RETURNED

FINAL INSPECTOR

[Signature]

DATE OF APPROVAL

8/2/02

Wall Check 16-25-02
Top of Wall Elev. 1404.6

NOTE: This Lot appears to lie in an area classified as Zone C, area of minimal flooding as shown on FIRM MAP of Howard County, Maryland, Community Panel Number 240044038B, Panel 38 of 45, dated December 4, 1986.

Private Sewage Easement -
Modification As Accepted,
By The Howard County Health
Department

20' Drainage Easement


CONSUMER INFORMATION

- 1) This plat is of benefit to the consumer only insofar as it is required by a lender of a title insurance company or its agent in connection with contemplated transfer, financing or refinancing purposes;
- 2) This plat is not to be relied upon for the establishment or location of fences, garages, buildings or other existing or future structures;
- 3) This plat does not provide for the accurate identification of property boundary lines, but such identification may not be required for the transfer of title or for securing financing or refinancing.

SURVEYOR'S CERTIFICATE

I hereby certify that a field survey of this property has been made under my supervision for the purpose of locating improvements shown hereon, and that they are located as shown.



26 June 02
DATE
William J. Macken

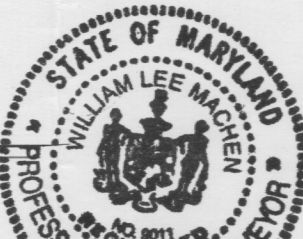

NOTES:
1. The setback distance accuracy = 1'.

Plat Reference: PLAT 4564

CLARK • FINEFROCK & SACKETT, INC. ENGINEERS • PLANNERS • SURVEYORS 7135 MINSTREL WAY • COLUMBIA, MD 21045 • (410) 381-7500 BALT. • (301) 621-8100 WASH.	
DESIGNED	LOCATION DRAWING 7326 MEADOW WOOD WAY LOT 13 SIMPSON WOODS LOTS 1 THRU 26 SECTION 3 AREA 1 5TH ELECTION DISTRICT HOWARD COUNTY, MARYLAND
DRAWN	
CHECKED	
PAS	
SCALE: 1" = 30'	
JOB NO.	

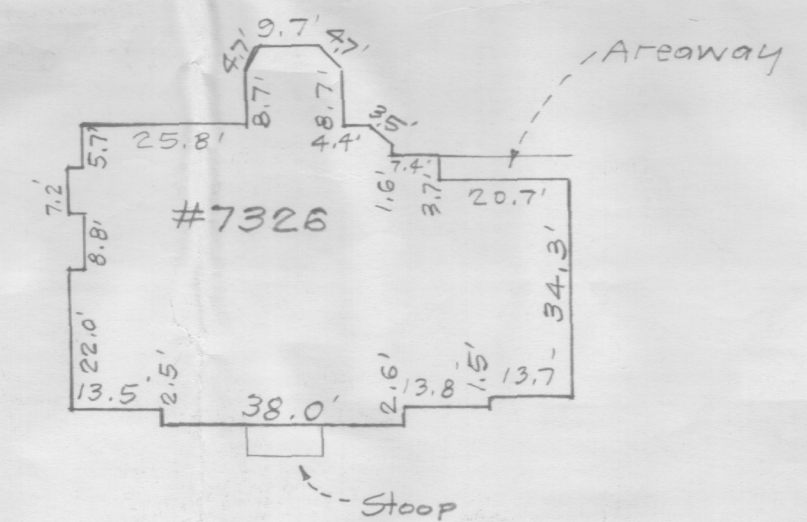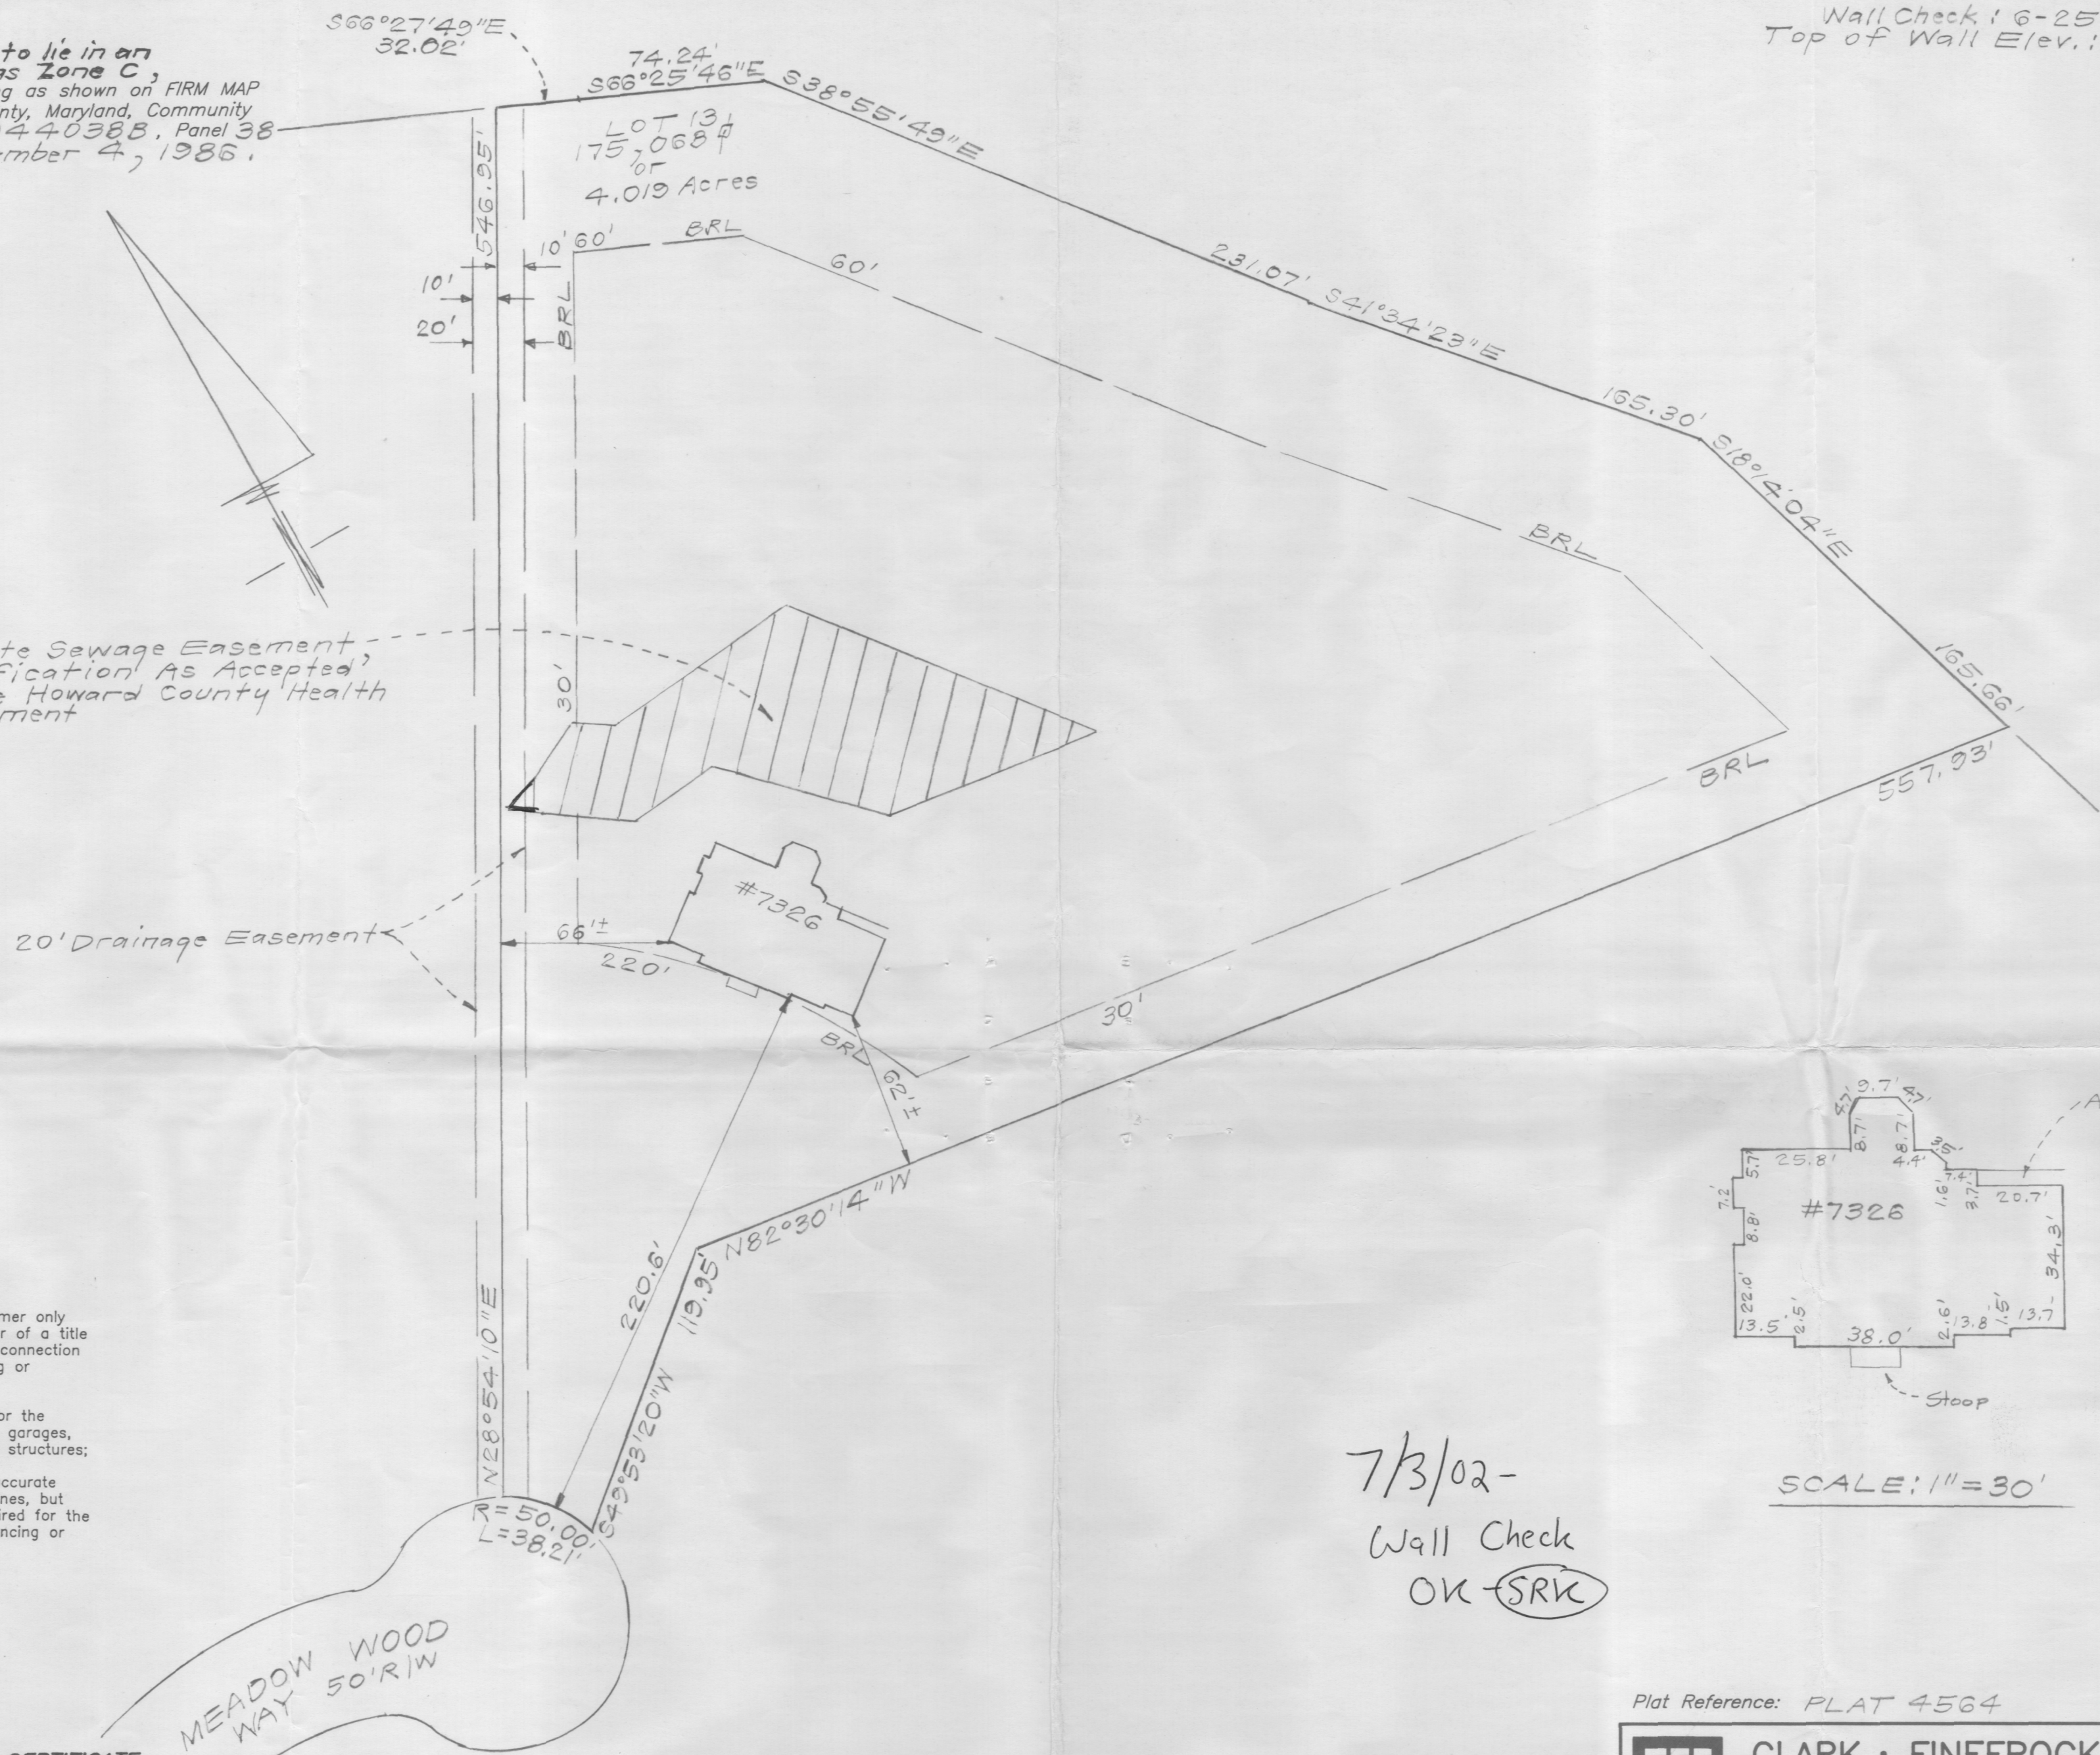

7/3/02-
Wall Check
OK (SRK)

J.D. JUDGE
LIBER 225 FOLIO 351

N 491.000
E 824.000

N 491.000
E 824.500

Total linear feet of trench
... required 240 feet


Width of trench(es) 3 feet

Depth of trench(es) 5 feet

Depth of stone required below
distribution pipe 2 feet

Approved Septic System Plan
Howard County Health Department

[Signature] 5.31
Signature Date

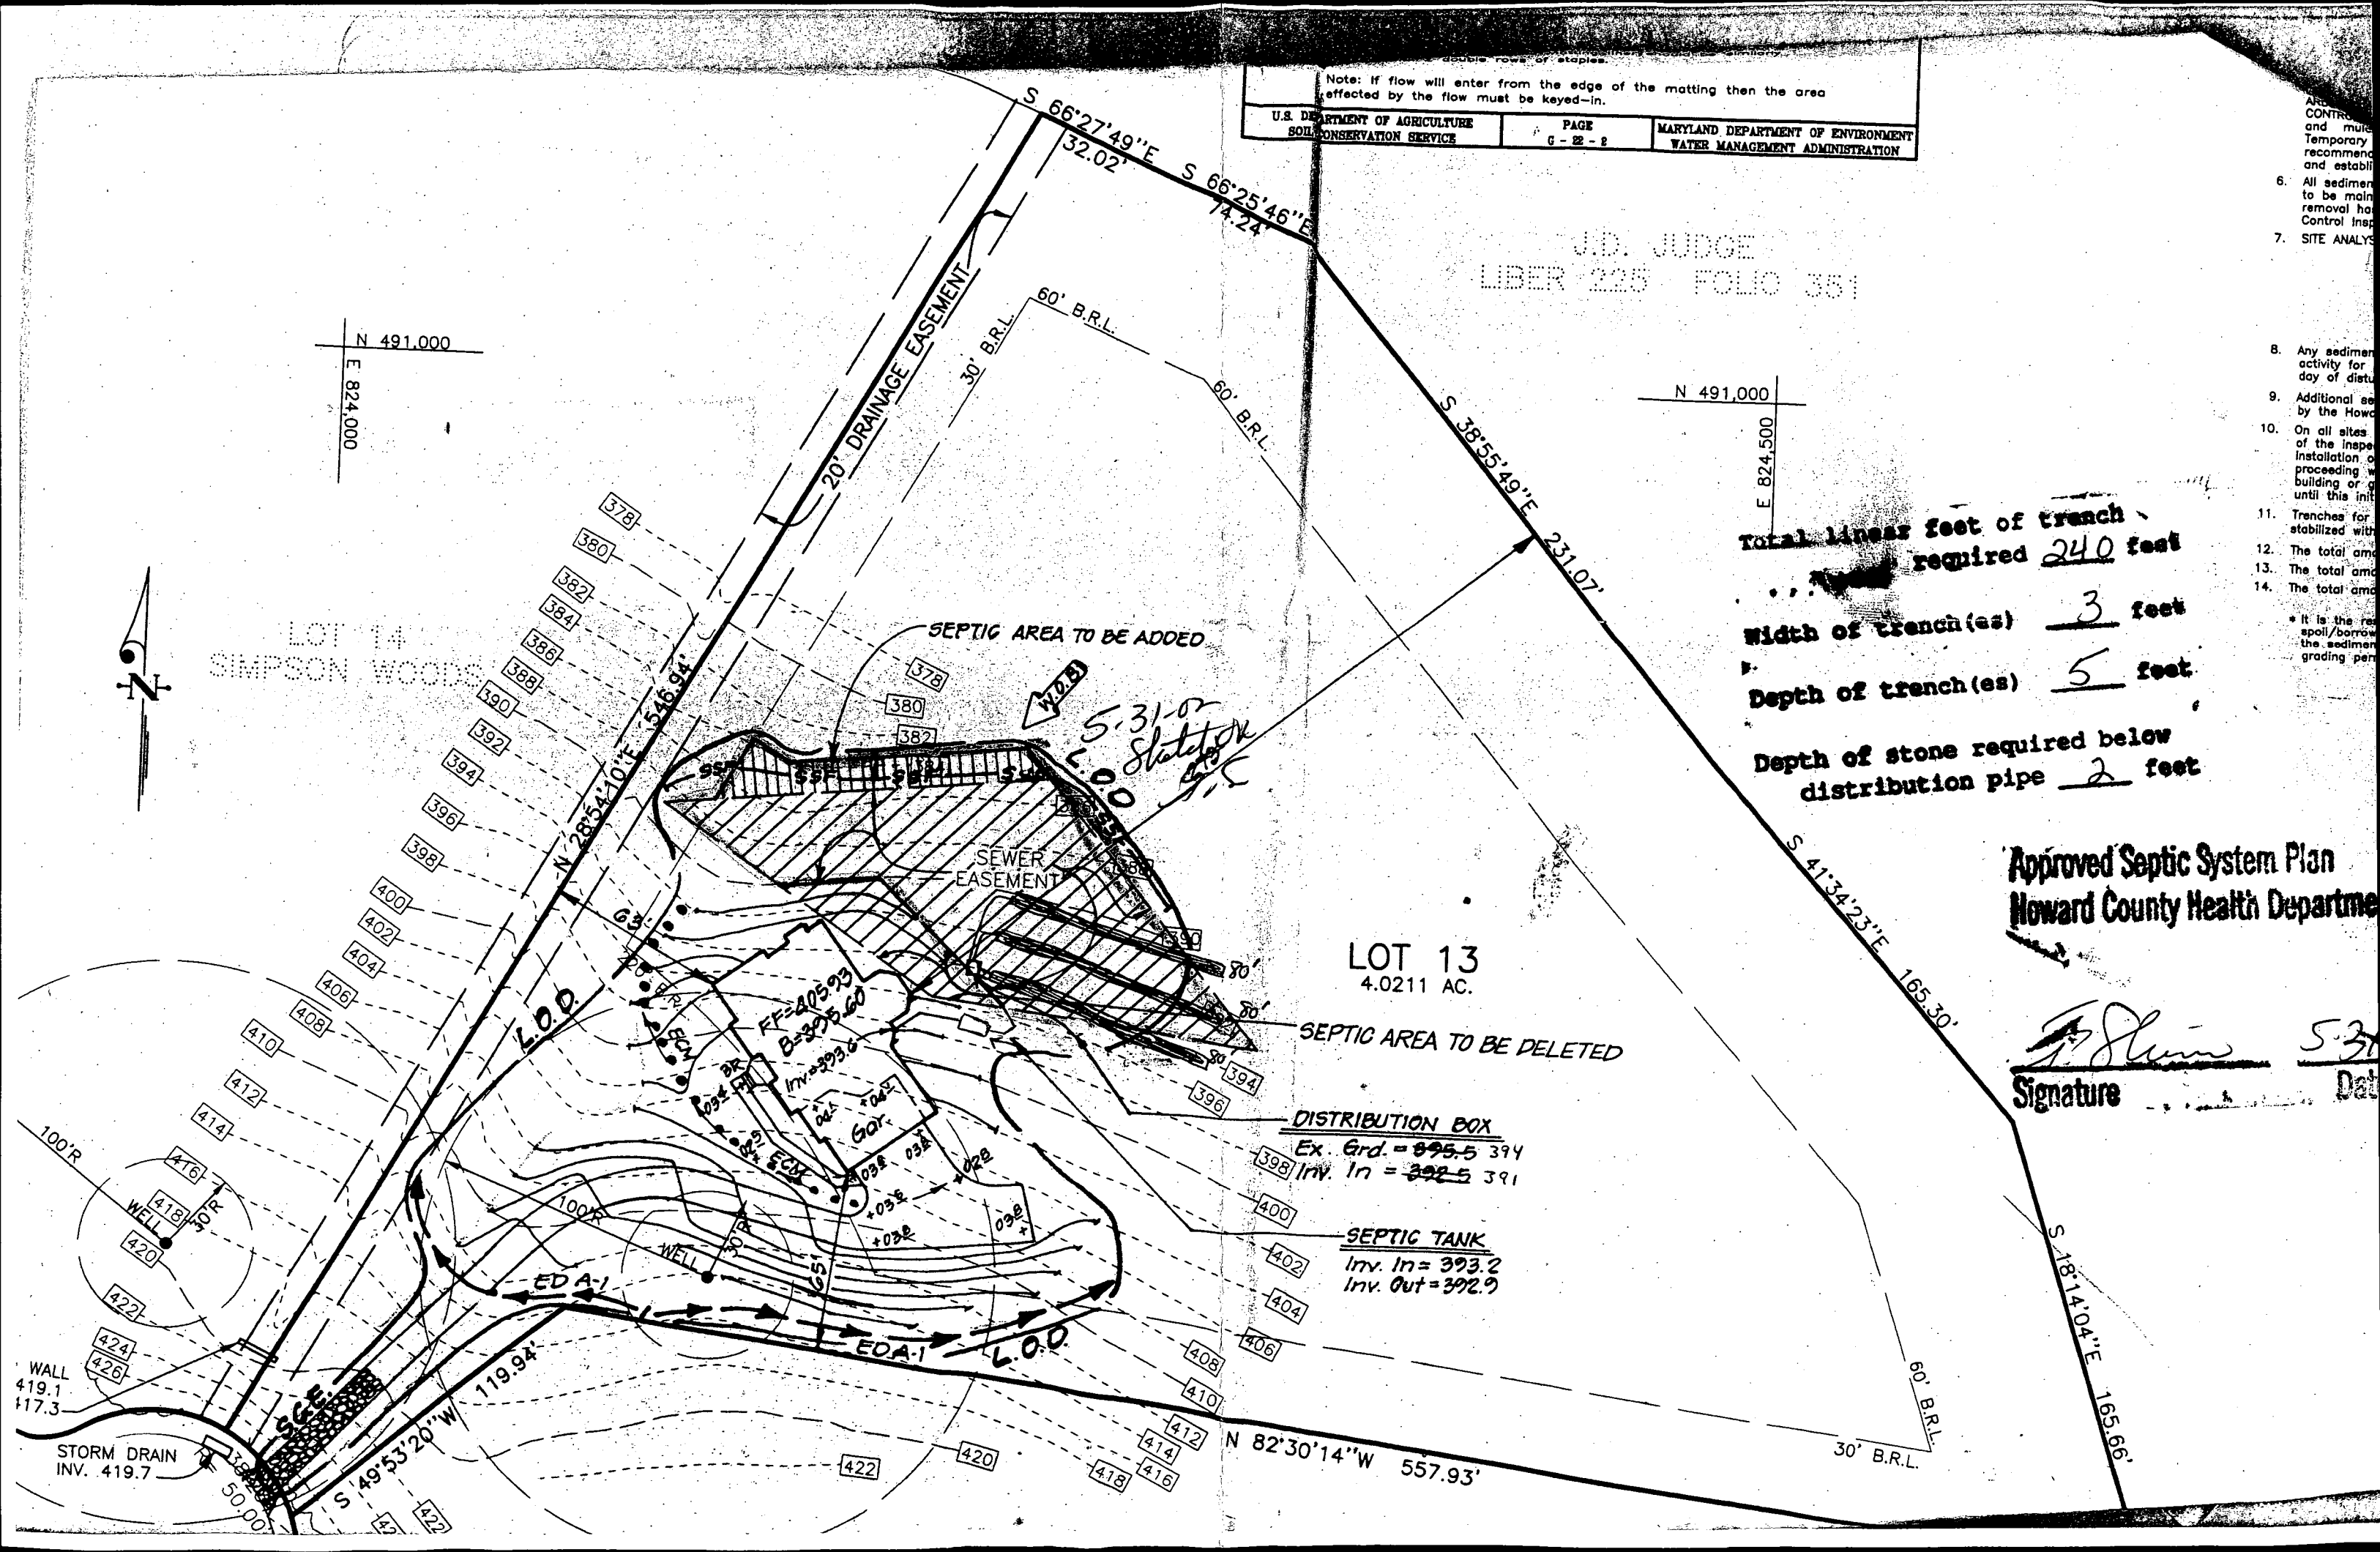

HOWARD COUNTY HEALTH DEPARTMENT
BUREAU OF ENVIRONMENTAL HEALTH
WATER AND SEWERAGE PROGRAM
TEL: (410)313-2640 FAX: (410)313-2648

Information Form for the Installation of the Well Pump, Pitless Adapter, and Supply Piping

NOTE: The installer is responsible for requesting an inspection prior to 9 am on the day of the desired inspection. No work is to be covered until approved by the Health Department. All installations must comply with the National Standard Plumbing Code (NSPC, as amended locally) and COMAR 26.04.04 (MD Well Construction Regulations). Submission of a complete form is required prior to Use and Occupancy approval.

Company Name: ASSOCIATED PLUMBING SERVICES Telephone #: 410-242-2606
Address: 3916 VERA RD
BALTIMORE, MD 21227

(Must circle one) Licensed Plumber Licensed Well Driller Licensed Well Pump Installer

License # and name of individual responsible for the field installation:

Name (Print): HOWARD J KAPFER SR License# 1787

*A licensed individual must perform the actual installation. Apprentices must be under the direct supervision of a licensed journeyman or master plumber, pump installer or well driller. Licenses may be subjected to field verification.

Name of Property Owner: MOSES WILLIAM ALADE Telephone #: 410-781-4844
Subdivision: Simpson Woods Lot #: 13 Well Tag #: HO-73-4089
Site Address: 7324 MEADOWWOOD WAY

Submersible Pump Data

Make: STARITE
Model #: 5SP4D02 HL
Pump Capacity 5 GPM
Well Yield: 5 GPM

Pitless Adapter

Make: MARTINSON
Model #: B10X
Depth: 42" + (36" min)
NSF approved: _____

Well Cap and Electric Conduit

Two piece watertight cap: LXL01 MARTINSON
Screened, vented well cap: YES
Cap secured to casing: YES
Conduit min 18" B.G.: YES
Conduit secured to well cap: YES

Depth of well encountered at time of pump installation: 250' (feet)

If pump capacity exceeds well yield, a low water cut off switch is required by NSPC 1990 Section 17.8.4

Torque arrestors or Cable guards are required - Must circle one

Safety rope, if used, attached to inside of well casing with eye bolt _____

Piping to house

Type: 1" Polybutylene
PSI: 160 (160 psi min)
Depth of supply line: 42" (36" min)

House Connection

PVC sleeved to undisturbed soil at wall penetration: YES
Approximate length of sleeve: 12'
Sleeve caulked and sealed properly: YES

The water supply line is required to be at least ten feet from the septic tank, pump chamber, sewage piping, distribution box, drainfields, and sewage reserve area. If this cannot be accomplished, contact this office for approval prior to installation.

Howard J. Kapfer Sr.
Signature of company representative responsible for installation

April 30, 2003
date

For Health Department Use Only - Not to be completed by Installer

Date Insp. Requested: None Date Insp. Approved: _____
Inspection Data: Pitless adapter and water supply line at least 36" below grade _____
Two piece cap installed and attached to casing securely _____
Elec. conduit extends at least 18" below grade/attached to cap properly _____
Safety rope installed inside of well casing _____
Correct well tag attached properly and casing 8" above finished grade _____
Water supply line sleeved adequately at house connection _____
Adequate grout observed below pitless adapter _____

Discussion w/
installer
regarding
inspection
procedures
SRU

SEQUENCE NO.
(OEP USE ONLY)PUNCHED
(CARDS)STATE OF MARYLAND
WELL COMPLETION REPORT
FILL IN THIS FORM COMPLETELY
PLEASE PRINT OR TYPETHIS REPORT MUST BE SUBMITTED WITHIN
45 DAYS AFTER WELL IS COMPLETED.COUNTY
NUMBER

A26644

DATE WELL COMPLETED

2 22 82

Depth of Well

240

(TO NEAREST FOOT)

PERMIT NO.

FROM "PERMIT TO DRILL WELL"

40-73-4089

OWNER Atlantic Mortgage Investors Inc.

STREET OR RFD last name

Meadow Wood Way

first name

TOWN Fulton

SUBDIVISION Simpson Woods

SECTION 3

LOT 13

WELL LOG

Not required for driven wells

STATE THE KIND OF FORMATIONS
PENETRATED, THEIR COLOR, DEPTH,
THICKNESS AND IF WATER BEARINGDESCRIPTION (Use
additional sheets if needed)

FEET

FROM TO

Check
if water
bearing

Sand

0 38

gray mica
rock

38 240

GROUTING RECORD


WELL HAS BEEN GROUTED
(Circle Appropriate Box)yes
Yno
N

TYPE OF GROUTING MATERIAL

CEMENT C M BENTONITE CLAY B C

NO. OF BAGS 14 NO. OF POUNDS 1316

GALLONS OF WATER 84

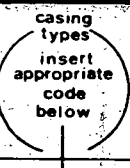DEPTH OF GROUT SEAL (to nearest foot)
from 0 ft. to 38 ft.
(enter 0 if from surface)

CASING RECORD

ST

STEEL

CO

CONCRETE

PL

PLASTIC

OT

OTHER

MAIN
CASING
TYPENominal diameter
top/main casing
(nearest inch)Total depth
of main casing
(nearest foot)


S T

6

44

E
A
C
H
C
A
S
I
N
GOTHER CASING (if used)
diameter inch depth (feet) toscreen type
or openhole

SCREEN RECORD

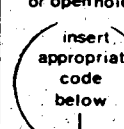

ST

STEEL

BR

BRASS

HO

OPEN

BRONZE

HOLE

PL

PLASTIC

OT

OTHER

C 2

Seq. no.

DEPTH (nearest ft.)

H O

42

240

2

23

24

26

30

32

36

3

38

39

41

45

47

51

SLOT SIZE

1

2

3

DIAMETER
OF SCREEN(NEAREST
INCH)

56

60

GRAVEL PACK

IF WELL DRILLED WAS

FLOWING WELL CIRCLE BOX

F

OEP USE ONLY

(NOT TO BE FILLED IN BY DRILLER)

T

(E.R.O.S.)

W Q

70

TELESCOPE
CASING

72

LOG
INDICATOR

74

75

76

OTHER DATA

C 3

Seq. no.

1

2

3

B 1 7350 (THIS NUMBER IS TO BE PUNCHED IN COLS. 3-6 ON ALL CARDS)	SEQUENCE NO. WRA USE ONLY	STATE OF MARYLAND APPLICATION FOR PERMIT TO DRILL WELL please print or type	WRA PERMIT NUMBER HO-73-4089 fill in this form completely
DATE RECEIVED <u>12/15/81</u> 8 (WRA USE ONLY) 13 OWNER INFORMATION <u>Atlantic Mortgage Investors Inc.</u> LAST NAME <u>765 - I Rockville Pike</u> FIRST NAME STREET OR RFD <u>Rockville Md. 20852</u> TOWN <u>Rockville</u> STATE <u>Md.</u> ZIP <u>20852</u>		B 3 LOCATION OF WELL COUNTY <u>Howard</u> SUBDIVISION <u>Hampton Woods</u> SECTION <u>3</u> LOT <u>13</u> NEAREST TOWN <u>Hutton</u> MILES FROM TOWN (enter 0 if in town) <u>2</u> MI	
B 1 CONTINUED DRILLER INFORMATION <u>Joseph L. Mayne 238</u> DRILLER'S NAME <u>Joseph L. Mayne</u> LICENSE NO. <u>80</u> SIGNATURE <u>12/14/81</u> DATE		B 4 DIRECTION OF WELL FROM TOWN (CIRCLE BOX) 	
B 2 WELL INFORMATION APPROX. PUMPING RATE (GAL. PER MIN.) <u>5</u> AVERAGE DAILY QUANTITY NEEDED (GAL. PER DAY) <u>250</u>		NEAR WHAT ROAD <u>Meadow Wood Way</u> ON WHICH SIDE OF ROAD (CIRCLE APPROPRIATE BOX) NORTH ☒ WEST ☐ SOUTH ☐ EAST ☐ DISTANCE FROM ROAD (CIRCLE APPROPRIATE BOX) <u>200</u> FT	
USE FOR WATER (CIRCLE APPROPRIATE BOX) ☒ HOME (SINGLE OR DOUBLE HOUSEHOLD UNIT ONLY) ☐ FARMING (LIVESTOCK WATERING & AGRICULTURAL IRRIGATION) ☐ INDUSTRIAL, COMMERCIAL, STATE AND FEDERAL GOV. OTHER (REQUIRES APPROPRIATION PERMIT) ☐ PUBLIC OR PRIVATE WATER COMPANY (REQUIRES APPROPRIATION PERMIT AND STATE HEALTH DEPARTMENT APPROVAL) ☐ TEST, OBSERVATION, MONITORING (MAY REQUIRE APPROPRIATION PERMIT)		SHOW LOCATION OF WELL WITH AN "X" IN THIS BOX 	
APPROXIMATE DEPTH OF WELL <u>200</u> FEET APPROXIMATE DIAMETER OF WELL <u>6</u> INCH		WRITE THE BOX NUMBER FROM THE MAP HERE E <u>8204</u> N <u>4900</u>	
Method of Drilling (circle one) BORED (OR AUGERED) ☒ JETTED ☐ JETTED & DRIVEN ☐ AIR ROTARY ☒ AIR PERCUSSION ☐ ROTARY (HYDRAULIC) ☐ CABLE ☐ REVERSE ROTARY ☐ DRIVE POINT ☐ ROTARY ☐ other _____		DRAW A SKETCH BELOW SHOWING LOCATION OF WELL IN RELATION TO NEARBY TOWNS AND ROADS AND GIVE DISTANCE FROM WELL TO NEAREST ROAD JUNCTION 	
REPLACEMENT OR DEEPEMED WELLS (Circle Appropriate Box) ☒ THIS WELL WILL NOT REPLACE AN EXISTING WELL ☐ THIS WELL WILL REPLACE A WELL THAT WILL BE ABANDONED AND SEALED ☐ THIS WELL WILL REPLACE A WELL THAT WILL BE USED AS A STANDBY ☐ THIS WELL WILL DEEPEN AN EXISTING WELL PERMIT NUMBER OF WELL TO BE REPLACED OR DEEPEMED (IF AVAILABLE) _____		NOT TO BE FILLED IN BY DRILLER HEALTH DEPARTMENT APPROVAL HOWARD COUNTY NAME <u>A 26644</u> COUNTY NO. EHA SIGNATURE <u>Frank Shriver</u> STATE HEALTH CIRCLE BOX <u>S</u> MO <u>12</u> DAY <u>21</u> YR <u>81</u> DATE NORTH <u>4900</u> EAST <u>0824</u> ELEV. (FT.) _____ GRID _____	
Not to be filled in by driller (WRA USE ONLY) APPROP. PERMIT NUMBER <u>GAP</u> FORCE <u>ES</u> INITIALS <u>HO-73-4089</u> CONDITIONS <u>40-73-4089</u>		SPECIAL CONDITIONS (WRA USE ONLY) _____	

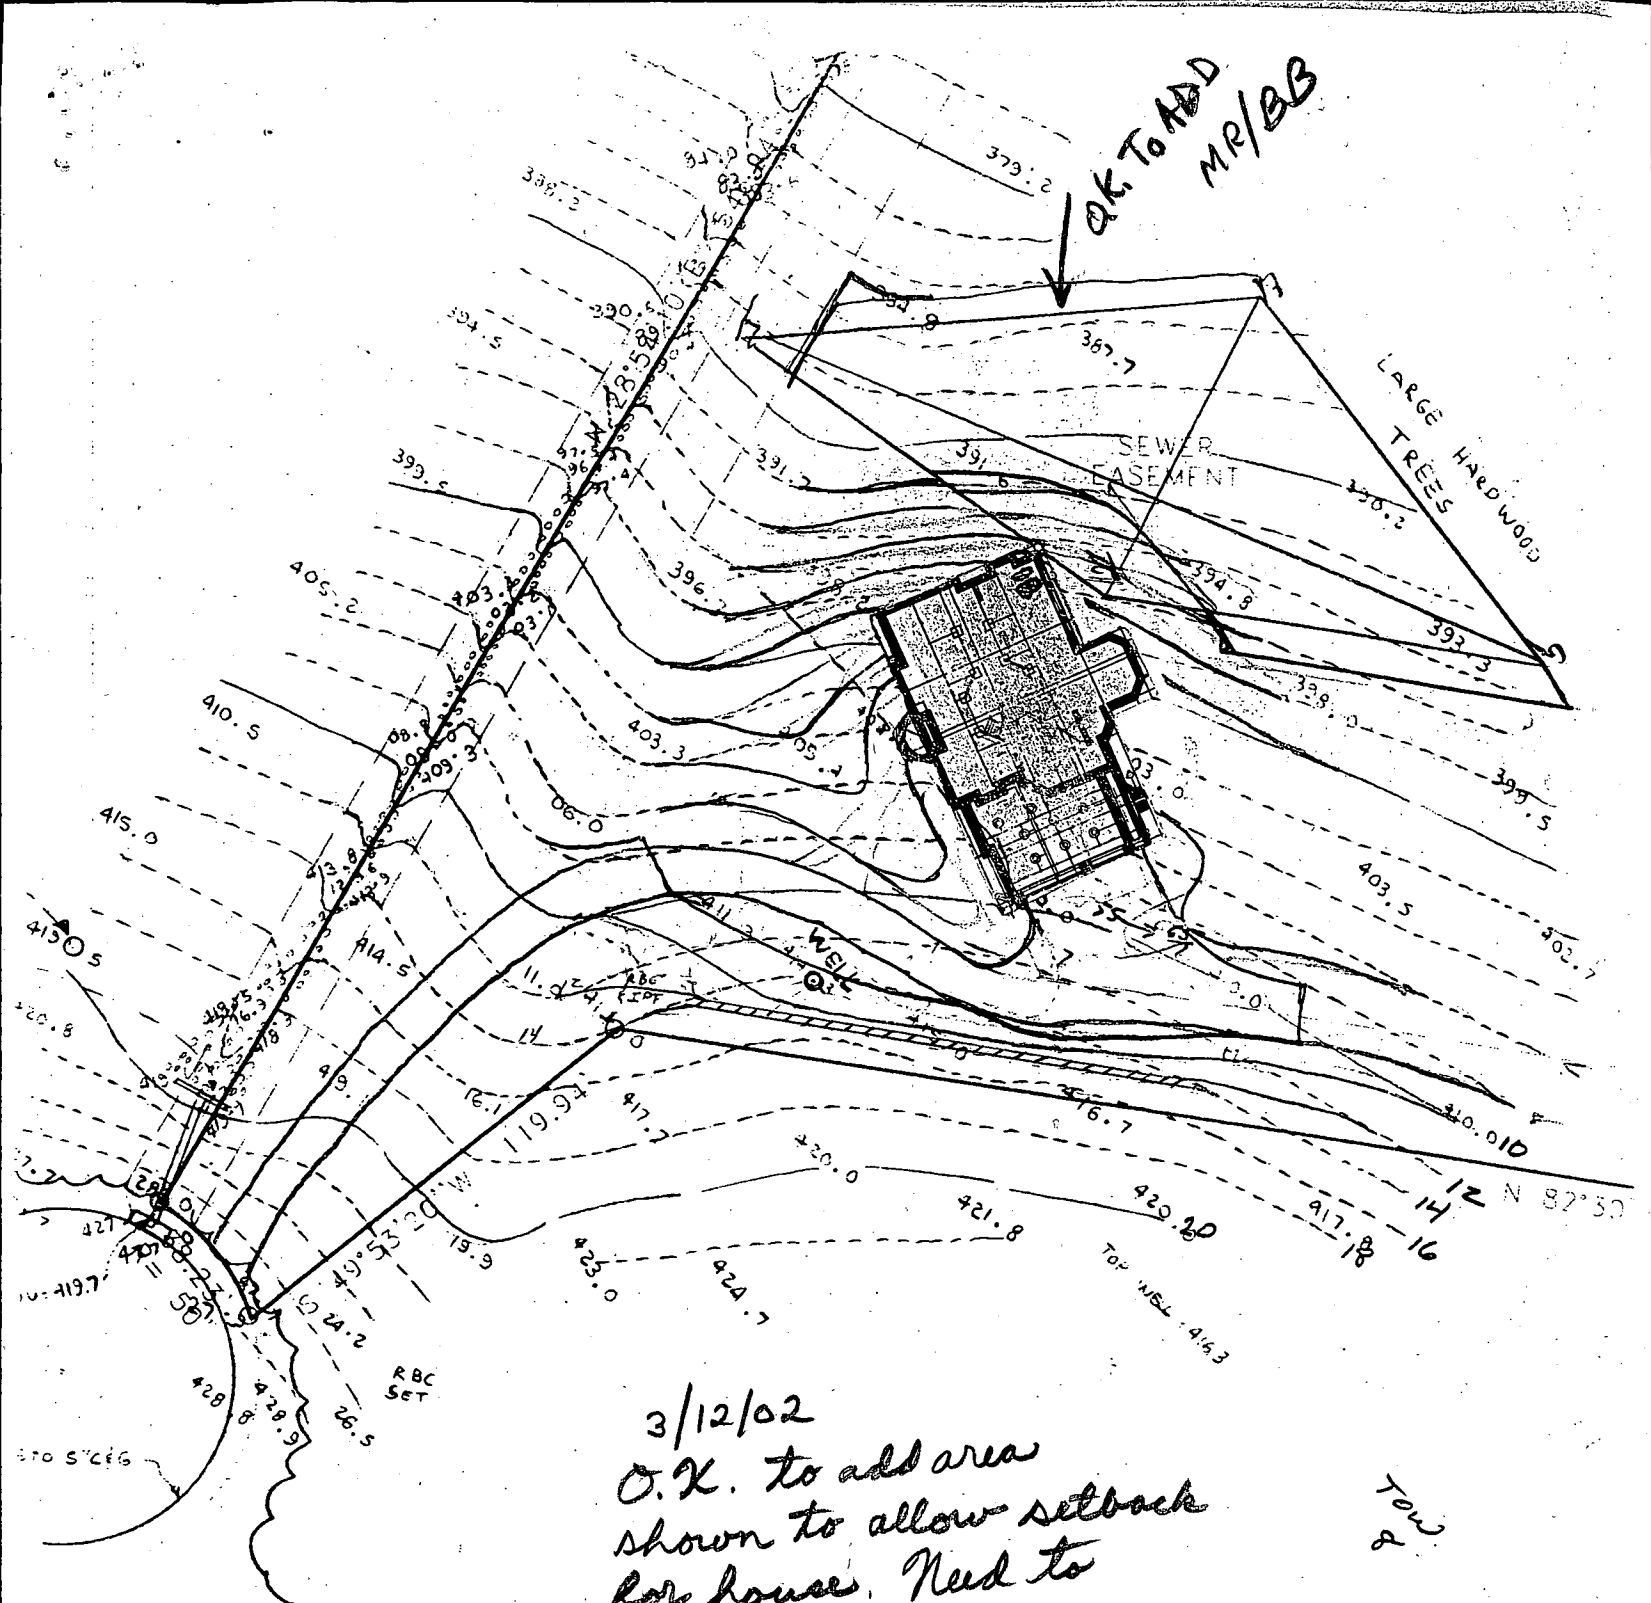

3/12/02
 O.K. to add area
 shown to allow setback
 for house. Need to
 maintain 10,000 sq. ft.
 of usable area. Waiting
 on revised plan.

MR/BB

Simpson Woods
 Sec 3/ lot 13

APPLICATION

PERCOLATION TESTING

NO FEE

P. _____

HOWARD COUNTY HEALTH DEPARTMENT

BUREAU OF ENVIRONMENTAL HEALTH

3525-H ELLICOTT MILLS DRIVE/ELLICOTT CITY, MARYLAND 21043
TELEPHONE: 313-2640

DISTRICT 4TH

DATE 12/17/2001

TO: THE COUNTY HEALTH OFFICER
ELLICOTT CITY, MARYLAND

I HEREBY APPLY FOR THE NECESSARY TEST PRIOR TO APPLICATION FOR PERMIT TO CONSTRUCT (OR RECONSTRUCT) A SEWAGE DISPOSAL SYSTEM.

PROPERTY OWNER BRUCE & MARYLON VAN NEWKIRK

ADDRESS 217 PARADISE AVE CATONSVILLE MD 21228 PHONE 410-788-6541 ^{work} 410-247-5500 ^{x241}

AGENT OR PROSPECTIVE BUYER N/A

ADDRESS N/A PHONE N/A

PROPERTY LOCATION:

SUBDIVISION WARFIELD ESTATES LOT NO. 13

ROAD AND DESCRIPTION INTERSECTION OF MAC CLINTOCK DRIVE & HYSTER DRIVE

TAX MAP 21 PARCEL # % 164

SIZE OF LOT 2.32 AC± TYPE BLDG. SINGLE FAMILY DWELUNG
(SINGLE FAMILY DWELLING OR COMMERCIAL)

THE SYSTEM INSTALLED UNDER THIS APPLICATION IS ACCEPTABLE ONLY UNTIL PUBLIC FACILITIES BECOME AVAILABLE. I FULLY UNDERSTAND THE

FEE CONNECTED WITH THE FILING OF THIS PERC TEST APPLICATION IS NON-REFUNDABLE UNDER ANY CIRCUMSTANCES. I ALSO AGREE TO

COMPLY WITH ALL M.O.S.H.A. REQUIREMENTS IN TESTING THIS LOT.

Bruce Van Newkirk
(SIGNATURE OF APPLICANT)

APPROVED BY _____ FOR _____ DATE _____

DISAPPROVED BY _____ FOR _____ DATE _____

HOLD PENDING FURTHER TESTS _____

REASONS FOR REJECTION OR HOLDING HOLD FOR PLAT - PERC OK MR 3/4/02

PERCOLATION TEST PLAT/PRELIMINARY PLAT - TITLE OR I.D. # _____ DATE _____

SITE DEVELOPMENT PLAN/FINAL PLAT - TITLE OR I.D. # _____ DATE _____

THIS IS NOT A PERMIT

COUNTY #

SOIL PROFILE

② ③ ④
orge red
lt. brn
sac/lm


45
lt. brn
tan pink
mica
sand
loam
10%
Frag

①
orge brn
yel red
sac/lm

4
tan yel.
lt. brn
mica sac/lm
10-15%
25-35%
black and
other frags

7
orge
brn
sac/lm

3
tan gray
lt. brn
sa mica
mica
20-30%
Frag

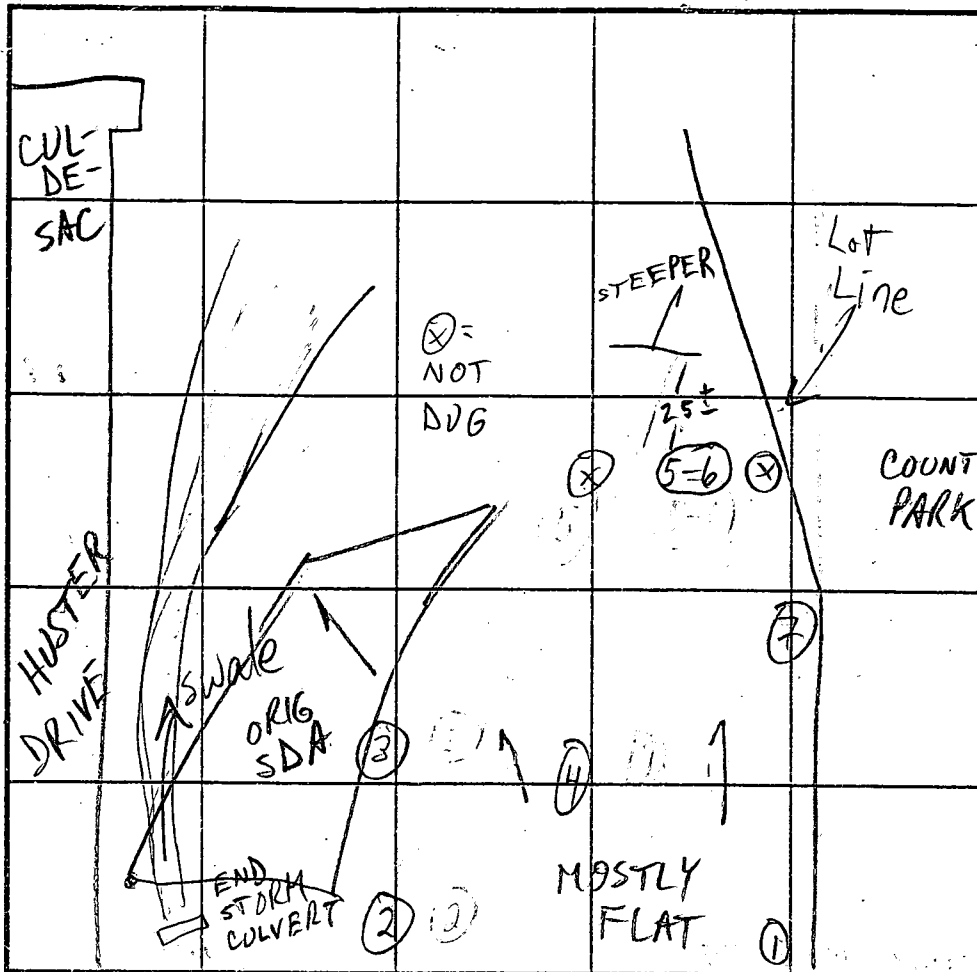

SOIL PROFILE

5-6
tan
brn
sac/lm

tan
sand
15-20%
Frag

20-25%
Frag

40-50%
Frag

UPHILL DOWNHILL

INDICATE NORTH - NAME ADJOINING ROADWAY AS BASE LINE. MacClintock Dr
STORM DRAIN IN STREET

DATE	TEST NO.	DEPTH	PRE-WET		TEST - 1" DROP		TIME
			START	STOP	START	STOP	
1/29/02	2 S	4 1/2 15 1/2	10:43 OK see profile	10:48	10:48	10:54	6
	3 S	4 14 1/2	10:46 OK see profile	10:50	10:50	11:00	10
	4 V	14 1/2	OK	see profile			
	1 S	4 1/2 14 1/2	11:13	11:16	11:16	11:24	8
	7 S	4 8' 3"	11:38 11:52:10	11:39 11:52:50	11:39 11:52:50	11:42 11:54:30	3 1 1/2
	7 M	8' 3"	11:54:50	11:56:30	11:56:30	11:59:30	3
	7 V	13 1/2	OK see profile				
	5-6 V	11	EXCESS RX @ Downhill side				
			AVOID BY 25'				

REMARKS

TYPE OF SOIL

TESTED BY M. Ripkin

ALSO PRESENT owner, Flock crew

TRENCH DESIGN DATA: AVERAGE PERCOLATION TIME

7

TRENCH WIDTH

3.0

INLET DEPTH

4.0

MAXIMUM BOTTOM DEPTH

6.0

SQ. FT./BEDROOM

180

Preliminary Septer 1st

APPLICATION

A 17097

P

SEWAGE DISPOSAL TESTING

MARYLAND STATE DEPARTMENT OF HEALTH

HOWARD COUNTY

ELLICOTT CITY

DISTRICT 4

DATE 5/31/72

System must go in before any building permit can be issued

Septic Tank 3 bedrooms - 1,000 gal.
4 " - 1,250 gal.

Dry Well - 120 sq ft absorbent sidewall area per bedroom to begin below the first 3' of original grade. Max depth permitted for DW is 9 ft below orig. grade

Place Dry Well 150' from front lot line and 150' from left side line (Huster Drive) as seen when facing lot from Mac Clintock drive

TO: THE COUNTY HEALTH OFFICER
ELLICOTT CITY, MARYLAND

I, HEREBY, APPLY FOR THE NECESSARY TESTS IN ORDER TO CONSTRUCT (OR RECONSTRUCT) A SEWAGE DISPOSAL SYSTEM.

PROPERTY OWNER Maple Hill Farms Assoc.

ADDRESS 9300 Fontana Ave., Seabrook, Md.

PHONE 277-2121, Ext. 23

PROPERTY LOCATION:

SUBDIVISION Warfield Estates

LOT NO. 13B re 6.1
1, Blk. C, Sect. 5

ROAD AND DESCRIPTION Corner of Huster and Mac Clintock Drives

OCCUPANT

PHONE

PERSON TO CONSTRUCT SYSTEM

ADDRESS

PHONE

SIZE OF LOT 220 ft. x 190 x 205 x 150

TYPE BLDG. 3 or 4 bedrooms

NUMBER OF BEDROOMS

IF NOT SINGLE RESIDENCE DESCRIBE

SIGNATURE OF APPLICANT /s/ Edward Cramer

APPROVED BY H. Snyder

FOR

Dry Well
(KIND OF SYSTEM)

DATE 6-27-72

REJECTED BY

FOR

(KIND OF SYSTEM)

DATE


HOLD PENDING FURTHER TESTS

DATE

REASONS FOR REJECTION OR HOLDING

THIS IS NOT A PERMIT

Huster

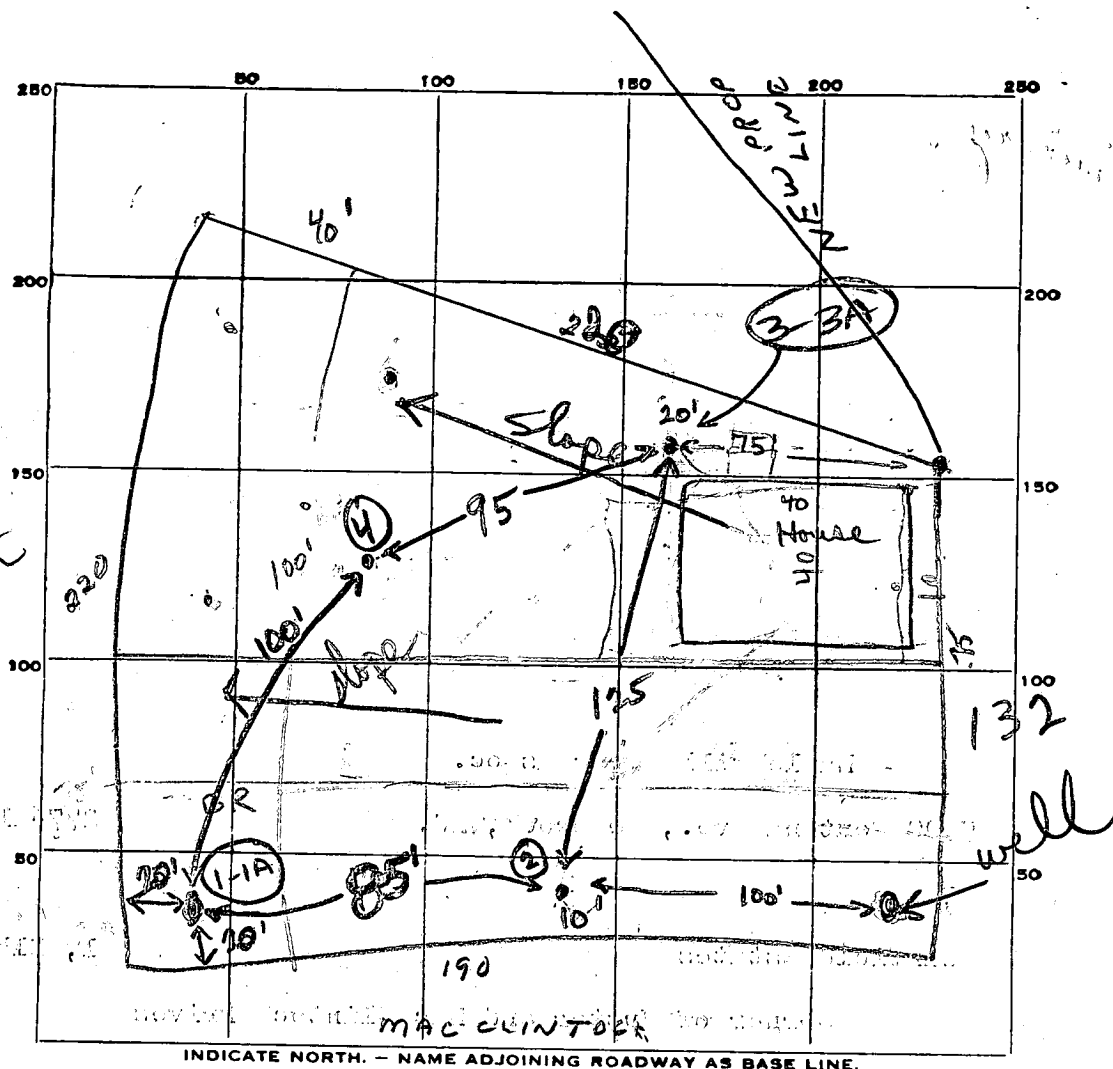

LOT 1

DATE	TEST NO.	DEPTH	PRE-WET		TEST - 1" DROP		TIME
			START	STOP	START	STOP	
10/27	1	5'	224	227	227	2	3
	1A	12'	224	227	227	230	3
	2	12'	5' ^{TOP} Clay -		7' ^{BOTTOM} Good Soil		Dry
	3	3'	250	250	250	254	4
	3A	11'	250	252	252	256	4
	4	11 1/2'	top 3' Clay Bottom 8 1/2' -		Good		Dry (close to)

Average 3½ min

SOIL AUGER FINDING

Dry Well at 3-3A


TESTED BY


Inlet 3' Max Drill 11'

REMARKS

System in before house

MT
Wilson
Pikesville

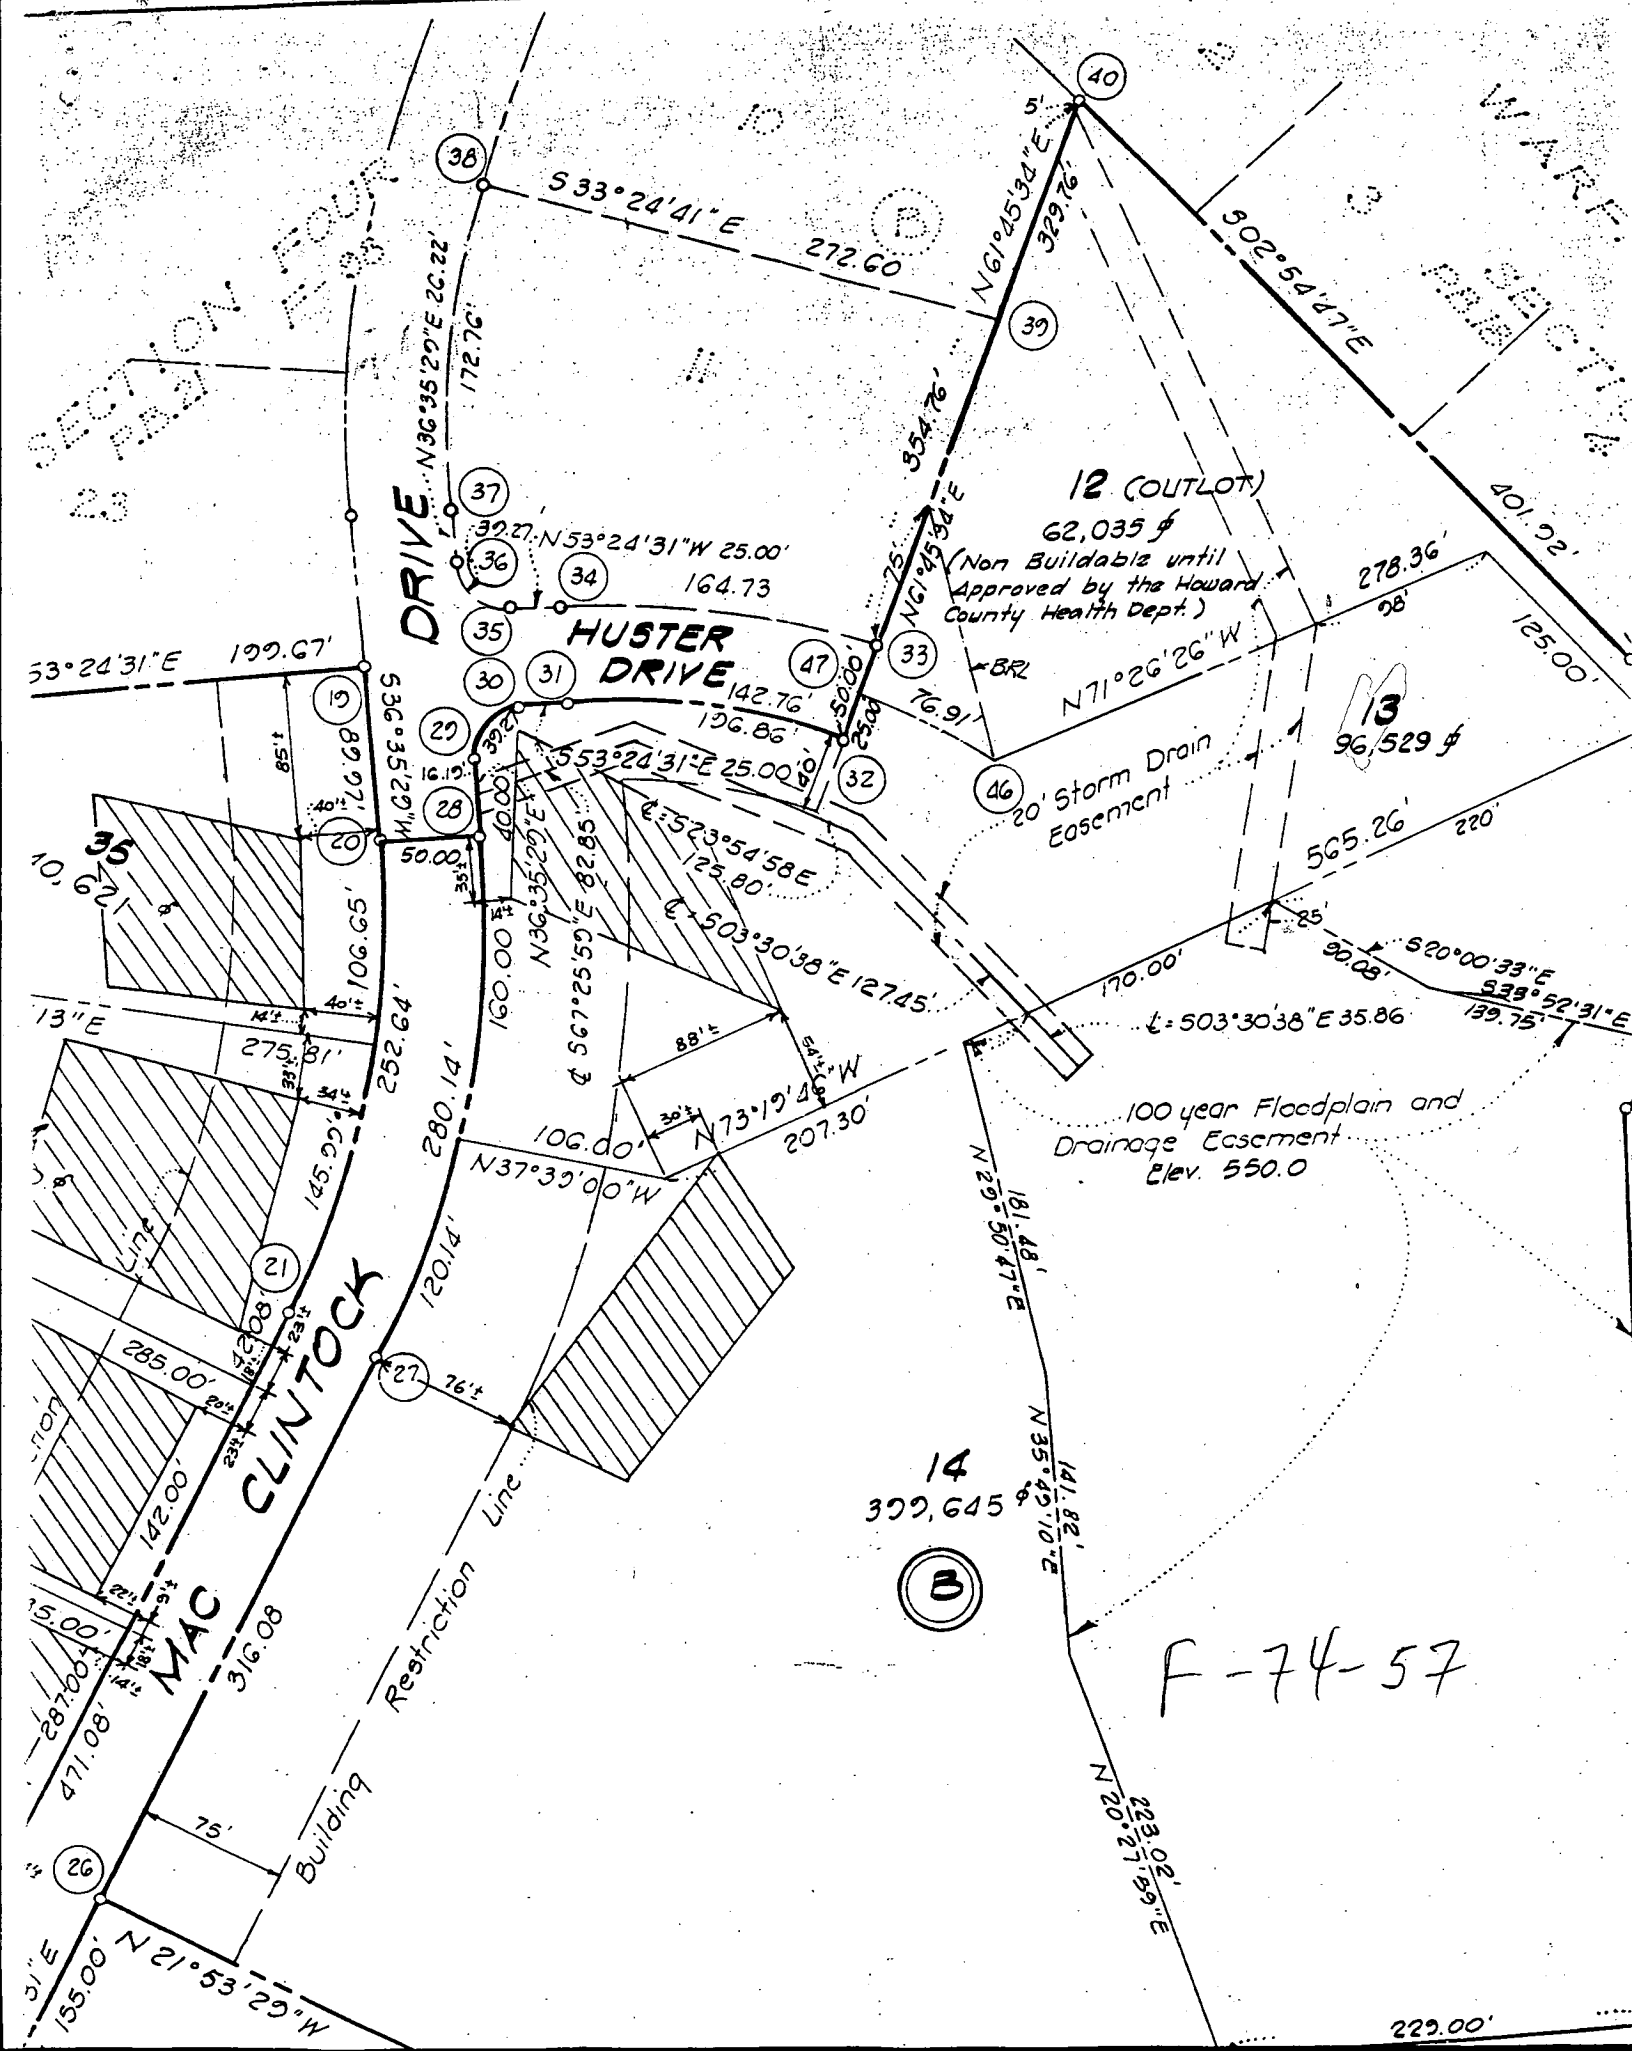

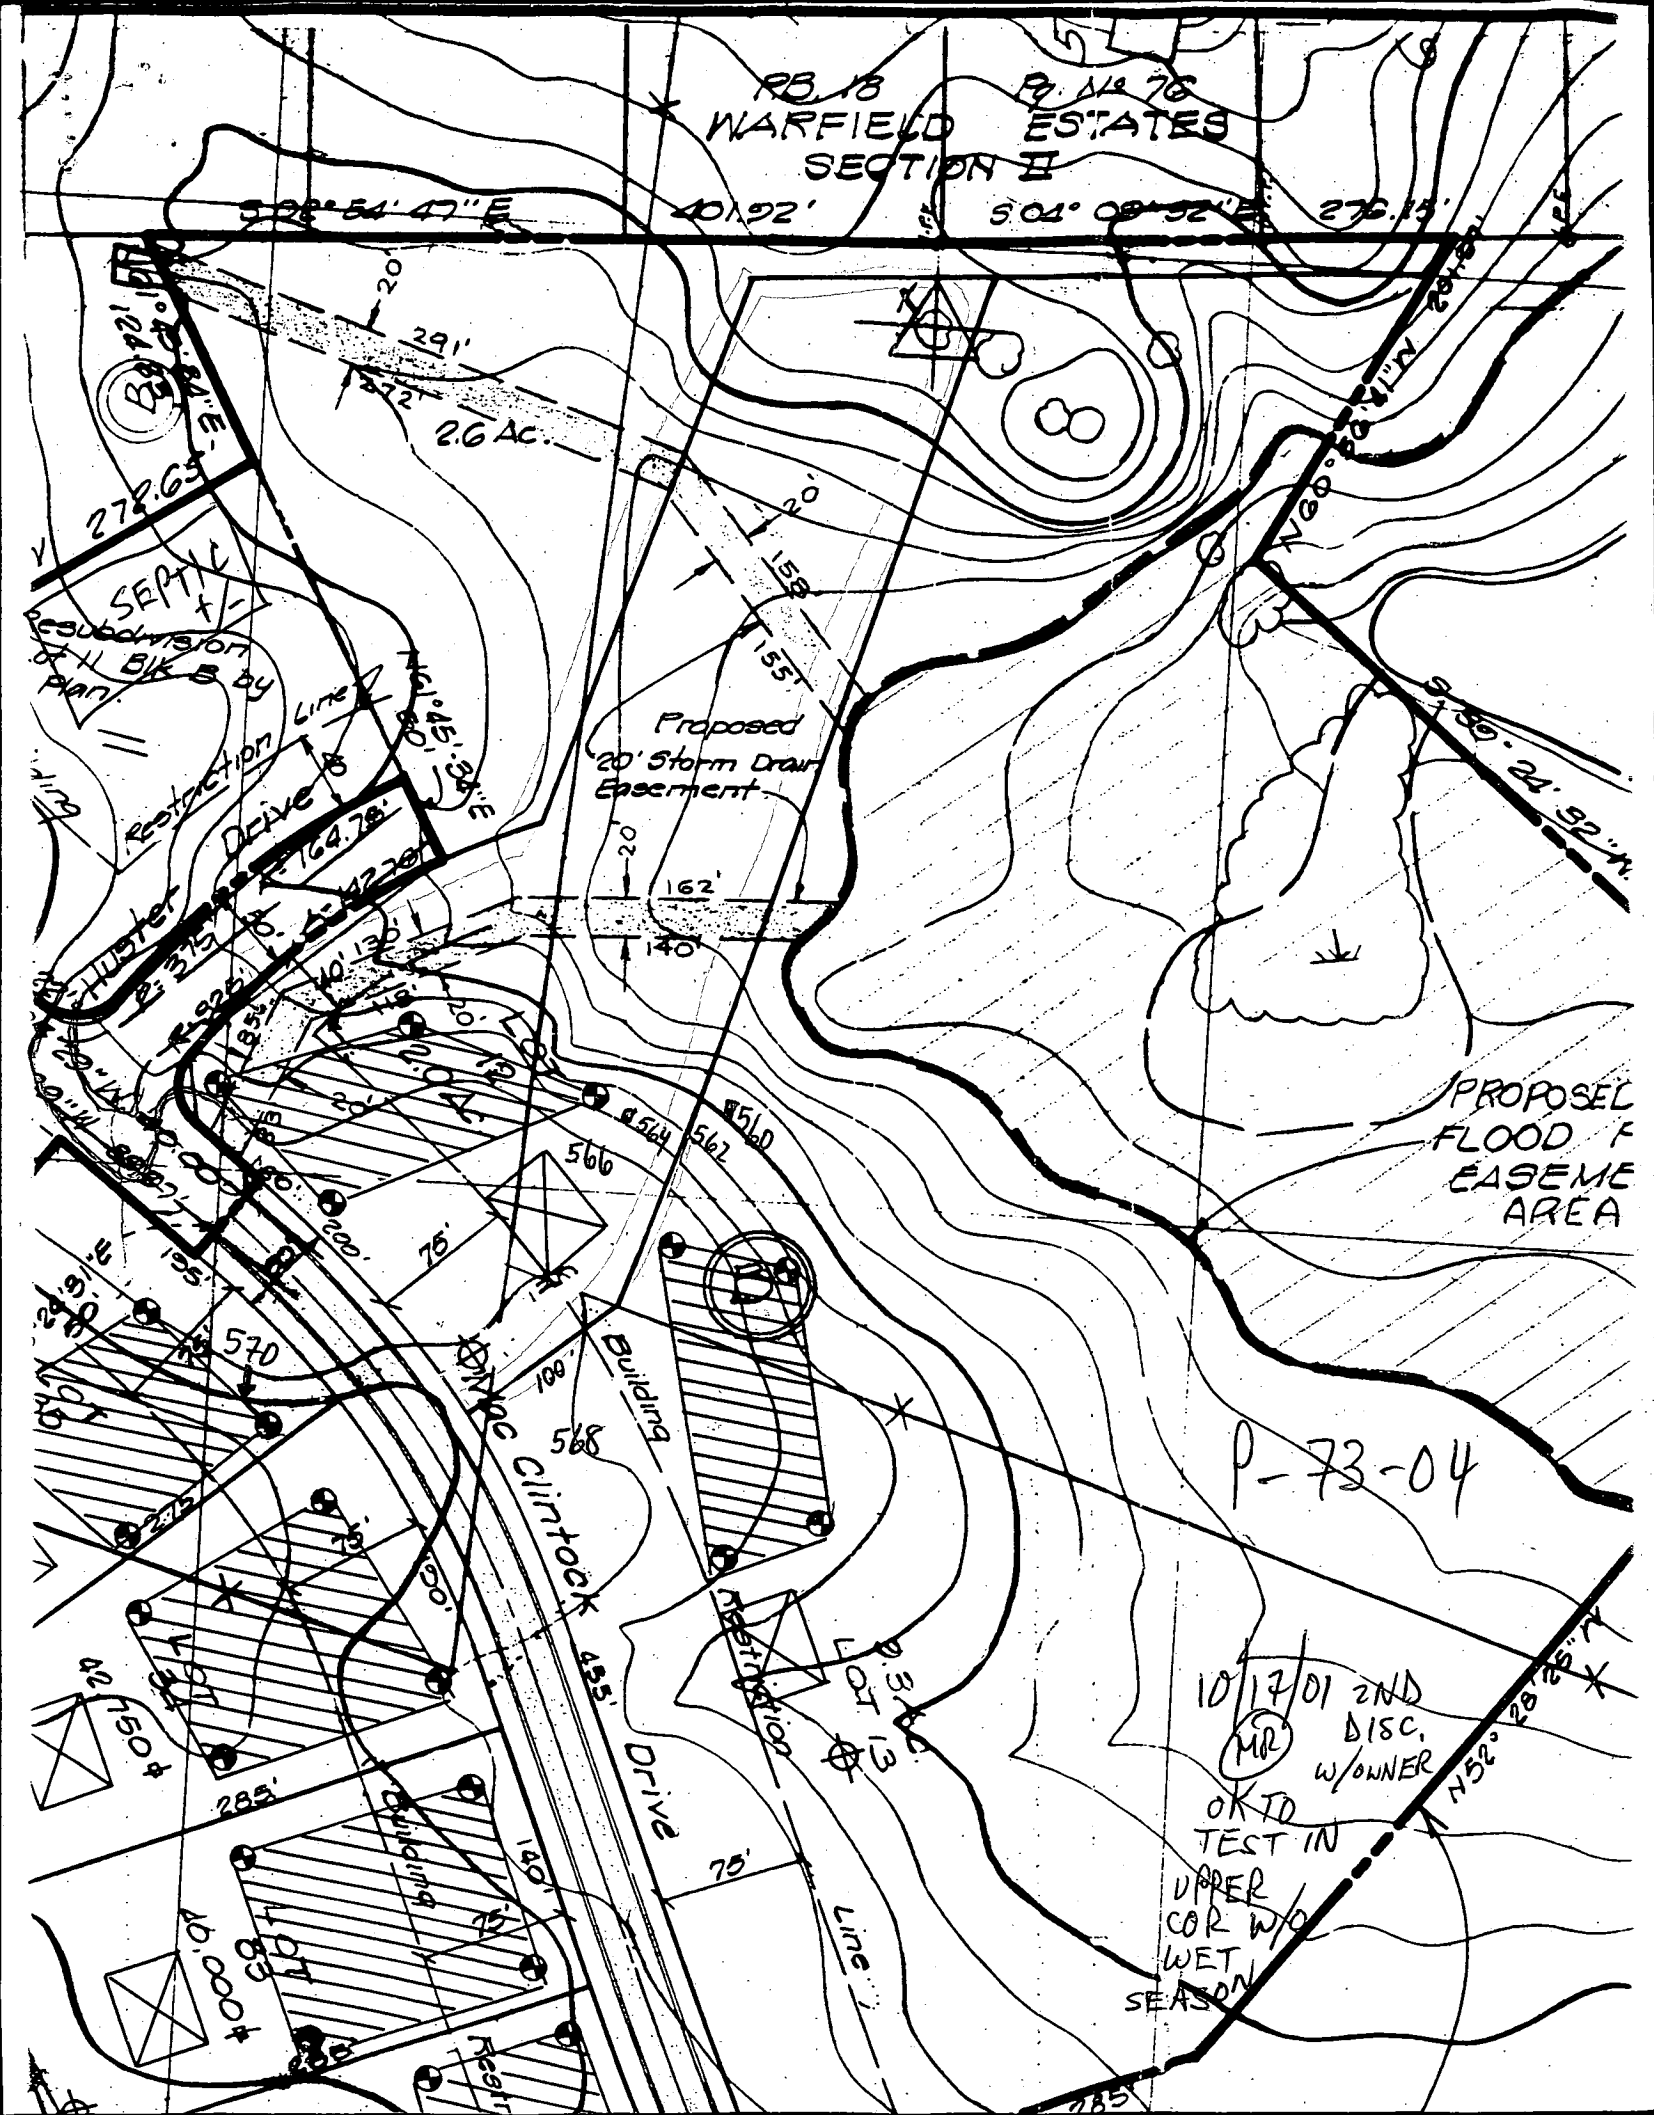

APPLICATION

A 26644

SEWAGE DISPOSAL TESTING

P _____

STATE OF MARYLAND - DEPARTMENT OF HEALTH AND MENTAL HYGIENE

HOWARD COUNTY HEALTH DEPARTMENT
ENVIRONMENTAL HEALTH SERVICESP. O. BOX 475, ELLICOTT CITY, MARYLAND 21043
TELEPHONE 465-5000, EXT. 356DISTRICT 5thDATE 10/16/78System 1st if approvedSYSTEM 1stSeptic Tank - 3 bedroom - 1000 gal
4" - 1250 galDry well 1200 gal absorbent sidewalk area per bedroom floor
below the first 4' of orig. grade. Max depth permitted for slab is 10 ft below
orig. grade.Place dry well 265 ft from rear lot line and 150 ft from
right side as seen when facing from the frontTO: THE COUNTY HEALTH OFFICER
ELLICOTT CITY, MARYLANDI, HEREBY, APPLY FOR THE NECESSARY TEST IN ORDER TO CONSTRUCT (OR RECONSTRUCT) A SEWAGE
DISPOSAL SYSTEM.PROPERTY OWNER PHASE II LTD.ADDRESS 40 LANOBORG, INC. SUITE 304 TEACHERS' BLDG. PHONE 730-0500
COLUMBIA, MD. 21044

PROPERTY LOCATION:

SUBDIVISION SIMPSON WOODS - SECT. 3 LOT NO. 13, Sec. 3ROAD AND DESCRIPTION NORTHEASTERLY END OF MEADOW WOOD WAYSIZE OF LOT 3.0 Ac. TYPE BLDG. RESIDENTIAL (3 or 4)

NUMBER OF BEDROOMS


IF NOT SINGLE RESIDENCE DESCRIBE N/ATHE SYSTEM INSTALLED UNDER THIS APPLICATION IS ACCEPTABLE ONLY UNTIL PUBLIC
FACILITIES BECOME AVAILABLE.SIGNATURE OF APPLICANT Phase II, Ltd. Clarence M. Pres.APPROVED BY DM Mangan Jr FOR DM DATE 6-4-80
(KIND OF SYSTEM)REJECTED BY _____ FOR _____ DATE _____
(KIND OF SYSTEM)

HOLD PENDING FURTHER TESTS _____ DATE _____

REASONS FOR REJECTION OR HOLDING _____

THIS IS NOT A PERMIT

LOT 13

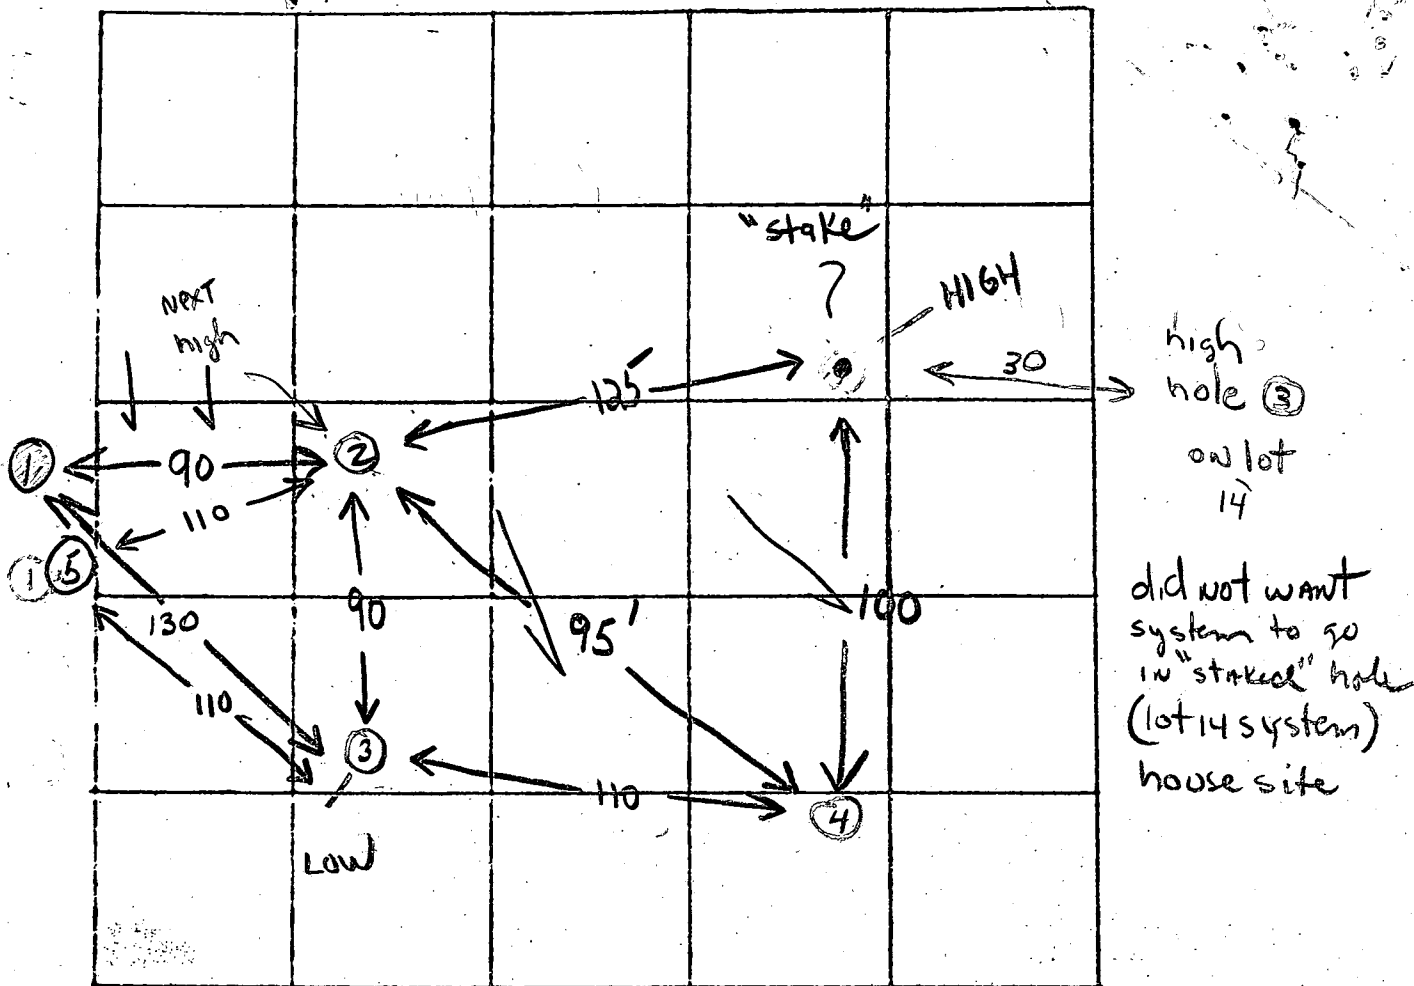

INDICATE NORTH. - NAME ADJOINING ROADWAY AS BASE LINE.

trench

DATE	TEST NO.	DEPTH	PRE-WET		TEST - 1" DROP		TIME	
			START	STOP	START	STOP		
12/6/78	15	11'	VISUAL	WEATHERED SANDSTONE AT 8'				
	10			HARD BOTTOM AT 11'				
	25	4 8		345	346	346	349	3
	20 -H	12 (B)		345	349	349	357	8
	35	4 1/2		328	335	335	344	9
	30 -L	13		328	330	330	335	5
/	45	5	318	320	320	322	2	
	40	14 1/2	314	316	316	320	4	
	5	13	VISUAL	- some ROCK				

use for system

REMARKS Tests as staked (heavy woods) except for 3 + 5


TYPE OF SOIL SANDY LOAM BELOW CLAY

TESTED BY (GLK) 3 RD

ALSO PRESENT:

PROPOSED SITE PLAN

LOT 13

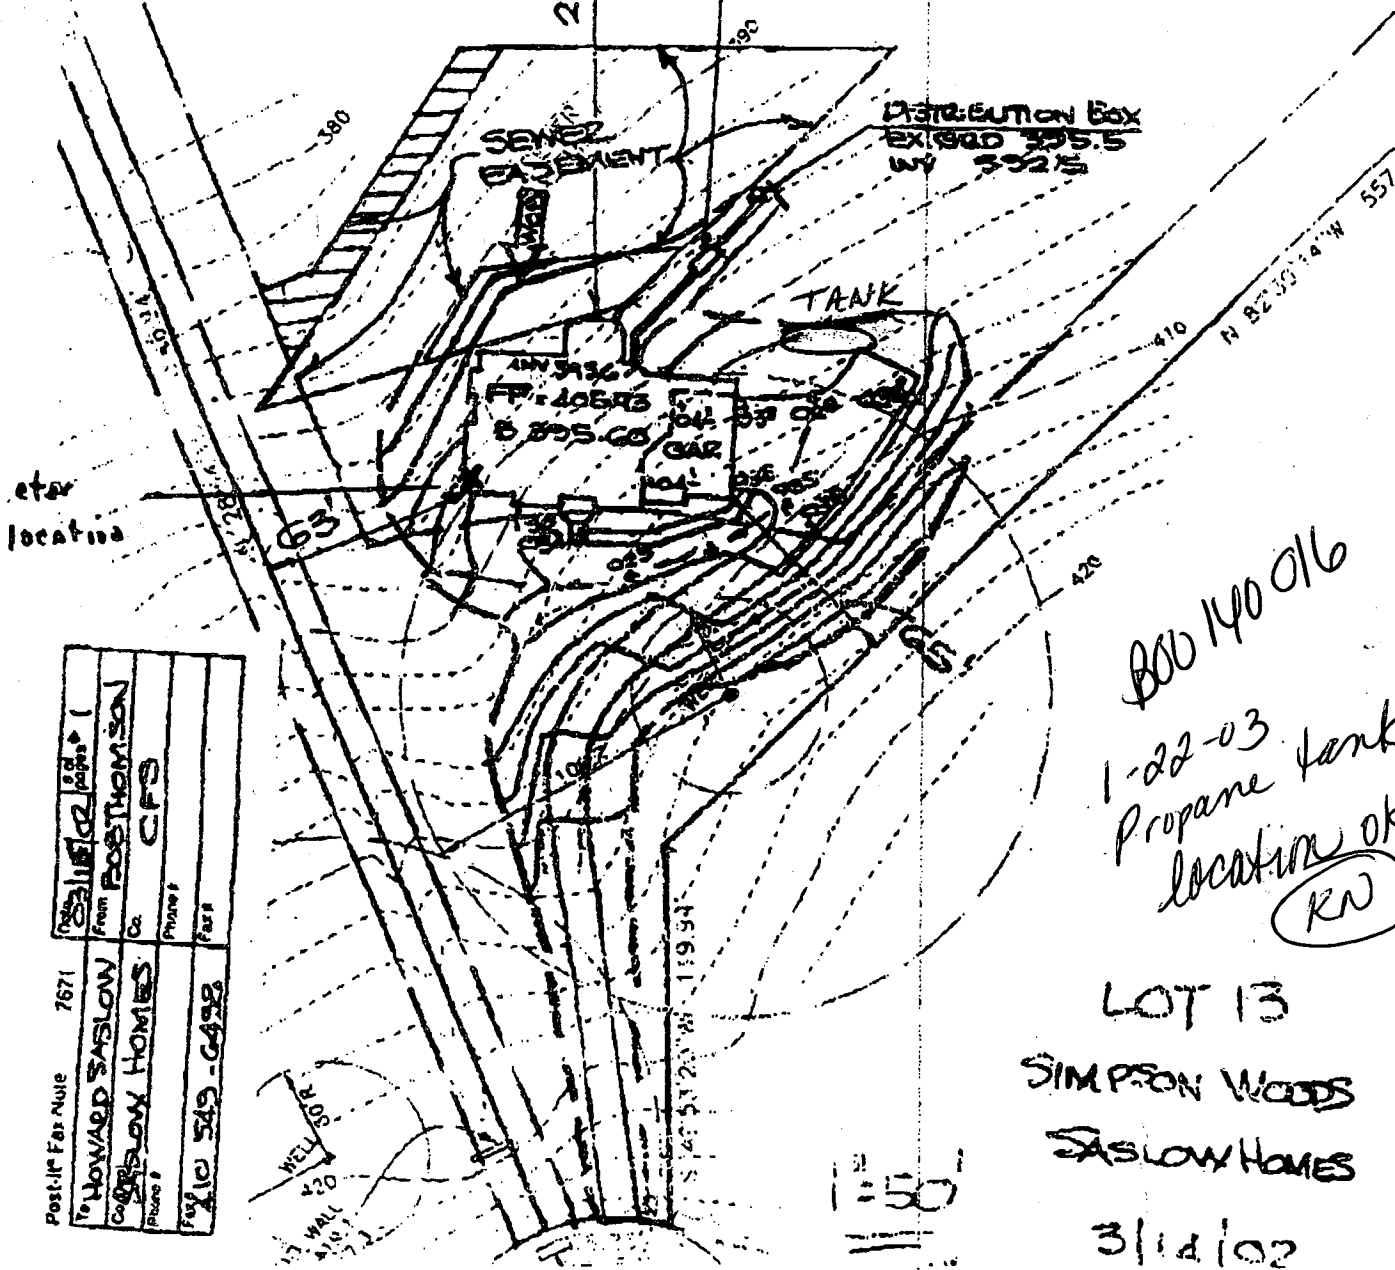


Post-It Fax Note	7671	Call 1-800-140-016
To: HOWARD SASLOW	From: POSTHOMSON	
CASLOW HOMES	Co. CFS	
Phone #		
Fax #		
1-800-543-6498		

800 140 016
1-22-03
Propane tank
location OK
(RW)


LOT 13
SIMPSON WOODS
SASLOW HOMES
3/14/02

Woods, Howards
and the Information,
has And the 1951
1. Property And
... That Is
... of the
... by Paper Survey
... of the
... the Improvements
... the Area And
... the Survey
... the The
... the The
... the Streets Or
... the Or Are
... the Direction Of All
... the Surface Drainage; (i)
... the On The Survey;
... the All Utility Easements
... the and Intersect
... the For Safety Title
... the Survey All Exceptions
... the Acknowledge With The
... the Establishes And
... the and Examines The Current
... the The Property That
... the Not Lie In An Area
... the Special Flood Or

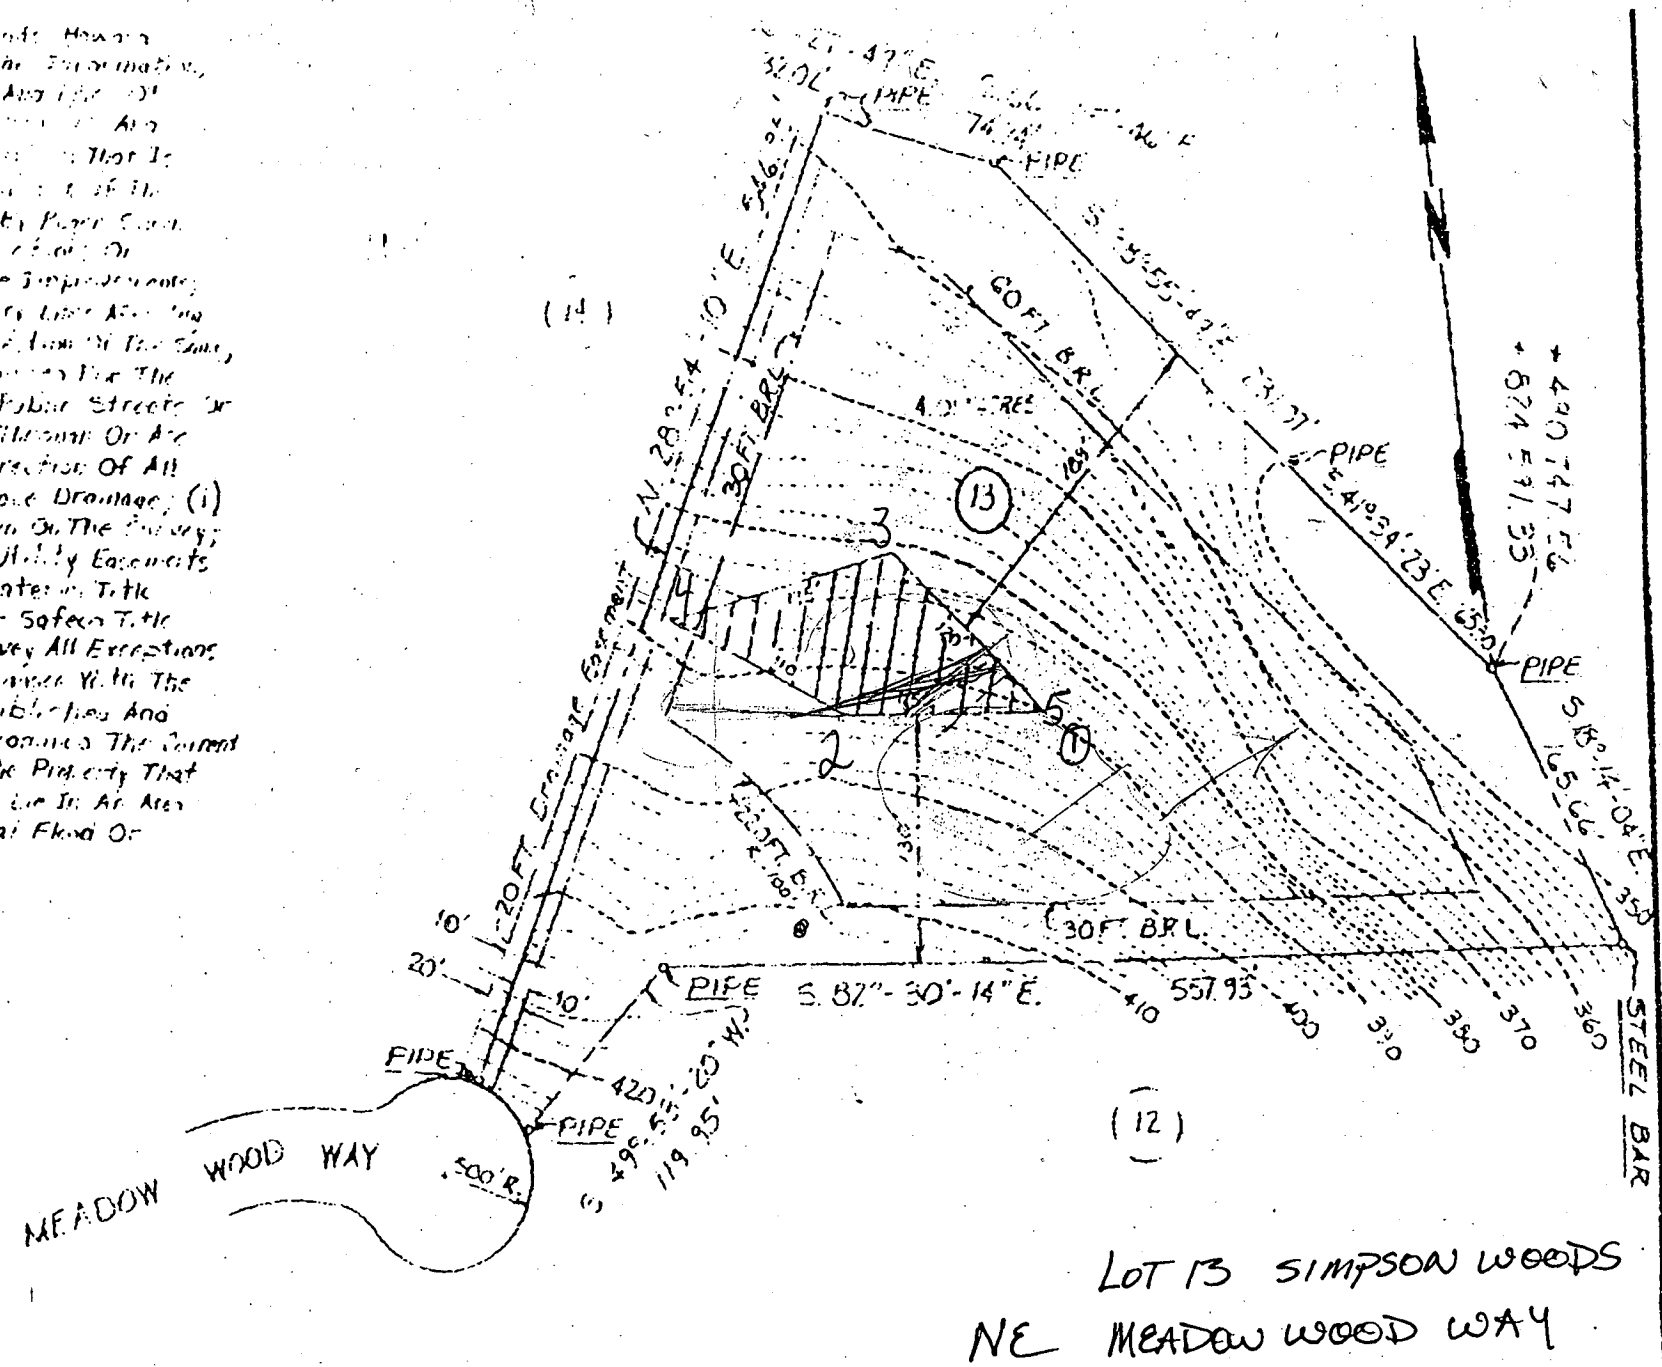

LOT 13 SIMPSON WOODS
NE MEADOW WOOD WAY

Note: All Coordinates Shown Hereon
Are Based On Maryland State Plane System.

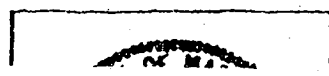

TO: CRANCES	REVISIONS
-------------	-----------

BOUNDARY SURVEY LOT 13