

4/13/78-app'd F.S.
after lunch

PERMIT

SEWAGE DISPOSAL SYSTEM

MARYLAND STATE DEPARTMENT OF HEALTH*

HOWARD COUNTY

P 27773

A 27141

ELLICOTT CITY

DISTRICT 4th

DATE 4/7/78

INDEXED

Jack Fyock

IS PERMITTED TO INSTALL X ALTER

ADDRESS 13775 Triadelphia Road, Glenelg, Md.

PHONE 988-9270

SUBDIVISION (Madden property)

ROAD 4440 Jennings Chapel Road LOT 3

PROPERTY OWNER Roy M. Wrenn

ADDRESS 8 Virginia Drive, Gaithersburg, Md. 20760

Phone: 926-0851 (Work # - 926-5521)

SPECIFICATIONS 3 bedrooms

SEPTIC TANK CAPACITY 1000 GALLONS

DRAIN FIELD _____ DEPTH _____ FEET, BOTTOM AREA _____ SQ. FT.

DEEP TRENCH _____ DEPTH _____ FEET, BOTTOM AREA _____ SQ. FT.

SEEPAGE PITS _____ ABSORBENT SIDE-WALL AREA 360 SQ. FT. sidewall area below inlet.

INLET PIPE 3 FT. BELOW ORIGINAL GRADE. MAXIMUM DEPTH 12 FT. BELOW ORIGINAL GRADE

EFFECTIVE DEPTH AT _____ FT. BELOW ORIGINAL GRADE.

LOCATE DISPOSAL AREA 75 FT. FROM back LOT LINE AND 20 FT. FROM left LOT LINE AS SEEN WHEN

FACING LOT FROM from Jennings Chapel Road.

PLANS APPROVED BY Raymond Hodges

DATE 11/2/77

COVER NO WORK UNTIL INSPECTED AND APPROVED.

NEITHER THE HOWARD COUNTY COUNCIL NOR THE HEALTH DEPARTMENT IS RESPONSIBLE FOR THE SUCCESSFUL OPERATION OF ANY SYSTEM.

NOTE: IF TRENCH IS USED CALL FOR INSPECTION BEFORE PLACING GRAVEL IN TRENCH.

NOTE: NO DRY WELL SHALL EXCEED 15 FOOT IN DIAMETER.


NOTE: ALL PIPE FROM HOUSE TO DISPOSAL AREA MUST BE CAST IRON.

PERMIT VOID AFTER THREE YEARS.

NOTE: INSTALL STAND PIPE ON SEPTIC TANK AND DRY WELL. STAND PIPES MUST BE 6 INCHES IN DIAMETER. CAST IRON, CONCRETE OR TERRA COTTA ACCEPTED.

*INSTALLER IS RESPONSIBLE FOR OBTAINING FINAL APPROVAL ON THIS PERMIT.

A 27141

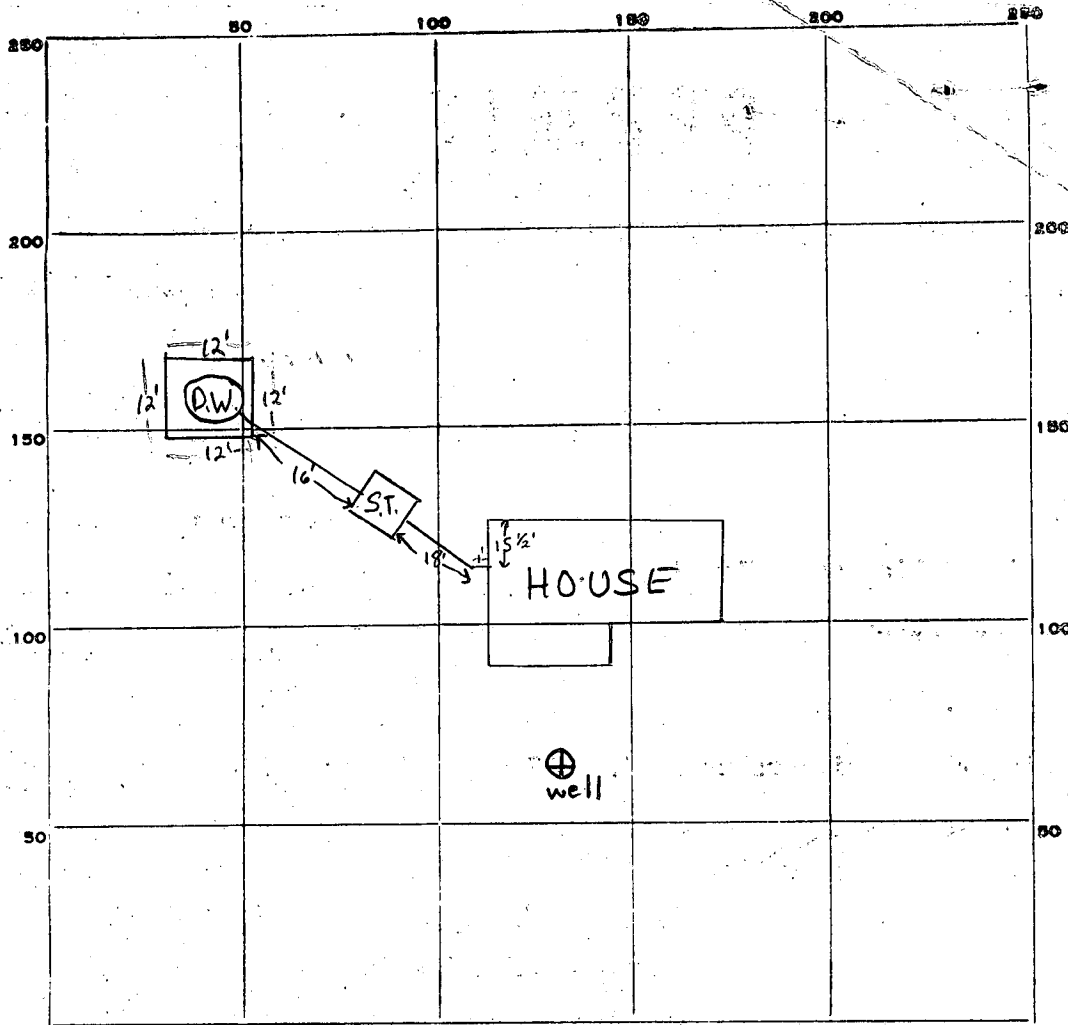

INDICATE NORTH. - NAME ADJOINING ROADWAY AS BASE LINE.

JENNINGS CHAPEL ROAD

PERMIT CARD ☒ signed final O.K. *F.S.*

SEPTIC TANK, LEVEL ☒

CLEANOUTS

S.T. D.W.

☒

☒

DISTRIBUTION BOX, LEVEL n.a.

TILE FIELD, DEPTH FT. TRENCH WIDTH FT.

GRAVEL DEPTH IN. TOTAL LENGTH FT.

NUMBER OF TRENCHES TOTAL BOTTOM AREA

SEEPAGE PITS, INSIDE DIAMETER 48 FT. DEPTH BELOW INLET 8 1/2 FT.

ABSORBENT AREA ± 408 SQ. FT.

REMARKS 4/13/78 Drywell location O.K.; O.K. to cover all work F.S.

DATE SYSTEM APPROVED 4/13/78

INSPECTOR

Frank Skinner

APPLICATION

A 27141

P _____

SEWAGE DISPOSAL TESTING

STATE OF MARYLAND - DEPARTMENT OF HEALTH AND MENTAL HYGIENE

HOWARD COUNTY HEALTH DEPARTMENT
ENVIRONMENTAL HEALTH SERVICESP O. BOX 476, ELLICOTT CITY, MARYLAND 21043
TELEPHONE: 465-5000, EXT. 356DISTRICT 4th
DATE 11/1/77

11/2/77 P.M.
1:30
DRY WELL - 360 SQ FT SIDEWALL AREA BELOW INLET
DRY WELL INLET TO BE 3 FT BELOW ORIGINAL GRADE
" " "BOTTOM" 11 1/2 12 FF " " " "

PLACE THE DRY WELL 75 FT FROM THE
BACK LOT LINE AND 20 FT FROM THE
LEFT SIDE OF THE LOT AS
TO: THE COUNTY HEALTH OFFICER
ELLICOTT CITY, MARYLAND
SEEN WHEN FACING THE LOT
FROM JENNINGS CHAPEL RD

I, HEREBY, APPLY FOR THE NECESSARY TEST IN ORDER TO CONSTRUCT (OR RECONSTRUCT) A SEWAGE
DISPOSAL SYSTEM.

PROPERTY OWNER Madden property Roy M. Whelan
ADDRESS 8 Virginia Drive, Gaithersburg, Md. PHONE 926-0851
20760 (work - Mrs. Whelan - 926-5521)

PROPERTY LOCATION:
SUBDIVISION MADDEN PROPERTY LOT NO. (?) 3
4440
ROAD AND DESCRIPTION Jennings Chapel Road - Route 97 to Jennings Chapel Road - west
off Route 97 - 3rd lot in on left hand side of road.

SIZE OF LOT 0.939 ac TYPE BLDG. 3 ~~or 4~~ 3
NUMBER OF BEDROOMS

IF NOT SINGLE RESIDENCE DESCRIBE _____

THE SYSTEM INSTALLED UNDER THIS APPLICATION IS ACCEPTABLE ONLY UNTIL PUBLIC
FACILITIES BECOME AVAILABLE.

SIGNATURE OF APPLICANT /s/ Enos C. Levy BLDG. PERMIT, SIGNED
AND RETURNED 11/21/77
Series No. 34022

APPROVED BY Raymond Hodge FOR Dry Well DATE 11/2/77
(KIND OF SYSTEM)


REJECTED BY _____ FOR _____ DATE _____
(KIND OF SYSTEM)

HOLD PENDING FURTHER TESTS _____ DATE _____

REASONS FOR REJECTION OR HOLDING _____

THIS IS NOT A PERMIT

see
plat
for sewage
area

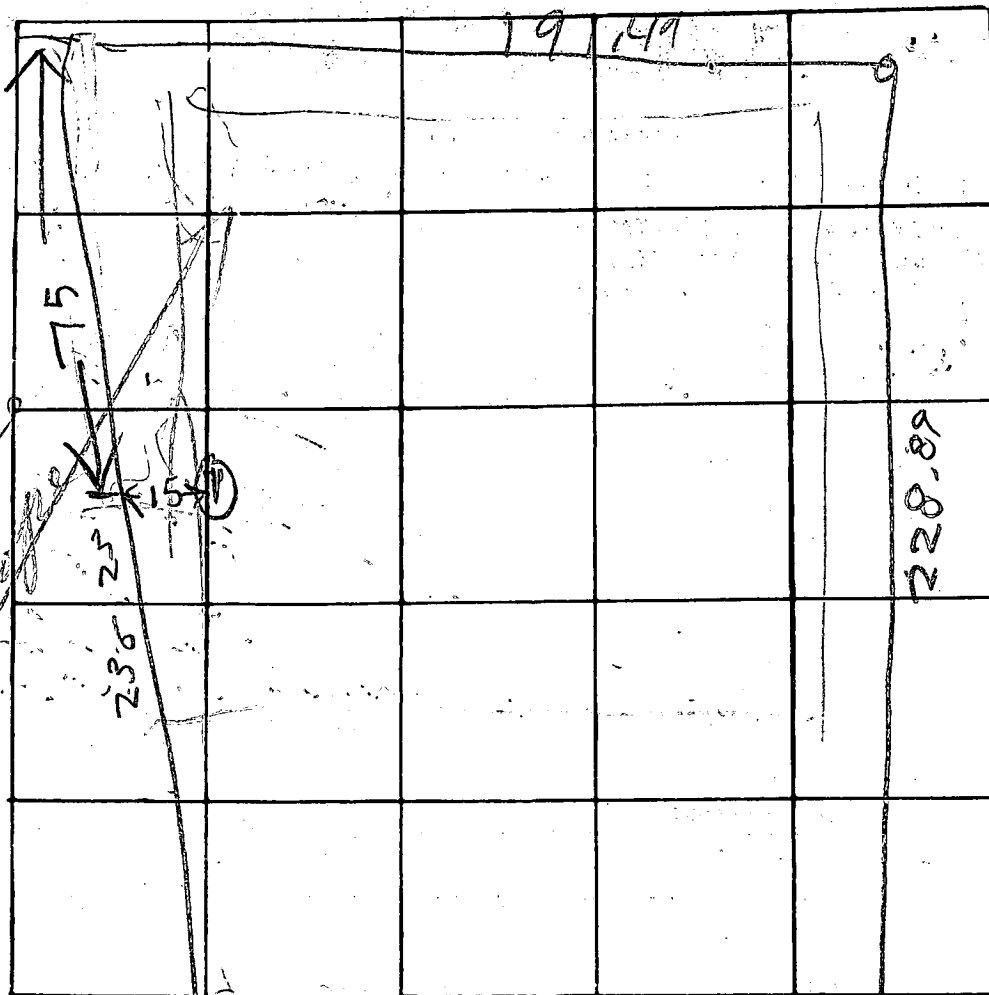

INDICATE NORTH NAME ADJOINING ROADWAY AS BASE LINE

JENNINGS CHAPEL RD

DATE	TEST NO.	DEPTH	PRE-WET		TEST - 1" DROP		TIME
			START	STOP	START	STOP	
11/2/77	1 S	3 1/2	152	155	155	159	4
10/2/77	1 D	13	152	155	155	200	5

REMARKS

TYPE OF SOIL

TESTED BY

B. J. Hodges

ALSO PRESENT:

Lever Bender
Frydick Backhaus

APPLICATION

A 26548

P _____

SEWAGE DISPOSAL TESTING

STATE OF MARYLAND - DEPARTMENT OF HEALTH AND MENTAL HYGIENE

HOWARD COUNTY HEALTH DEPARTMENT
ENVIRONMENTAL HEALTH SERVICESP. O. BOX 476, ELLICOTT CITY, MARYLAND 21043
TELEPHONE: 465-5000, EXT. 356DISTRICT 4th
DATE 8/11/7710/4/77
9:30 A.M.TO: THE COUNTY HEALTH OFFICER
ELLICOTT CITY, MARYLAND

I, HEREBY, APPLY FOR THE NECESSARY TEST IN ORDER TO CONSTRUCT (OR RECONSTRUCT) A SEWAGE DISPOSAL SYSTEM.

PROPERTY OWNER Mr. John T. MaddenADDRESS 4402 Route 97, Brookeville, Maryland 20729 PHONE 301-489-4019PROPERTY LOCATION: Same as aboveNot Combined
(3rd lot to be combined)SUBDIVISION Madden Property LOT NO. 3ROAD AND DESCRIPTION: Southwest corner of Route 97 & Jennings Chapel RoadsSIZE OF LOT 1 acre + TYPE BLDG. Single family up to 4 BR
NUMBER OF BEDROOMS

IF NOT SINGLE RESIDENCE DESCRIBE _____

THE SYSTEM INSTALLED UNDER THIS APPLICATION IS ACCEPTABLE ONLY UNTIL PUBLIC FACILITIES BECOME AVAILABLE.

SIGNATURE OF APPLICANT John T. MaddenAPPROVED BY _____ FOR _____ DATE _____
(KIND OF SYSTEM)REJECTED BY _____ FOR _____ DATE _____
(KIND OF SYSTEM)

HOLD PENDING FURTHER TESTS _____ DATE _____

REASONS FOR REJECTION OR HOLDING _____


THIS IS NOT A PERMIT

1, 3, 2

0 —
1 — sandy
14 —

④

0 —
3 — clay
5 — sandy
13½ —

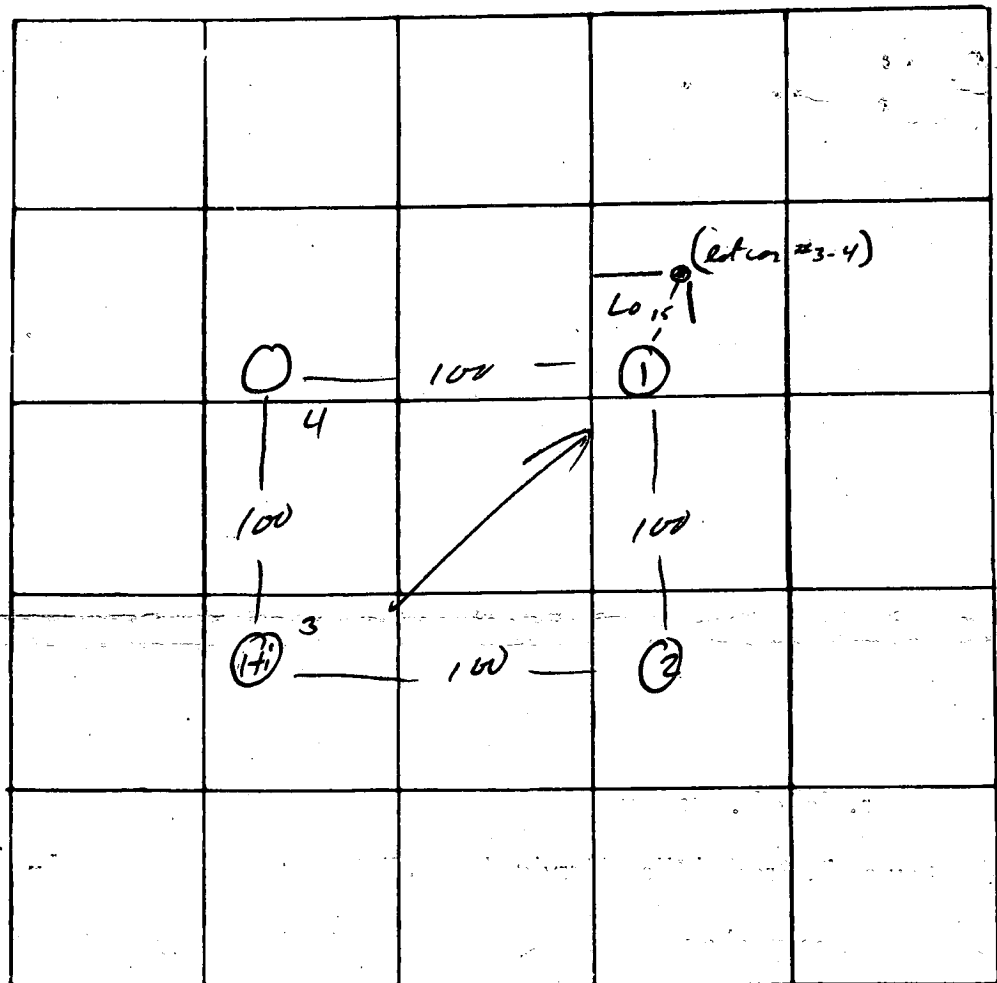

Lot 3(4)

DATE	TEST NO.	DEPTH	PRE-WET		TEST - 1" DROP		TIME
			START	STOP	START	STOP	
15 Sept 77	1	3	12 ³²	12 ⁴³	12 ⁴³	1 ²⁰	27
		14	"	12 ³⁹	12 ³⁹	12 ⁵⁰	11
	2		V's				
	④	3	1 ⁴⁸	1" log 40 min.		—	230
		14	"	1 ⁵⁴	1 ⁵⁴	2 ⁰⁸	14
	3	3	1 ⁴⁵	1 ⁴⁸	1 ⁴⁸	1 ⁵⁴	6
		13½	"	"	"	"	6
	4B	5	2 ¹⁵	2 ²⁹	2 ²⁹	2 ⁵³	24

REMARKS _____

TYPE OF SOIL sandy

TESTED BY M ALSO PRESENT: Scheel & Strimmel

APPLICATION

A 26549

P. _____

SEWAGE DISPOSAL TESTING

STATE OF MARYLAND - DEPARTMENT OF HEALTH AND MENTAL HYGIENE

HOWARD COUNTY HEALTH DEPARTMENT
ENVIRONMENTAL HEALTH SERVICES

P. O. BOX 476, ELLICOTT CITY, MARYLAND 21043
TELEPHONE: 465-5000, EXT. 356

DISTRICT ✓ 4th

DATE 8/11/77

TO: THE COUNTY HEALTH OFFICER
ELLICOTT CITY, MARYLAND

I, HEREBY, APPLY FOR THE NECESSARY TEST IN ORDER TO CONSTRUCT (OR RECONSTRUCT) A SEWAGE DISPOSAL SYSTEM.

PROPERTY OWNER Mr. John T. Madden

ADDRESS 4402 Route 97, Brookeville, Maryland 20729 PHONE 301-489-4019

PROPERTY LOCATION: Same as above

SUBDIVISION Madden Property LOT NO. 4

ROAD AND DESCRIPTION Southwest corner of Route 97 & Jennings Chapel Road

SIZE OF LOT 1 acre [±] TYPE BLDG. Single family up to 4 BR
NUMBER OF BEDROOMS

IF NOT SINGLE RESIDENCE DESCRIBE _____

THE SYSTEM INSTALLED UNDER THIS APPLICATION IS ACCEPTABLE ONLY UNTIL PUBLIC FACILITIES BECOME AVAILABLE.

SIGNATURE OF APPLICANT John T. Madden


APPROVED BY _____ FOR _____ DATE _____
(KIND OF SYSTEM)

REJECTED BY _____ FOR _____ DATE _____
(KIND OF SYSTEM)

HOLD PENDING FURTHER TESTS _____ DATE _____

REASONS FOR REJECTION OR HOLDING _____

THIS IS NOT A PERMIT

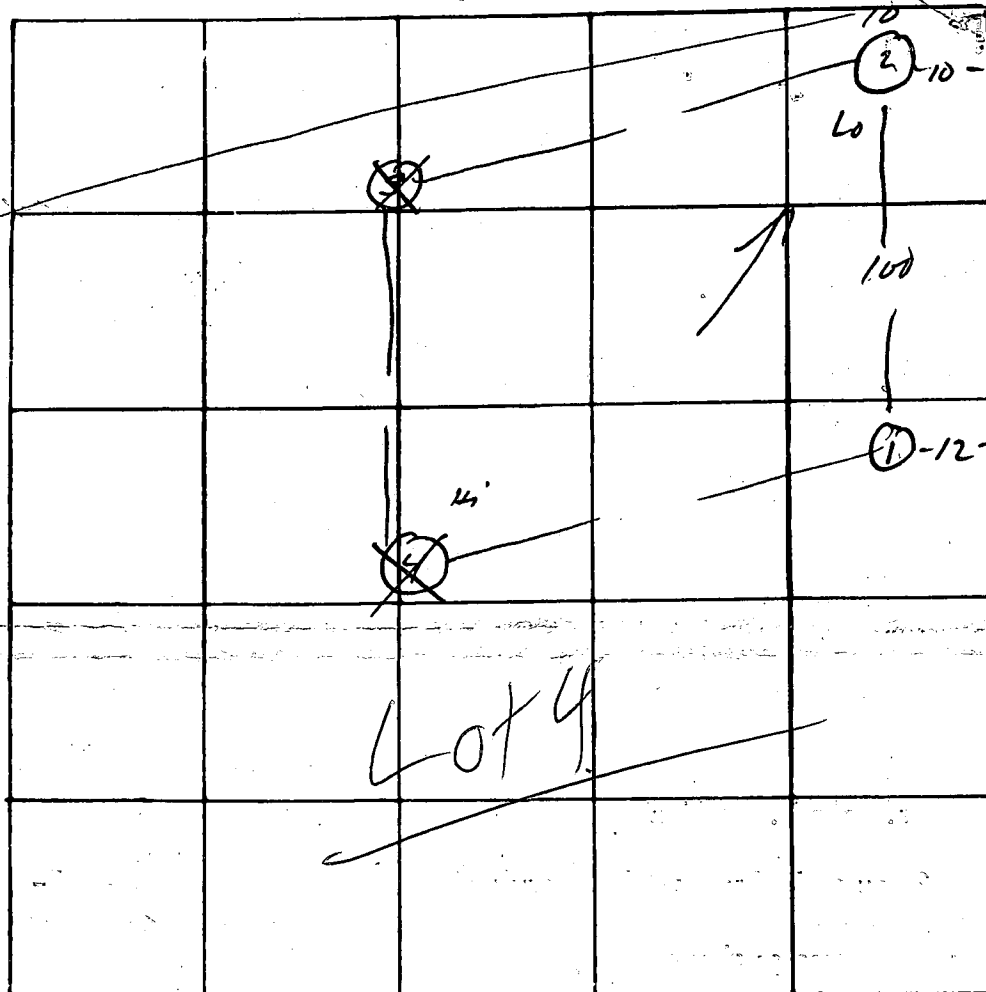

DATE	TEST NO.	DEPTH	PRE-WET		TEST - 1" DROP		TIME
			START	STOP	START	STOP	
15 Sept 77	①	3	10 ⁵⁷	11 ²⁸	31 min 1st inch		130
		12½	"	11 ⁰⁵	11 ⁰⁵	11 ²⁰	15
	②	14	water @	12'			

REMARKS Wet Season

TYPE OF SOIL _____

TESTED BY M

ALSO PRESENT: Strimmel & Scheel

HOMER COUNTY HEALTH DEPT. MD
20 MAR 1977

B 1	0415	SEQUENCE NO. (WRA USE ONLY)	STATE OF MARYLAND WATER RESOURCES ADMINISTRATION TAWES STATE OFFICE BLDG., ANNAPOLIS, MARYLAND 21401 APPLICATION FOR PERMIT TO DRILL WELL	WRA PERMIT NUMBER HO-23-2406 FILL IN THIS FORM COMPLETELY
-----	------	--------------------------------	--	--

DATE RECEIVED (WRA USE ONLY)	OWNER <u>Tattler & Levy Const Co.</u> COL 15 LAST NAME FIRST NAME COL. 34
	STREET OR RFD <u>3689 Hwy Rd.</u> COL. 36 COL. 55
	POST OFFICE <u>Greenwood Md.</u> COL 57 COL. 76

B 1	CONTINUED	DRILLER INFORMATION
1 2 3 (SEQ. NO.) 6		
DATE <u>10/27/77</u>	LICENSE NUMBER <u>42</u> 77 80	
FIRST NAME <u>L. F. Pasterday</u>	DRILLER <u>L. F. Pasterday</u>	LAST NAME
SIGNATURE <u>L. F. Pasterday</u>		

B 3	LOCATION OF WELL
1 2 3 (SEQ. NO.) 6	
COUNTY <u>Howard</u> (DO NOT ABBREVIATE COUNTY NAME)	21
SUBDIVISION <u>23</u>	42
SECTION <u>44</u>	46
LOT <u>48</u>	50
NEAREST TOWN <u>Burnside</u>	71
MILES FROM TOWN (ENTER 0 IF IN TOWN) <u>3</u>	73 76 77 78

B 2	WELL INFORMATION
1 2 3 (SEQ. NO.) 6	
MAXIMUM PUMPING RATE (GALLONS PER MINUTE) <u>5</u>	8 12
AVERAGE DAILY QUANTITY NEEDED (GALLONS PER DAY) <u>600</u>	14 20
USE FOR WATER (CIRCLE APPROPRIATE BOX)	
☒ HOME (SINGLE OR DOUBLE HOUSEHOLD UNIT ONLY)	
☐ FARMING, AGRICULTURE, IRRIGATION	
☐ INDUSTRIAL, COMMERCIAL, STATE AND FEDERAL GOVERNMENT.	
☐ MUNICIPAL WATER SUPPLY	
☐ PRIVATE WATER COMPANY	
☐ TEST	

B 4	DIRECTION FROM TOWN (CIRCLE APPROPRIATE BOX)
1 2 3 (SEQ. NO.) 6	
☒ NORTH	☐ EAST
☐ SOUTH	☐ WEST
☐ NE	☐ SE
☐ NW	☐ SW
NEAR WHAT <u>Jennings Chapel Rd.</u>	
ON WHICH SIDE OF ROAD (CIRCLE APPROPRIATE BOX)	☒ NORTH
	☐ SOUTH
	☐ EAST
	☐ WEST
DISTANCE FROM ROAD (ENTER DISTANCE AND CIRCLE APPROPRIATE BOX)	<u>100</u>

APPROXIMATE DEPTH OF WELL <u>150</u> FEET
APPROXIMATE DIAMETER OF WELL <u>6</u> (NEAREST INCH)

METHOD OF DRILLING USED (CIRCLE APPROPRIATE METHOD)		
☒ BORED (OR AUGERED)	☐ JETTED	☐ DRIVEN
☒ AIR-ROTARY	☐ AIR-PERCUSION	☐ ROTARY (HYDRAULIC ROTARY)
☐ CABLE	☐ REVERSE-ROTARY	☐ DRIVE-POINT
OTHER (DESCRIBE)		

REPLACEMENT OR DEEPEMED WELLS (CIRCLE APPROPRIATE BOX)	
☒ THIS WELL WILL NOT REPLACE AN EXISTING WELL	
☐ THIS WELL WILL REPLACE A WELL THAT WILL BE ABANDONED AND SEALED	
☐ THIS WELL WILL REPLACE A WELL THAT WILL BE USED AS A STANDBY	
☐ THIS WELL WILL DEEPEMED AN EXISTING WELL PERMIT NUMBER OF WELL TO BE REPLACED OR DEEPEMED (IF AVAILABLE)	

NOT TO BE FILLED IN BY DRILLER (WRA USE ONLY)	
APPROPRIATION PERMIT NUMBER <u>54</u>	ENGINEER REVIEW DISTRICT NO. <u>63</u>
FORCE <u>67</u>	CONDITIONS <u>68</u>

B 4	HEALTH DEPARTMENT APPROVAL
1 2 3 (SEQ. NO.) 6	
STATE HEALTH (CIRCLE BOX) <u>5</u>	COUNTY NAME <u>Howard</u>
DATE <u>10/28/77</u>	COUNTY NO. <u>W27124</u>
APPROVED BY <u>Fred Frommelt, Sanitarian</u>	

DRAW A SKETCH BELOW SHOWING LOCATION OF WELL IN RELATION TO NEARBY TOWNS, ROADS AND STREAMS WITH NORTH IN THE DIRECTION OF THE ARROW, AND GIVE DISTANCE FROM WELL TO NEAREST ROAD JUNCTION OR STREAM CROSSING SHOWN ON THE SKETCH. ALSO SHOW, BY MEANS OF AN "X", THE WELL LOCATION IN THE BOX BELOW AND THE BOX NUMBER FROM THE WELL LOCATION MAP.

BOX NUMBER <u>780</u> <u>510</u>	
NORTH COORDINATE <u>510000</u>	EAST COORDINATE <u>0585000</u>
ELEVATION AT WELL HEAD (FEET) <u>65</u>	

B 5	SPECIAL CONDITIONS 8-83 (WRA USE ONLY)
1 2 3 (SEQ. NO.) 6	

Need better directions

NO AREA
ON CO.
MAP

C. 1	8323	SEQUENCE NO. (WRA USE ONLY)	STATE OF MARYLAND WATER RESOURCES ADMINISTRATION TAWES STATE OFFICE BLDG., ANNAPOLIS, MD. 21401 WELL COMPLETION REPORT		THIS REPORT MUST BE SUBMITTED WITHIN 30 DAYS AFTER WELL COMPLETION FILL IN THIS FORM COMPLETELY COUNTY NUMBER _____																						
DATE RECEIVED (WRA USE ONLY) _____ DATE WELL COMPLETED <u>11/18/77</u> 8-13 15 20		DEPTH OF WELL <u>140</u> 22 (TO NEAREST FOOT) 26		PERMIT NO. FROM "PERMIT TO DRILL WELL" <u>40-14-2406</u> 28 29 30 31 32 33 34 35 36 37																							
OWNER <u>TAL TRIE & LEVY CONST.</u> LAST NAME FIRST NAME STREET OR RFD <u>TAL TRIE & LEVY CONST. 3689 SHELTON RD.</u> POST OFFICE <u>GLENNWOOD, MD.</u>																											
WELL LOG STATE THE KIND OF FORMATIONS PENETRATED, THEIR COLOR, DEPTH, THICKNESS AND IF WATER BEARING <table border="1" style="width:100%; border-collapse: collapse;"> <thead> <tr> <th rowspan="2">DESCRIPTION (USE ADDITIONAL SHEETS IF NECESSARY)</th> <th colspan="2">FEET</th> <th rowspan="2">CHECK IF WATER BEARING</th> </tr> <tr> <th>FROM</th> <th>TO</th> </tr> </thead> <tbody> <tr> <td><u>TOP SOIL</u></td> <td><u>0</u></td> <td><u>2</u></td> <td></td> </tr> <tr> <td><u>SHALE</u></td> <td><u>2</u></td> <td><u>10</u></td> <td></td> </tr> <tr> <td><u>SANDSTONE</u></td> <td><u>10</u></td> <td><u>113</u></td> <td>☒</td> </tr> <tr> <td><u>CLAY</u></td> <td><u>113</u></td> <td><u>140</u></td> <td></td> </tr> </tbody> </table>			DESCRIPTION (USE ADDITIONAL SHEETS IF NECESSARY)	FEET		CHECK IF WATER BEARING	FROM	TO	<u>TOP SOIL</u>	<u>0</u>	<u>2</u>		<u>SHALE</u>	<u>2</u>	<u>10</u>		<u>SANDSTONE</u>	<u>10</u>	<u>113</u>	☒	<u>CLAY</u>	<u>113</u>	<u>140</u>		GROUTING RECORD WELL HAS BEEN GROUTED (CIRCLE APPROPRIATE BOX) ☒ YES ☐ NO TYPE OF GROUTING MATERIAL (CIRCLE BOX) CEMENT ☒ BENTONITE CLAY ☐ NO. OF BAGS <u>11</u> NO. OF POUNDS <u>1100</u> GALLONS OF WATER <u>55</u> DEPTH OF GROUT SEAL (TO NEAREST FOOT) FROM <u>0</u> FT. TO <u>51+</u> FT. (ENTER 0 IF FROM SURFACE)		
DESCRIPTION (USE ADDITIONAL SHEETS IF NECESSARY)	FEET			CHECK IF WATER BEARING																							
	FROM	TO																									
<u>TOP SOIL</u>	<u>0</u>	<u>2</u>																									
<u>SHALE</u>	<u>2</u>	<u>10</u>																									
<u>SANDSTONE</u>	<u>10</u>	<u>113</u>	☒																								
<u>CLAY</u>	<u>113</u>	<u>140</u>																									
CASING RECORD CASING TYPES INSERT ☒ STEEL ☐ CONCRETE APPROPRIATE CODE BELOW BELOW ☐ PLASTIC ☐ OTHER MAIN CASING TYPE ☒ <u>ST</u> NOMINAL DIAMETER TOP (MAIN) CASING (NEAREST INCH) <u>6</u> TOTAL DEPTH OF MAIN CASING (NEAREST FOOT) <u>61</u>			PUMPING TEST HOURS PUMPED (TO NEAREST HOUR) <u>2</u> PUMPING RATE (GALLONS PER MINUTE TO NEAREST GALLON) <u>10</u> METHOD USED TO MEASURE PUMPING RATE <u>BUCKET</u> WATER LEVEL (DISTANCE FROM LAND SURFACE) BEFORE PUMPING <u>65</u> (NEAREST FOOT) WHEN PUMPING <u>140</u> (NEAREST FOOT) TYPE OF PUMPED USED (CIRCLE APPROPRIATE BOX) (FOR PUMPING TEST) ☒ AIR ☐ PISTON ☐ TURBINE ☐ CENTRIFUGAL ☐ ROTARY ☐ OTHER (DESCRIBE BELOW) ☐ JET ☐ SUBMERSIBLE																								
OTHER CASING (IF USED) DIAMETER (INCH) _____ DEPTH (FEET) FROM _____ TO _____ EACH CASING _____			PUMP INSTALLED TYPE OF PUMP (WRITE APPROPRIATE LETTER IN BOX - SEE ABOVE: A, C, J, P, R, S, T, O) DRILLER WILL INSTALL PUMP (CIRCLE APPROPRIATE BOX) ☒ YES ☐ NO CAPACITY: GALLONS PER MINUTE (TO NEAREST GALLON) _____ PUMP HORSEPOWER _____ PUMP COLUMN LENGTH (NEAREST FOOT) _____																								
SCREEN RECORD SCREEN TYPE OR OPEN HOLE INSERT ☒ STEEL ☐ BRASS ☐ OPEN HOLE APPROPRIATE CODE BELOW BELOW ☐ PLASTIC ☐ OTHER			LOCATION OF WELL ON LOT SHOW PERMANENT STRUCTURE SUCH AS BUILDINGS, SEPTIC TANKS, AND/OR OTHER LAND MARKS AND INDICATE NOT LESS THAN TWO DISTANCES (MEASUREMENTS TO WELL). <u>JENNINGS CHURCH RD.</u> <u>60'</u>																								
CIRCLE APPROPRIATE BOXES ☐ A WELL WAS ABANDONED AND SEALED WHEN THIS WELL WAS COMPLETED ☐ E ELECTRIC LOG OBTAINED ☐ P TEST WELL CONVERTED TO PRODUCTION WELL I HEREBY CERTIFY THAT I HAVE COMPLIED WITH ALL CONDITIONS STATED ON THE ABOVE-CAPTIONED "PERMIT TO DRILL WELL", AND THAT INFORMATION CONTAINED IN THIS REPORT IS TRUE, ACCURATE, AND COMPLETE TO THE BEST OF MY KNOWLEDGE, INFORMATION AND BELIEF. DRILLERS NAME _____ (PLEASE PRINT) <u>L. F. EASTERDAY</u> SIGNATURE <u>L. F. Easterday</u>			DEPTHS DEPTH (NEAREST WHOLE FOOT) FROM TO 1 <u>110</u> <u>59</u> <u>140</u> 2 _____ 3 _____ 23 24 26 30 32 36 38 39 41 45 47 51 SLOT SIZE 1. _____ 2. _____ 3. _____ DIAMETER OF SCREEN _____ (NEAREST INCH) FROM _____ TO _____ GRAVEL PACK _____ IF WELL DRILLED WAS A FLOWING WELL CIRCLE BOX ☐ 68 ☐ F WRA USE ONLY (NOT TO BE FILLED IN BY DRILLER) T ☐ (E.R.O.S.) ☐ W ☐ 70 ☐ 72 ☐ TELESCOPE CASING LOG INDICATOR OTHER DATA AVAILABLE																								


I certify the above measurements and elevation differences are actual and correct for this property.

E. C. Levy

3-4	2757.44	05°12'41"	250.31	125.49	250.72	501°25'19"E
10-11	25.00	76°17'55"	33.29	107.64	30.89	537°58'25"E
11-5	2807.44	04°11'28"	205.36	102.72	205.31	501°58'12"E

COORDINATE SCHEDULE		
Nd.	North	East
1	10,145.46	9,453.44
2	10,067.06	9,768.06
3	10,018.95	9,965.50
4	9,718.31	9,971.72
5	9,765.40	9,921.80
6	9,758.00	9,795.00
7	9,713.85	9,613.27
8	9,687.94	9,326.16
9	10,106.90	9,442.72
10	9,974.94	9,895.92
11	9,970.59	9,914.92

Datum Assumed

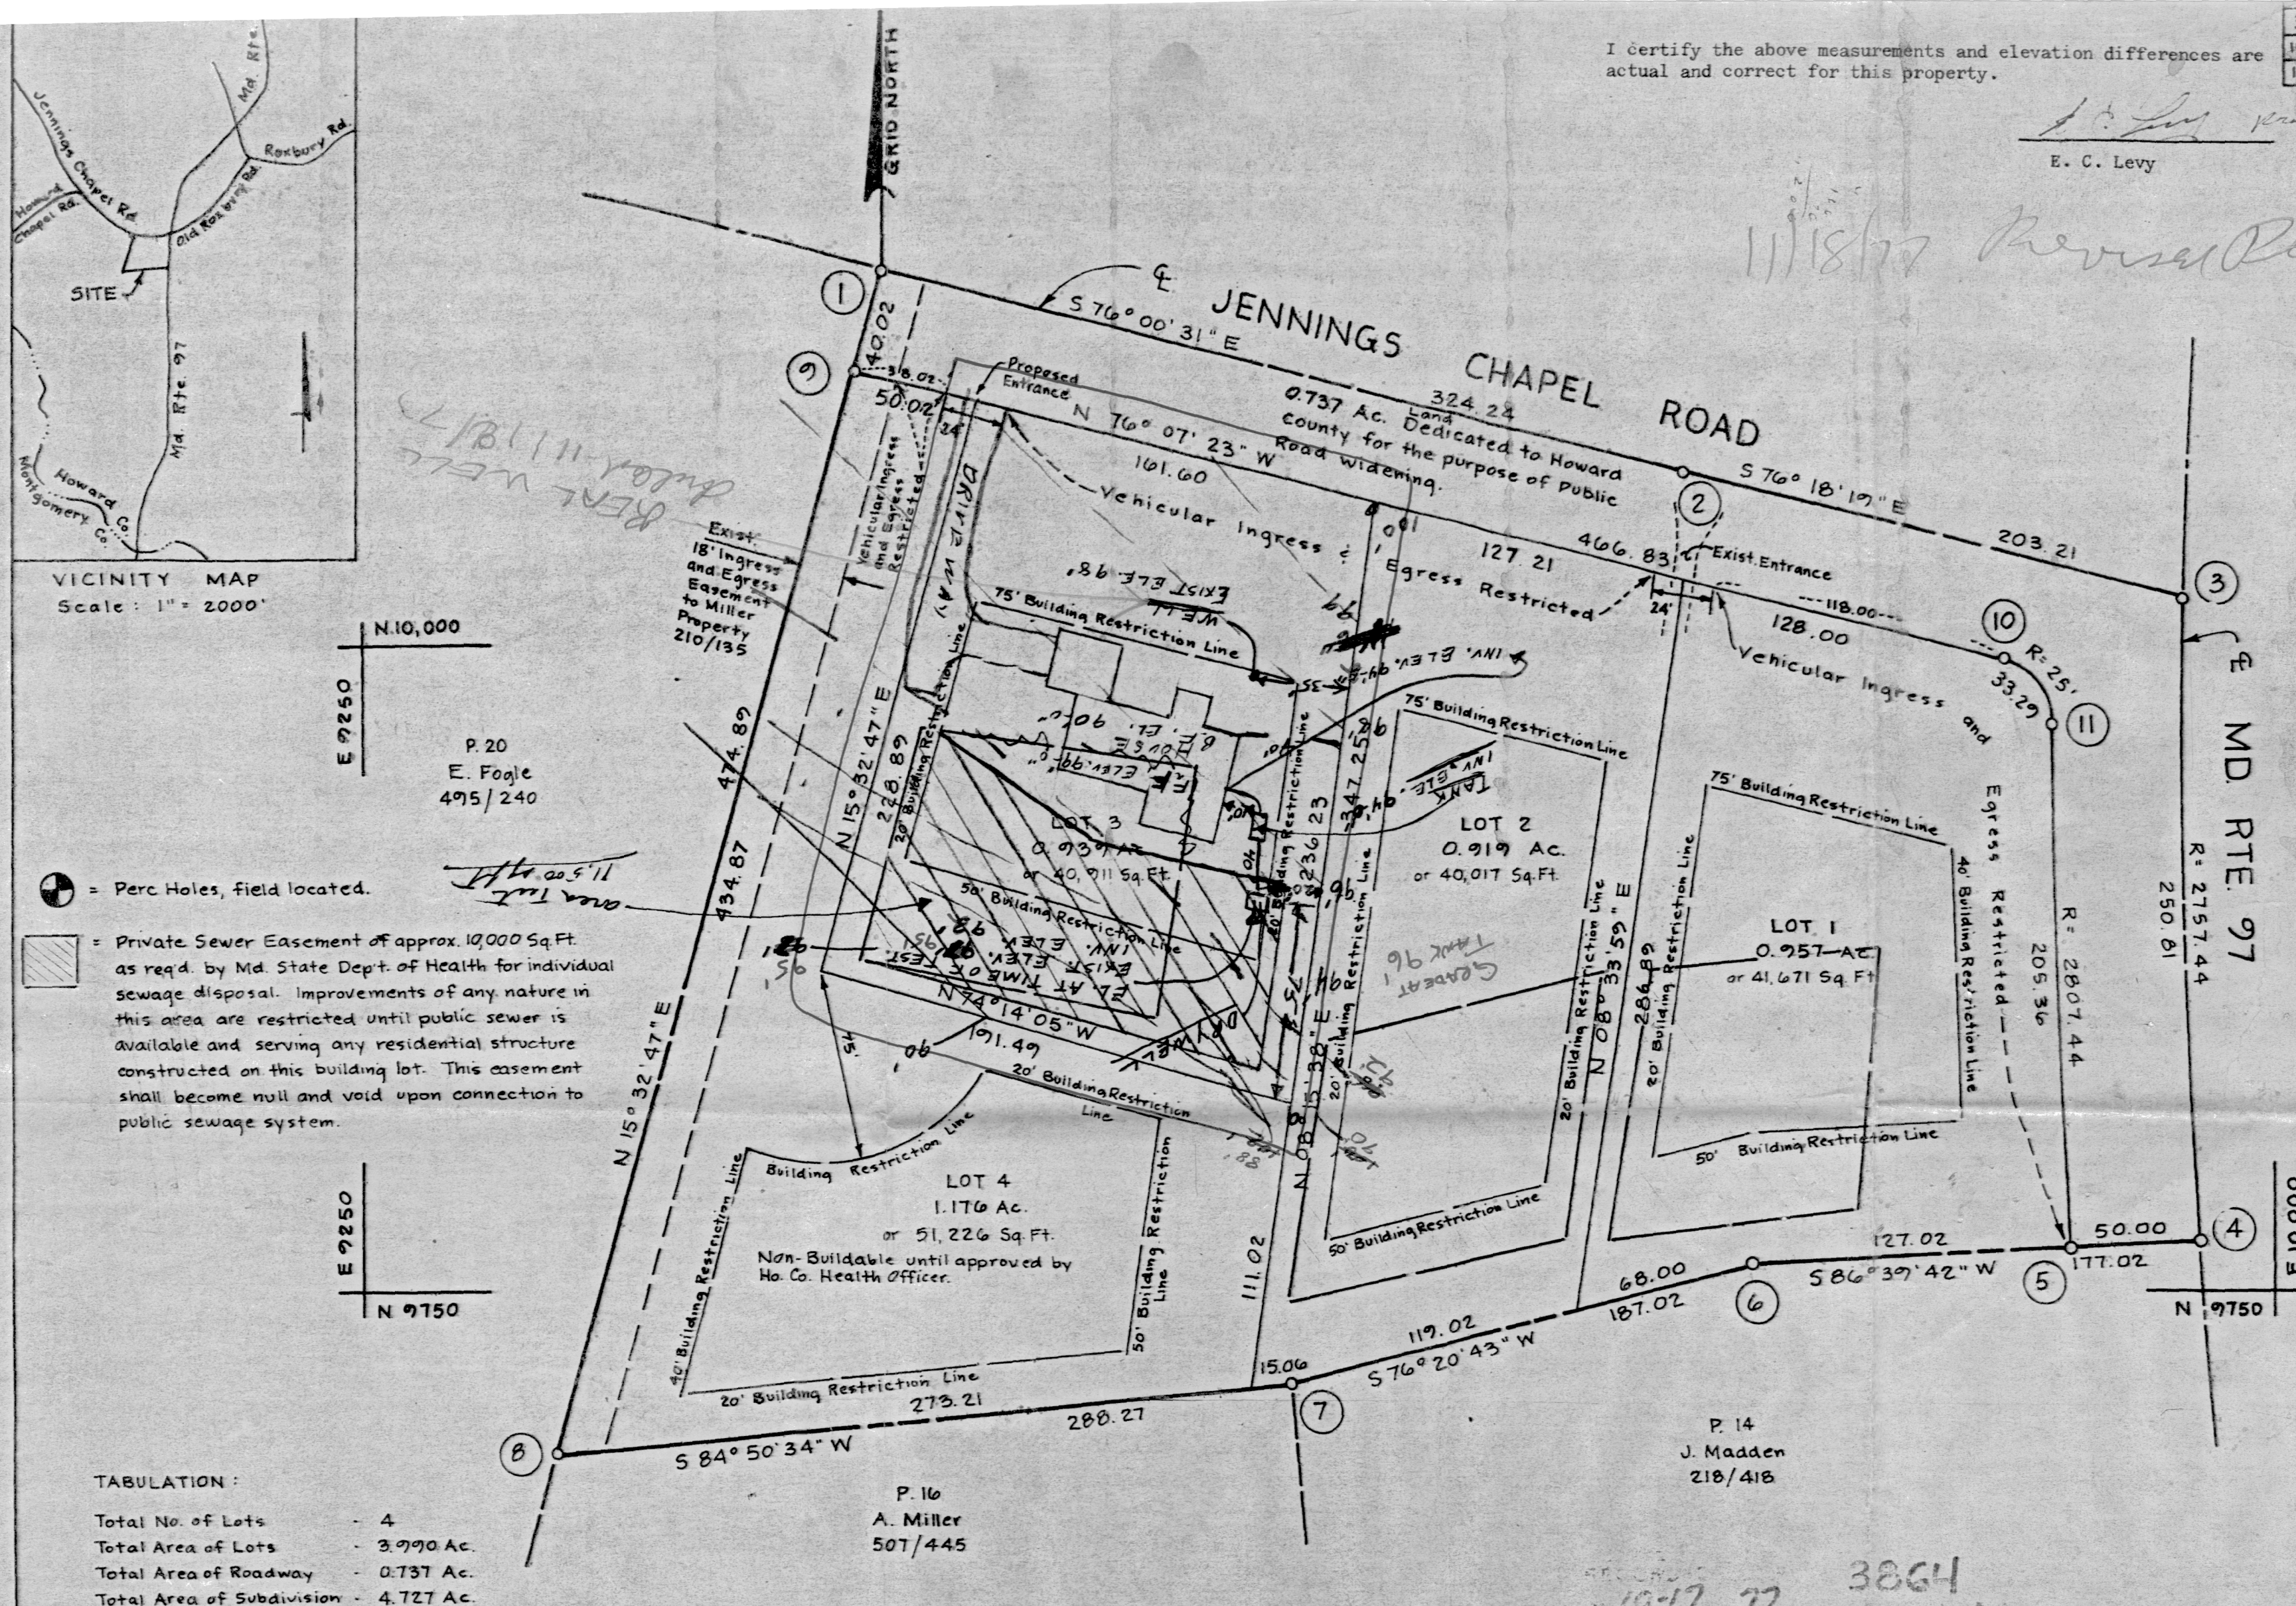

THIS PLAT SUBJECT TO
VP-78-10.

OWNER:
John T. and Anna B. Madden
4402 Route 97
Brookeville, Md. 20729



APPROVED: For Private Water and Private Sewerage Systems, Howard County Health Department.

John T. Madden 10-12-77
County Health Officer Date

APPROVED: Howard County Office of Planning and Zoning.

[Signature] 10-12-77
Director Date

APPROVED: For Storm Drainage Systems and Public Roads, Howard County Dept. of Public Works.

OWNER'S DEDICATION

I, (We) John T. Madden and Anna B. Madden, owner(s) of the property shown and described hereon, hereby adopt this plan of subdivision, and in consideration of the approval of this plat by the Office of Planning and Zoning establish the minimum building restriction lines, and grant unto Ho. Co., Md., its successors and assigns (1) the right to lay, construct and maintain sewers, drains, water pipes and other municipal utilities and services; in and under all roads and street rights of way and the specific easement areas shown hereon, (2) dedicate to public use the beds of the streets and or roads and floodplains and open space where applicable, and for One Dollar consideration, hereby grant the right and option to Ho. Co. to acquire the fee simple title to the beds of the streets and or roads and floodplains and open space where applicable, (3) that no building or similar structure shall be erected on or over the said easements and rights of way, and (4) it is further agreed that maintenance of all water ways, drainage easements and or floodplains shown hereon are the responsibility of the property owner, its successors or assigns.

Witness my (our) hand(s) this _____ day of _____, 1977

Signature

SURVEYORS CERTIFICATE

I hereby certify that the Final Plat shown hereon is correct, that it is a subdivision of all of the lands conveyed By Clarence F. Morrison to John T. and Anna B. Madden deed, dated Feb. 5, 1953 and recorded in the Land Records of Howard County, in Liber 240 Folio 480, and that all monuments are in place as shown in accordance with the Annotated Code of Maryland, as amended.

Carl Hudgins #96 / *Carl Hudgins* 8-3-77
Surveyor Date

MADDEN PROPERTY

4440 Jennings Chapel Rd.
Roy Wrenn

Parcel 15
Tax Map 27
4th Election Dist.
Howard County, Md.

Date: 8-3-77 Scale: 1" = 50'
Rev. 9-30-77
Rev. 10-7-77
Rev. 10-12-77