

9/24/91
10/15/91
12:00 noon
also see contractor

PERMIT

SEWAGE DISPOSAL SYSTEM

MARYLAND STATE DEPARTMENT OF HEALTH

HOWARD COUNTY
BUREAU OF ENVIRONMENTAL HEALTH
461-9933

INDEXED

05-347122

P 47493

A 27904

DISTRICT 5th

DATE 4/19/01

DATE SYSTEM APPROVED 10/11/91

INSPECTOR BH

C. C. Cissel

IS PERMITTED TO INSTALL ☒ ALTER ☐

ADDRESS 14079 Brighton Dam Road, Clarksville, Maryland PHONE 854-2006

SUBDIVISION E. F. Cox Property ROAD 13955 Clarksville Pike LOT 7C

PROPERTY OWNER Robert & Carol Messerly

ADDRESS

~~IF GARBAGE GRINDER IS USED IN SEWER LINE, IT MUST BE INSTALLED IN THE SEWER LINE AND NOT IN THE SEWER TANK OR IN THE SEWER LINE AREA.~~

~~GARBAGE GRINDER YES XXXXXXXXXXXXXXXXXXXX~~

5 FT

SEPTIC TANK CAPACITY 1000 GALLONS NUMBER OF BEDROOMS 3

3 FT

TRENCHES - 180 sq. ft. per bedroom. Trench to be 3 feet wide. Inlet 2 1/2 feet below original grade. Bottom maximum depth 4 feet below original grade. Effective area begins at 2 1/2 feet below original grade. 1 1/2 feet of stone below distribution pipe.

LOCATION - Start the first trench 20 ft from the right side line and 150 feet from the front lot line (which is 131.68 ft. long). Continue to dig the trench on level ground running towards the left side of lot. Place the 2nd trench roughly parallel to the first trench and 9 feet away.

NOTE - No trench to exceed 100 feet in length. Provide 6" - 8" diameter cleanout and cap to grade or above on septic tank. 7-6-90 JEN

REVISED BY BH AFTER SITE INSPECTION 4/24/91

PLANS APPROVED BY Frank Skinner cm DATE 05/04/83

COVER NO WORK UNTIL INSPECTED AND APPROVED

BLDG. PERMIT SIGNED

NEITHER THE HOWARD COUNTY COUNCIL NOR THE HEALTH DEPARTMENT IS RESPONSIBLE FOR THE SUCCESSFUL OPERATION OF ANY SYSTEM

AND RETURNED 6/7/2000

NOTE: CLEANOUT REQUIRED EVERY 70 FEET OF SEWER LINE AND/OR AT 90° SWEEPS IN LINES FROM HOUSE TO DRAIN FIELDS

B00124686

NOTE: ALL PARTS OF SEPTIC SYSTEMS (I.E., TANK, DISTRIBUTION BOX, TRENCHES) TO BE 100 FEET FROM WELL (UNLESS OTHERWISE SPECIFICALLY AUTHORIZED)

ABOVE GROUND POOL

NOTE: IF DEEP TRENCH(IES) ARE USED CALL FOR INSPECTION BEFORE AND AFTER PLACING GRAVEL IN TRENCH(IES)

BLDG. PERMIT SIGNED

NOTE: NO DRY WELL SHALL EXCEED 15 FOOT IN DIAMETER NO ABSORPTION TRENCH TO EXCEED 100 FEET IN LENGTH

AND RETURNED 5/9/01

NOTE: ALL PIPE FROM HOUSE TO SEPTIC TANK MUST BE CAST IRON OR SCHEDULE 40 PVC OR ABS

Deck to above ground pool B00130073

PERMIT VOID AFTER TWO YEARS

NOTE: INSTALL STAND PIPE ON SEPTIC TANK AND DRY WELL. STAND PIPES MUST BE 6 INCHES IN DIAMETER. CAST IRON, CONCRETE OR TERRA COTTA OR PVC OR ABS ACCEPTED. IF TOP OF SEPTIC TANK IS DEEPER THAN 3 FEET, MANHOLE TO GRADE REQUIRED


BLDG. PERMIT SIGNED

NOTE: DISTRIBUTION BOXES MUST HAVE BAFFLES

AND RETURNED 9/22/94

*INSTALLER IS RESPONSIBLE FOR OBTAINING FINAL APPROVAL ON THIS PERMIT

*CALL 461-9933 FOR INSPECTION OF SEPTIC SYSTEMS.

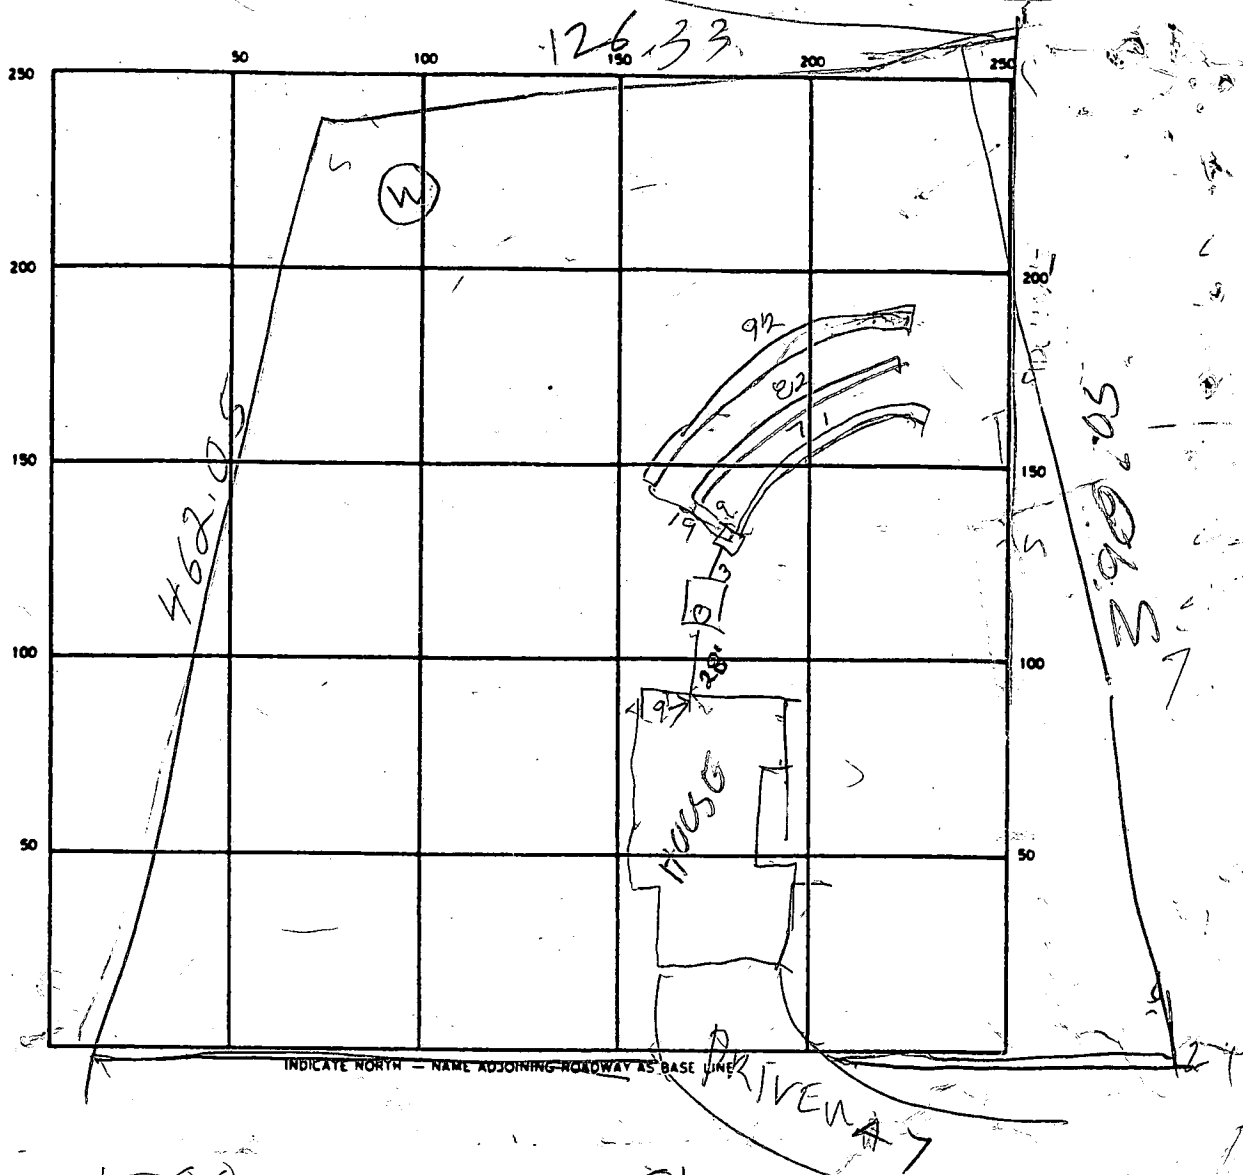

SEPTIC TANK. LEVEL 1500 CLEANOUTS OK

DISTRIBUTION BOX. LEVEL OK

DRAIN FIELD/TILE FIELD. DEPTH 5 FT. TRENCH WIDTH 3 FT. INLET DEPTH 2 1/2 - 3 FT.

EFFECTIVE GRAVEL DEPTH 2 FT. TOTAL LENGTH 94/24/71 FT. 247

NUMBER OF TRENCHES 3 ONE SIDEWALL/BOTTOM AREA 741 SQ. FT.

DRYWELL INSIDE DIAMETER _____ FT. EFFECTIVE DEPTH BELOW INLET _____ FT.

ABSORBENT AREA _____ SQ. FT.

REMARKS 9/24/91 VISITED SITE MET WITH C. CISSEL & OWNER

10/1/91 TRENCHES OK

DATE SYSTEM APPROVED 10/1/91 INSPECTOR Raymond Hodges

Ken Allen

C1 2915		SEQUENCE NO. (OEP USE ONLY)		STATE OF MARYLAND WELL COMPLETION REPORT FILL IN THIS FORM COMPLETELY PLEASE PRINT OR TYPE		THIS REPORT MUST BE SUBMITTED WITHIN 45 DAYS AFTER WELL IS COMPLETED.	
DATE RECEIVED		DATE WELL COMPLETED		Depth of Well		PERMIT NO.	
12 18 84		12 18 84		305		FROM "PERMIT TO DRILL WELL"	
OWNER: Messerly		last name		first name Robert		H0-81-0719	
STREET OR RFD Four Wheel Drive		TOWN Highland		SUBDIVISION E. F. Cox property		SECTION 7C	
WELL LOG		GROUTING RECORD		C 3		PUMPING TEST	
Not required for driven wells		WELL HAS BEEN GROUTED		HOURS PUMPED (nearest hour) 6		PUMPING RATE (gal. per min. to nearest gal.) 10	
STATE THE KIND OF FORMATIONS PENETRATED, THEIR COLOR, DEPTH, THICKNESS AND IF WATER BEARING		(Circle Appropriate Box)		TYPE OF GROUTING MATERIAL		METHOD USED TO MEASURE PUMPING RATE SUBMERSIBLE	
DESCRIPTION (Use additional sheets if needed)		CEMENT CM BENTONITE CLAY BC		WATER LEVEL (distance from land surface)		BEFORE PUMPING 13	
FEET FROM TO		NO. OF BAGS 11 NO. OF POUNDS 1100		WHEN PUMPING 280		TYPE OF PUMP USED (for test)	
Clay 0 10		GALLONS OF WATER 66		A air P piston T turbine		C centrifugal R rotary O other (describe below)	
Sandy soil 20 40		DEPTH OF GROUT SEAL (to nearest foot)		J jet S submersible		PUMP INSTALLED	
Mica 40 305 X		from 0 ft. to 49 ft.		DRILLER WILL INSTALL PUMP YES NO		IF DRILLER INSTALLS PUMP, THIS SECTION MUST BE COMPLETED FOR ALL WELLS EXCEPT HOME USE	
Rock 40 305 X		Casing Record		TYPE OF PUMP INSTALLED		PLACE (A,C,J,P,R,S,T,O) IN BOX-SEE ABOVE:	
WELL #1 505' DRY		ST CO PL OT		CAPACITY: GALLONS PER MINUTE		PUMP HORSE POWER	
WELL #2 145' DRY		MAIN Nominal diameter Total depth		PUMP COLUMN LENGTH		CASING HEIGHT (circle appropriate box and enter casing height)	
(BACKFILLED)		Casing top (main) casing of main casing		LAND SURFACE		LOCATION OF WELL ON LOT	
		TYPE (nearest inch) (nearest foot)		SHOW PERMANENT STRUCTURE SUCH AS BUILDING, SEPTIC TANKS, AND/OR LANDMARKS AND INDICATE NOT LESS THAN TWO DISTANCES (MEASUREMENTS TO WELL)		X DRY HOLE	
		OTHER CASING (if used)					
		diameter inch depth (feet)					
		screen type or open hole					
		ST BR HO PL OT					
		STEEL BRASS BRONZE PLASTIC OTHER					
		C 2					
		DEPTH (nearest ft.)					
		H0 40 305					
		SLOT SIZE 1 2 3					
		DIAMETER OF SCREEN					
		GRAVEL PACK					
		IF WELL DRILLED WAS FLOWING WELL INSERT F IN BOX 68					
		OEP USE ONLY (NOT TO BE FILLED IN BY DRILLER)					
		T (E.R.O.S.) WQ					
		70 72 74 75 76					
		TELESCOPE CASING LOG INDICATOR OTHER DATA					
		SITE SUPERVISOR (sign. of driller or journeyman responsible for sitework if different from permittee)					

B 1 0167 SEQUENCE NO. (OEP USE ONLY) (THIS NUMBER IS TO BE PUNCHED IN COLS. 3-6 ON ALL CARDS)	STATE OF MARYLAND PERMIT TO DRILL WELL please print or type	OEP PERMIT NUMBER H0-81-0719 fill in this form completely
Date Received 080989 OWNER INFORMATION MESSERLY ROBERT 15 Last Name Owner First Name 13971 FOUR WHEEL DR 36 Street or RFD HIGHLAND 57 Town 70 State 72 Zip 76	B 3 LOCATION OF WELL HOWARD 8 COUNTY E.F. COX PROPERTY 23 SUBDIVISION SECTION 70 LOT 7C 44 46 48 50 HIGHLAND 52 NEAREST TOWN MILES FROM TOWN (enter 0 if in town) 1 MI 73 76 77 78	
DRILLER INFORMATION HOWARD DILLON Driller's Name 77 License No. 80 DILLON DRILLING COMPANY Firm Name 1514 Mt. VERNON AVE. - BALTO 21215 Address Howard Dillon Signature Date	B 4 DIRECTION OF WELL FROM TOWN (CIRCLE BOX) NEAR WHAT ROAD FOUR WHEEL DRIVE 11 30 ON WHICH SIDE OF ROAD (CIRCLE APPROPRIATE BOX) NORTH (N) WEST (W) SOUTH (S) EAST (E) DISTANCE FROM ROAD 800 34 37 ENTER FT or MI FT 38 39	
B 2 WELL INFORMATION APPROX. PUMPING RATE (GAL. PER MIN.) 5 8 12 AVERAGE DAILY QUANTITY NEEDED (GAL. PER DAY) 750 14 20 USE FOR WATER (CIRCLE APPROPRIATE BOX) ☒ HOME (SINGLE OR DOUBLE HOUSEHOLD UNIT ONLY) ☐ FARMING (LIVESTOCK WATERING & AGRICULTURAL IRRIGATION) ☐ INDUSTRIAL, COMMERCIAL, STATE AND FEDERAL GOV. OTHER (REQUIRES APPROPRIATION PERMIT) ☐ PUBLIC OR PRIVATE WATER COMPANY (REQUIRES APPROPRIATION PERMIT AND STATE HEALTH DEPARTMENT APPROVAL) ☐ TEST, OBSERVATION, MONITORING (MAY REQUIRE APPROPRIATION PERMIT)	NOT TO BE FILLED IN BY DRILLER HEALTH DEPARTMENT APPROVAL HOWARD COUNTY NAME A27904 COUNTY NO. Frank Skinn OEP SIGNATURE STATE HEALTH INSERT S 092084 DATE ISSUED CO SIGNATURE EXP. DATE 484000 NORTH GRID 50 55 0808000 EAST GRID 57 63	
APPROXIMATE DEPTH OF WELL 200 24 28 FEET	APPROXIMATE DIAMETER OF WELL 6 NEAREST INCH	
METHOD OF DRILLING (circle one) BORED (or Augered) 30- AIR-ROTary 37- CABLE other JETTED AIR-PERCussion REVERSE-ROTary Jettied & DRIVEN ROTARY (Hydraulic Rotary) Drive-POINT	SHOW MAJOR FEATURES OF BOX & LOCATE WELL WITH AN X SOURCES OF DRILLING WATER WRITE THE BOX NUMBER FROM THE MAP HERE 800 480 800 8 480 4 DRAW A SKETCH BELOW SHOWING LOCATION OF WELL IN RELATION TO NEARBY TOWNS AND ROADS AND GIVE DISTANCE FROM WELL TO NEAREST ROAD JUNCTION N 40' - casing 35' - open 11 - bags cement see location on plat 12/18/84 MD 100 Four Wheel Drive MD 216 HALLS SHOP RD will fill 3 day holes at later time	
REPLACEMENT OR DEEPEMED WELLS (CIRCLE APPROPRIATE BOX) ☒ THIS WELL WILL NOT REPLACE AN EXISTING WELL ☐ THIS WELL WILL REPLACE A WELL THAT WILL BE ABANDONED AND SEALED ☐ THIS WELL WILL REPLACE A WELL THAT WILL BE USED AS A STANDBY ☐ THIS WELL WILL DEEPMEN AN EXISTING WELL PERMIT NUMBER OF WELL TO BE REPLACED OR DEEPEMED (IF AVAILABLE) 41 67 68		
Not to be filled in by driller (OEP USE ONLY) APPROX. PERMIT NUMBER GAP 54 63 FORCE FS WRITE INITIALS IN BOX PERMIT No. H0-81-0719 67 68 70 71 72 73 74 75 76 77 78 79		
SPECIAL CONDITIONS 854-2137 OR 231-2919 HEALTH		

Page 1 of 2
Date 12/18/84FIELD DATA SHEET
HOWARD COUNTY WELL YIELD TESTWell Permit No. HO - 81-0719Location of property (road) 4 Wheel DriveSubdivision E.F. Cox PropertyLot 7-C Block — Plat — Sec. —Well Driller Howard DillonOwner Robert MesserlyDepth of well 305'Distance of measuring point (M.P.) above ground 1 1/2'Static water level (S.W.L.) below M.P. 13'

High rate pumping -- reservoir drawdown

Time pump started 8:30 A.M.Pumping rate 120Total time 60 to reach pumping water level 280 ft. below M.P.

11. Recovery pump test data - observations to be recorded every 15 minutes

TIME (in 15 minute intervals)	WATER LEVEL below M.P.	PUMPING RATE time to fill 1 gallon bucket	FLOW METER READING (if used)	CALCULATED FLOW (gallons per minute)
8:30	13'	5 sec		12
8:45	75'	5 sec		12
9:00	140'	5 sec		12
9:15	210'	5 sec		12
9:30	280'	5 sec		12
9:45	280'	60 sec		1
10:00	280'	60 sec		1
10:15	280'	60 sec		1
10:30	280'	60 sec		1
10:45	280'	60 sec		1
11:00	280'	60 sec		1
11:15	280'	60 sec		1
11:30	280'	60 sec		1
11:45	280'	60 sec		1
12:00	280'	60 sec		1
12:15	280'	60 sec		1
12:30	280'	60 sec		1
12:45	280'	60 sec		1
1:00	280'	60 sec		1
1:15	280'	60 sec		1
1:30	280'	60 sec		1
1:45	280'	60 sec		1
2:00	280'	60 sec		1
2:30	280'	60 sec		1

3:30

280'

60 sec

1

C16562SEQUENCE NO. (OEP USE ONLY)

STATE OF MARYLAND
WELL COMPLETION REPORT
FILL IN THIS FORM COMPLETELY
PLEASE PRINT OR TYPE

THIS REPORT MUST BE SUBMITTED WITHIN
45 DAYS AFTER WELL IS COMPLETED.

COUNTY
NUMBERA27904

DATE Received

DATE WELL COMPLETED
1121884

Depth of Well
145
(TO NEAREST FOOT)

PERMIT NO.
FROM "PERMIT TO DRILL WELL"
40-81-0709

OWNER
last name first name
MESSERLY ROBERT

STREET OR RFD
13971 FOUR WHEEL DR.

TOWN
HIGHLAND MD 20777

SUBDIVISION
E.F. COX PROP.

SECTION

LOT
7C

WELL LOG
Not required for driven wells

STATE THE KIND OF FORMATIONS
PENETRATED, THEIR COLOR, DEPTH,
THICKNESS AND IF WATER BEARING

DESCRIPTION (Use additional sheets if needed)

FEET
FROM TO

Check if water bearing

CLAY 0 24
MICA ROCK 24 145 X

GROUTING RECORD
WELL HAS BEEN GROUTED
(Circle Appropriate Box)
TYPE OF GROUTING MATERIAL
CEMENT CM BENTONITE CLAY BC
NO. OF BAGS 4 NO. OF POUNDS 400
GALLONS OF WATER 24
DEPTH OF GROUT SEAL (to nearest foot)
from 0 ft. to 24 ft.
(enter 0 if from surface)

CASING RECORD
casing types insert appropriate code below
ST CO
STEEL CONCRETE
PL OT
PLASTIC OTHER
MAIN CASING TYPE
Nominal diameter top (main) casing (nearest inch)
Total depth of main casing (nearest foot)
ST 6 24

OTHER CASING (if used)
diameter depth (feet)
inch from to

SCREEN RECORD
screen type or open hole insert appropriate code below
ST BR HO
STEEL BRASS OPEN HOLE
PL OT
PLASTIC OTHER
DEPTH (nearest ft.)
H0 24 145

EACH SCREEN
23 24 26 30 32 36 38 39 41 45 47 51

SLOT SIZE 1 2 3
DIAMETER OF SCREEN (NEAREST INCH)
56 60

GRAVEL PACK
IF WELL DRILLED WAS FLOWING WELL INSERT F IN BOX 68
OEP USE ONLY (NOT TO BE FILLED IN BY DRILLER)
T (E.R.O.S.) WQ
70 72 74 75 76
TELESCOPE CASING LOG INDICATOR OTHER DATA

C3
PUMPING TEST
HOURS PUMPED (nearest hour) 3
PUMPING RATE (gal. per min. to nearest gal.) 25
METHOD USED TO MEASURE PUMPING RATE AIR
WATER LEVEL (distance from land surface)
BEFORE PUMPING 20
WHEN PUMPING 125
TYPE OF PUMP USED (for test)
A air P piston T turbine
C centrifugal R rotary O other (describe below)
J jet S submersible

PUMP INSTALLED
DRILLER WILL INSTALL PUMP YES NO
IF DRILLER INSTALLS PUMP, THIS SECTION MUST BE COMPLETED FOR ALL WELLS EXCEPT HOME USE
TYPE OF PUMP INSTALLED PLACE (A,C,J,P,R,S,T,O) IN BOX - SEE ABOVE:
CAPACITY: GALLONS PER MINUTE (to nearest gallon)
PUMP HORSE POWER
PUMP COLUMN LENGTH (nearest ft.)
CASING HEIGHT (circle appropriate box and enter casing height)
+ above
- below
LAND SURFACE (nearest foot)


LOCATION OF WELL ON LOT
SHOW PERMANENT STRUCTURE SUCH AS BUILDING, SEPTIC TANKS, AND/OR LANDMARKS AND INDICATE NOT LESS THAN TWO DISTANCES (MEASUREMENTS TO WELL)
130'
170'

CIRCLE APPROPRIATE LETTER WHEN THIS WELL WAS COMPLETED
A A WELL WAS ABANDONED AND SEALED
E ELECTRIC LOG OBTAINED
P TEST WELL CONVERTED TO PRODUCTION WELL
I HEREBY CERTIFY THAT THIS WELL HAS BEEN CONSTRUCTED IN ACCORDANCE WITH COMAR 10.17.13 "WELL CONSTRUCTION" AND IN CONFORMANCE WITH ALL CONDITIONS STATED IN THE ABOVE CAPTIONED PERMIT, AND THAT THE INFORMATION PRESENTED HEREIN IS ACCURATE AND COMPLETE TO THE BEST OF MY KNOWLEDGE:
DRILLERS IDENT. NO. 209
DRILLERS SIGNATURE
(MUST MATCH SIGNATURE ON APPLICATION)
SITE SUPERVISOR (sign. of driller or journeyman responsible for sitework if different from permittee)


B 1 9115	SEQUENCE NO. (OEP USE ONLY) THIS NUMBER IS TO BE PUNCHED IN C.O.S. 3-6 ON ALL CARDS	STATE OF MARYLAND PERMIT TO DRILL WELL please print or type	OEP PERMIT NUMBER 40-81-0709
Date Received 810885		B 3 LOCATION OF WELL HOWARD	
OWNER INFORMATION MESSERLY ROBERT		E. F. COX PROPERTY	
13771 FOUR WHEEL DR.		HIGHLAND	
HIGHLAND		MD 20777	
DRILLER INFORMATION HOWARD DILLON		209	
DILLON DRILLING		6514 W. VERNON AVE. BALTO 21215	
Howard Dillon		12-28-84	
B 2 WELL INFORMATION APPROX. PUMPING RATE (GAL. PER MIN.) 5		B 4 DIRECTION OF WELL FROM TOWN (CIRCLE BOX) 	
AVERAGE DAILY QUANTITY NEEDED (GAL. PER DAY) 750		FOUR WHEEL DRIVE	
USE FOR WATER (CIRCLE APPROPRIATE BOX) ☒ HOME (SINGLE OR DOUBLE HOUSEHOLD UNIT ONLY) ☐ FARMING (LIVESTOCK WATERING & AGRICULTURAL IRRIGATION) ☐ INDUSTRIAL, COMMERCIAL, STATE AND FEDERAL GOV. OTHER (REQUIRES APPROPRIATION PERMIT) ☐ PUBLIC OR PRIVATE WATER COMPANY (REQUIRES APPROPRIATION PERMIT AND STATE HEALTH DEPARTMENT APPROVAL) ☐ TEST, OBSERVATION, MONITORING (MAY REQUIRE APPROPRIATION PERMIT)		ON WHICH SIDE OF ROAD (CIRCLE APPROPRIATE BOX) 	
APPROXIMATE DEPTH OF WELL 200 FEET		NOT TO BE FILLED IN BY DRILLER HEALTH DEPARTMENT APPROVAL HOWARD	
APPROXIMATE DIAMETER OF WELL 6 INCH		A27904	
METHOD OF DRILLING (circle one) BORED (or Augered) ☒ JETTED ☐ Jetted & DRIVEN ☐ AIR-ROTARY ☐ AIR-PERCUSSION ☒ ROTARY (Hydraulic Rotary) ☐ CABLE ☐ REVERSE-ROTARY ☐ DRIVE-POINT ☐ other _____		DATE ISSUED 010985 CO SIGNATURE C. Williams 7/9/85 NORTH GRID 484000 EAST GRID 0808000	
REPLACEMENT OR DEEPEMED WELLS (CIRCLE APPROPRIATE BOX) ☐ THIS WELL WILL NOT REPLACE AN EXISTING WELL ☐ THIS WELL WILL REPLACE A WELL THAT WILL BE ABANDONED AND SEALED ☒ THIS WELL WILL REPLACE A WELL THAT WILL BE USED AS A STANDBY ☐ THIS WELL WILL DEEPEMED AN EXISTING WELL		SHOW MAJOR FEATURES OF BOX & LOCATE WELL WITH AN X SOURCES OF DRILLING WATER 1. _____ 2. _____ 3. _____ WRITE THE BOX NUMBER FROM THE MAP HERE 804	
PERMIT NUMBER OF WELL TO BE REPLACED OR DEEPEMED (IF AVAILABLE) _____		DRAW A SKETCH BELOW SHOWING LOCATION OF WELL IN RELATION TO NEARBY TOWNS AND ROADS AND GIVE DISTANCE FROM WELL TO NEAREST ROAD JUNCTION 	
Not to be filled in by driller (OEP USE ONLY) APPROP. PERMIT NUMBER _____			
FORCE 3W WRITE INITIALS IN BOX PERMIT No. 40-81-0709			
SPECIAL CONDITIONS			

854-2937 or 231-2919

HEALTH

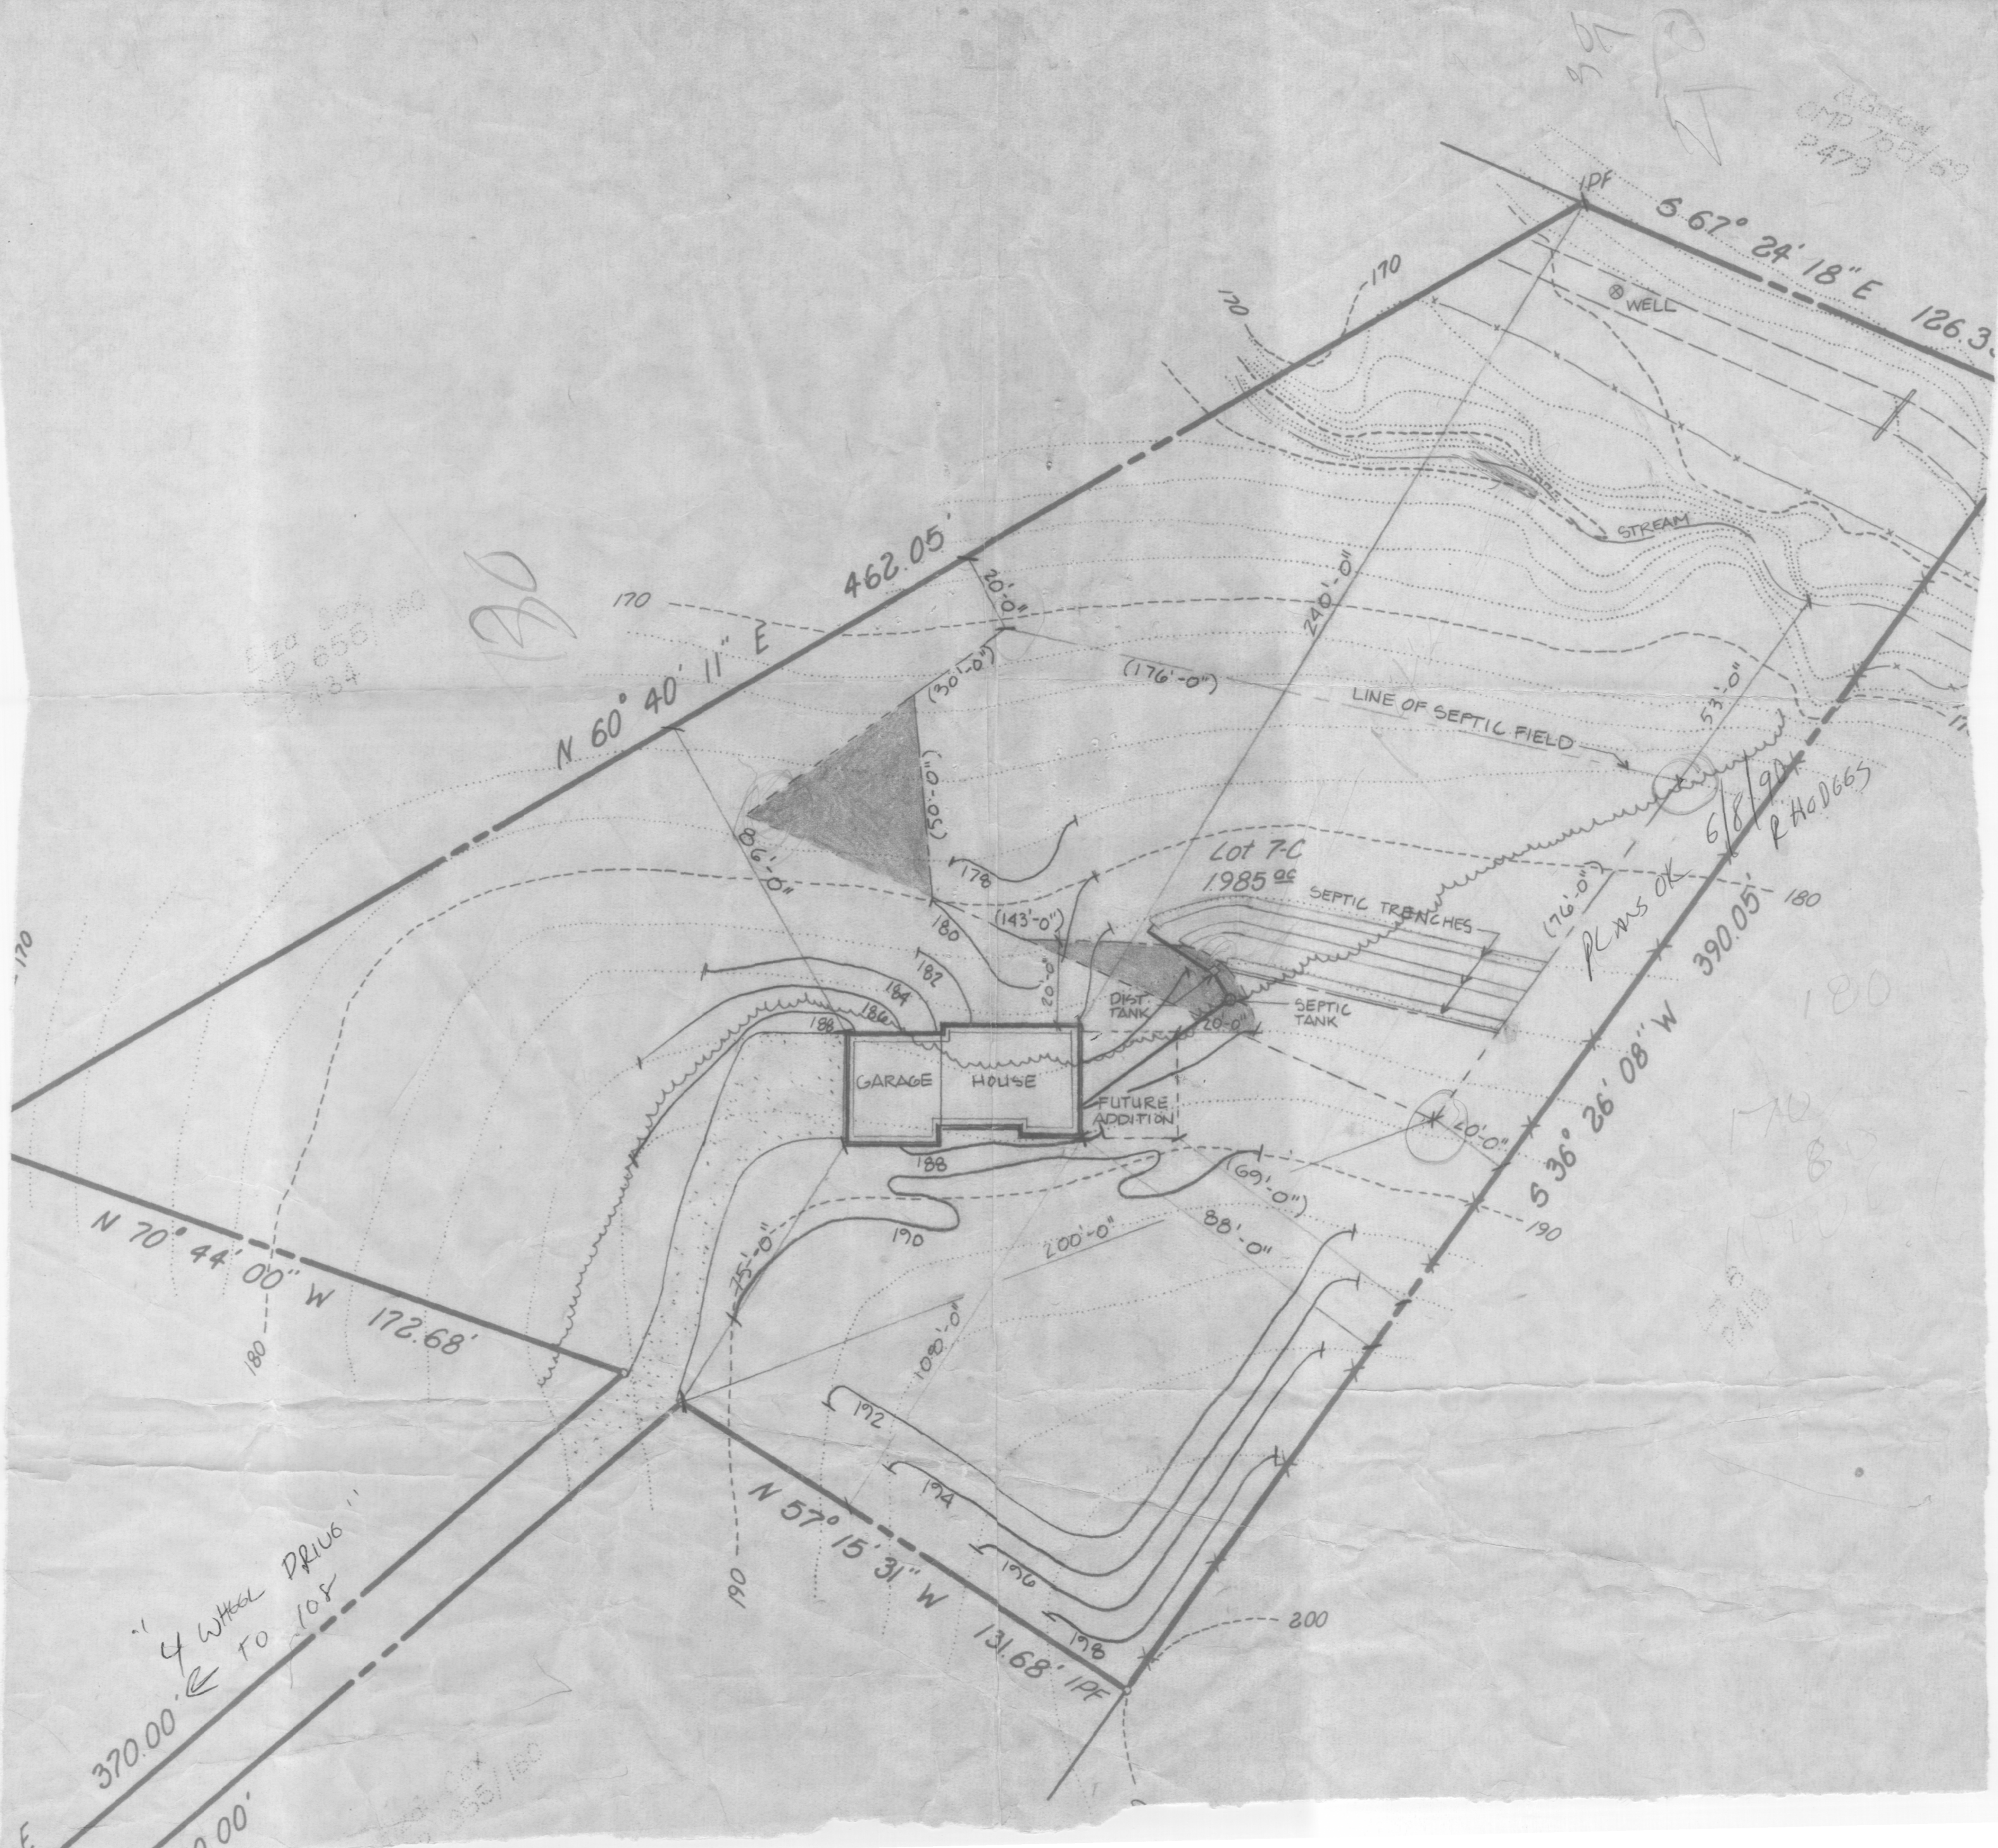

P. 479

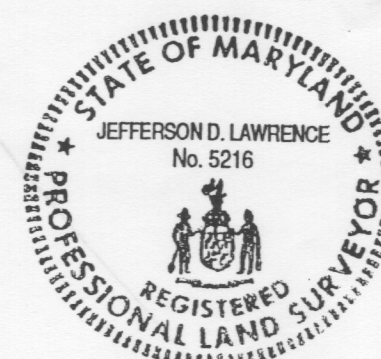

Not in flood plain per existing re
unless otherwise noted.


I hereby certify to the best of my knowledge & belief that the property delineated hereon is in accordance with the Plat of Subdivision and/or deed of record, that the improvements were located by accepted field practices and include permanent visible structures and encroachments, if any. This Plat is not for determining property lines, but prepared for exclusive use of present owners of property and also those who purchase, mortgage, or guarantee the title thereto, within six months from date hereof, and as to them I warrant the accuracy of this Plat. C. J. No title report furnished.

Professional Land Surveyor No. 5216

17904 GEORGIA AVE. #102
OLNEY, MARYLAND 20832
301-924-4570

DATE 13 AUG. '91	WALL CH 13 AUG.
DRAWN BY LSM	FINAL
CHECKED JDL	RECERT
SCALE 1" = 50'	PROJECT NO. 21-14

Robert + Carol Messerly
13955 Clarksville Pike
Highland MD 20777
301-854-0543

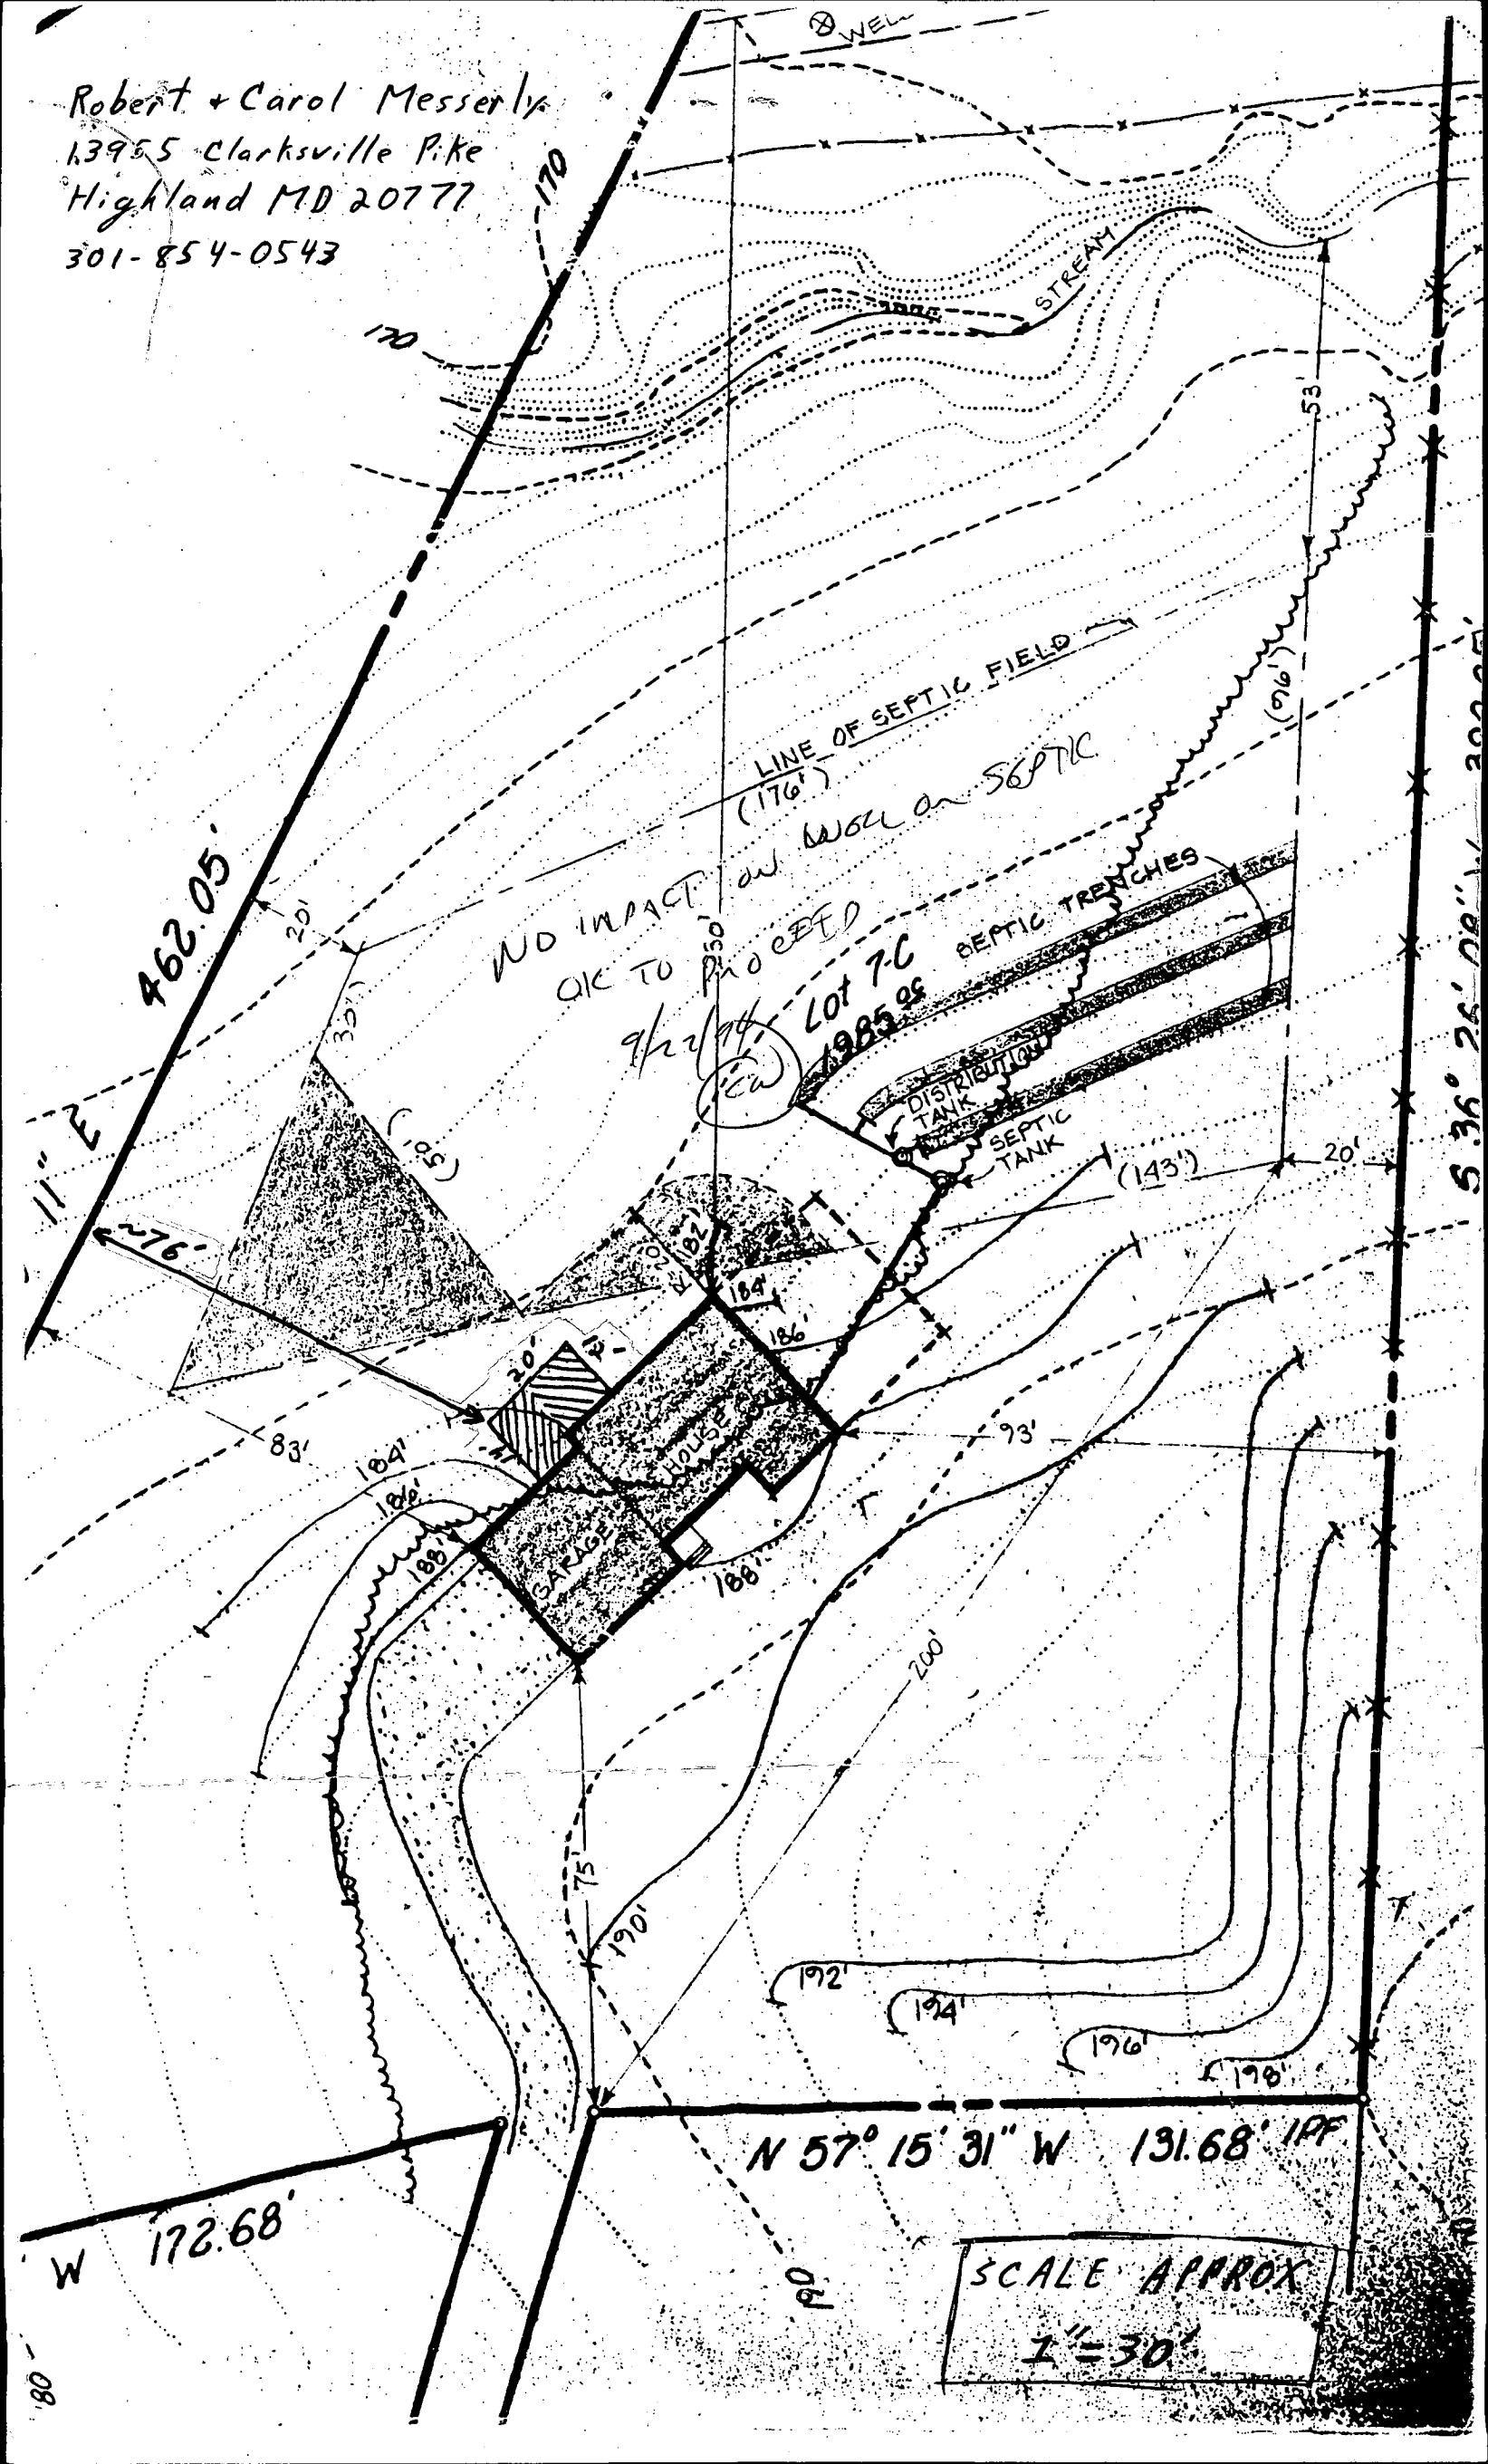

7 Dec 68

Well into
consideration + lots
on a slab
7. Top of
no. between 100
8.



Approved: Private Water and Private Sewer

SCALE: 1 IN. = 200 FT. JULY 7, 1973
Revision Note: Plot revised to show
computed Lots 7A, 7B, 7C April 3, 1974

