

PERMIT

SEWAGE DISPOSAL SYSTEM

DEPARTMENT OF HEALTH AND MENTAL HYGIENE

03-281564

HOWARD COUNTY HEALTH DEPARTMENT

BUREAU OF ENVIRONMENTAL HEALTH

313-2640

INDEXED

File
Note: Not logged in well log.
No well log number.
9/23 C.R.
P 49607
A 28107

DISTRICT 3rd

DATE 9/10/93

DATE SYSTEM APPROVED 9/22/93

INSPECTOR C.R.

Fogle's Septic Clean, Inc.

IS PERMITTED TO INSTALL ☒ ALTER

ADDRESS 558 Obrecht Road, Sykesville, Maryland 21784 PHONE 795-5670

SUBDIVISION Roy Patterson LOT 3 ROAD 479 Gaither Road

PROPERTY OWNER William J. Long

ADDRESS

SEPTIC TANK CAPACITY 1000 GALLONS

NUMBER OF BEDROOMS 3

180 SQUARE FEET PER BEDROOM

LINEAR FEET OF TRENCH REQUIRED 135

TRENCHES - Trench to be 2 feet wide. Inlet 3 feet below original grade. Bottom maximum depth 7 feet below original grade. Effective area begins at 3 feet below original grade. 4 feet of stone below distribution pipe.

LOCATION - Trenches to start at a point 100 feet straight back from existing water well with a distribution box; Run trenches out both sides of distribution box, initially; Run trenches on the contour of the land surface.

NOTES - No trench to exceed 100 feet in length. Provide 6" - 8" diameter cleanout and and cap to grade or above on septic tank. OK 6/24/93 JH

PLANS APPROVED BY C. B. Streaker

REVISED DATE 2/03/93

COVER NO WORK UNTIL INSPECTED AND APPROVED

NEITHER THE HOWARD COUNTY COUNCIL NOR THE HEALTH DEPARTMENT IS RESPONSIBLE FOR THE SUCCESSFUL OPERATION OF ANY SYSTEM

NOTE: CLEANOUT REQUIRED EVERY 70 FEET OF SEWER LINE AND/OR AT 90° SWEEPS IN LINES FROM HOUSE TO DRAIN FIELDS, 90° ELBOWS NOT ACCEPTABLE.

NOTE: ALL PARTS OF SEPTIC SYSTEMS (I.E. TANK, DISTRIBUTION BOX TRENCHES) TO BE 100 FEET FROM WELL (UNLESS OTHERWISE SPECIFICALLY AUTHORIZED)

NOTE: IF DEEP TRENCH(ES) ARE USED CALL FOR INSPECTION BEFORE AND AFTER PLACING GRAVEL IN TRENCH(ES)

NOTE: NO DRY WELL SHALL EXCEED 15 FOOT IN DIAMETER NO ABSORPTION TRENCH TO EXCEED 100 FEET IN LENGTH

NOTE: ALL PIPE FROM HOUSE TO SEPTIC TANK MUST BE CAST IRON OR SCHEDULE 35/40 PVC OR ABS

PERMIT VOID AFTER TWO YEARS

NOTE: INSTALL STAND PIPE ON SEPTIC TANK AND DRY WELL STAND PIPES MUST BE 6 INCHES IN DIAMETER CAST IRON. CONCRETE OR TERRA COTTA OR PVA OR ABS ACCEPTED. IF TOP OF SEPTIC TANK IS DEEPER THAN 3 FEET. MANHOLE TO GRADE REQUIRED.

NOTE: DISTRIBUTION BOXES MUST HAVE BAFFLES

*INSTALLER IS RESPONSIBLE FOR OBTAINING FINAL APPROVAL ON THIS PERMIT

Retest

APPLICATION

A 28107

P _____

SEWAGE DISPOSAL TESTING

STATE OF MARYLAND - DEPARTMENT OF HEALTH AND MENTAL HYGIENE

HOWARD COUNTY HEALTH DEPARTMENT
ENVIRONMENTAL HEALTH SERVICES

P. O. BOX 476, ELLICOTT CITY, MARYLAND 21043
TELEPHONE: 465-5000, EXT. 356

Septic Tank { 1-3 Bedrooms 1000 gallons
DISTRICT 3rd 1250 gallons
DATE 5/29/98
4 Bedrooms 240+

Revised
(?) on
Trenches
5'

May use wells
Dry well to have 10' effective
absorbent sidewall area per bedroom below
inlet. Inlet to be 4' below original grade
and maximum depth 9' location 19' from
left front property corner and 24' off left property
line when facing lot from Gaither Road.
or dry well and trench

TO: THE COUNTY HEALTH OFFICER
ELLICOTT CITY, MARYLAND

I, HEREBY, APPLY FOR THE NECESSARY TEST IN ORDER TO CONSTRUCT (OR RECONSTRUCT) A SEWAGE
DISPOSAL SYSTEM.

PROPERTY OWNER Contract Purchaser - Roy Patterson
used - need: (1) 5' earth
[Per hole (5 1/2')] buffers between
dry well & trench
(2) 2 inspections
of trench before
water wells

ADDRESS 8319-B Mindale Circle, Baltimore, Md. 21207 PHONE 922-3745 and after

PROPERTY LOCATION:

(3) stone in.
Run trench
3 on contour

SUBDIVISION _____ LOT NO. _____

ROAD AND DESCRIPTION Gaither Road

SIZE OF LOT 5 acres TYPE BLDG. 3 or 4 bedrooms
NUMBER OF BEDROOMS

IF NOT SINGLE RESIDENCE DESCRIBE _____

THE SYSTEM INSTALLED UNDER THIS APPLICATION IS ACCEPTABLE ONLY UNTIL PUBLIC
FACILITIES BECOME AVAILABLE.

SIGNATURE OF APPLICANT /s/ Diana E. Campe

APPROVED BY C. B. [Signature] FOR Dry Well & Trench DATE 4/23/79
(KIND OF SYSTEM)

REJECTED BY _____ FOR _____ DATE _____
(KIND OF SYSTEM)

HOLD PENDING FURTHER TESTS _____ DATE _____

REASONS FOR REJECTION OR HOLDING 6/28/78 See original test sheets

7/23/78
send
four letters

7/12/78 Mr. Costello in field - note stated
at Highland Park
Mr. Skinner engineer had not certified holes
had just cleared line and found some old holes on other
lots. Hold for submittal.

THIS IS NOT A PERMIT

7/19/78 send
platt
in per
Mr. Costello at office

1/20/93 (TENT)

APPLICATION

PERCOLATION TESTING

A 27743

P _____

HOWARD COUNTY HEALTH DEPARTMENT

BUREAU OF ENVIRONMENTAL HEALTH

3525-H ELLICOTT MILLS DRIVE/ELLICOTT CITY, MARYLAND 21043
TELEPHONE: 313-2640

RE-TEST TO ESTABLISH

NEW SEPTIC AREA

DISTRICT _____

NOT IN CONFLICT

WITH WELL LOCATION.

DATE _____

TO: THE COUNTY HEALTH OFFICER
ELLICOTT CITY, MARYLAND

(OK TO ACCEPT REPAIR TEST FEE
RATHER THAN STANDARD TEST FEE,
APPLICANT IS NOT WHOLLY RESPONSIBLE FOR LOCATION
CONFLICT (W))

I HEREBY APPLY FOR THE NECESSARY TEST PRIOR TO APPLICATION FOR PERMIT TO CONSTRUCT (OR RECONSTRUCT) A SEWAGE DISPOSAL SYSTEM.

PROPERTY OWNER JAMES BAKER

ADDRESS _____ PHONE _____

AGENT OR PROSPECTIVE BUYER _____

ADDRESS _____ PHONE _____

PROPERTY LOCATION:

SUBDIVISION ROY PATTERSON PROPERTY LOT NO. 3

ROAD AND DESCRIPTION _____

GAITHER RD.

TAX MAP _____ PARCEL # _____

SIZE OF LOT _____ TYPE BLDG. _____
(SINGLE FAMILY DWELLING OR COMMERCIAL)

THE SYSTEM INSTALLED UNDER THIS APPLICATION IS ACCEPTABLE ONLY UNTIL PUBLIC FACILITIES BECOME AVAILABLE. I FULLY UNDERSTAND THE

FEE CONNECTED WITH THE FILING OF THIS PERC TEST APPLICATION IS NON-REFUNDABLE UNDER ANY CIRCUMSTANCES. I ALSO AGREE TO

COMPLY WITH ALL M.O.S.H.A. REQUIREMENTS IN TESTING THIS LOT.

"Plot submitted" Brida Sparks (SIGNATURE OF APPLICANT)

APPROVED BY Charles Bryan Wheat FOR Shallow system DATE 1/25/93

DISAPPROVED BY _____ FOR _____ DATE _____

HOLD PENDING FURTHER TESTS _____

REASONS FOR REJECTION OR HOLDING _____

PERCOLATION TEST PLAT/PRELIMINARY PLAT - TITLE OR I.D. # Hand delivered by Mr. Baker DATE 1/25/93

SITE DEVELOPMENT PLAN/FINAL PLAT - TITLE OR I.D. # _____ DATE _____

THIS IS NOT A PERMIT

Continued
A 27743
COUNTY #


SOIL PROFILE

0' #12
0' to 3 1/2'
Clay
3 1/2' to 8 1/2'
Sandy
Loam

New Home

#(11)

0' to 4' ± <u>Clay</u>
4' to 9' <u>Sandy</u> Loam

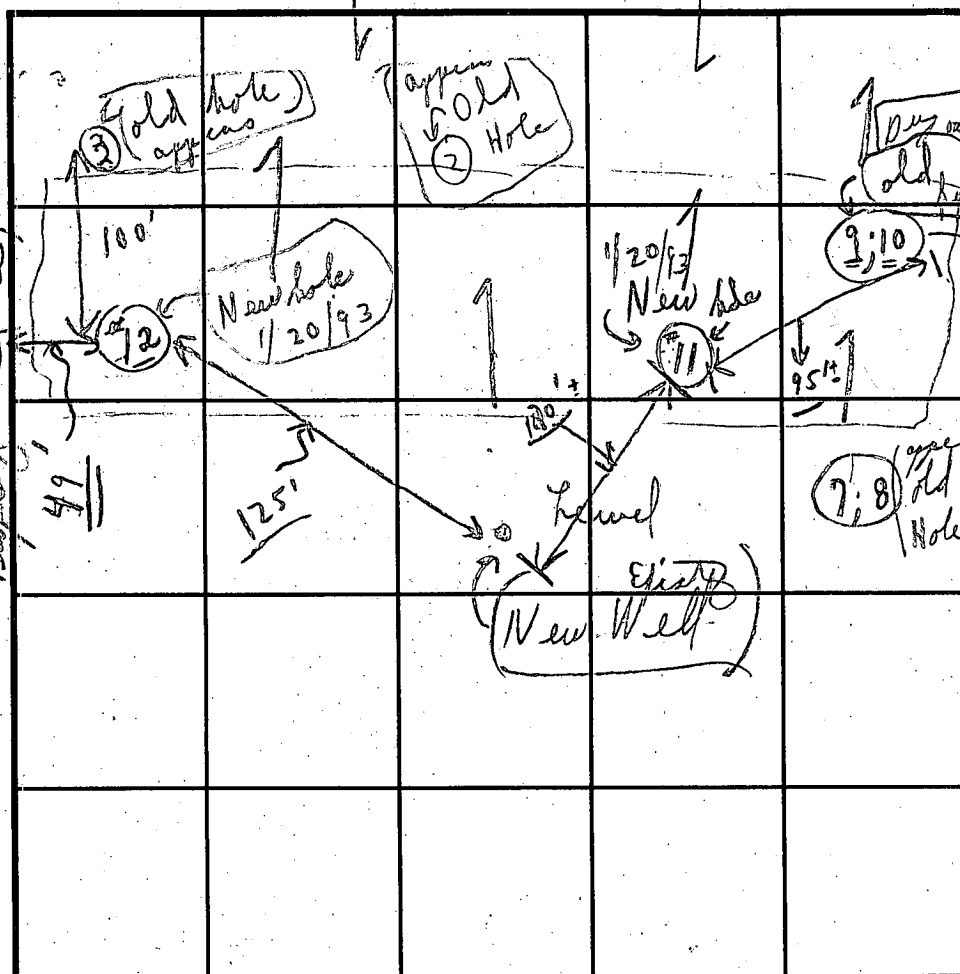

SOIL PROFILE

Old
 9, 10
 (Low hole)
 → 0' 6 2'
 clay
 2' ±
 Loam
 12 1/2'
 Bottom
 Dry

INDICATE NORTH - NAME ADJOINING ROADWAY AS BASE LINE.

GAITHER ROAD

DATE	TEST NO.	DEPTH	PRE-WET		TEST - 1" DROP		TIME
			START	STOP	START	STOP	
1/20/93	* ⑪	4'	10:39	10:43	10:43	10:51	8 min
Wed		9'			(Sandy Loam)		below
	⑫	3 1/2'	11:13	11:18	11:18	11:31	13 min
		8 1/2'		Sandy Loam			below shell
	⑬	2 ±'	:	:	:	:	
Low	⑭ 9, 10	12 1/2'	12 1/2'	(Visual sandy loam)			
		1'	:				
		1					
	1/20	(Start trench - 100' straight)					Note: back from this point - back on

REMARKS

TYPE OF SOIL

TESTED BY

TRENCH DESIGN DATA: AVERAGE PERCOLATION TIME

INLET DEPTH

MAXIMUM BOTTOM DEPTH

ALSO PRESENT

TRENCH WIDTH

SQ. FT./BEDROOM

4/20/93 Tests in Woods & Brush
located bottom old hole

Paul - Backo
(House) King's

7 sent
with
80%
85%
was from
W.D.
Wall

APPLICATION

A 27743

P _____

SEWAGE DISPOSAL TESTING

STATE OF MARYLAND - DEPARTMENT OF HEALTH AND MENTAL HYGIENE

HOWARD COUNTY HEALTH DEPARTMENT
ENVIRONMENTAL HEALTH SERVICESP. O. BOX 476, ELLICOTT CITY, MARYLAND 21043
TELEPHONE: 465-5000, EXT. 356DISTRICT 3DATE 3/31/78TO: THE COUNTY HEALTH OFFICER
ELLICOTT CITY, MARYLAND*Office*
997-8100

I, HEREBY, APPLY FOR THE NECESSARY TEST IN ORDER TO CONSTRUCT (OR RECONSTRUCT) A SEWAGE DISPOSAL SYSTEM.

PROPERTY OWNER Roy Patterson
Kazimieras M. Campe and Diana E. CampeADDRESS 6701 Pine Dr., Columbia, Md. 21046 PHONE 546-5023PROPERTY LOCATION: 8319-B Mindale Circle 922-3745
Balto., Md. 21207SUBDIVISION None LOT NO. 3ROAD AND DESCRIPTION Gaither Rd.SIZE OF LOT 5 Acres TYPE BLDG. 3 or 4
NUMBER OF BEDROOMS

IF NOT SINGLE RESIDENCE DESCRIBE _____

THE SYSTEM INSTALLED UNDER THIS APPLICATION IS ACCEPTABLE ONLY UNTIL PUBLIC FACILITIES BECOME AVAILABLE.

SIGNATURE OF APPLICANT Diana E. CampeAPPROVED BY _____ FOR _____ DATE _____
(KIND OF SYSTEM)REJECTED BY _____ FOR _____ DATE _____
(KIND OF SYSTEM)

HOLD PENDING FURTHER TESTS _____ DATE _____

REASONS FOR REJECTION OR HOLDING 4/13/78 - PERC OKHOLD FOR PLAT RH**THIS IS NOT A PERMIT**

2:30-11:00 Met Realtor
~~tentative~~ 10/1/91

SITE INSPECTION SHEET

OWNER: Baker
ADDRESS: Roy Patterson Prop Lot 3
Gaither Rd

DATE REQUESTED: _____


DRILLER: _____

WELL TAG # _____

COUNTY # _____

PROPOSAL: _____

LOCATION DIAGRAM

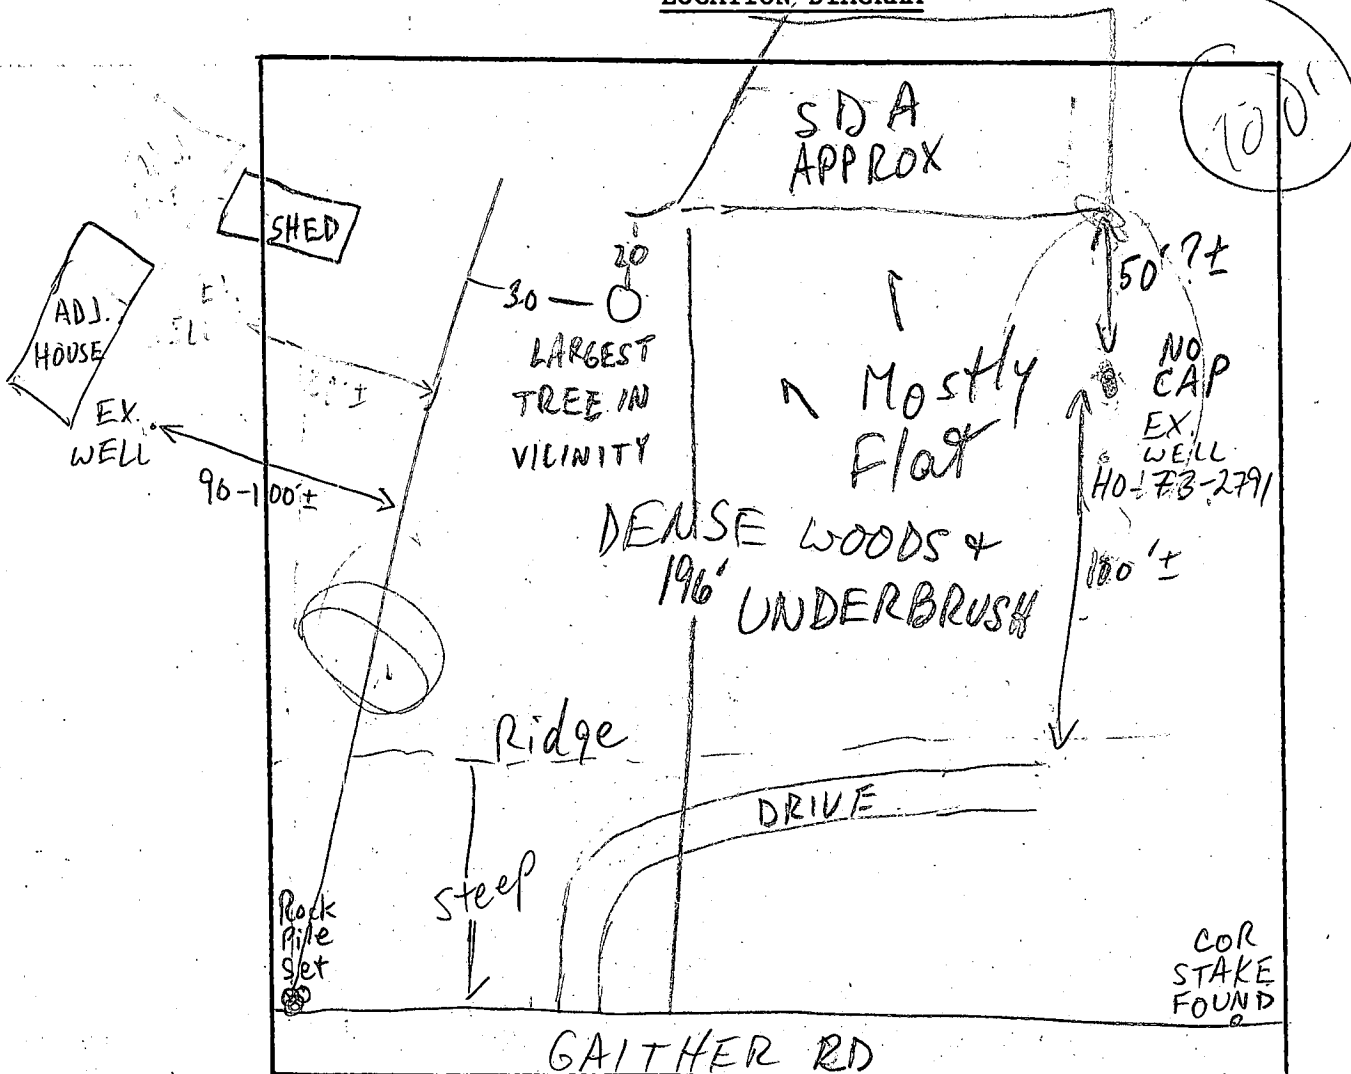

COMMENTS: 10/1/91 Met Realtor, measurements difficult, but they indicate well is in unsuitable location; well location is probably no more than 50' from right front edge of SDA; well elev. OK? (difficult to determine); need site survey and poss.

DATE: 10/1/91


INSPECTOR: M. Rifkin

re-perc or new well;
realtor to investigate MR

SITE INSPECTION SHEET

POT. BUYER:
 OWNER: JAMES BAKER DATE REQUESTED: 7/24/91
 PHONE #: _____ CONTRACTOR: _____
 ADDRESS: 13961 HALLOWELL CT. WELL TAG #: _____
DAYTON COUNTY #: _____
 PROPOSAL: ✓ REACTOR REQUESTS LETTER: "WELL & PERC APPROVED."
INSPECT SITE AND CONFIRM / REVISE SEPTIC SPECS
IF SOME PROBLEM - NOTIFY APPLICANT OF HOW TO RESOLVE, C.B.

LOCATION DIAGRAM

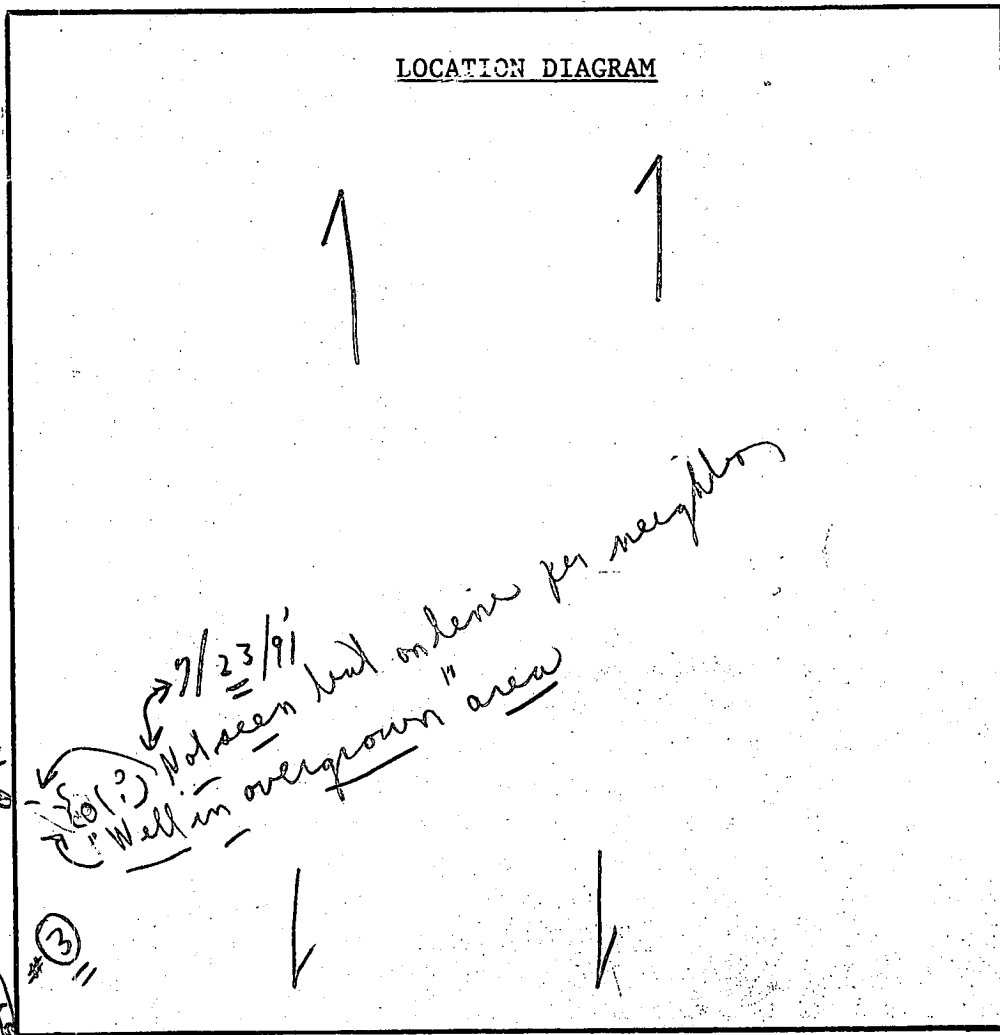

COMMENTS: 7/23/91 P.M. Lot - overgrown - Keep trenches
100' + from existing water wells on LOT #3
and Lot #2. ← Only change in septic specs
with a recommendation of Vicinal holes on septic
 DATE: 7/24/91 ← late INSPECTOR: C.B. ✓ Test
system before building permit - released.
[Tentative - Water Well & Perc Approved] C.B.

STATE OF MARYLAND WATER RESOURCES ADMINISTRATION TAWES STATE OFFICE BLDG., ANNAPOLIS, MARYLAND 21401 APPLICATION FOR PERMIT TO DRILL WELL		WRA PERMIT NUMBER <i>HD-73-2791</i> FILL IN THIS FORM COMPLETELY
B 1 3269 SEQUENCE NO. (WRA USE ONLY) 1 2 3 (SEQ. NO.) 6 (THIS NUMBER IS TO BE PUNCHED IN COLS. 3-6 ON ALL CARDS)		
DATE RECEIVED (WRA USE ONLY) <i>7/27/78</i> <i>9:30 A.M.</i> <i>5:30 P.M.</i> OWNER COL 15 LAST NAME <i>Patterson</i> FIRST NAME <i>Ray</i> COL. 34 STREET OR RFD COL 36 <i>9312 B. ...</i> COL. 55 POST OFFICE COL 57 <i>Baltimore, Md 21207</i> COL. 76		
B 1 CONTINUED DRILLER INFORMATION 1 2 3 (SEQ. NO.) 6 DATE <i>7/27/78</i> LICENSE NUMBER <i>42</i> <i>F. Enterday</i> FIRST NAME <i>F. Enterday</i> DRILLER <i>F. Enterday</i> LAST NAME SIGNATURE <i>[Signature]</i>		B 3 LOCATION OF WELL 1 2 3 (SEQ. NO.) 6 COUNTY <i>Howard</i> (DO NOT ABBREVIATE COUNTY NAME) 21 SUBDIVISION 23 42 SECTION 44 48 LOT 48 50 NEAREST TOWN <i>Lehmanville</i> 52 71 MILES FROM TOWN (ENTER 0 IF IN TOWN) <i>2</i> 79 76 77 78
B 2 WELL INFORMATION 1 2 3 (SEQ. NO.) 6 MAXIMUM PUMPING RATE (GALLONS PER MINUTE) 8 12 AVERAGE DAILY QUANTITY NEEDED (GALLONS PER DAY) <i>1000</i> 14 20 USE FOR WATER (CIRCLE APPROPRIATE BOX) ☒ D HOME (SINGLE OR DOUBLE HOUSEHOLD UNIT ONLY) ☐ F FARMING, AGRICULTURE, IRRIGATION ☐ I INDUSTRIAL, COMMERCIAL, STATE AND FEDERAL GOVERNMENT. ☐ M MUNICIPAL WATER SUPPLY ☐ P PRIVATE WATER COMPANY ☐ T TEST MUST HAVE STATE HEALTH DEPT. APPROVAL		B 4 DIRECTION FROM TOWN (CIRCLE APPROPRIATE BOX) 1 2 3 (SEQ. NO.) 6 ☒ N NORTH ☐ E EAST ☐ NE NORTHEAST ☐ SE SOUTHEAST ☐ S SOUTH ☐ W WEST ☐ NW NORTHWEST ☐ SW SOUTHWEST NEAR WHAT ROAD <i>Lehmanville Rd.</i> ON WHICH SIDE OF ROAD (CIRCLE APPROPRIATE BOX) ☒ N NORTH ☐ S SOUTH ☐ E EAST ☐ W WEST DISTANCE FROM ROAD (ENTER DISTANCE AND CIRCLE APPROPRIATE BOX) <i>200</i> 34 37 38 39
APPROXIMATE DEPTH OF WELL <i>150</i> 24 28 FEET APPROXIMATE DIAMETER OF WELL <i>6</i> (NEAREST INCH) METHOD OF DRILLING USED (CIRCLE APPROPRIATE METHOD) ☒ BORED (OR AUGERED) ☐ JETTED ☐ DRIVEN 30-37 ☒ AIR-ROTARY ☐ AIR-PERCUSSION ☐ ROTARY (HYDRAULIC ROTARY) ☐ CABLE ☐ REVERSE-ROTARY ☐ DRIVE-POINT OTHER (DESCRIBE)		27 July 78 - Cancellation - Truck could not get up hill. (GLK) Bridge <i>26 ft casing</i> <i>(solid) Rock 24 ft open</i> Truck could not go up 2 ft above grade hill. Front loader did not arrive until 3:15. Grouting began at 3:45. <i>Disagreement</i> (GLK) 28 July 78
REPLACEMENT OR DEEPEMED WELLS (CIRCLE APPROPRIATE BOX) ☐ N THIS WELL WILL NOT REPLACE AN EXISTING WELL ☐ Y THIS WELL WILL REPLACE A WELL THAT WILL BE ABANDONED AND SEALED ☐ S THIS WELL WILL REPLACE A WELL THAT WILL BE USED AS A STANDBY ☐ D THIS WELL WILL DEEPM AN EXISTING WELL PERMIT NUMBER OF WELL TO BE REPLACED OR DEEPEMED (IF AVAILABLE)		
NOT TO BE FILLED IN BY DRILLER (WRA USE ONLY) APPROPRIATION PERMIT NUMBER <i>54</i> ENGINEER REVIEW DISTRICT NO. <i>63</i> FORCE <i>67</i> WRITE INITIALS IN BOX <i>68</i> CONDITIONS <i>70 71 72 73 74 75 76 77 78 79</i>		
B 4 CONTINUED HEALTH DEPARTMENT APPROVAL 1 2 3 (SEQ. NO.) 6 STATE HEALTH (CIRCLE BOX) <i>Howard</i> COUNTY NAME <i>Howard</i> COUNTY NO. <i>W28045</i> DATE <i>051578</i> APPROVED BY <i>Donald W. Monaghan, Sanitarian</i> SPECIAL CONDITIONS 8-63 (WRA USE ONLY)		

C 1	0485	SEQUENCE NO. (WRA USE ONLY)	STATE OF MARYLAND WATER RESOURCES ADMINISTRATION TAWES STATE OFFICE BLDG., ANNAPOLIS, MD. 21401 WELL COMPLETION REPORT		THIS REPORT MUST BE SUBMITTED WI IN 30 DAYS AFTER WELL COMPLET FILL IN THIS FORM COMPLETELY COUNTY NUMBER
1 2 3 (SEQ. NO.) 6 (THIS NUMBER IS TO BE PUNCHED IN COLS. 3-6 ON ALL CARDS)		DATE RECEIVED (WRA USE ONLY)		DEPTH OF WELL 200 22 (TO NEAREST FOOT) 26	PERMIT NO. FROM "PERMIT TO DRILL WELL" MD-73-2791 28 29 30 31 32 33 34 35 36 37
DATE WELL COMPLETED 7/13/78 15 20		DRILLERS IDENTIFICATION NO. 42			
OWNER LAST NAME PATTERTSON ROY			FIRST NAME BALTIMORE, MD. 21207		
STREET OR RFD 8319-B MINDALE PIKE			POST OFFICE		
WELL DESCRIPTION					
WELL LOG					
STATE THE KIND OF FORMATIONS PENETRATED, THEIR COLOR, DEPTH, THICKNESS AND IF WATER BEARING					
DESCRIPTION (USE ADDITIONAL SHEETS IF NECESSARY)	FEET FROM TO		CHECK IF WATER BEARING		
Top Soil Shale GRANITE 200 100 30 20 10	0 2 2 30 30 40				
GROUTING RECORD					
WELL HAS BEEN GROUTED (CIRCLE APPROPRIATE BOX) YES ☒ NO ☐					
TYPE OF GROUTING MATERIAL (CIRCLE BOX) CEMENT ☒ BENTONITE CLAY ☐					
NO. OF BAGS 7 NO. OF POUNDS 100					
GALLONS OF WATER 35					
DEPTH OF GROUT SEAL (TO NEAREST FOOT) FROM 0 FT. TO 24 FT. (ENTER 0 IF FROM SURFACE)					
CASING RECORD					
CASING TYPES (INSERT APPROPRIATE CODE BELOW) STEEL ☐ CONCRETE ☐ PLASTIC ☐ OTHER ☐					
MAIN CASING TYPE 57 6 26 60 61 63 64 66 70					
NOMINAL DIAMETER TOP (MAIN) CASING (NEAREST INCH) 6					
TOTAL DEPTH OF MAIN CASING (NEAREST FOOT) 26					
OTHER CASING (IF USED)					
DIAMETER (INCH) DEPTH (FEET) FROM TO					
SCREEN RECORD					
SCREEN TYPE OR OPEN HOLE (INSERT APPROPRIATE CODE BELOW) STEEL ☐ BRASS OR BRONZE ☐ OPEN HOLE ☐ PLASTIC ☐ OTHER ☐					
C 2 (SEQ. NO.) 6					
DEPTH (NEAREST WHOLE FOOT) FROM 24 TO 200 8 9 11 15 17 21					
EACH SCREEN 23 24 26 30 32 36 38 39 41 45 47 51					
SLOT SIZE 1, 2, 3					
DIAMETER OF SCREEN 56 60 (NEAREST INCH) FROM TO					
GRAVEL PACK					
IF WELL DRILLED WAS A FLOWING WELL CIRCLE BOX 68 F					
WRA USE ONLY (NOT TO BE FILLED IN BY DRILLER) (E.R.O.S.) TELESCOPE CASING 70 LOG INDICATOR 72 OTHER DATA AVAILABLE 74 75 76					
PUMPING TEST					
HOURS PUMPED (TO NEAREST HOUR) 3					
PUMPING RATE (GALLONS PER MINUTE TO NEAREST GALLON) 2					
METHOD USED TO MEASURE PUMPING RATE Duckett					
WATER LEVEL: (DISTANCE FROM LAND SURFACE) BEFORE PUMPING 30 (NEAREST FOOT) WHEN PUMPING 200 (NEAREST FOOT)					
TYPE OF PUMPED USED (CIRCLE APPROPRIATE BOX) (FOR PUMPING TEST) AIR ☒ PISTON ☐ TURBINE ☐ CENTRIFUGAL ☐ ROTARY ☐ OTHER (DESCRIBE BELOW) ☐ JET ☐ SUBMERSIBLE ☐					
PUMP INSTALLED					
TYPE OF PUMP (WRITE APPROPRIATE LETTER IN BOX - SEE ABOVE: A, C, J, P, R, S, T, O)					
DRILLER WILL INSTALL PUMP (CIRCLE APPROPRIATE BOX) YES ☐ NO ☐					
CAPACITY: GALLONS PER MINUTE (TO NEAREST GALLON) 31 35					
PUMP HORSE POWER 37 41					
PUMP COLUMN LENGTH (NEAREST FOOT) 43 47					
CASING HEIGHT (CIRCLE APPROPRIATE BOX AND ENTER CASING HEIGHT)					
ABOVE ☒ BELOW ☐ LAND SURFACE (NEAREST FOOT) 49 50 51					
LOCATION OF WELL ON LOT					
SHOW PERMANENT STRUCTURE SUCH AS BUILDINGS, SEPTIC TANKS, AND/OR OTHER LAND MARKS AND INDICATE NOT LESS THAN TWO DISTANCES (MEASUREMENTS TO WELL).					
CIRCLE APPROPRIATE BOXES: A A WELL WAS ABANDONED AND SEALED WHEN THIS WELL WAS COMPLETED E ELECTRIC LOG OBTAINED P TEST WELL CONVERTED TO PRODUCTION WELL					
I HEREBY CERTIFY THAT I HAVE COMPLIED WITH ALL CONDITIONS STATED ON THE ABOVE-CAPTIONED "PERMIT TO DRILL WELL", AND THAT INFORMATION CONTAINED IN THIS REPORT IS TRUE, ACCURATE, AND COMPLETE TO THE BEST OF MY KNOWLEDGE, INFORMATION AND BELIEF.					
DRILLERS NAME (PLEASE PRINT) L. F. EASTER, JR. SIGNATURE L. F. Easter, Jr.					

HOWARD COUNTY HEALTH DEPARTMENT
Bureau of Environmental Health
3525-H Ellicott Mills Drive
Ellicott City, MD 21043
461-9933

APPLICATION FOR PITLESS ADAPTER, WELL PUMP AND PRESSURE TANK INSTALLATION

New Installation ☒
Replacement ☐

Receipt # 70
Date 9/28/93

Name of Installer PAUL E. LENNON

Telephone 781-64053

License Number 7611

Certified Well Pump Installer ☐ Well Driller ☐ Registered Plumber ☒

Name of Property Owner William Lons

Telephone

Subdivision ROY PATTERSON PROP Lot # 3 Well Tag # HO-73-2791

Site Address 479 Ga. Ave. Rd

200

Pump

1. Type
 - a. Deep well jet ☐
 - b. Shallow well jet ☐
 - c. Submersible ☒

2. Make SACCUZZI

3. Model # 24

4. Capacity 24 GPM

5. Pump exceeds well capacity Yes ☒ No ☐

6. If Yes, is low pressure cutoff switch installed? Yes ☒ No ☐

7. What methods are used to protect the pump and electrical wiring from vibrations? Torque arrestors ☐ Cable guards ☒ Other ☐

Motor

1. Horsepower 1/2

2. RPM 3400

3. Voltage 240

a. 110 ☐

b. 220 ☒

Pitless Adapter

1. Make HARWARD

2. Model # 24

3. Depth 4'

Tank

1. Capacity 60 GAL
2. Pressure relief valve? 75

Piping

1. Type Black orange bery

2. Size 1"

3. NSF and/or BOCA Code approved ☐

4. Depth of supply line 200

Well data

1. Depth 200 ft.

2. Yield 2 GPM

3. Static water level 200 ft.

4. Will water supply be disinfected by installer? YES

I understand that it is my responsibility to notify the Howard County Health Department when the installation is ready for inspection (otherwise this permit is null and void).

All information given above is true to the best of my knowledge.

Signature of Applicant: Paul E. Lennon

Date: 9/28/93

Note: A sticker indicating approval/status of the installation will be placed on the well casing at the time of the inspection.

Scale: 1" = 40'

William J. and Anna M. Long
Lot 3 - Gaither Road
Third Elec. Dist., Howard Co.
Sykesville, Maryland

SEWAGE DISPOSAL
EASEMENT

Exist. elev. at trench 100.
Exist. elev. at dist. box 100.
Inv. elev. (into) dist. box 92.1
Inv. elev. (out of) septic
tank 92.15

FF Elev. 102.
BE Elev. 93

Well elevation 102.

Exist. elev. at septic tank 17.2
Inv. Elev. (into) septic tank 72.5
Inv. elev. (out of) house 92.2

Inv. elev. (into) trench 97.

Note: Elevations are generic / Total length septic field to be determined
by Howard County Health Department at time of installation

I certify that the above measurements are actual and
correct for this property.

Signed: William J. Long

Anna M. Long

2




N 84° 15' E 794.28'
S 84° 15' E 794.28'

FF. Elev. 102'

3

728.1 ±

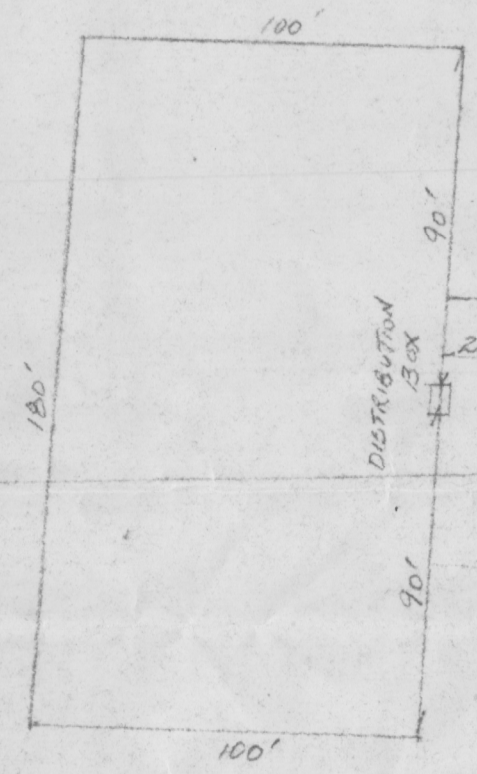

DRIVE

WELL

GAITHER ROAD

M. L. E. N. ROAD

N 65° 55' W 332.44'
S 65° 55' W 332.44'

S 88° 51' E 604.41'
N 88° 51' E 604.41'

4

PLOT PLAN FOR WILLIAM J. AND ANNA M. LONG
THIRD ELECTION DISTRICT - HOWARD COUNTY
SYKESVILLE, MARYLAND

LOT 3 - 479 GAITHER ROAD

SCALE: 1" = 50'

n 70' well to S.W.E.

180/
3-7