

03-307334

P 33957

A 28312

ELLICOTT CITY

DISTRICT 3rd.

DATE 6/5/84

INDEX

3/1/04 - NEED PLAN SHOWING
Location of pool before
signing any new bp's

William H. Smith, Jr.

IS PERMITTED TO INSTALL X ALTER

ADDRESS P. O. Box 38, Darlington, Maryland 21034 PHONE 457-5570

SUBDIVISION Farside ROAD 11849 Farside Road LOT 54

PROPERTY OWNER Woodmark, Inc.

12150 Mt. Albert Court

ADDRESS Ellicott City, Maryland 21043

IF GARBAGE GRINDER IS USED INCREASE SEPTIC TANK CAPACITY BY 50% AND ABSORPTION AREA BY 22%.

GARBAGE GRINDER? YES _____ NO X

SEPTIC TANK CAPACITY 1250 GALLONS NUMBER OF BEDROOMS 4

DRY WELL OR DRY WELL AND TRENCH - 150 sq. ft. sidewall area per bedroom. Inlet 3 feet below original grade. Bottom maximum depth 9 feet below original grade. Effective area begins at 3 feet below original grade. NOTE: If trench is used to make up absorbent area, run the trench on level ground. Leave a 5 foot earth buffer between dry well and trench. No trench is to exceed 100 feet in length. Trench inlet to be same as dry well, with 6 feet of stone below distribution pipe. LOCATION: Dry well to be located 170 feet from the left (313') lot line and 85 feet from the rear (440') lot line. If additional trench required, start trench 5 feet downhill from dry well and continue along contour towards Farside Road. Manhole cleanout required if top of septic tank is more than 36" below final grade.

PLANS APPROVED BY C. Williams DATE 6/5/84

COVER NO WORK UNTIL INSPECTED AND APPROVED.

NEITHER THE HOWARD COUNTY COUNCIL NOR THE HEALTH DEPARTMENT IS RESPONSIBLE FOR THE SUCCESSFUL OPERATION OF ANY SYSTEM.

NOTE: IF TRENCH IS USED CALL FOR INSPECTION BEFORE AND AFTER PLACING GRAVEL IN TRENCH.

NOTE: NO DRY WELL SHALL EXCEED 15 FOOT IN DIAMETER. NO ABSORPTION TRENCH TO EXCEED 100 FEET IN LENGTH.

NOTE: ALL PIPE FROM HOUSE TO SEPTIC TANK MUST BE CAST IRON OR SCHEDULE 40 PVC OR ABS.

PERMIT VOID AFTER THREE YEARS.

NOTE: INSTALL STAND PIPE ON SEPTIC TANK AND DRY WELL. STAND PIPES MUST BE 6 INCHES IN DIAMETER. CAST IRON, CONCRETE OR TERRA COTTA, OR PVC OR ABS ACCEPTED. IF TOP OF SEPTIC TANK IS DEEPER THAN 3 FEET MANHOLE TO GRADE REQUIRED.

BLOG. PERMIT SIGNED

AND RETURNED

Serial # 19919 - Prod

***INSTALLER IS RESPONSIBLE FOR OBTAINING FINAL APROVAL ON THIS PERMIT**

***CALL 992-2330 FOR INSPECTION OF SEPTIC SYSTEMS.**

EH - 2-1082

28312 A

APPLICATION

A 28312

P _____

SEWAGE DISPOSAL TESTING

STATE OF MARYLAND - DEPARTMENT OF HEALTH AND MENTAL HYGIENE

HOWARD COUNTY HEALTH DEPARTMENT
ENVIRONMENTAL HEALTH SERVICESP. O. BOX 476, ELLICOTT CITY, MARYLAND 21043
TELEPHONE: 465-5000, EXT. 356DISTRICT 3
*1-3 Bedrooms 1000 gallons*DATE May 12, 1978*4 Bedrooms 1250 gallons*TO: THE COUNTY HEALTH OFFICER
ELLICOTT CITY, MARYLAND

I, HEREBY, APPLY FOR THE NECESSARY TEST IN ORDER TO CONSTRUCT (OR RECONSTRUCT) A SEWAGE DISPOSAL SYSTEM.

PROPERTY OWNER Woodmark, Inc.ADDRESS 9267 Balto. Nat'l. Pike PHONE 461-2889

PROPERTY LOCATION:

SUBDIVISION Farside LOT NO. 56 54ROAD AND DESCRIPTION Rt. 40 West to left on Rt. 144, left on Folly Quarter, left on
Homewood, 1 mile to property on leftSIZE OF LOT 3 plus acres TYPE BLDG. 1
NUMBER OF BEDROOMS

IF NOT SINGLE RESIDENCE DESCRIBE _____

THE SYSTEM INSTALLED UNDER THIS APPLICATION IS ACCEPTABLE ONLY UNTIL PUBLIC FACILITIES BECOME AVAILABLE.


SIGNATURE OF APPLICANT *R. J. [Signature]*APPROVED BY _____ FOR _____ DATE 11
(KIND OF SYSTEM)REJECTED BY _____ FOR _____ DATE _____
(KIND OF SYSTEM)

HOLD PENDING FURTHER TESTS _____ DATE _____

REASONS FOR REJECTION OR HOLDING _____

THIS IS NOT A PERMIT

54

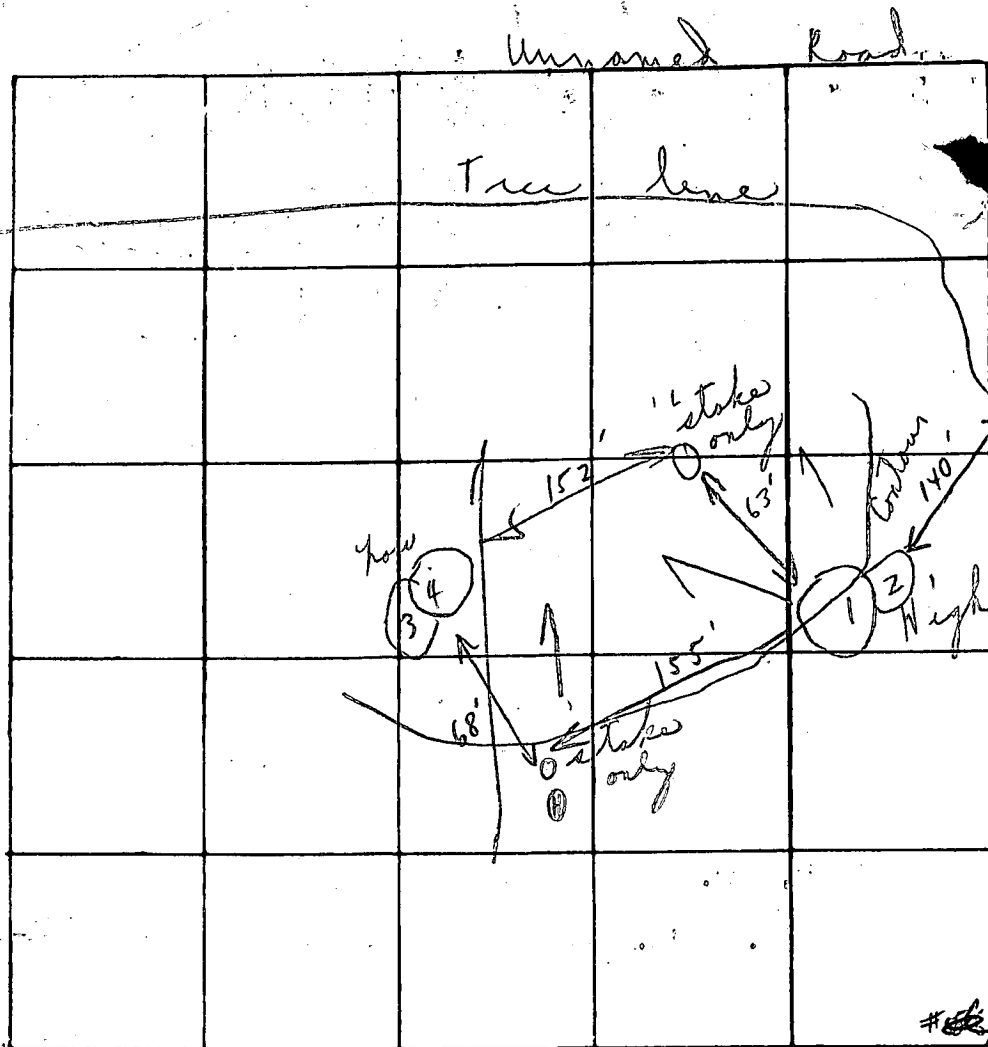

Soil Profile

Below
Soil
Brown

DATE	TEST NO.	DEPTH	PRE-WET		TEST 1" DROP		TIME
			START	STOP	START	STOP	
9/11/78	1	3'	9:34	9:35	9:35	9:37	2 in
	2	11'	9:34	9:37	9:37	9:41	4 in
	3	3'	9:21	9:22	9:22	9:23	1 in
	4	10 1/2'	9:22	9:24	9:24	9:27	3 in
			2 Holes only		per P.F.W.		
							3 in - avg.
							150 sq ft per bedroom

Some sand stone

Under 3'

3 in - avg.

150 sq ft per bedroom

REMARKS

Open field - Test conducted

TYPE OF SOIL

J.A.D.


TESTED BY

C.B.S.

ALSO PRESENT

Same as 7/10/78

Hold for certified holes

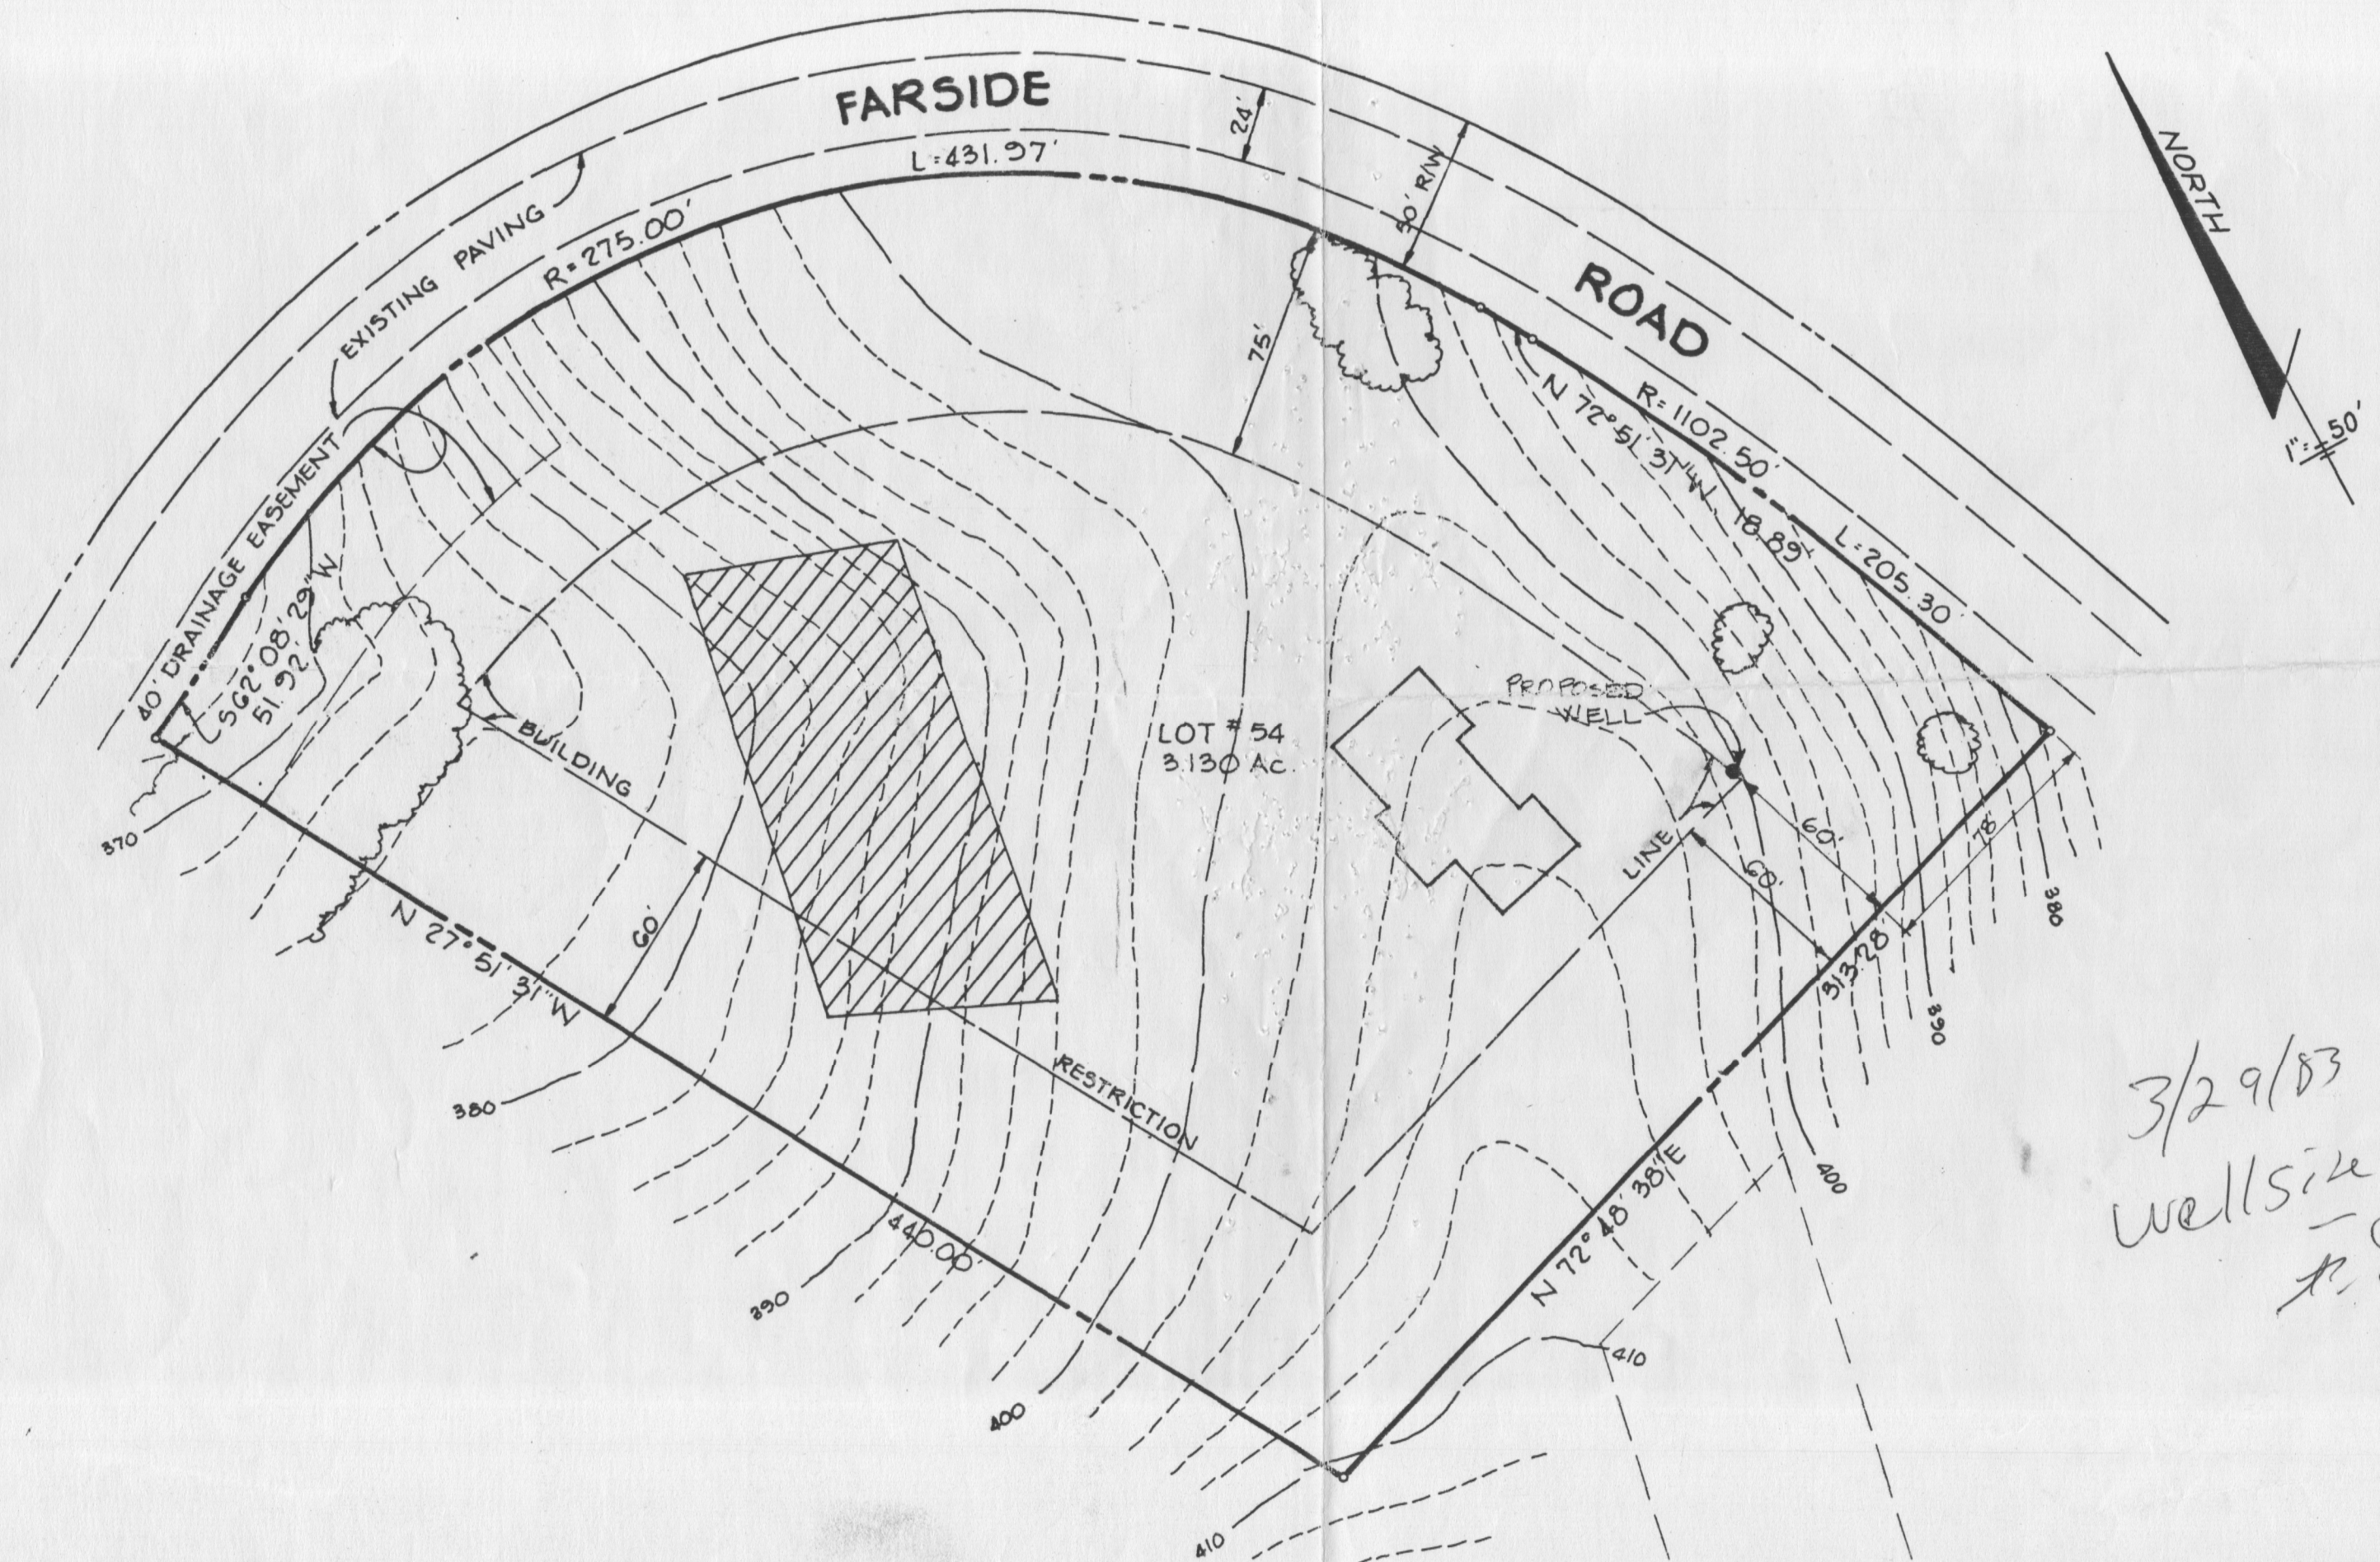

3/29/83
Well size on
P.S.

FAR SIDE

4/31/83
EMERGENCY/TEMP. NO. IF ANY

B 1	0290	SEQUENCE NO. (OEP USE ONLY)	4.00 3hr pump test 9.30 Grout	STATE OF MARYLAND PERMIT TO DRILL WELL please print or type	OEP PERMIT NUMBER HO-81-0036 fill in this form completely
Date Received		0 3 2 1 8 3 (OEP Use Only)		LOCATION OF WELL	
OWNER INFORMATION		COUNTY <u>Howard</u>			
Last Name 15 <u>EDWARDS</u> Owner 34 Name <u>D. J.</u>		SUBDIVISION <u>Farside</u>			
36 <u>5391</u> 41 <u>1/2</u> 46 <u>House</u> 55 <u>CT</u>		SECTION <u>23</u> LOT <u>54</u>			
Town 57 <u>Columbia</u> State <u>MD</u> 76 Zip <u>21044</u>		NEAREST TOWN <u>Ellick</u>			
MILES FROM TOWN (enter o if in town) <u>1.310</u>		M 1 I			
B 1 Continued		DRILLER INFORMATION			
Driller's Name <u>Joseph L. Mague</u>		77 License No. 80 <u>238</u>			
Firm Name <u>Joseph L. Mague</u>		Address <u>5512 Ridge Rd. Mt. Airy Md.</u>			
Signature <u>Joseph L. Mague</u>		Date <u>Mar 21, 83</u>			
B 2		WELL INFORMATION			
APPROX. PUMPING RATE (GAL. PER MIN.) <u>5</u>		AVERAGE DAILY QUANTITY NEEDED (GAL. PER DAY) <u>500</u>			
USE FOR WATER (CIRCLE APPROPRIATE BOX)					
☒ HOME (SINGLE OR DOUBLE HOUSEHOLD UNIT ONLY) ☐ FARMING (LIVESTOCK WATERING & AGRICULTURAL IRRIGATION) ☐ INDUSTRIAL, COMMERCIAL, STATE AND FEDERAL GOV. OTHER (REQUIRES APPROPRIATION PERMIT) ☐ PUBLIC OR PRIVATE WATER COMPANY (REQUIRES APPROPRIATION PERMIT AND STATE HEALTH DEPARTMENT APPROVAL) ☐ TEST, OBSERVATION, MONITORING (MAY REQUIRE APPROPRIATION PERMIT)					
APPROXIMATE DEPTH OF WELL <u>180</u> FEET					
APPROXIMATE DIAMETER OF WELL <u>6</u> INCH					
METHOD OF DRILLING (circle one)					
☒ BORED (OR AUGERED) ☐ JETTED ☐ JETTED & DRIVEN ☐ AIR ROTARY ☐ AIR PERCUSSION ☐ ROTARY (HYDRAULIC ROTARY) ☐ CABLE ☐ REVERSE ROTARY ☐ DRIVE POINT other _____					
REPLACEMENT OR DEEPEINED WELLS (CIRCLE APPROPRIATE BOX)					
☒ THIS WELL WILL NOT REPLACE AN EXISTING WELL ☐ THIS WELL WILL REPLACE A WELL THAT WILL BE ABANDONED AND SEALED ☐ THIS WELL WILL REPLACE A WELL THAT WILL BE USED AS A STANDBY ☐ THIS WELL WILL DEEPEIN AN EXISTING WELL PERMIT NUMBER OF WELL TO BE REPLACED OR DEEPEINED (IF AVAILABLE) 41 _____					
Not to be filled in by driller (OEP USE ONLY)					
APPROX. PERMIT NUMBER <u>54</u> <u>GAP</u> <u>63</u>					
FORCE <u>ES</u> WRITE INITIALS IN BOX PERMIT No. <u>HO-81-0036</u>					
B 5 SPECIAL CONDITIONS 8-63					
1 2 3 6					

LOCATION OF WELL

11 NEAR WHAT ROAD Farside Rd. 30

ON WHICH SIDE OF ROAD (CIRCLE APPROPRIATE BOX)

WEST EAST SOUTH NORTH

78

34 DISTANCE FROM ROAD 37

(CIRCLE APPROPRIATE BOX)

SHOW MAJOR FEATURES OF BOX & LOCATE WELL WITH AN X

SOURCES OF DRILLING WATER

1. WELL

2.

3.

WRITE THE BOX NUMBER FROM THE MAP HERE

E 8204

N 5108

000 3/31/83 000

DRAW A SKETCH BELOW SHOWING LOCATION OF WELL IN RELATION TO NEARBY TOWNS AND/ROADS AND GIVE DISTANCE FROM WELL TO NEAREST ROAD JUNCTION.

N

Farside Road

3 1/10 mi

Spring Haven Ct

Ellick

B 4

NOT TO BE FILLED IN BY DRILLER HEALTH DEPARTMENT APPROVAL

HOWARD A28310

COUNTY NAME COUNTY NO.

OEP SIGNATURE Frank S. Skinner STATE HEALTH CIRCLE BOX S 41

DATE ISSUED 032983 CO SIGNATURE _____

43 48 50 55 57 63

NORTH GRID 518 EAST GRID 0824 EXPIRES 092983

FIELD DATA SHEET
HOWARD COUNTY WELL YIELD TEST

Well Permit No. HO - 81-0036
Location of property (road) Farside
Subdivision Farside Lot 54 Block Plat Sec.
Well Driller Joseph Mayne Owner J.D. Evans
Depth of well 125'
Distance of measuring point (M.P.) above ground 1 1/2'
Static water level (S.W.L.) below M.P. 47'

1. High rate pumping -- reservoir drawdown

Time pump started 8:15 Pumping rate 2
Total time to reach pumping water level _____ ft. below M.P.

II. Recovery pump test data - observations to be recorded every 15 minutes

[illegible]

WPI

9/14/84

SUPPLY LINE & PITLESS ADAPTER
INSTALLED 4' DEEP.

PRESSURE TANK WITH P.R.V. OK,

Craig Wilbur

C1 7687	SEQUENCE NO. (OEP USE ONLY)	STATE OF MARYLAND WELL COMPLETION REPORT FILL IN THIS FORM COMPLETELY PLEASE PRINT OR TYPE		THIS REPORT MUST BE SUBMITTED WITHIN 45 DAYS AFTER WELL IS COMPLETED.
	(THIS NUMBER IS TO BE PUNCHED IN COLUMNS 3-6 ON ALL CARDS)			COUNTY NUMBER A 28312
Date Received (OEP use only)	DATE WELL COMPLETED 33/83	Depth of Well 125 (TO NEAREST FOOT)	PERMIT NO. FROM "PERMIT TO DRILL WELL" 40-81-0036	

OWNER last name Evans first name D. J.	STREET OR RFD Forside Road	TOWN Elioak
SUBDIVISION Forside	SECTION	LOT 54

WELL LOG Not required for driven wells		
STATE THE KIND OF FORMATIONS PENETRATED, THEIR COLOR, DEPTH, THICKNESS AND IF WATER BEARING		
DESCRIPTION (Use additional sheets if needed)	FEET FROM TO	Check if water bearing
Sand	0 36	
Sandstone	36 125	✓

GROUTING RECORD WELL HAS BEEN GROUTED (Circle Appropriate Box)	
TYPE OF GROUTING MATERIAL CEMENT (CM) BENTONITE CLAY (BC)	
NO. OF BAGS 10 NO. OF POUNDS 940	
GALLONS OF WATER 60	
DEPTH OF GROUT SEAL (to nearest foot) from 0 ft. to 38 ft. (enter 0 if from surface)	
CASING RECORD casing types insert appropriate code below	
STEEL (ST) CONCRETE (CO) PLASTIC (PL) OTHER (OT)	
MAIN CASING TYPE S 7 6 42	
OTHER CASING (if used) diameter inch. depth (feet) from to	
SCREEN RECORD screen type or open hole insert appropriate code below	
STEEL (ST) BRASS (BR) OPEN HOLE (HO) BRONZE (PL) OTHER (OT)	
C 2 (seq. no.)	
DEPTH (nearest ft.) 40 41 125	
SLOT SIZE	
DIAMETER OF SCREEN (NEAREST INCH)	
GRAVEL PACK	
IF WELL DRILLED WAS FLOWING WELL CIRCLE BOX (F)	

C 3 (seq. no.)	PUMPING TEST HOURS PUMPED (nearest hour) 3
PUMPING RATE (gal. per min. to nearest gal.) 9	
METHOD USED TO MEASURE PUMPING RATE submersible	
WATER LEVEL (distance from land surface)	
BEFORE PUMPING 47	
WHEN PUMPING 47	
TYPE OF PUMP USED (for test)	
A air P piston T turbine	
C centrifugal R rotary O other (describe below)	
J jet S submersible	

PUMP INSTALLED YES NO	
DRILLER WILL INSTALL PUMP (CIRCLE APPROPRIATE BOX) Y N	
IF DRILLER INSTALLS PUMP, THIS SECTION MUST BE COMPLETED FOR ALL WELLS EXCEPT HOME USE	
TYPE OF PUMP (WRITE APPROPRIATE LETTER IN BOX - SEE ABOVE: (A, C, J, P, R, S, T, O))	
CAPACITY: GALLONS PER MINUTE (to nearest gallon)	
PUMP HORSE POWER	
PUMP COLUMN LENGTH (nearest ft.)	
CASING HEIGHT (circle appropriate box and enter casing height)	
+ above LAND SURFACE	
- below (nearest foot)	

CIRCLE APPROPRIATE BOX	
A A WELL WAS ABANDONED AND SEALED WHEN THIS WELL WAS COMPLETED	
E ELECTRIC LOG OBTAINED	
P TEST WELL CONVERTED TO PRODUCTION WELL	
I HEREBY CERTIFY THAT THIS WELL HAS BEEN CONSTRUCTED IN ACCORDANCE WITH COMAR 10.17.13 "WELL CONSTRUCTION" AND IN CONFORMANCE WITH ALL CONDITIONS STATED IN THE ABOVE CAPTIONED PERMIT, AND THAT THE INFORMATION PRESENTED HEREIN IS ACCURATE AND COMPLETE TO THE BEST OF MY KNOWLEDGE.	
DRILLERS IDENT. NO. 238	
DRILLERS SIGNATURE Joseph L. Mayne	
SITE SUPERVISOR (sign of driller or journeyman responsible for sitework if different from permittee)	

OEP USE ONLY (NOT TO BE FILLED IN BY DRILLER)	
T (E.R.O.S.)	
W Q	
TELESCOPE CASING LOG INDICATOR OTHER DATA	


LOCATION OF WELL ON LOT	
SHOW PERMANENT STRUCTURE SUCH AS BUILDING, SEPTIC TANKS, AND/OR LANDMARKS AND INDICATE NOT LESS THAN TWO DISTANCES (MEASUREMENTS TO WELL)	
60' well 78' front lot line	

Well Permit No. HO - 81-0036
Location of property (road) Farside Rd
Subdivision Farside Lot 54 Block Plat Sec.
Well Driller Joseph L. Mayre Owner J. D. Evans

Depth of well 125
Distance of measuring point (M.P.) above ground 1 1/2
Static water level (S.W.L.) below M.P. 47

Time pump started 8:15 Pumping rate 9
Total time 8:15 to reach pumping water level 47 ft. below M.P.

[illegible]

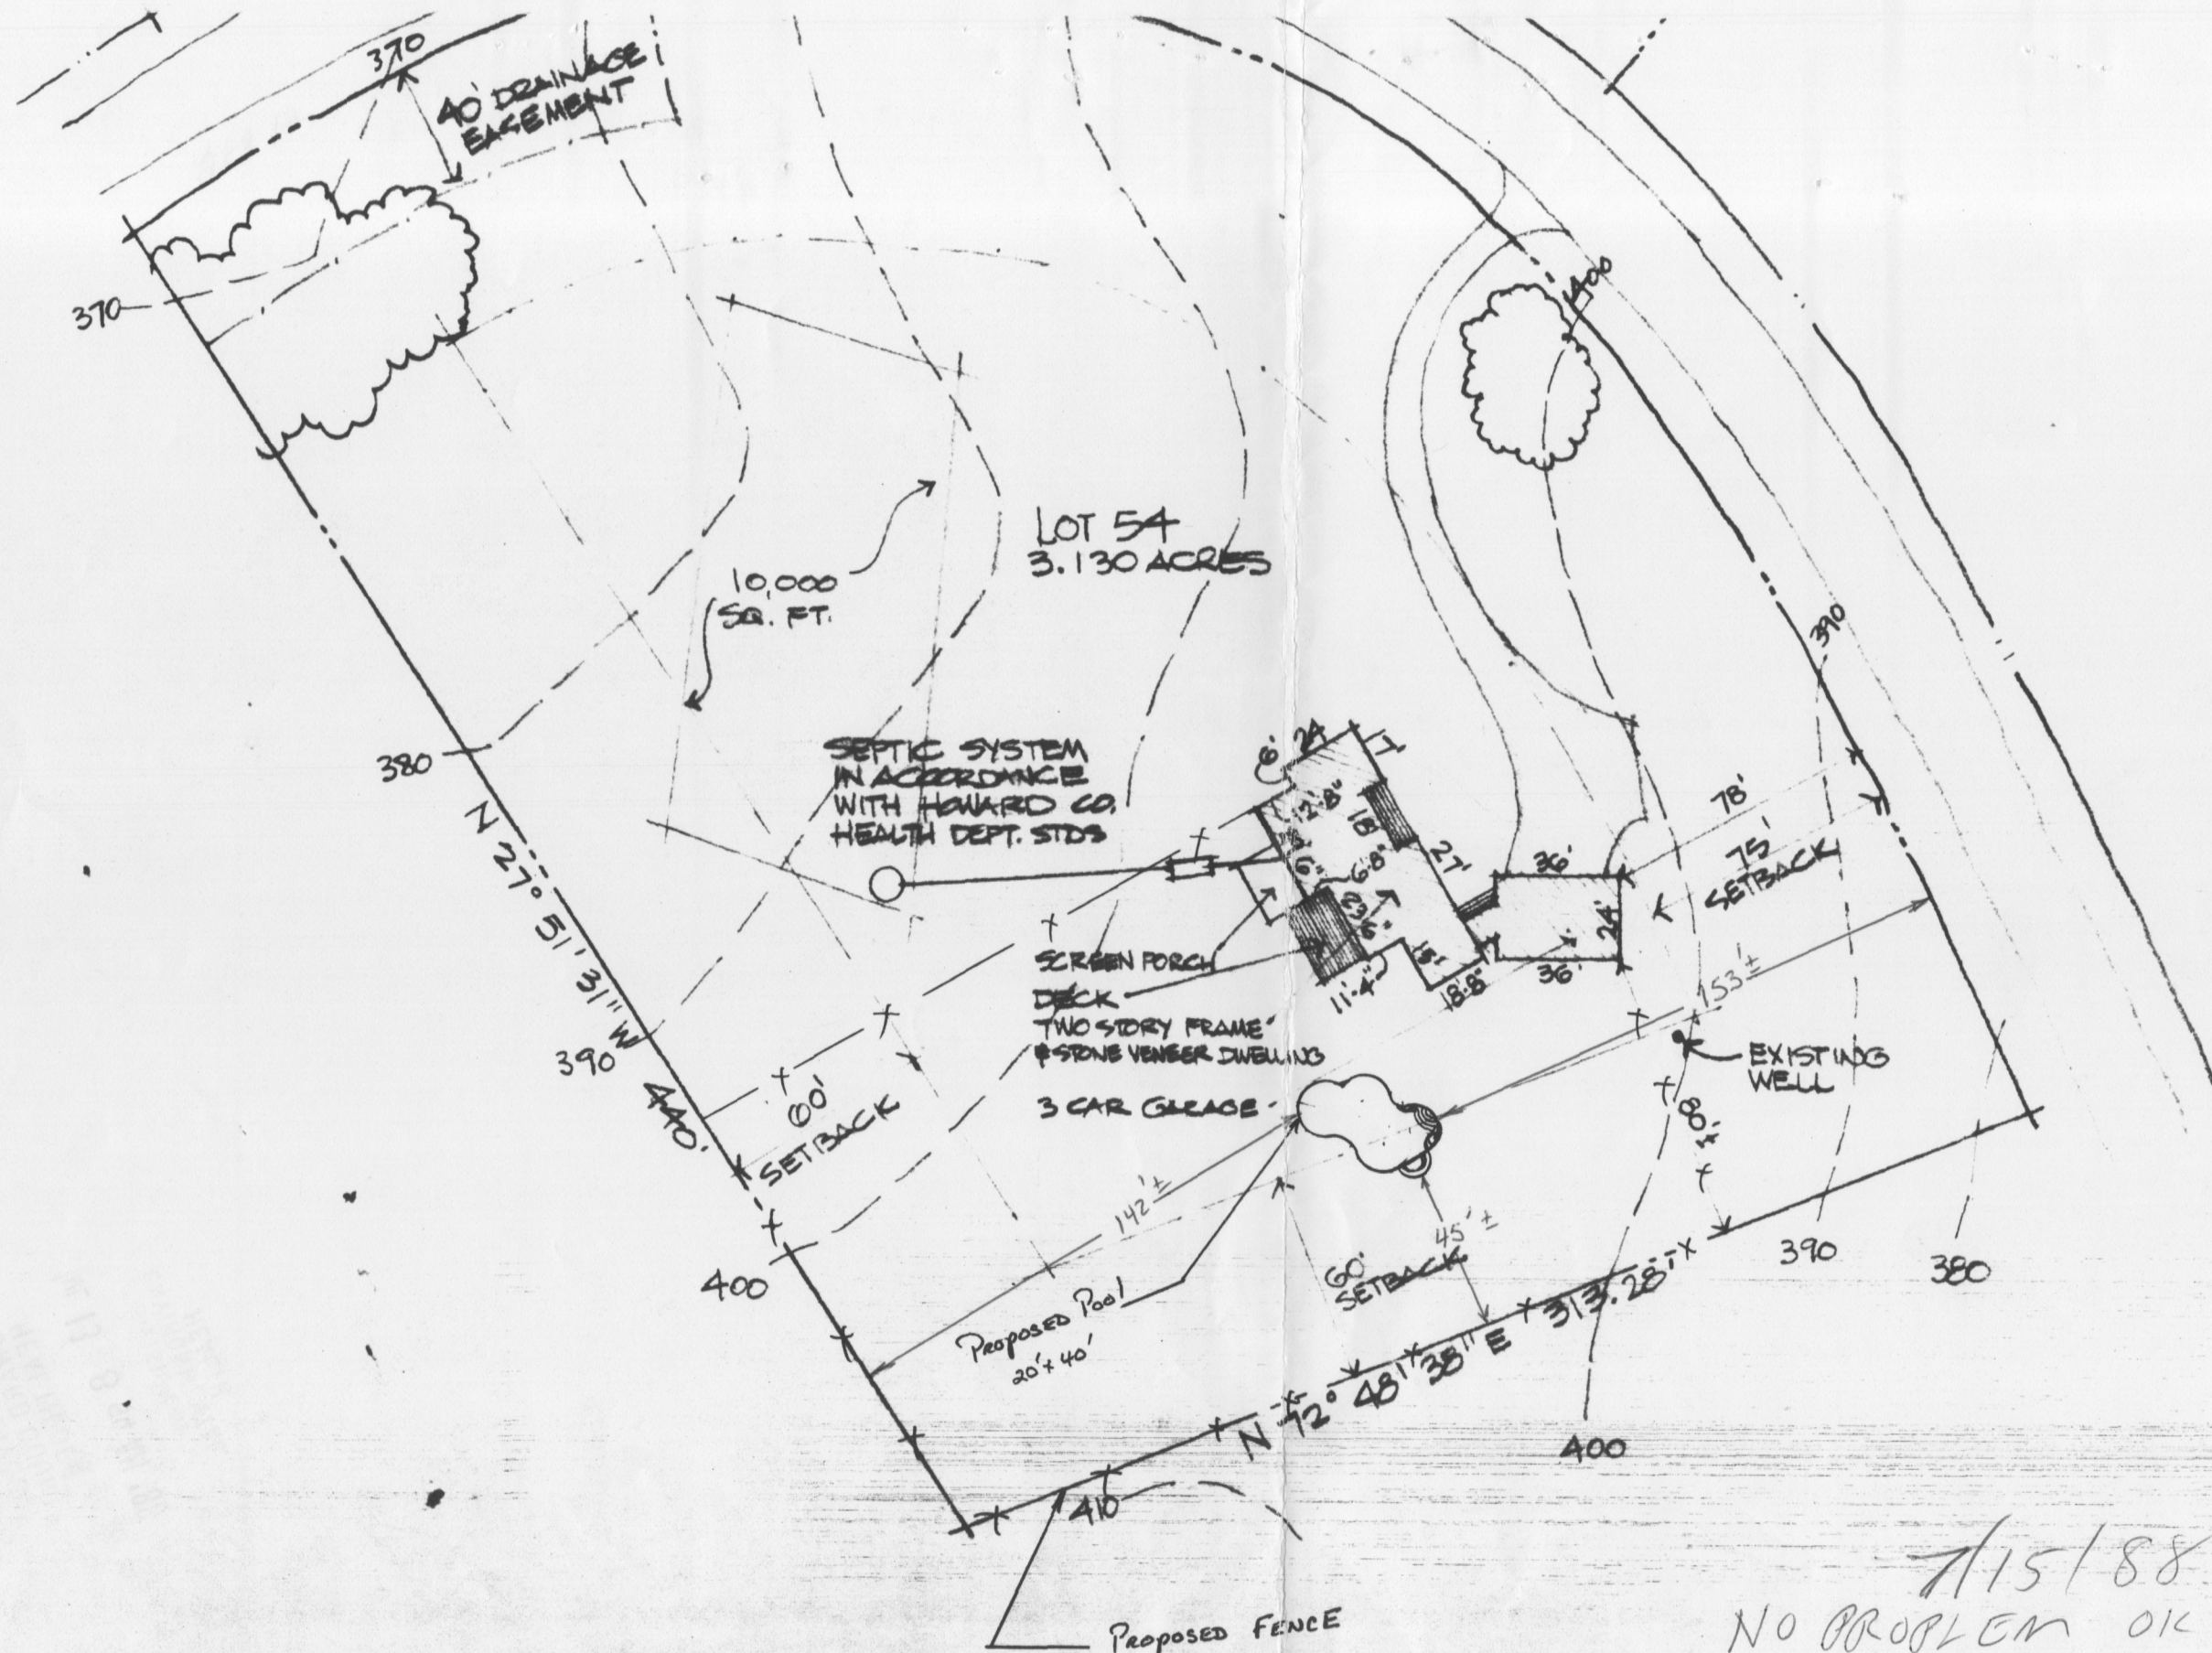

7/15/88
NO PROBLEM OK TO SIGN RH

NORTH

SITE PLAN SCALE 1"=50'0"