

Approved 11/23/84
Stages 34197
P 34466
A 28405

9/25/84
after noon

PERMIT

SEWAGE DISPOSAL SYSTEM

MARYLAND STATE DEPARTMENT OF HEALTH*

HOWARD COUNTY
BUREAU OF ENVIRONMENTAL HEALTH
992-2330

TAX ID # 03-306941

ELLICOTT CITY

DISTRICT 3rd

DATE 11/19/84

INDEXED

Robert L. Orndorff IS PERMITTED TO INSTALL X ALTER

ADDRESS 7469 Flamewood Drive, Clarksville, MD 21029 PHONE 776-0444

SUBDIVISION Farside ROAD 11678 Laurel Oak Ct. LOT 20

PROPERTY OWNER Dr. & Mrs. Willis 465-1530

ADDRESS 3728 Spring Falls Court
Ellicott City, Maryland 21043

IF GARBAGE GRINDER IS USED INCREASE SEPTIC TANK CAPACITY BY 50% AND ABSORPTION AREA BY 22%.

GARBAGE GRINDER? YES X NO

SEPTIC TANK CAPACITY 2000 GALLONS NUMBER OF BEDROOMS 4

(with garbage grinder)
Dry Well to have 183 sq. ft. effective absorbant sidewall area per bedroom below inlet.
Inlet to be 3 1/2 feet below original grade and maximum depth 9 1/2 feet. LOCATION per engineer's
platt: 265' up left property line from left front corner point and in 135' from left
property line when facing lot from Laurel Oak Court. or if dry well and trench used need;
(1) 5' earth buffer between dry well and trench (2) 2 inspections of trench before and
after stone in. (3) Run trench on contour.

145 BUILDING PERMIT SIGNED ONLY IF 217 SQ FT / BDRM ABSORBANT AREA. 11/27/84 CW
AND RETURNED

9-30-84 B00150538-DECK
3-2-05 B00152466-DECK

PLANS APPROVED BY C. B. Streaker DATE 11/15/79

COVER NO WORK UNTIL INSPECTED AND APPROVED.

NEITHER THE HOWARD COUNTY COUNCIL NOR THE HEALTH DEPARTMENT IS RESPONSIBLE FOR THE SUCCESSFUL OPERATION OF ANY SYSTEM.

NOTE: IF TRENCH IS USED CALL FOR INSPECTION BEFORE AND AFTER PLACING GRAVEL IN TRENCH.

NOTE: NO DRY WELL SHALL EXCEED 15 FOOT IN DIAMETER. NO ABSORPTION TRENCH TO EXCEED 100 FEET IN LENGTH.

NOTE: ALL PIPE FROM HOUSE TO SEPTIC TANK MUST BE CAST IRON OR SCHEDULE 40 PVC OR ABS.

PERMIT VOID AFTER THREE YEARS.

NOTE: INSTALL STAND PIPE ON SEPTIC TANK AND DRY WELL. STAND PIPES MUST BE 6 INCHES IN DIAMETER. CAST IRON, CONCRETE OR TERRA COTTA, OR
PVC OR ABS ACCEPTED. IF TOP OF SEPTIC TANK IS DEEPER THAN 3 FEET MANHOLE TO GRADE REQUIRED.


BLDG. PERMIT SIGNED
AND RETURNED 5/19/86
Dual # 70692
Pool.

A 28405

*INSTALLER IS RESPONSIBLE FOR OBTAINING FINAL APROVAL ON THIS PERMIT

*CALL 992-2330 FOR INSPECTION OF SEPTIC SYSTEMS.

EH - 2-1082

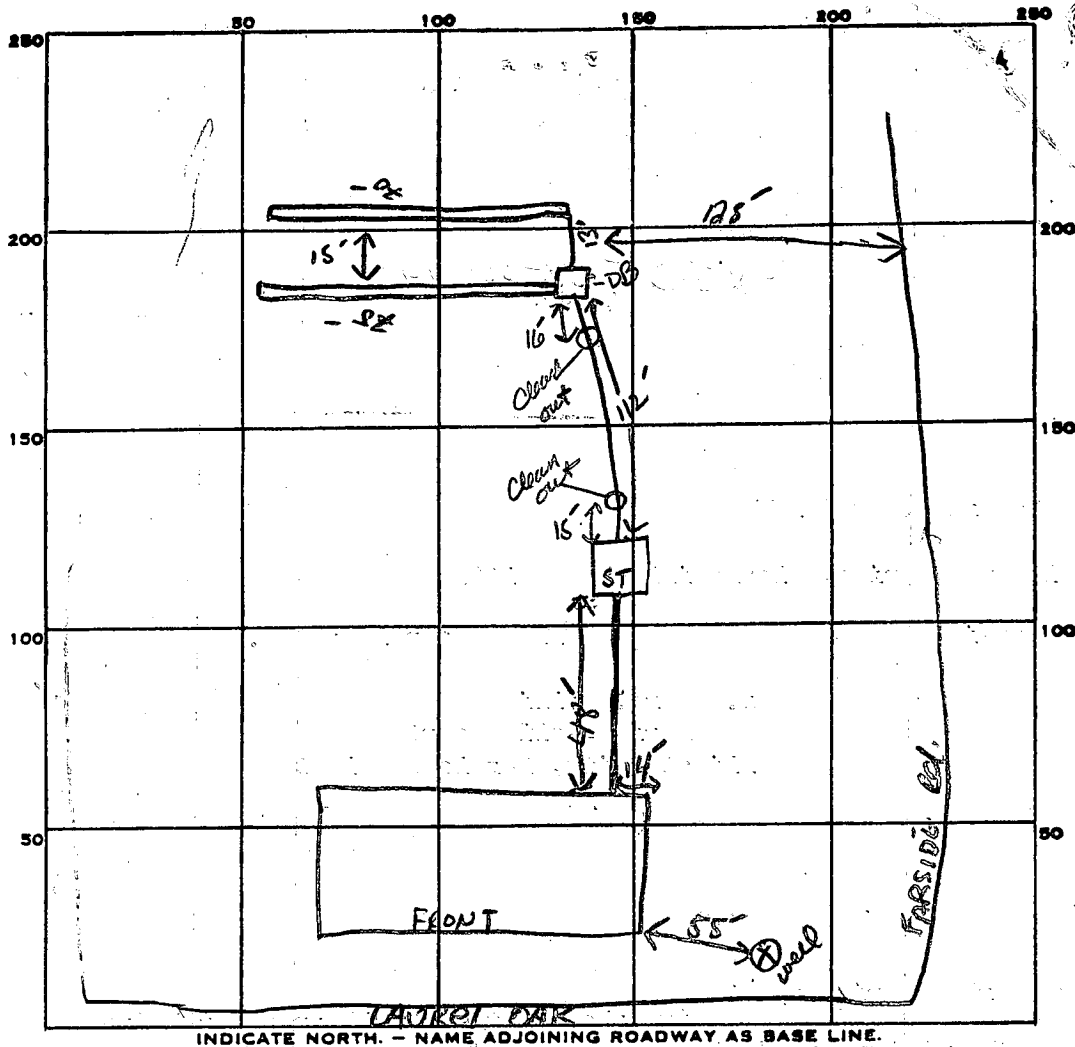

217
868

PERMIT CARD

SEPTIC TANK, LEVEL ☒ 2000 gal

CLEANOUTS 2 in line ST → DB / ST

DISTRIBUTION BOX, LEVEL ☒

BUILDING PERMIT SIGNED
AND RETURNED

TILE FIELD, DEPTH $9\frac{1}{2}$ FT. TRENCH WIDTH 2 FT.

GRAVEL DEPTH 6 IN. TOTAL LENGTH 145 FT.

NUMBER OF TRENCHES 2 TOTAL BOTTOM AREA 870

SEEPAGE PITS, INSIDE DIAMETER _____ FT. DEPTH BELOW INLET _____ FT.


ABSORBENT AREA 870 SQ. FT.

REMARKS 11/23/84 House connection made - Trenches constructed to specs. OK TO ADD STONE IN Trenches 5' deep

11/23/84 OK to cover all work

DATE SYSTEM APPROVED 11/23/84 INSPECTOR *Flanagan*

NOTE: W.O.D. DENOTES WALK-OUT
DOOR IN BASEMENT

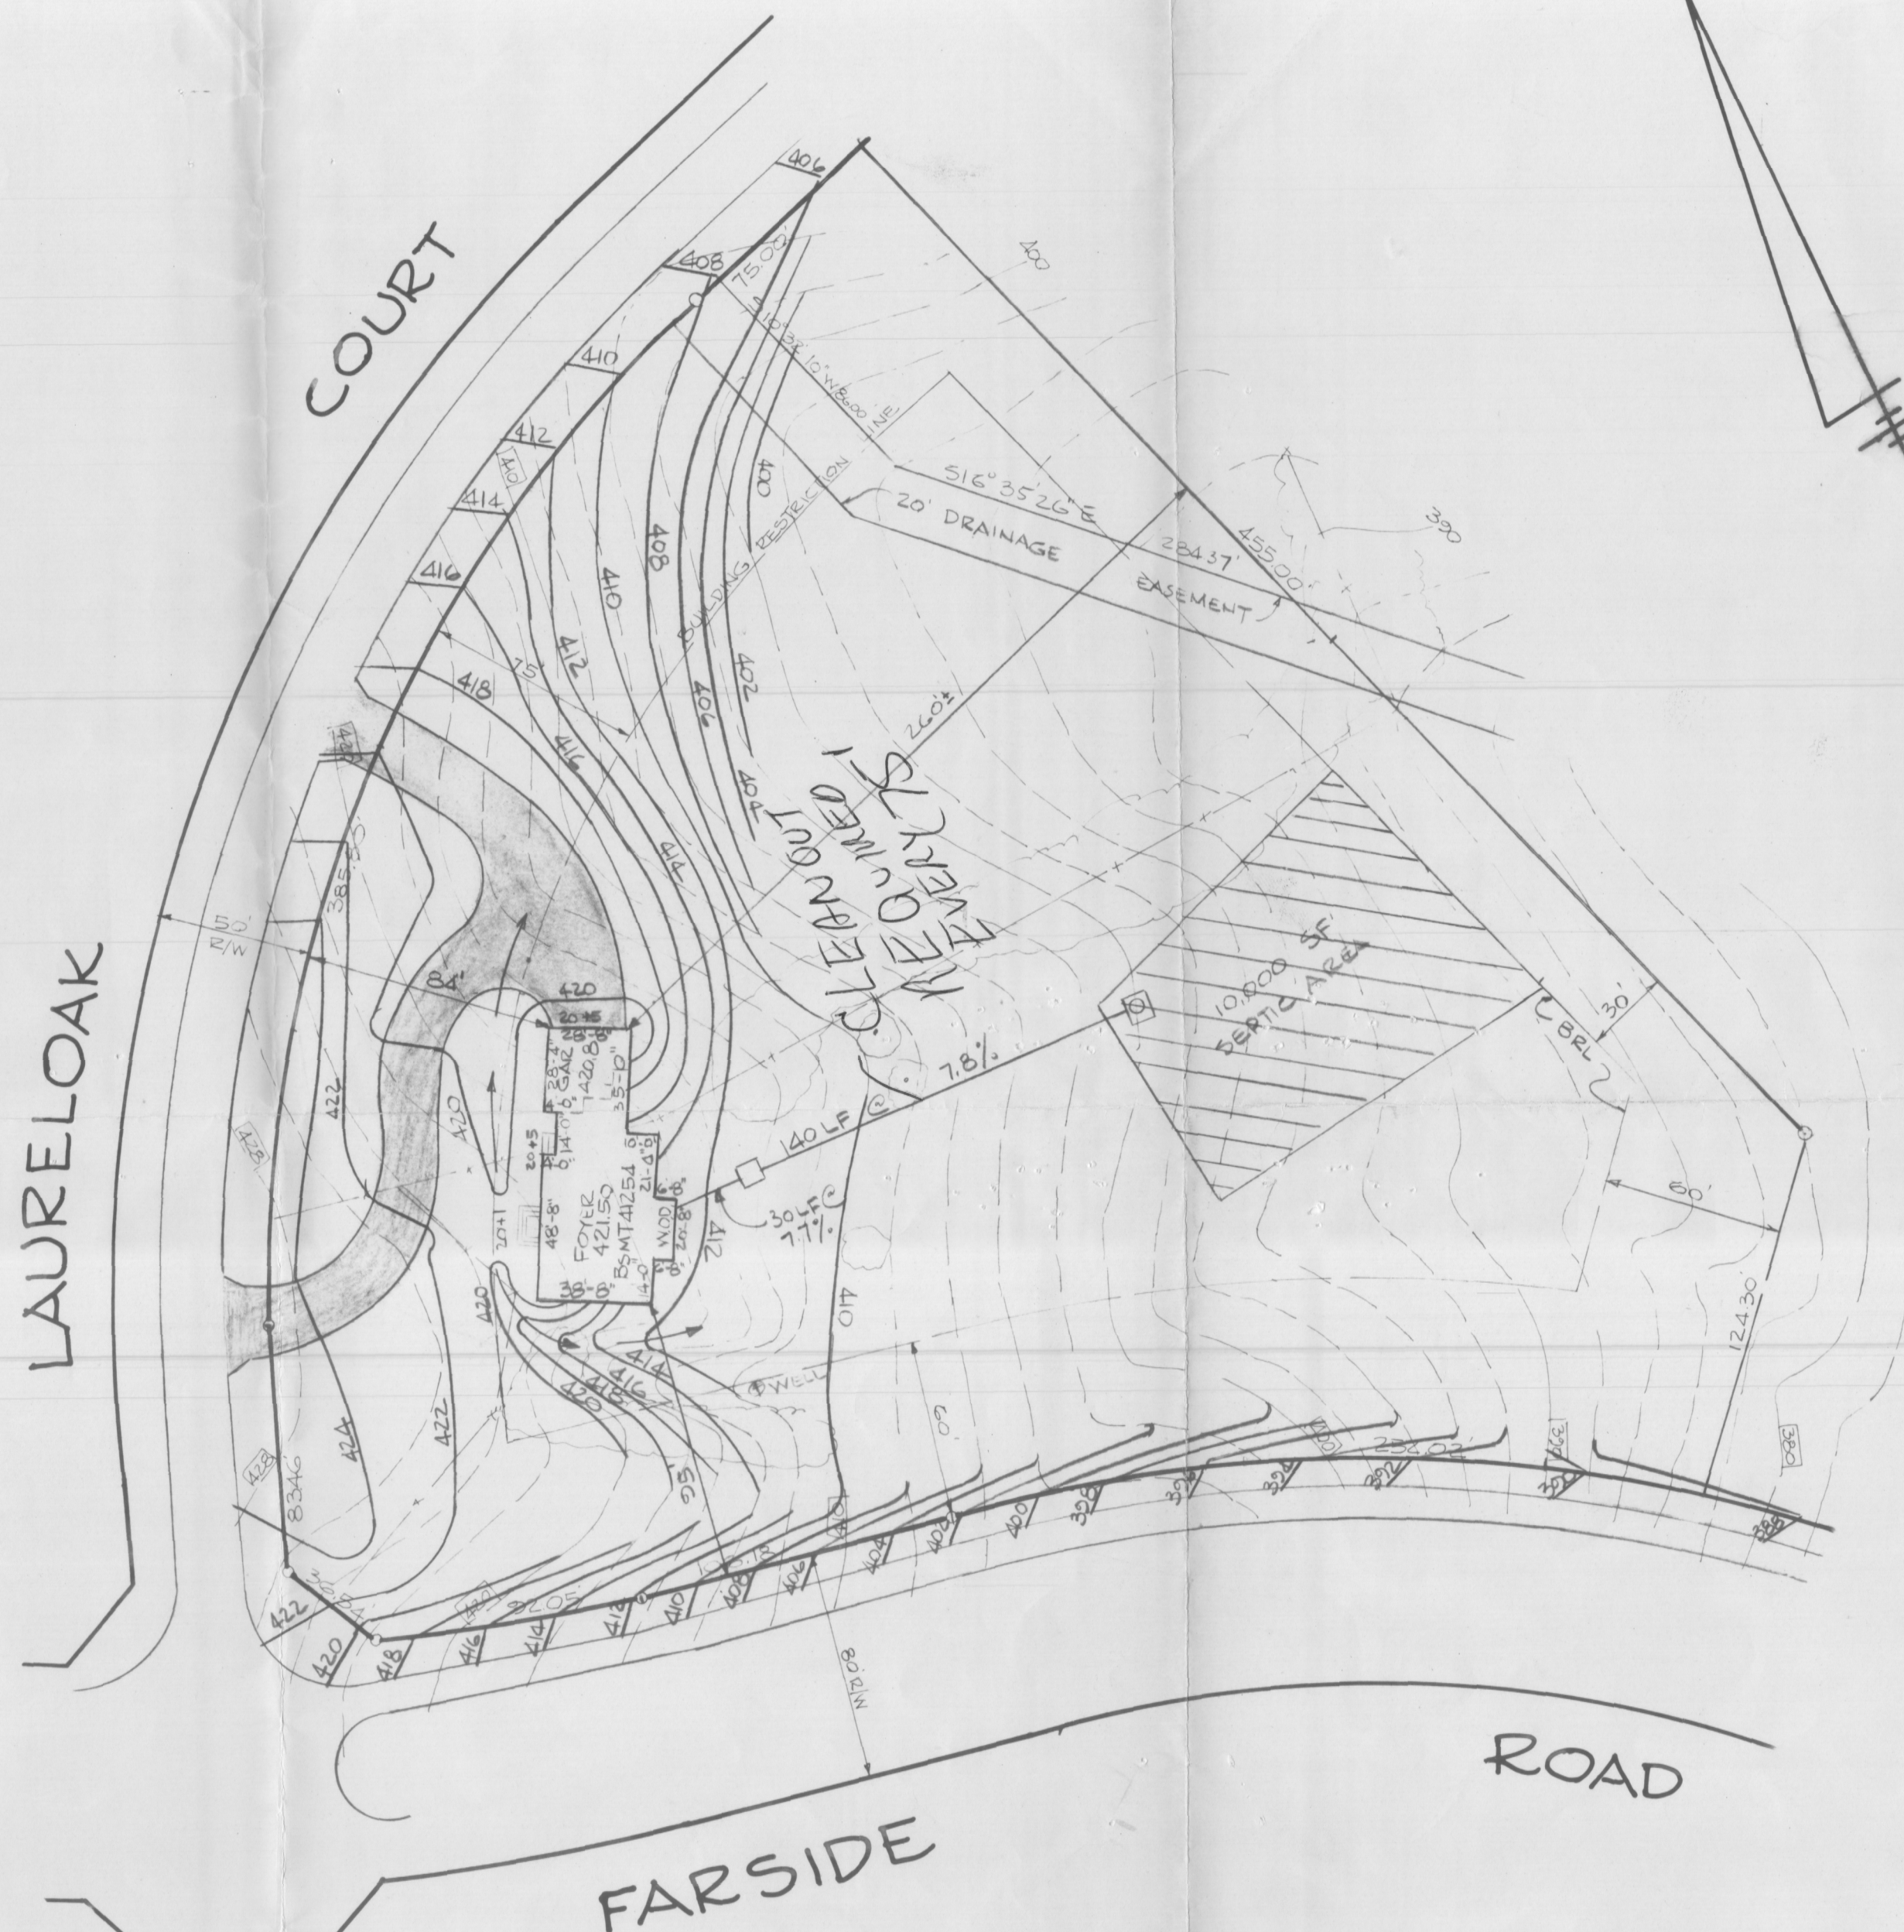

INV. @ HOUSE: 410.0

SEPTIC TANK
EX. GR. 414.3
FIN. GR. 411.5
INV. IN. 407.9
INV. OUT. 407.6

DRYWELL
EX. GR. 400.0
FIN. GR. 400.0
INV. IN. 396.5
INV. OUT. 396.0

Step down 1' in
house sewer required
Sewerline 10 feet before
septic tank must have
slope @ 1" → 270'
(1/8" 1/4" drop per foot)
otherwise sketch OK
J. Shum

SITE DEVELOPMENT PLAN
LOT 20 FARSIDE
PLAT CMP No 4407
3RD ELECTION DISTRICT
HOWARD COUNTY, MD.
SCALE: 1"=50' MAY 7, 1984
TAX MAPS 23 & 29



HIDKINS ASSOCIATES, INC.
SUITE 231, JOSEPH SQUARE
5445 HARRIS FARM ROAD
COLUMBIA, MD 21044

APPLICATION

A 28405

SEWAGE DISPOSAL TESTING

P _____

STATE OF MARYLAND - DEPARTMENT OF HEALTH AND MENTAL HYGIENE

HOWARD COUNTY HEALTH DEPARTMENT
ENVIRONMENTAL HEALTH SERVICES

P. O. BOX 476, ELLICOTT CITY, MARYLAND 21043
TELEPHONE: 465-5000, EXT. 356

1-3 Bedrooms 1000 gallons
DISTRICT 3

DATE May 12, 1978

4 Bedrooms 1250 gallons

Septic Tank
Dry well to have 150 sq ft. effective
absorbant sidewall area per bedroom below inlet.
Inlet to be 3 1/2' below original grade and maximum
depth 9 1/2'. Location per engineer's plat: 265' up
left property line from left front corner point and in 135' from
left property line when facing lot from Laurel Oak Court.

TO: THE COUNTY HEALTH OFFICER
ELLICOTT CITY, MARYLAND

I, HEREBY, APPLY FOR THE NECESSARY TEST IN ORDER TO CONSTRUCT (OR RECONSTRUCT) A SEWAGE
DISPOSAL SYSTEM.

PROPERTY OWNER Dr. & Mrs. Eugene Willis
Woodmark, Inc.
3728 Spring Falls Court
ADDRESS 9267 Balto. Nat'l. Pike
Ellicott City, Md 21043

PROPERTY LOCATION:

SUBDIVISION Farside

11678 Laurel Oak Court

ROAD AND DESCRIPTION Rt. 40 west to left on Rt. 114, left on Folly Quarter, left on

Homewood, 1 mile to property on left

SIZE OF LOT 3 plus acres

TYPE BLDG. 4

NUMBER OF BEDROOMS

IF NOT SINGLE RESIDENCE DESCRIBE _____

THE SYSTEM INSTALLED UNDER THIS APPLICATION IS ACCEPTABLE ONLY UNTIL PUBLIC
FACILITIES BECOME AVAILABLE.

SIGNATURE OF APPLICANT _____

APPROVED BY C. B. Tucker

FOR

(KIND OF SYSTEM)

DATE

11/15/79

REJECTED BY _____

FOR

(KIND OF SYSTEM)

DATE

HOLD PENDING FURTHER TESTS _____

DATE

REASONS FOR REJECTION OR HOLDING _____

BLDG. PERMIT SIGNED

AND RETURNED 5/18/84

Serial # 58962 STD.


4 Bedroom

THIS IS NOT A PERMIT

4407-21-27
EST 3-210
10 ELECTION DISTRICT
HOWARD COUNTY
MARYLAND

APPROVED
WALK-THRU BUILDING PERMIT
BP# 150538 A# 28405
APP. SAN KN DATE: 9/30/04
DESC. OF WORK: DECK

APPROVED
WALK-THRU BUILDING PERMIT
BP# 152 A# 28405
APP. SAN KN DATE: 3/20/05
DESC. OF WORK: NEW DECK

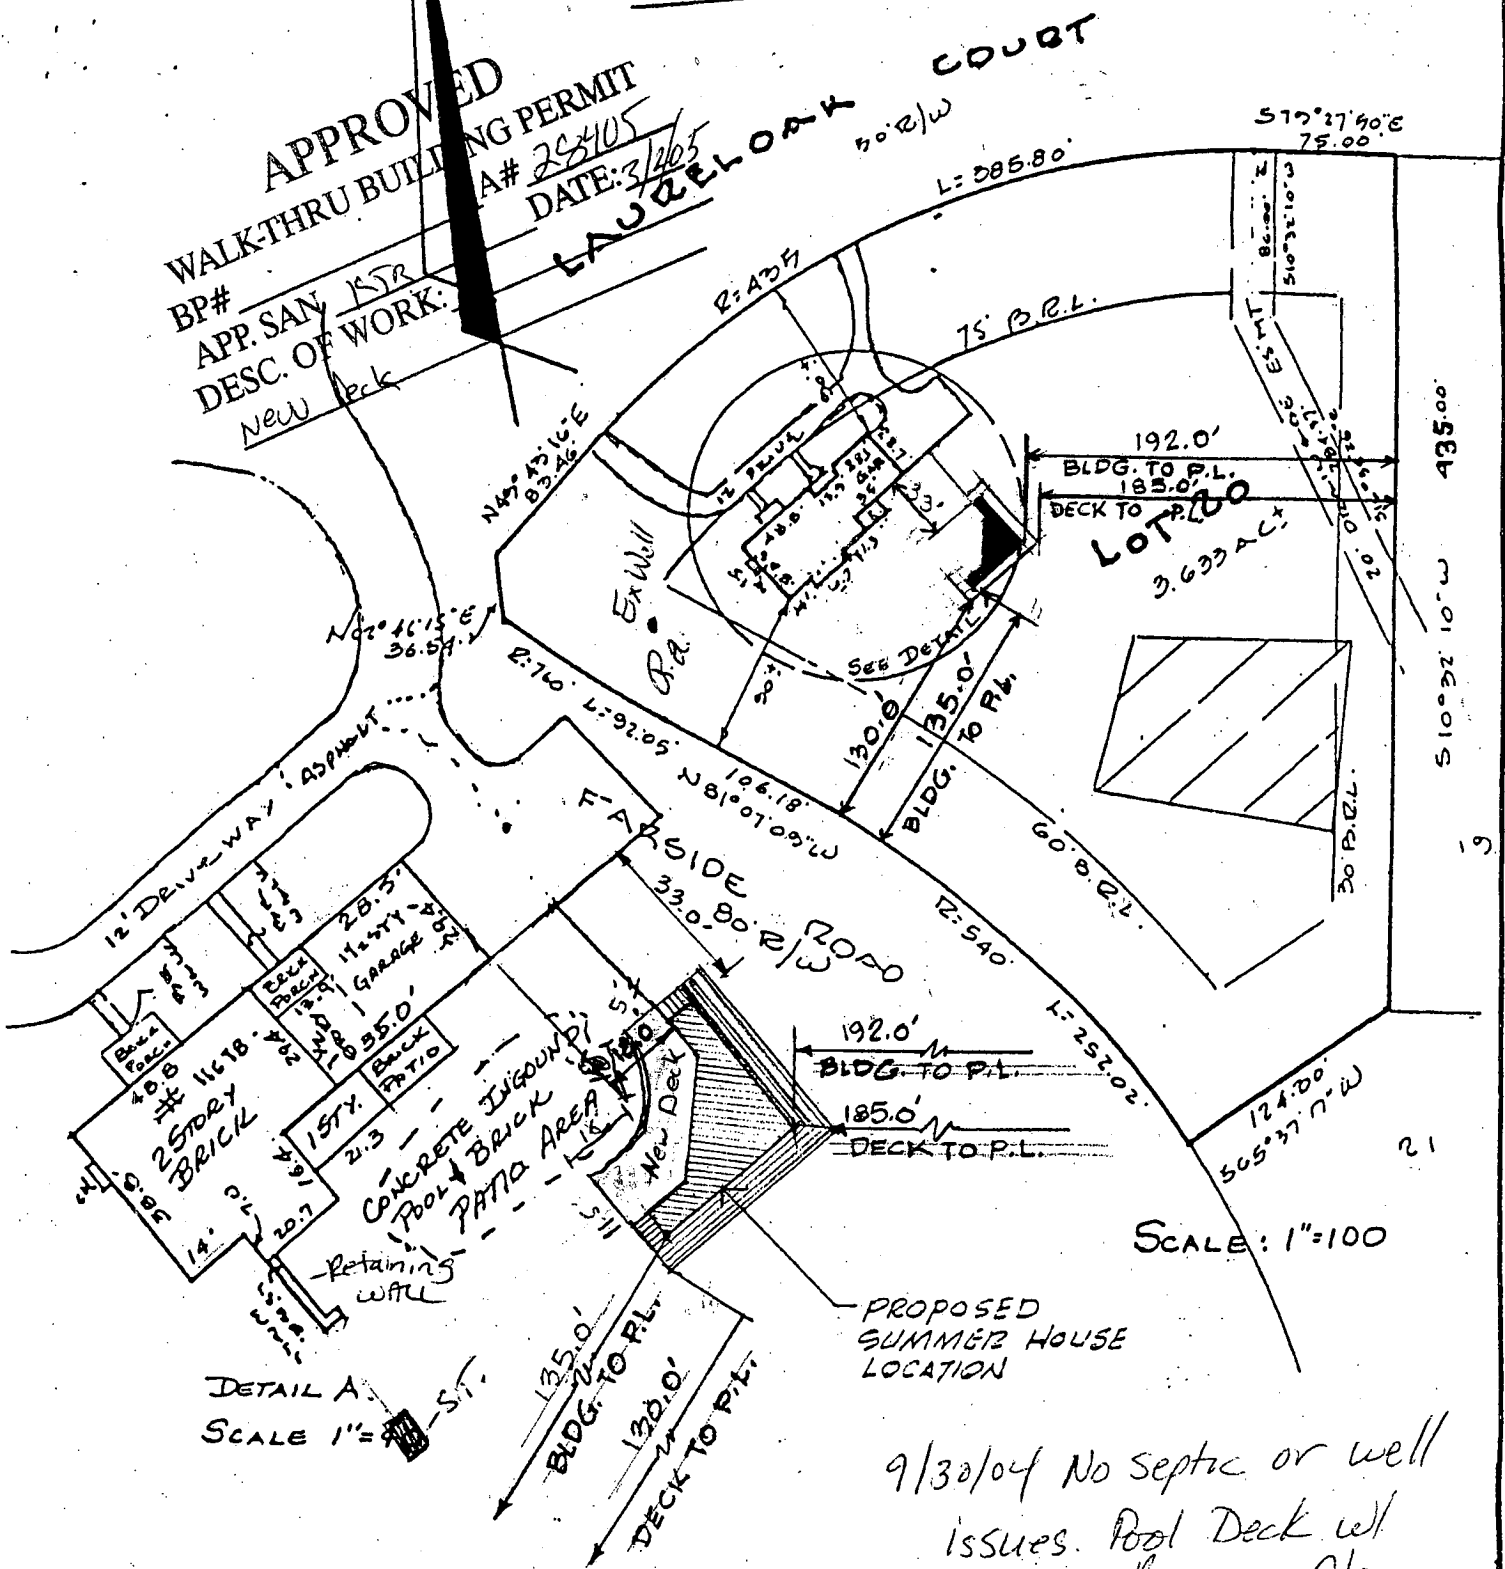

LOCATION SURVEY PLAT

9/30/04 No septic or well
issues. Pool Deck w/
changing room - No
plumbing

KN

LOT 14
4.041 Ac.

LOT 15
3.003 Ac.

LOT 16
4.235 Ac.

LAURELOAK

LOT 20
3.638 Ac.

LOT
3.339

FARSIDE ROAD

LOT 3
5.925 Ac.

LOT 21
3.778 Ac.

well
110-81-0031
3/21/83
well site on
T. S.

RECEIVED
MAR 10 1 59 PM '83

Dr. + Mrs. Eugene Willis
3728 Spring Falls CT
Ellicott City, Md. 21043

465-1530

Lot #20
Farmside

RECEIVED
HOWARD COUNTY
HEALTH DEPT.
MAR 10 3 39 PM '83
DIVISION OF
ENVIRONMENTAL
HEALTH

[illegible]

FIELD DATA SHEET
HOWARD COUNTY WELL YIELD TEST

Well Permit No. HO - 81-0631
Location of property (road) Fossil Rd
Subdivision Fossil Lot 20 Block Plat Sec.
Well Driller Ralph Mayne Owner Willis, Eugene

Depth of well 140'
Distance of measuring point (M.P.) above ground 2'
Static water level (S.W.L.) below M.P. 30'

1. High rate pumping -- reservoir drawdown


Time pump started 7:15 Pumping rate 9
Total time 15 min to reach pumping water level 34 ft. below M.P.

II. Recovery pump test data - observations to be recorded every 15 minutes

[illegible]

B 1 0551	SEQUENCE NO. (OEP USE ONLY)	STATE OF MARYLAND PERMIT TO DRILL WELL please print or type	OEP PERMIT NUMBER H0-81-0031 fill in this form completely
(THIS NUMBER IS TO BE PUNCHED IN COLS. 3-6 ON ALL CARDS)			
Date Received 3/23/83 9:30 A.M.		LOCATION OF WELL COUNTY Howard SUBDIVISION FARSI SECTION 20 NEAREST TOWN Columbia MILES FROM TOWN (enter 0 if in town) 1	
OWNER INFORMATION Last Name WILLIS Owner ELBANE DREMPIS 36 3728 SPRING FALLES CT 55 Town ELLICOTT CITY MD 76 Zip 21046		B 3 DIRECTION OF WELL FROM TOWN (CIRCLE BOX) 	
B 1 Continued DRILLER INFORMATION Driller's Name Ralph Mayne 77 License No. 80 Firm Name Ralph Mayne (well Drilling) Address P.O. Box 9120 Mt. Airy Md. Signature Ralph Mayne 3/18/83 Date		B 4 NEAR WHAT ROAD FARSI Rd. ON WHICH SIDE OF ROAD (CIRCLE APPROPRIATE BOX) NORTH ☐ WEST ☐ EAST ☒ SOUTH ☐ DISTANCE FROM ROAD 100 (CIRCLE APPROPRIATE BOX)	
B 2 WELL INFORMATION APPROX. PUMPING RATE (GAL. PER MIN.) 5 AVERAGE DAILY QUANTITY NEEDED (GAL. PER DAY) 500		SHOW MAJOR FEATURES OF BOX & LOCATE WELL WITH AN X SOURCES OF DRILLING WATER 1 well 2 3 WRITE THE BOX NUMBER FROM THE MAP HERE E 820 3 N 510 5	
USE FOR WATER (CIRCLE APPROPRIATE BOX) ☒ HOME (SINGLE OR DOUBLE HOUSEHOLD UNIT ONLY) ☐ FARMING (LIVESTOCK WATERING & AGRICULTURAL IRRIGATION) ☐ INDUSTRIAL, COMMERCIAL, STATE AND FEDERAL GOV. OTHER (REQUIRES APPROPRIATION PERMIT) ☐ PUBLIC OR PRIVATE WATER COMPANY (REQUIRES APPROPRIATION PERMIT AND STATE HEALTH DEPARTMENT APPROVAL) ☐ TEST, OBSERVATION, MONITORING (MAY REQUIRE APPROPRIATION PERMIT)		DRAW A SKETCH BELOW SHOWING LOCATION OF WELL IN RELATION TO NEARBY TOWNS, AND ROADS, AND GIVE DISTANCE FROM WELL TO NEAREST ROAD JUNCTION. 	
APPROXIMATE DEPTH OF WELL 150 FEET APPROXIMATE DIAMETER OF WELL 6 INCH METHOD OF DRILLING (circle one) ☒ BORED (OR AUGERED) ☐ JETTED ☐ JETTED & DRIVEN ☐ AIR ROTARY ☐ AIR PERCUSSION ☐ ROTARY (HYDRAULIC ROTARY) ☐ CABLE ☐ REVERSE ROTARY ☐ DRIVE POINT other		NOT TO BE FILLED IN BY DRILLER HEALTH DEPARTMENT APPROVAL HOWARD COUNTY NAME A28405 COUNTY NO.	
REPLACEMENT OR DEEPEMED WELLS (CIRCLE APPROPRIATE BOX) ☒ THIS WELL WILL NOT REPLACE AN EXISTING WELL ☐ THIS WELL WILL REPLACE A WELL THAT WILL BE ABANDONED AND SEALED ☐ THIS WELL WILL REPLACE A WELL THAT WILL BE USED AS A STANDBY ☐ THIS WELL WILL DEEPEM AN EXISTING WELL PERMIT NUMBER OF WELL TO BE REPLACED OR DEEPEMED (IF AVAILABLE)		OEP SIGNATURE Frank Shinn DATE ISSUED 032283 NORTH GRID 515 EAST GRID 1823 EXPIRES 092283	
Not to be filled in by driller (OEP USE ONLY) APPROP. PERMIT NUMBER GAP FORCE ES WRITE INITIALS IN BOX PERMIT NO. H0-81-0031			
SPECIAL CONDITIONS 8-63			

LAURELOAK CT

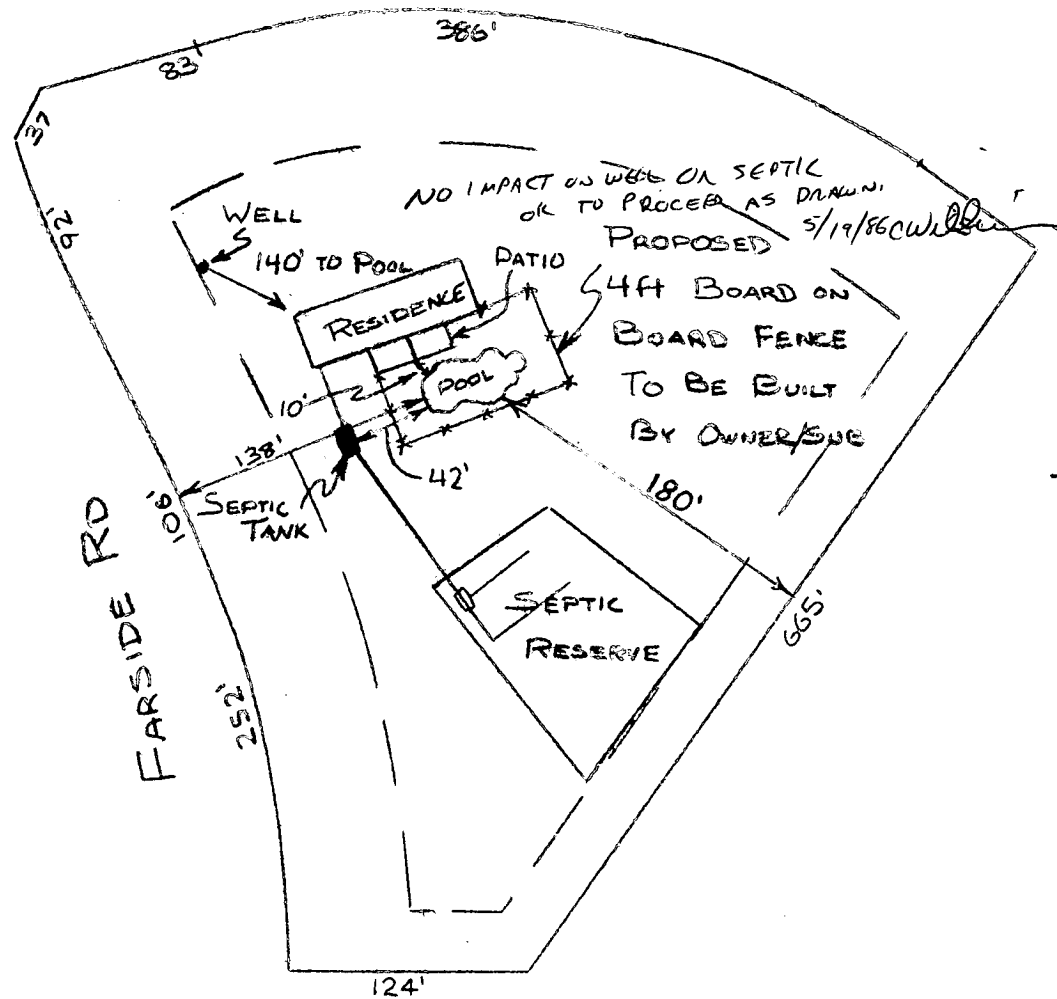

FAR SIDE
LOT 19-24 & 27-29
PLAT 4407
SHEET 3 of 10
3RD ELECTION DISTRICT
HOWARD COUNTY
MARYLAND

WALK-THRU BUILDING PERMIT
28402


BP# 150538

A# 28405

APP. SAN

28905
DATE: 9/30/04

APP. SAN RTS
DESC. OF WORK: DECK

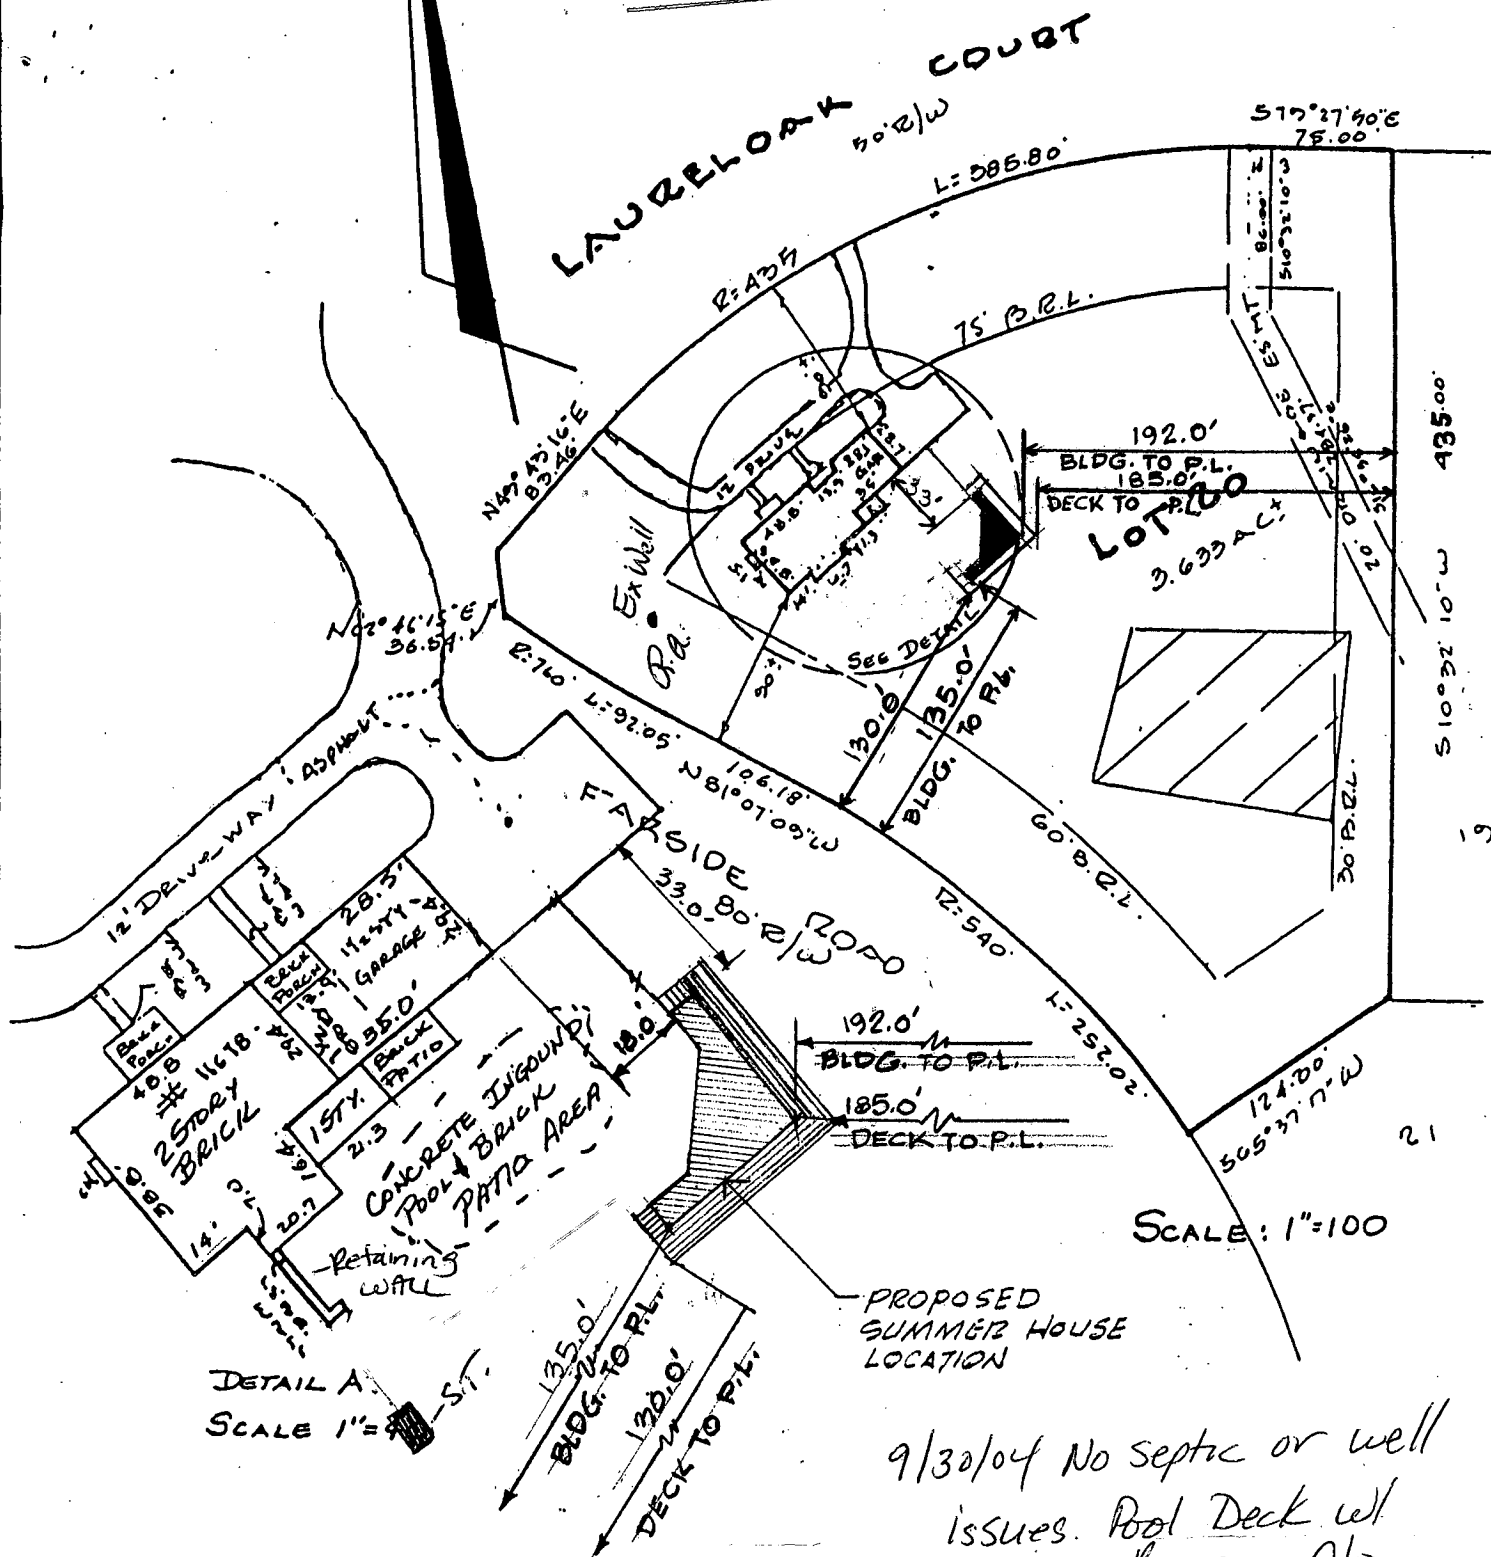

LOCATION SURVEY PLAT

9/30/04 No septic or well
issues. Pool Deck w/
changing Room - No
plumbing

KN