

PERMIT

SEWAGE DISPOSAL SYSTEM

MARYLAND STATE DEPARTMENT OF HEALTH

COUNTY

09-341465

INDEX

ELLICOTT CITY

DISTRICT 4th

DATE Sept. 2, 1982

Paul Schissler

IS PERMITTED TO INSTALL ☒ ALTER ☐

ADDRESS 7311 Brangles Road, Marriottsville, Md. 21104 PHONE 795-2642

SUBDIVISION Country Side ROAD 3559 Countryside Dr. LOT 9

PROPERTY OWNER Frayda Glass

ADDRESS 11920 Beltsville Dr., Apt 13, Beltsville, Md. 20705

SPECIFICATIONS 3 Bedrooms

SEPTIC TANK CAPACITY 1000 GALLONS

DRAIN FIELD DEPTH FEET, BOTTOM AREA SQ. FT.

DEEP TRENCH DEPTH FEET, BOTTOM AREA SQ. FT.

SEEPAGE PITS ABSORBENT SIDE-WALL AREA SQ. FT.

INLET PIPE FT. BELOW ORIGINAL GRADE. MAXIMUM DEPTH FT. BELOW ORIGINAL GRADE

EFFECTIVE DEPTH AT FT. BELOW ORIGINAL GRADE.

LOCATE DISPOSAL AREA FT. FROM LOT LINE AND FT. FROM LOT LINE AS SEEN WHEN

FACING LOT FROM

Trenches to be 3' wide. Inlet to be 3' below original grade and effective absorbant area from 3' - 5' only. Max. Depth of trenches to be 5' below original grade. A minimum of 158' sq. ft. effective bottom area per bedroom needed. Trenches can not exceed 100' in length. Distribution box to be used if more than 1 trench used. Two inspections of trenches required - before and after stone installed. If more than 1 trench used - need to have 15 ft. distance between trench center to center. Run trenches on contour and/or on level ground as much as possible. Start trenches at a point - 30' from the left side line and 250' from the rear lot line or seen when facing the lot from Countryside Dr.

PLANS APPROVED BY Frank Skinner DATE September 2, 1982

COVER NO WORK UNTIL INSPECTED AND APPROVED.

NEITHER THE HOWARD COUNTY COUNCIL NOR THE HEALTH DEPARTMENT IS RESPONSIBLE FOR THE SUCCESSFUL OPERATION OF ANY SYSTEM.

NOTE: IF TRENCH IS USED CALL FOR INSPECTION BEFORE PLACING GRAVEL IN TRENCH.

NOTE: NO DRY WELL SHALL EXCEED 15 FOOT IN DIAMETER.

NOTE: ALL PIPE FROM HOUSE TO DISPOSAL AREA MUST BE CAST IRON.

PERMIT VOID AFTER THREE YEARS.

NOTE: INSTALL STAND PIPE ON SEPTIC TANK AND DRY WELL. STAND PIPES MUST BE 6 INCHES IN DIAMETER. CAST IRON, CONCRETE OR TERRA COTTA ACCEPTED.

*INSTALLER IS RESPONSIBLE FOR OBTAINING FINAL APPROVAL ON THIS PERMIT.

2
158
13
474

140
13
420

18
3/54

BLDG. PERMIT SIGNED

AND RETURNED 4/23/84

Serial # 58357

Donna Bair


BLDG. PERMIT SIGNED

AND RETURNED 4/27/84

Serial # 57683

Lucien Power

EH-2-1079

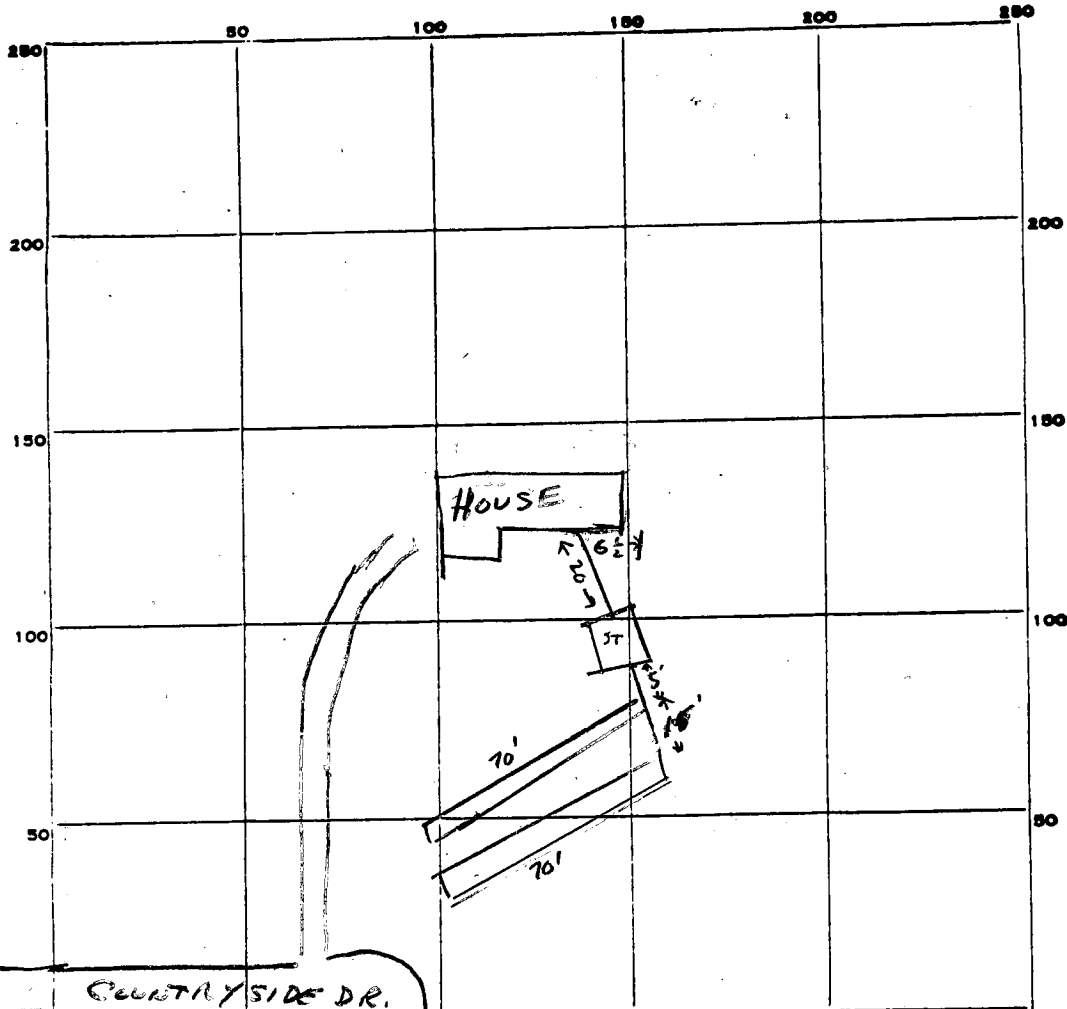

ROUTE
97

PERMIT CARD ☒

SEPTIC TANK, LEVEL ☒

CLEANOUTS ☐

DISTRIBUTION BOX, LEVEL ☐

TILE FIELD, DEPTH 5 FT. TRENCH WIDTH 3 FT.

GRAVEL DEPTH 2 IN. TOTAL LENGTH 160 FT.

NUMBER OF TRENCHES TOTAL BOTTOM AREA

SEEPAGE PITS, INSIDE DIAMETER FT. DEPTH BELOW INLET FT.

ABSORBENT AREA SQ. FT.

REMARKS 2-70' TRENCHES 3 FT WIDE. 11000 S.T. ADD 18' TRENCH + ADD GRAVEL

11000 9-28-82 CW

2-80' TRENCHES 3 FT WIDE. GRAVEL DEPTH 2'

FINISH ADDING GRAVEL. INSTALL PIPE + COVER ALL WORK.

2pm 9-28-82 CW

DATE SYSTEM APPROVED 9-28-82

INSPECTOR C. Williams

Well Permit No. HO - 73-4162
Location of property (road) Countryside Dr.
Subdivision Countryside Lot 9 Block Plat Sec.
Well Driller George Easterday Owner Frayda Glass
Depth of well 120 600 m.
Distance of measuring point (M.P.) above ground 18 2+
Static water level (S.W.L.) below M.P.

Time pump started 12:30 Pumping rate 10 GALS per min
Total time 1 hr 16 min to reach pumping water level 20 ft. below M.P.

[illegible]

APPLICATION

A 28463

P _____

SEWAGE DISPOSAL TESTING

STATE OF MARYLAND - DEPARTMENT OF HEALTH AND MENTAL HYGIENE

DISTRICT 4thDATE 7/11/78HOWARD COUNTY HEALTH DEPARTMENT
ENVIRONMENTAL HEALTH SERVICESP. O. BOX 476, ELLICOTT CITY, MARYLAND 21043
TELEPHONE: 465-5000, EXT. 356

BLDG. PERMIT SIGNED

AND RETURNED 4/3/82Serial # 49804

Garage

BLDG. PERMIT SIGNED

AND RETURNED 4/11/82Serial # 49800 SFO

(C.B. & F.)
2/4/80
Water
Well
Location
criticized
60' +
from
Rear,
540' line

TO: THE COUNTY HEALTH OFFICER
ELLICOTT CITY, MARYLAND

I, HEREBY, APPLY FOR THE NECESSARY TEST IN ORDER TO CONSTRUCT (OR RECONSTRUCT) A SEWAGE DISPOSAL SYSTEM.

PROPERTY OWNER Estate of Sylvan A. Manger Ronca + Frayda GlassADDRESS 11920 Beltsville Dr - Apt 13
Beltsville, Md 20705 PHONE Mr. Rome - 465-1869

PROPERTY LOCATION:

SUBDIVISION Countryside S/D LOT NO. 9ROAD AND DESCRIPTION Route 97 3559 Countryside DriveSIZE OF LOT 3.8 acres TYPE BLDG. 3 or 4 bedrooms
NUMBER OF BEDROOMS

IF NOT SINGLE RESIDENCE DESCRIBE _____

THE SYSTEM INSTALLED UNDER THIS APPLICATION IS ACCEPTABLE ONLY UNTIL PUBLIC FACILITIES BECOME AVAILABLE.

SIGNATURE OF APPLICANT /s/ Bernard RomeAPPROVED BY _____ FOR _____ DATE _____
(KIND OF SYSTEM)REJECTED BY _____ FOR _____ DATE _____
(KIND OF SYSTEM)

HOLD PENDING FURTHER TESTS _____ DATE _____

REASONS FOR REJECTION OR HOLDING 9/7/78 Unsatisfactory & Hold for Review R/H


BLDG. PERMIT SIGNED

AND RETURNED 10/20/83Serial # 50233

farm equip storage

THIS IS NOT A PERMIT

lot # 9

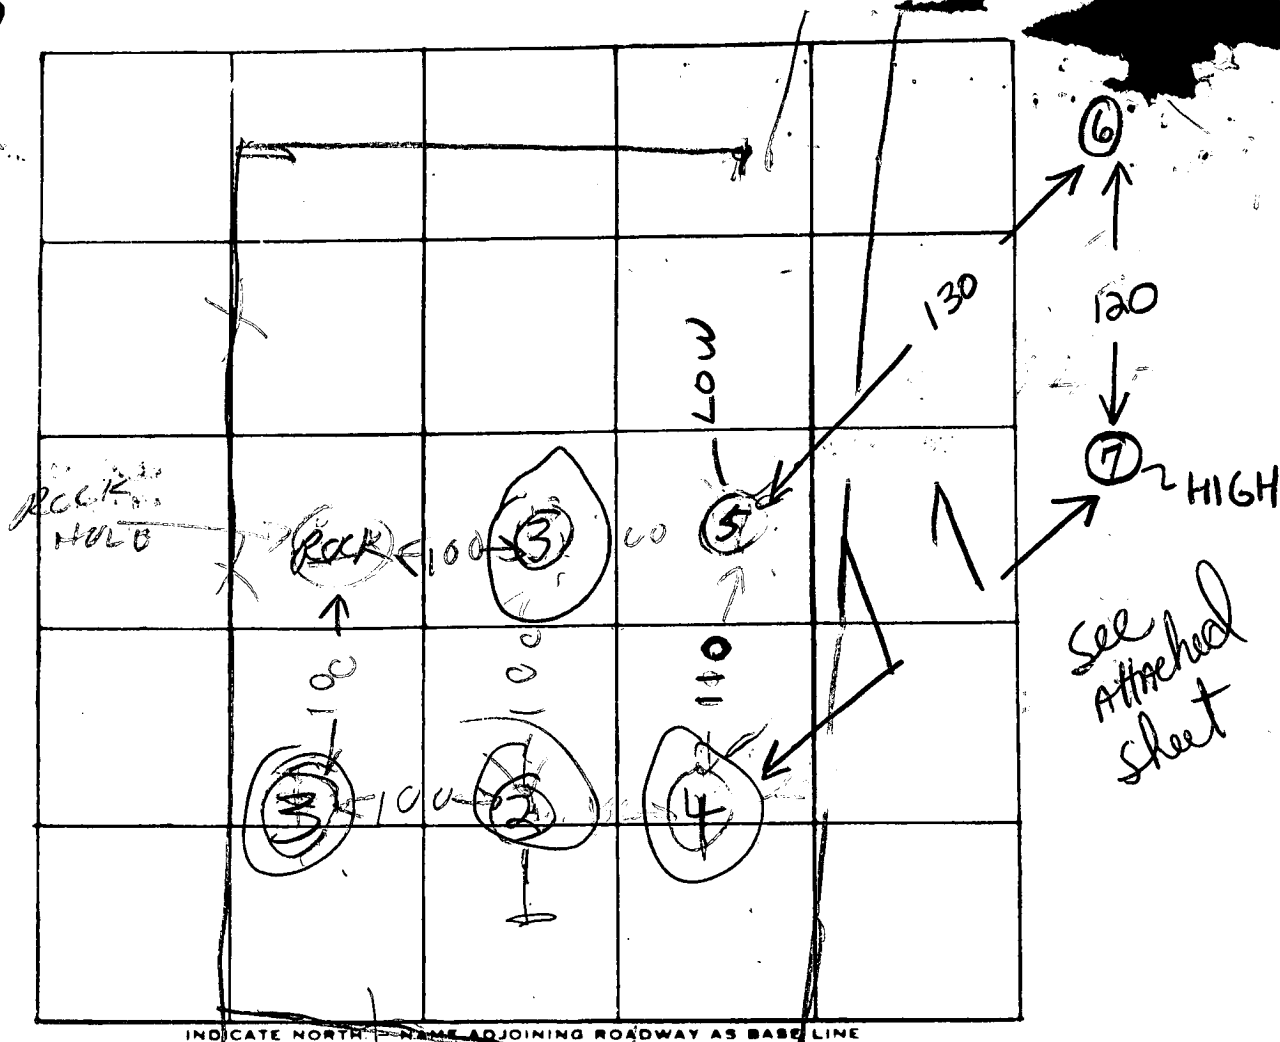

DATE	TEST NO.	DEPTH	PRE-WET		TEST - 1" DROP		TIME
			START	STOP	START	STOP	
9/7/78	1D	9	TOP	5 FT	CLAY	BOTH	SAME
	2D	7	136	157	159	202	5
	2S	3	137	146	140	145	5
	3D	6 1/2	142	147	147	155	8
	3S	3	143	144	144	145	1
	4D	7	206	211	211	225	14
	4S	4	206	210	210	225	15
	3V	11	WATER 8 FT				
	5S	4	217	219	219	222	3
	5D	7	218	223	223	227	4
9/7/78	2V	11	WATER 9 1/2 FT				
REMARKS	4V	11	WATER 11 FT				
TYPE OF SOIL	5V	11	DRY after 15 minutes				

TESTED BY

BH 9

ALSO PRESENT:

ROME
GALLER
LINDRIN

Countrydale

LOT 9


- 2 Feb 79


(GLK) 3 SS

6S	3'	$10^{44} \rightarrow 10^{46}$	$10^{46} \rightarrow 10^{53}$	7
6D	8'	$10^{44} \rightarrow 10^{45}$	$10^{45} \rightarrow 10^{48}$	3
7S	3'	$10^{49} \rightarrow 10^{51}$	$10^{51} \rightarrow 10^{56}$	5
7D - HIGH	8'	$10^{50} \rightarrow 10^{51}$	$10^{51} \rightarrow 10^{53}$	2

5-Low 12' Reopened this date AS VISUAL
low hole of pattern - SANDY LOAM 3' OR

Engineer staked lot 8 - lot 9 lot line shifted
~~and~~ lot 9 $\approx$ 5 Acres

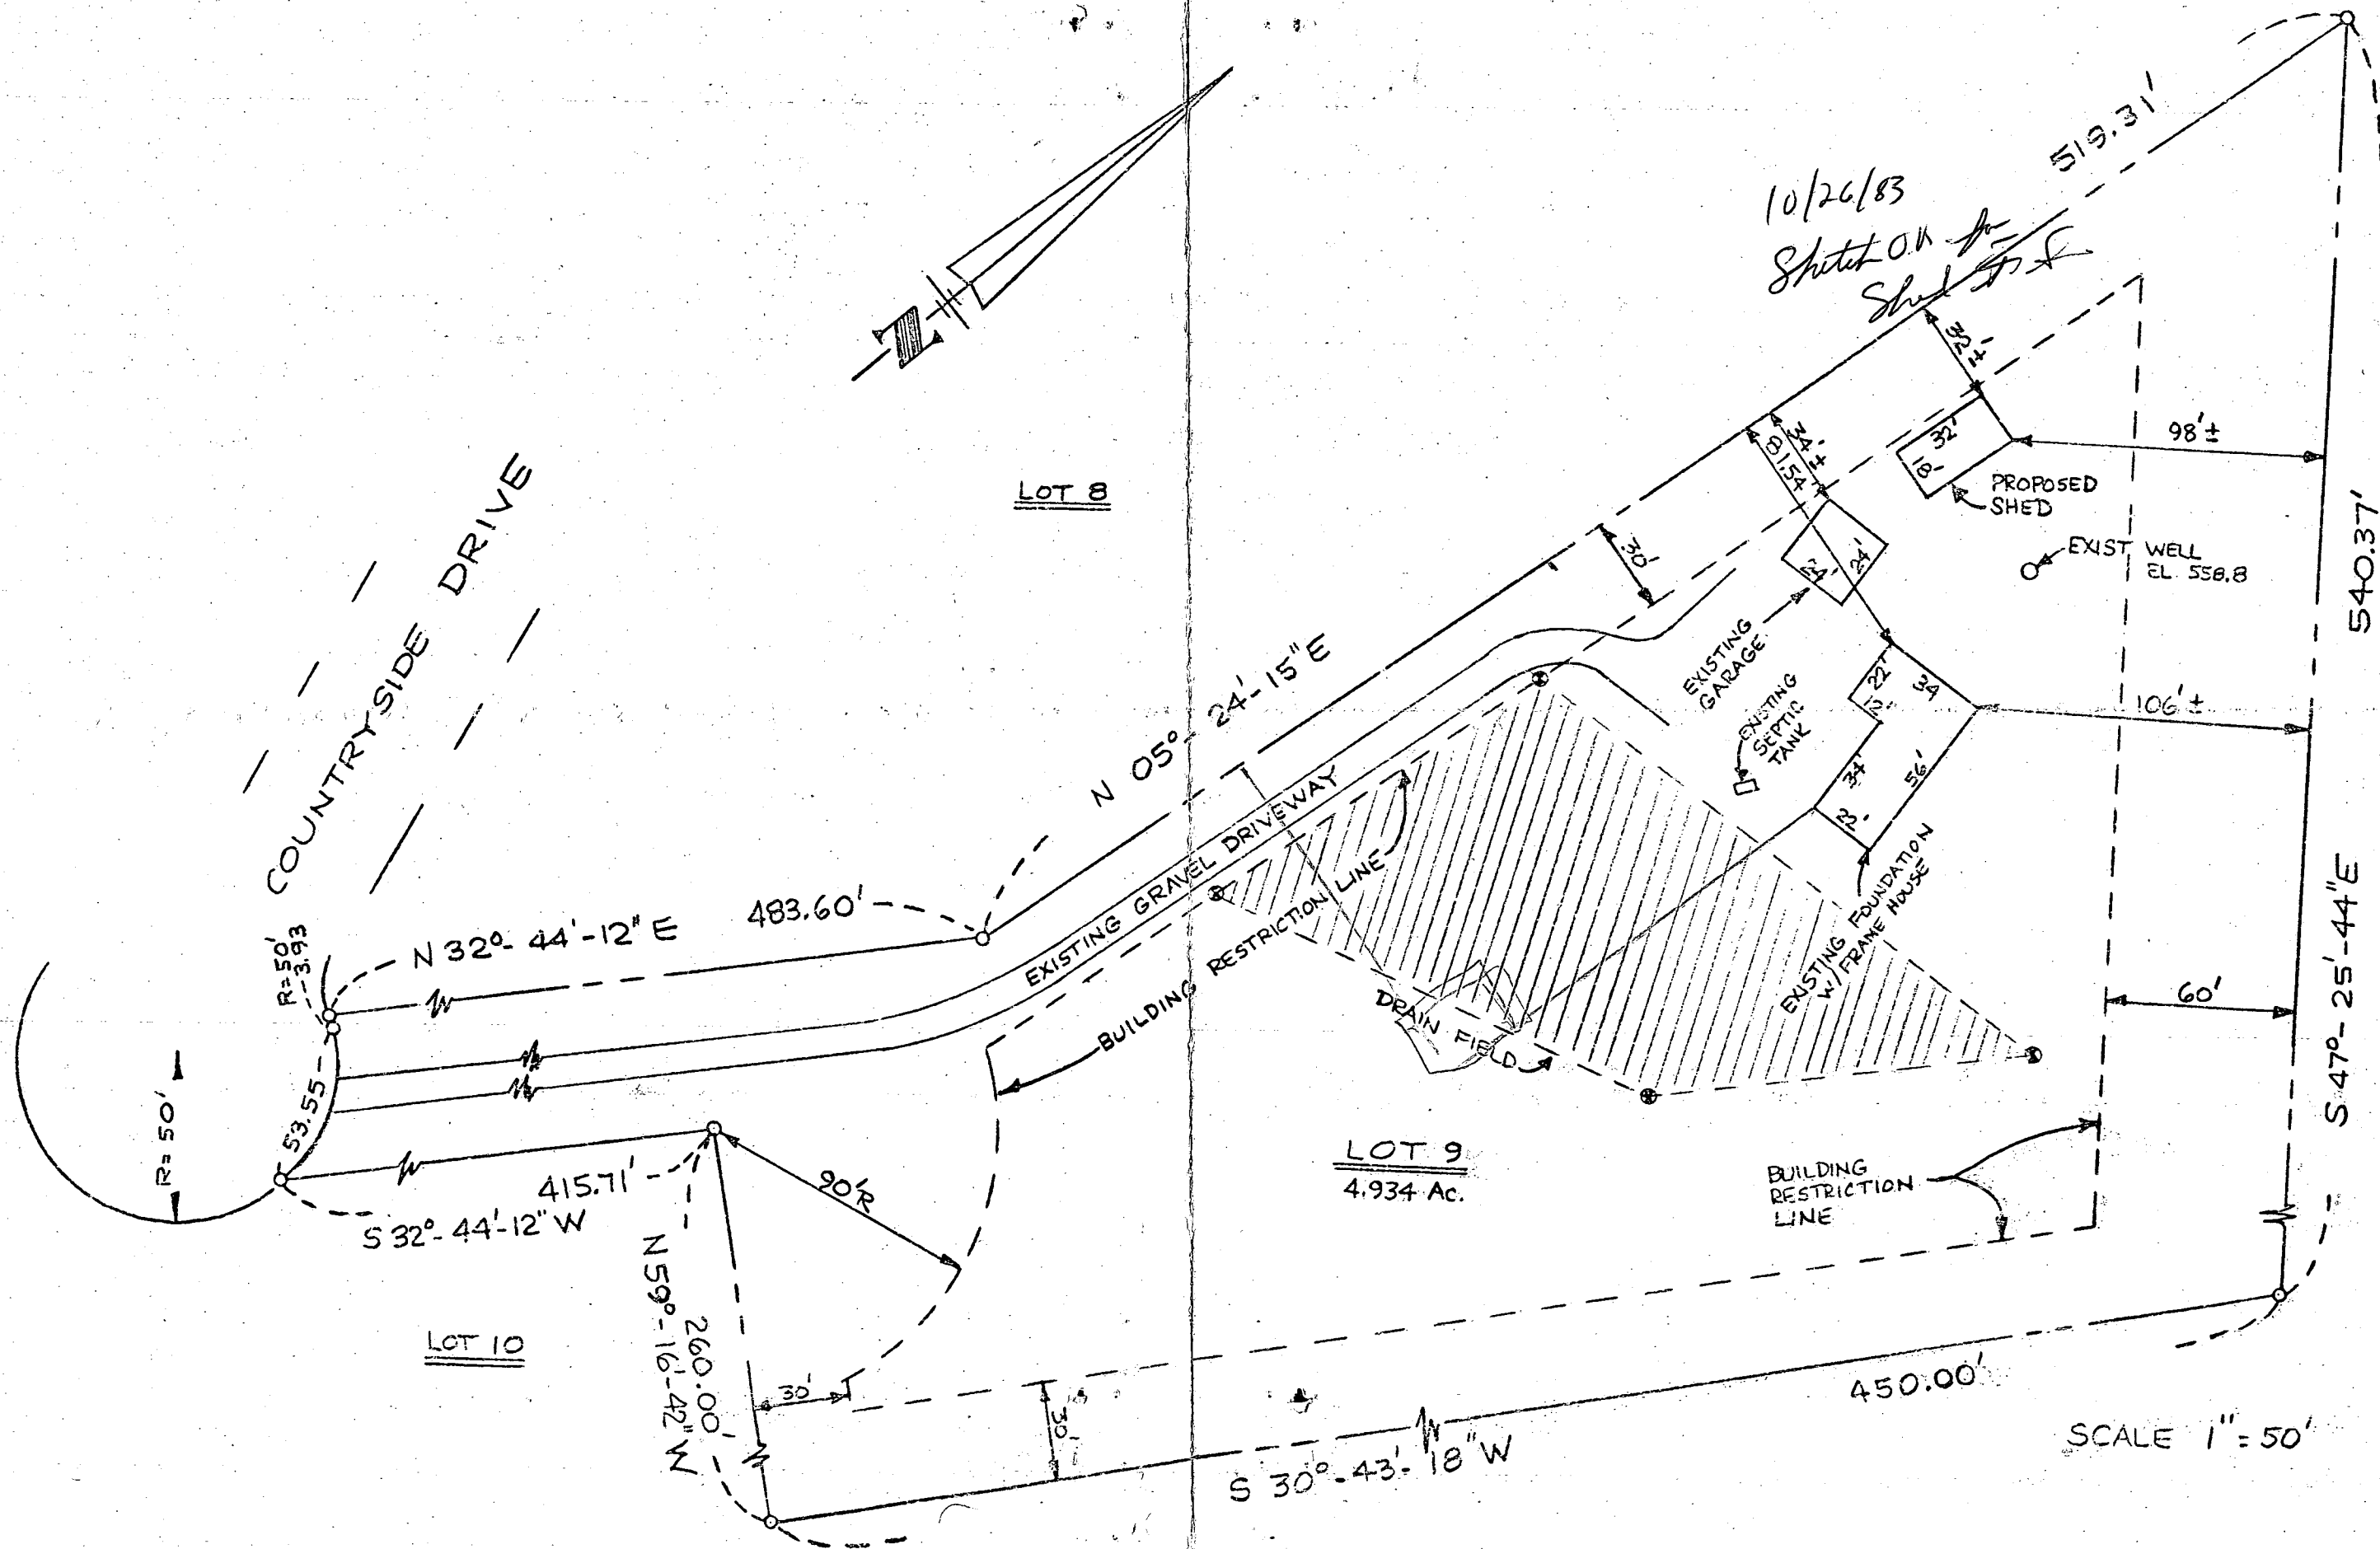

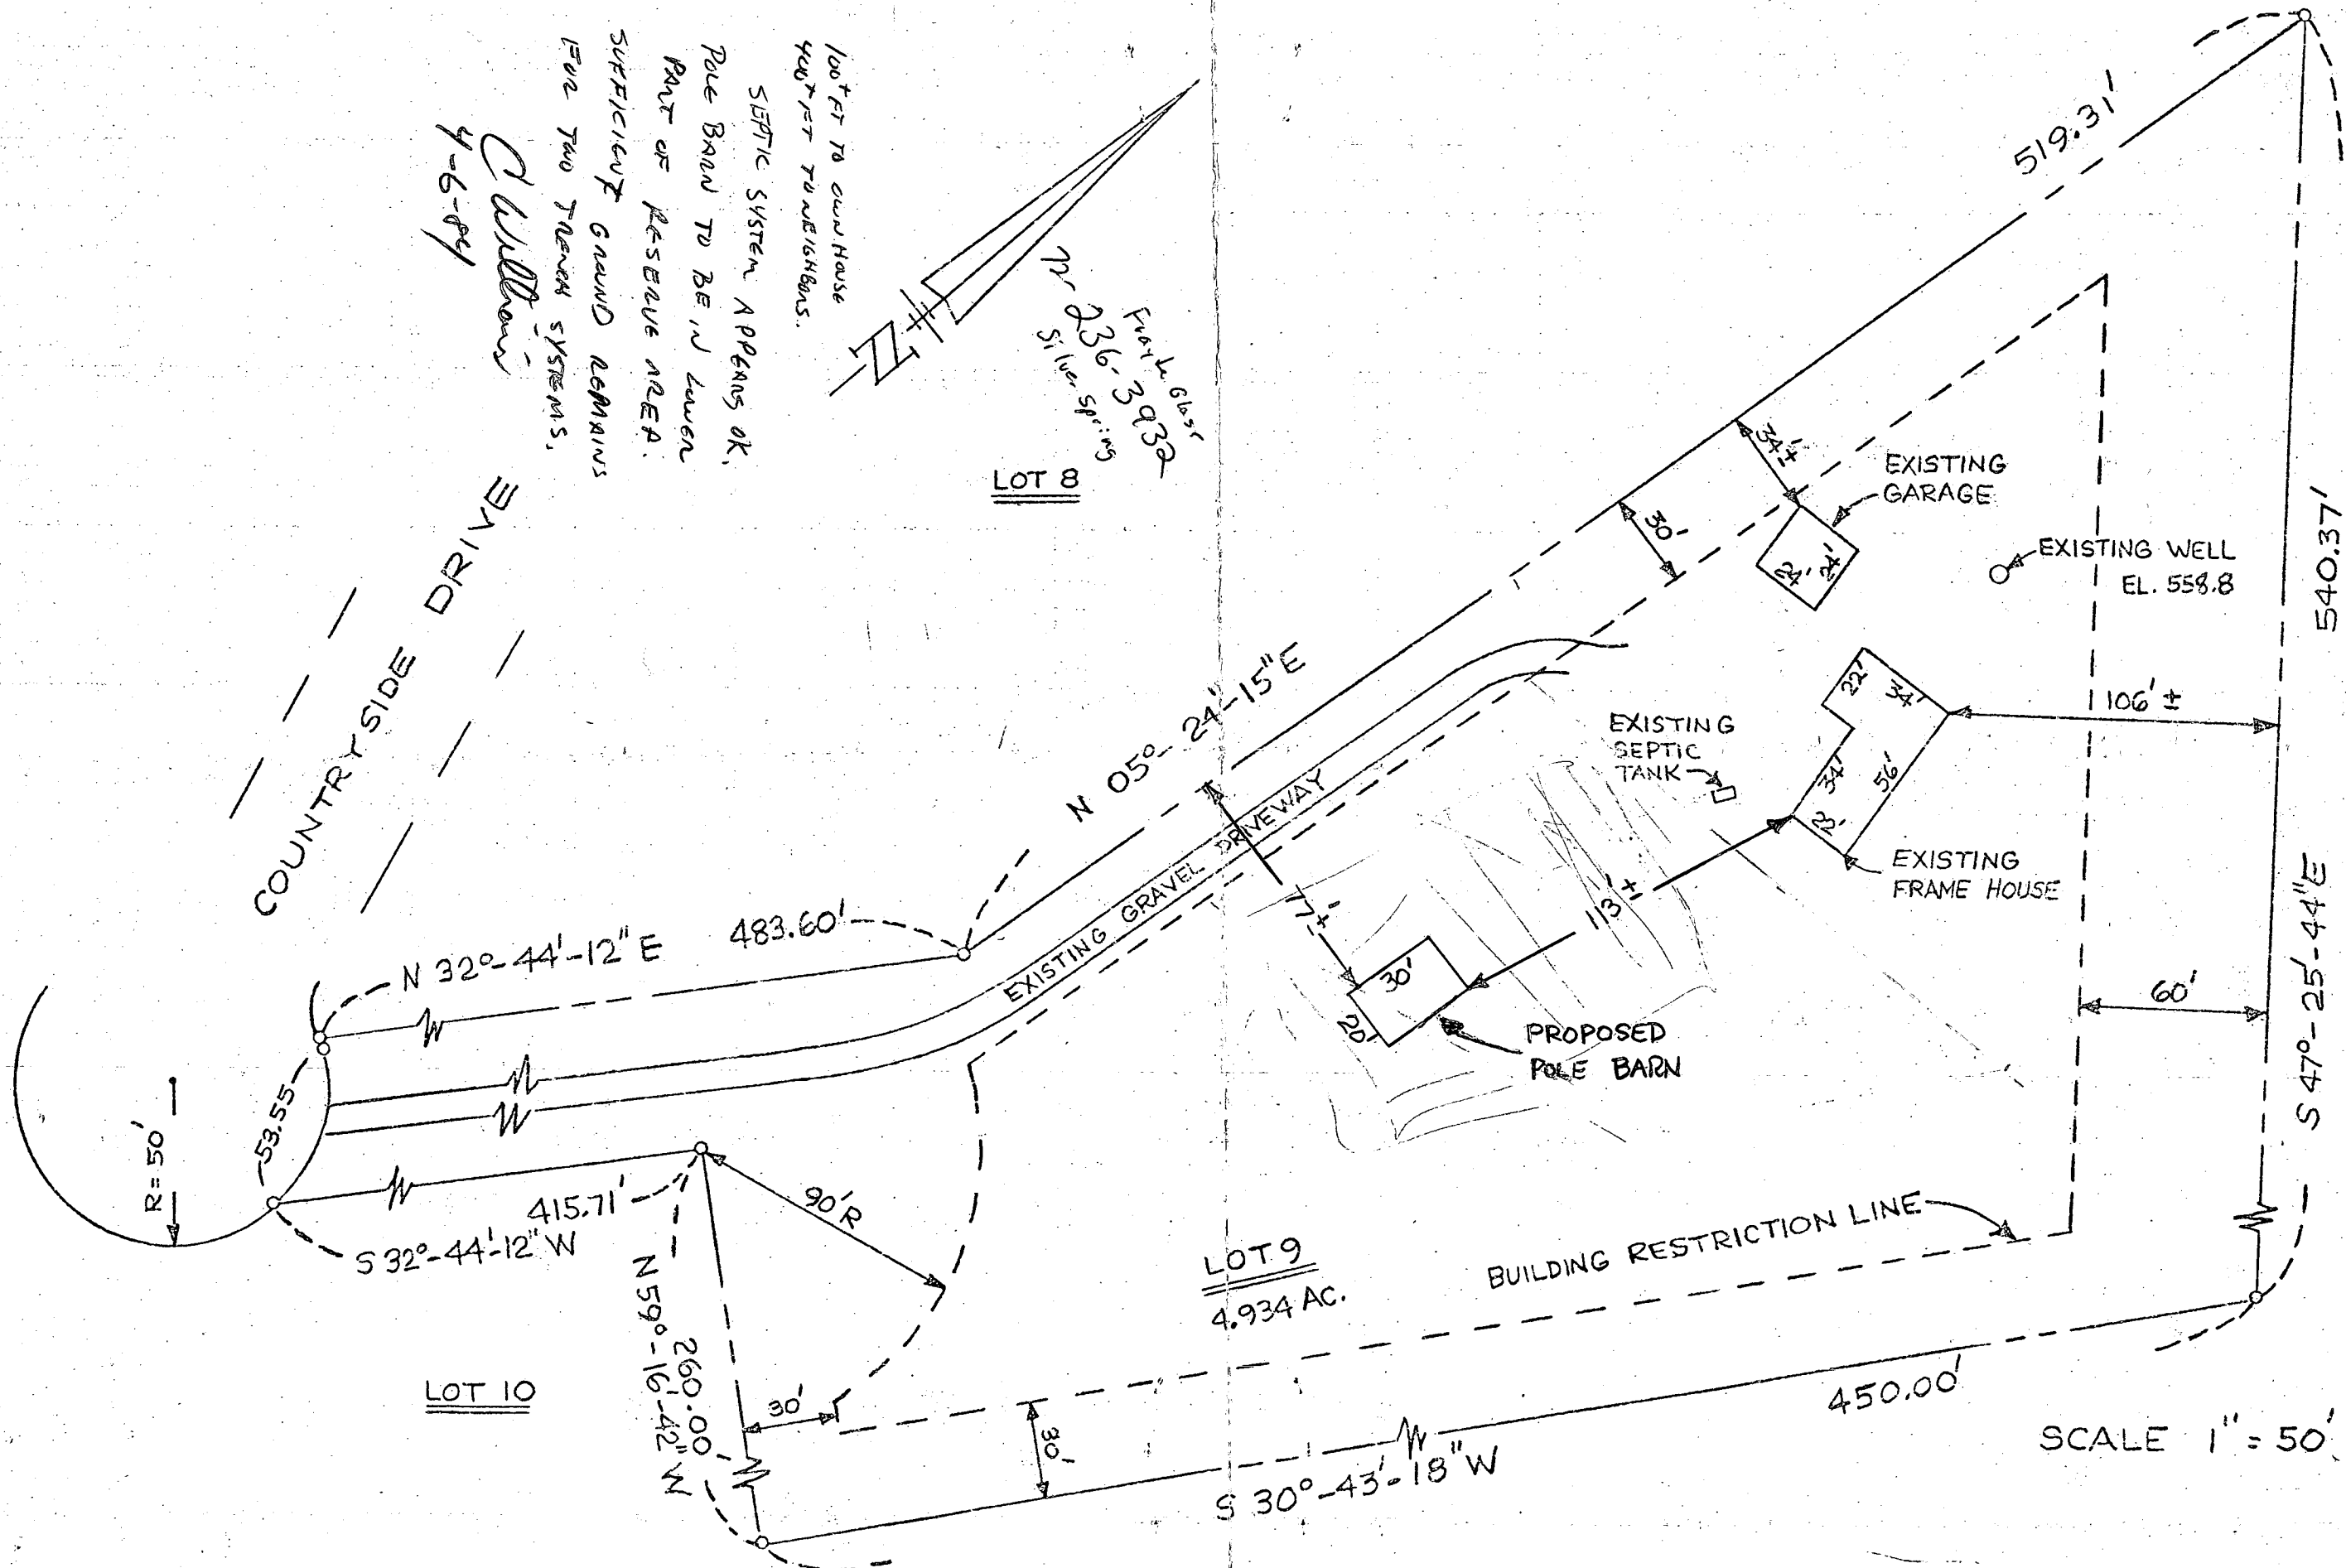


SEPTIC SYSTEM APPEARS OK.
POLE BARN TO BE IN LOWER
PART OF RESERVE AREA.
SUFFICIENT GRASS REMAINS
FOR TWO TRUCK SYSTEMS.

C. Williams
4-6-84

100' FT TO OWN HOUSE
400' FT TO NEIGHBORS.

236.3' from 2032' to 2032'

LOT 8

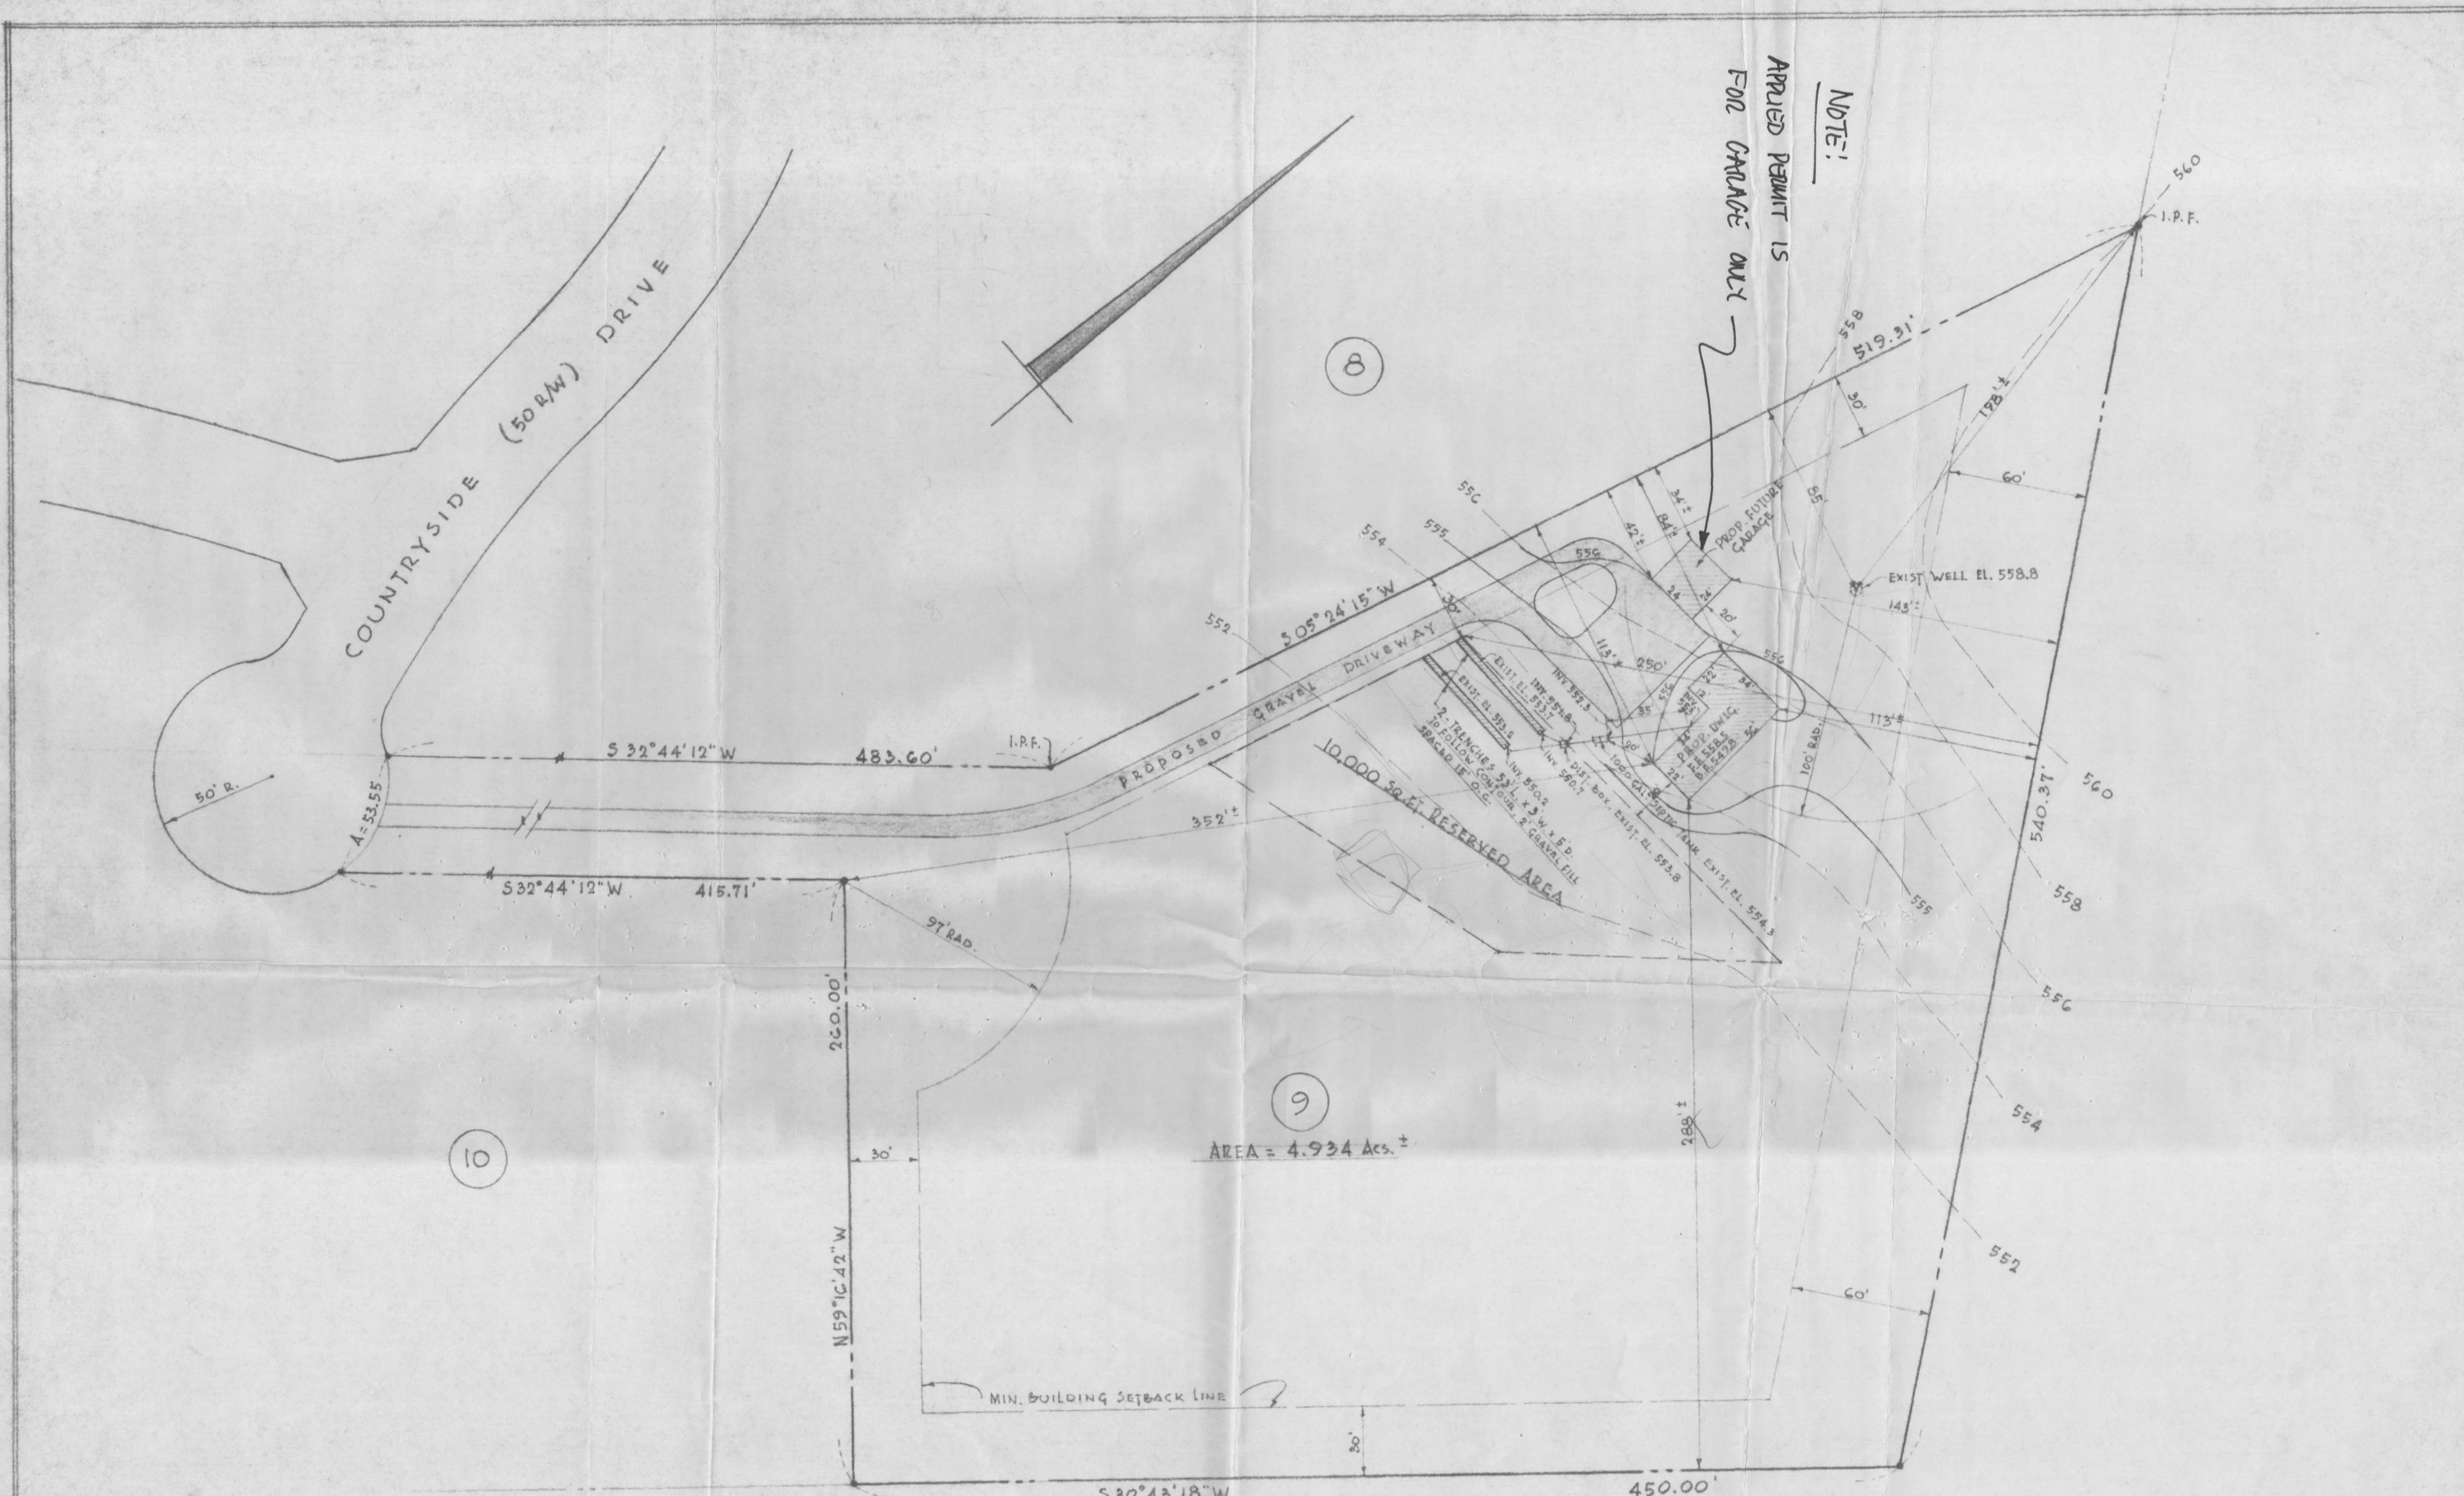

NOTE:

APPROVED PERMIT IS
FOR GARAGE ONLY

8

9

AREA = 4.934 Acs. ±

10

6/3/82 Sketch OK for garage
J.S.

PLOT PLAN

SCALE: 1" = 50'

PROPERTY OF
MR. & MRS. RONALD GLASS
"COUNTRYSIDE"
4th ELECT. DIST., HOWARD COUNTY, MD.

I CERTIFY THE ABOVE MEASUREMENTS AND ELEVATIONS ARE ACTUAL
AND CORRECT FOR THIS PROPERTY.

Gregor L. Vishino

5/26/82 5/12/82 J/L