

6/30/83 - as soon as possible

approved
6-30-83
C. Williams

PERMIT

P 32793

A 29120

SEWAGE DISPOSAL SYSTEM

MARYLAND STATE DEPARTMENT OF HEALTH*

HOWARD COUNTY

BUREAU OF ENVIRONMENTAL HEALTH
992-2330

ELLICOTT CITY

DISTRICT 4th

DATE May 23, 1983

INDEX

Martin G. Knott

IS PERMITTED TO INSTALL ☒ ALTER

ADDRESS 502 Baltimore Ave, Townson, MD 21204 PHONE 821-9595

SUBDIVISION Hoods Mill Farms ROAD 760 MD. Route 97 LOT 1

PROPERTY OWNER Mr. & Mrs. Eng

ADDRESS 805 Pointed Post Ct., Pikesville, MD

IF GARBAGE GRINDER IS USED INCREASE SEPTIC TANK CAPACITY BY 50% AND ABSORPTION AREA BY 22%.

GARBAGE GRINDER? YES NO ☒

SEPTIC TANK CAPACITY 1250 GALLONS NUMBER OF BEDROOMS 4

Tile field 480 sq. ft. Bottom area. Installed ~~3~~ 4ft. deep with 1 1/2 ft. stone.

Start the tile field 185 ft. from the lot line which is 199.85 ft. long & 10 ft. from the lot line which is 383.96 ft. long. Run the ditches along the contour lines away from the lot line which is 383.96 ft. long.

See plans OK to change ditch #3 location a little because of tree R/H 6/1/83 R/H

6-22-83 PERCED TWO NEW HOLES. OK TO START SYSTEM 30' DOWNHILL FROM ORIGINAL SPECS. CHANGE NECESSARY BECAUSE OF ELEVATION OF HOUSE. C. Williams

PLANS APPROVED BY Raymond Hodges

DATE 3/30/79

COVER NO WORK UNTIL INSPECTED AND APPROVED.

NEITHER THE HOWARD COUNTY COUNCIL NOR THE HEALTH DEPARTMENT IS RESPONSIBLE FOR THE SUCCESSFUL OPERATION OF ANY SYSTEM.

NOTE: IF TRENCH IS USED CALL FOR INSPECTION BEFORE AND AFTER PLACING GRAVEL IN TRENCH.

NOTE: NO DRY WELL SHALL EXCEED 15 FOOT IN DIAMETER. NO ABSORPTION TRENCH TO EXCEED 100 FEET IN LENGTH.

NOTE: ALL PIPE FROM HOUSE TO SEPTIC TANK MUST BE CAST IRON OR SCHEDULE 40 PVC OR ABS.

PERMIT VOID AFTER THREE YEARS.


NOTE: INSTALL STAND PIPE ON SEPTIC TANK AND DRY WELL. STAND PIPES MUST BE 6 INCHES IN DIAMETER. CAST IRON, CONCRETE OR TERRA COTTA, OR PVC OR ABS ACCEPTED. IF TOP OF SEPTIC TANK IS DEEPER THAN 3 FEET MANHOLE TO GRADE REQUIRED.

*INSTALLER IS RESPONSIBLE FOR OBTAINING FINAL APROVAL ON THIS PERMIT

*CALL 992-2330 FOR INSPECTION OF SEPTIC SYSTEMS.

EH - 2-1082

A 29120

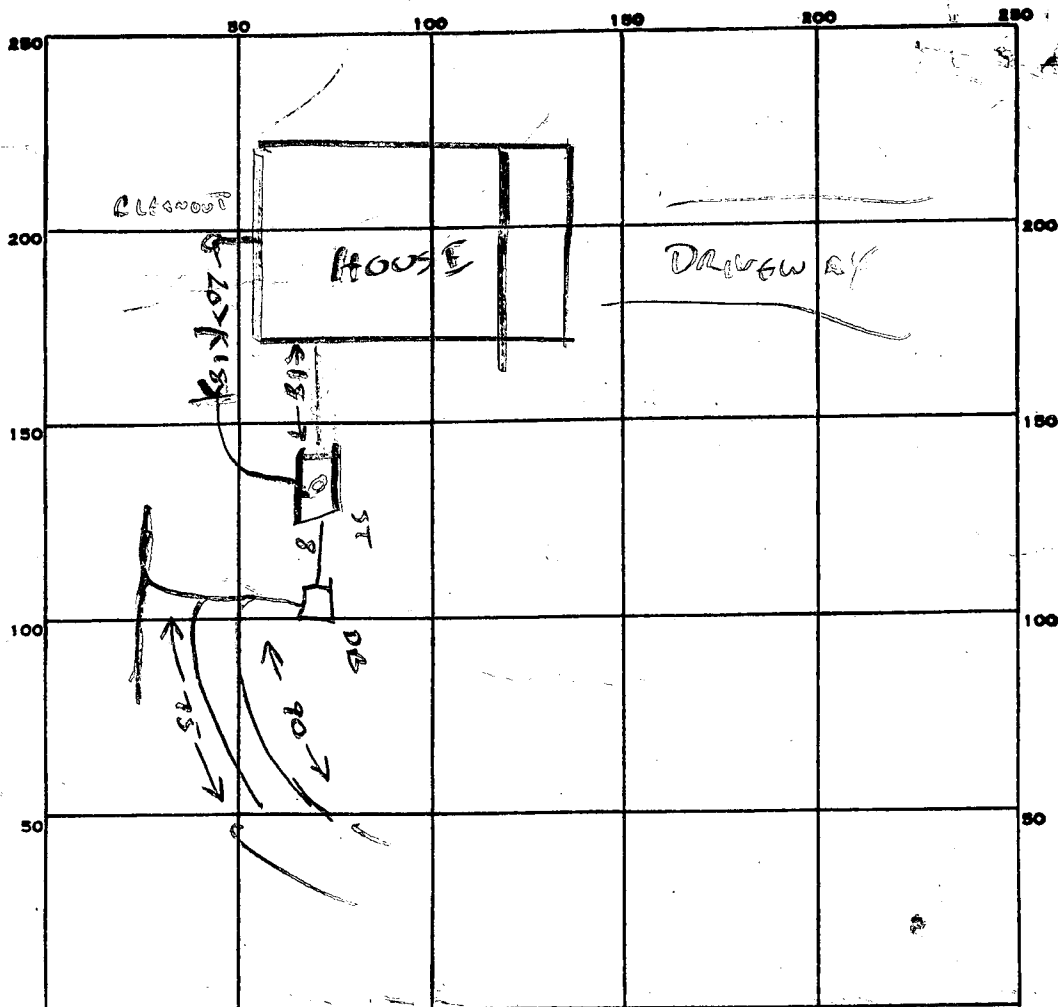

INDICATE NORTH. - NAME ADJOINING ROADWAY AS BASE LINE.

PERMIT CARD ☒

SEPTIC TANK, LEVEL ☒

CLEANOUTS ST ☒ IN LINE ☒

DISTRIBUTION BOX, LEVEL ☒

TILE FIELD, DEPTH _____ FT. TRENCH WIDTH _____ FT.

GRAVEL DEPTH _____ IN. TOTAL LENGTH _____ FT.

NUMBER OF TRENCHES _____ TOTAL BOTTOM AREA _____

SEEPAGE PITS, INSIDE DIAMETER _____ FT. DEPTH BELOW INLET _____ FT.

ABSORBENT AREA _____ SQ. FT.

REMARKS 6/13/83 TRENCH DUG TOO DEEP. REPERC DONE

6-27-83 NEED 30' MORE TRENCH. CALL WHEN GRAVEL ADDED. CW

6-28-83 OK TO COVER 1ST & 2ND TRENCH. CW

6-30-83 OK TO COVER ALL. CW

DATE SYSTEM APPROVED

6-30-83



INSPECTOR

Cullbran

P 32793
A 29120

26
37
45
178

- ① Hole ⑥ is Higher than BOX
- ② BOX IS 5F7 BOG
- ③ Hole ⑦ is a little lower than BOX

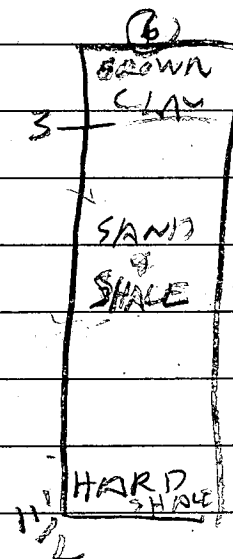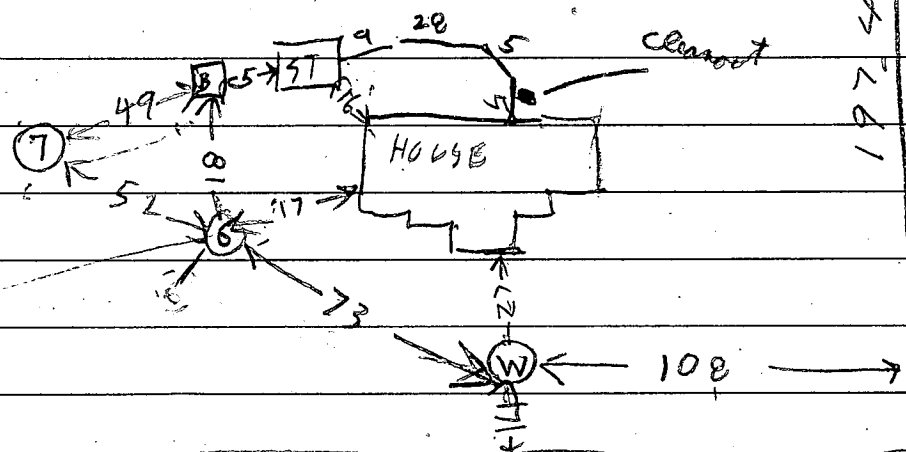

38396

6/13/83	6M	8 1/2	1154	1155	1155	1156	2	⑦
6/13/83	6V	11 1/2	OK except hard bottom				2	BROWN CLAY
	6M	5 1/2	1243	1245	1245	1251	6	BROWN SAND
	7V	10 1/2	OK except hard bottom					
								9 SANDY SHALE
								10 1/2 HARD



also present chuck ashby
Michael ashby
Mr Goelz

Tested by B. Hoelge
OVER

6/13/83 - DISCUSSED WITH FS

He said UNSATSFACTORY
owner may do one of these 3

- ① RETEST LOT
- ② USE PUMP SYSTEM
- ③ USE DOUBLE SYSTEM one for
Basement & one for FIRST
& 2nd FLOOR

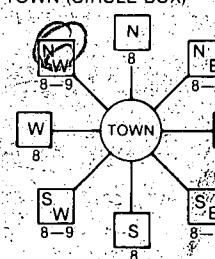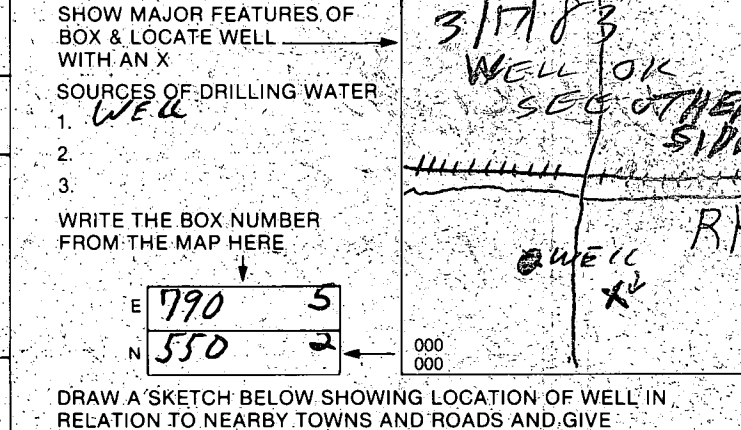B-1 1160 SEQUENCE NO. (OEP USE ONLY) (THIS NUMBER IS TO BE PUNCHED IN S.S. 3-6 ON ALL CARDS) Date Received 3/17/83 1:30 PM OWNER INFORMATION 8 83 13 15-Last Name ENZ Owner GARY First Name 34 36 805 Kinted Post Ct 55 Street or RFD 57 Pikeville 70 State 72 MD Zip 76 2120	STATE OF MARYLAND PERMIT TO DRILL WELL please print or type B-3 LOCATION OF WELL 8 COUNTY Howard 21 23 SUBDIVISION POODS MILL FARM 42 SECTION 1 44 46 LOT 1 48 50 52 NEAREST TOWN COOKSVILLE 71 MILES FROM TOWN (enter 0 if in town) 3 73 76 77 78 MI	OEP PERMIT NUMBER 40-81-0024 70 fill in this form completely 79
DRILLER INFORMATION Driller's Name Stanley W. Dollinger Jr. 77 License No. 80 308 Firm Name Stan's Well Drilling Inc. Address PO Box 2075 West, Md. 21157 Signature Stanley W. Dollinger Jr. Date 8/11/83	B-4 DIRECTION OF WELL FROM TOWN (CIRCLE BOX) 	NEAR WHAT ROAD MD 97 ON WHICH SIDE OF ROAD (CIRCLE APPROPRIATE BOX)  DISTANCE FROM ROAD 400 ENTER FT or MI FT
B-2 WELL INFORMATION APPROX. PUMPING RATE (GAL. PER MIN.) 5 AVERAGE DAILY QUANTITY NEEDED (GAL. PER DAY) 500	USE FOR WATER (CIRCLE APPROPRIATE BOX) ☒ HOME (SINGLE OR DOUBLE HOUSEHOLD UNIT ONLY) ☐ FARMING (LIVESTOCK WATERING & AGRICULTURAL IRRIGATION) ☐ INDUSTRIAL, COMMERCIAL, STATE AND FEDERAL GOV. OTHER (REQUIRES APPROPRIATION PERMIT) ☐ PUBLIC OR PRIVATE WATER COMPANY (REQUIRES APPROPRIATION PERMIT AND STATE HEALTH DEPARTMENT APPROVAL) ☐ TEST, OBSERVATION, MONITORING (MAY REQUIRE APPROPRIATION PERMIT)	
APPROXIMATE DEPTH OF WELL 165 FEET APPROXIMATE DIAMETER OF WELL 6 INCH METHOD OF DRILLING (circle one) BORED (or Augered) JETTED Jetted & DRIVEN 30: AIR-ROTary AIR-PERCussion ROTARY (Hydraulic Rotary) 37 CABLE Reverse-ROTary Drive-POINT other	NOT TO BE FILLED IN BY DRILLER HEALTH DEPARTMENT APPROVAL HOWARD COUNTY NAME OEP SIGNATURE Frank Sheena COUNTY NO. A29120 DATE ISSUED 03/14/83 STATE HEALTH INSERT S CO SIGNATURE Frank Sheena EXP. DATE 9/14/83 NORTH GRID 552000 EAST GRID 0795000	
REPLACEMENT OR DEEPEMED WELLS (CIRCLE APPROPRIATE BOX) ☒ THIS WELL WILL NOT REPLACE AN EXISTING WELL ☐ THIS WELL WILL REPLACE A WELL THAT WILL BE ABANDONED AND SEALED 39 ☐ THIS WELL WILL REPLACE A WELL THAT WILL BE USED AS A STANDBY ☐ THIS WELL WILL DEEPEMED AN EXISTING WELL PERMIT NUMBER OF WELL TO BE REPLACED OR DEEPEMED (IF AVAILABLE) 41	SHOW MAJOR FEATURES OF BOX & LOCATE WELL WITH AN X SOURCES OF DRILLING WATER 1. WELL 2. 3. WRITE THE BOX NUMBER FROM THE MAP HERE  DRAW A SKETCH BELOW SHOWING LOCATION OF WELL IN RELATION TO NEARBY TOWNS AND ROADS AND GIVE DISTANCE FROM WELL TO NEAREST ROAD JUNCTION WELL 800' MD 97 PATAPSCO RIVER B+O RR	
Not to be filled in by driller (OEP USE ONLY) APPROP. PERMIT NUMBER GAP FORCE FS WRITE INITIALS PERMIT NO. 40-81-0024 67 68 IN BOX 70 71 72 73 74 75 76 77 78 79		
SPECIAL CONDITIONS		

3/17/83

- (1) LOCATION PROBABLY OK
- (2) 40 FT CASING 1 FT OUT OF GROUND
- (3) 30 FT OPEN HOLE
- (4) WELL 165 FT DEEP
- (5) PUMP TEST WATER SAMPLE TODAY ALSO
- (6) 6 BAGS
- (7) WELL OK

RH0176EE

C1 7676

SEQUENCE NO.
(OEP USE ONLY)

STATE OF MARYLAND

WELL COMPLETION REPORT

FILL IN THIS FORM COMPLETELY.
PLEASE PRINT OR TYPETHIS REPORT MUST BE SUBMITTED WITHIN
45 DAYS AFTER WELL IS COMPLETED.COUNTY
NUMBER

A 29120

Date Received
(OEP use only)

DATE WELL COMPLETED

03/17/83

Depth of Well

165

(TO NEAREST FOOT)

PERMIT NO.

FROM "PERMIT TO DRILL WELL"

HD-81-0024

OWNER Ena
last nameGarv
first name

STREET OR RFD

Md Rte 97

TOWN

Cooksville

SUBDIVISION

Hoods Mill Farms

SECTION

LOT

1

WELL LOG

/Not required for driven wells

STATE THE KIND OF FORMATIONS
PENETRATED, THEIR COLOR, DEPTH,
THICKNESS AND IF WATER BEARINGDESCRIPTION (Use
additional sheets if needed)

FEET

Check
if water
bearingTop Soil
Brown Shale
Soft Sandstone
Granite
Granite
Granite
Granite
GraniteFROM TO
0 2
2 8
8 28
38 50
50 54
54 130
130 135
135 165J1
J9

GROUTING RECORD

WELL HAS BEEN GROUTED

(Circle Appropriate Box)

yes

no

TYPE OF GROUTING MATERIAL

CEMENT CM BENTONITE CLAY BC

NO. OF BAGS NO. OF POUNDS

GALLONS OF WATER

DEPTH OF GROUT SEAL (to nearest foot)

from 48 TOP ft to 58 BOTTOM ft
(enter 0 if from surface)

CASING RECORD

casing
types
insert
appropriate
code
below

ST

STEEL

CO

CONCRETE

PL

PLASTIC

OT

OTHER

MAIN
CASING
TYPENominal diameter
(top/main) casing
(nearest inch)Total depth
of main casing
(nearest foot)

ST 6 40

6

40

E
A
C
H
C
A
S
I
N
G

OTHER CASING (if used)

diameter

depth (feet)

inch from to

screen type
or open hole

SCREEN RECORD

insert
appropriate
code
below

ST

STEEL

BR

BRASS

HO

OPEN

BRONZE

HOLE

PL

PLASTIC

OT

OTHER

C2

Seq. no.

E
A
C
H
S
C
R
E
E
N

DEPTH (nearest ft.)

40 39 165

39

165

2 23 24 26 30 32 36

38 39 41 45 47 51

SLOT SIZE

DIAMETER
OF SCREEN(NEAREST
INCH)

GRAVEL PACK

IF WELL DRILLED WAS

FLOWING WELL CIRCLE BOX

F

OEP USE ONLY

(NOT TO BE FILLED IN BY DRILLER)

T

(E.R.O.S.)

W.Q.

70

72

TELESCOPE
CASING

74

75

LOG
INDICATOR

76

77

OTHER DATA

C 3

Seq. no.

PUMPING TEST

HOURS PUMPED (nearest hour)

PUMPING RATE (gal. per min.
to nearest gal.)

METHOD USED TO

MEASURE PUMPING RATE

WATER LEVEL (distance from land surface)

BEFORE PUMPING

WHEN PUMPING

TYPE OF PUMP USED (for test)

A air

P piston

T turbine

C centrifugal

R rotary

J jet

S submersible

O other (describe below)

PUMP INSTALLED

DRILLER WILL INSTALL PUMP
(CIRCLE APPROPRIATE BOX)IF DRILLER INSTALLS PUMP, THIS SECTION
MUST BE COMPLETED FOR ALL WELLS
EXCEPT HOME USETYPE OF PUMP (WRITE APPROPRIATE
LETTER IN BOX - SEE ABOVE
(A, C, J, P, R, S, T, O))

CAPACITY

GALLONS PER MINUTE

(to nearest gallon)

PUMP HORSE POWER


PUMP COLUMN LENGTH (nearest ft.)

CASING HEIGHT (Circle appropriate box
and enter casing height)

above

below

LOCATION OF WELL ON LOT

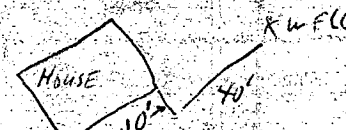SHOW PERMANENT STRUCTURE SUCH AS
BUILDING, SEPTIC TANKS, AND/OR
LANDMARKS AND INDICATE NOT LESS
THAN TWO DISTANCES
(MEASUREMENTS TO WELL)

Location of property (road) Md. Rte 97
Subdivision Hoods Mill Farms Lot 1 Block — Plat — Sec. —
Well Driller Stanley Bullinger Owner Gary Eng


Depth of well 165'
Distance of measuring point (M.P.) above ground 1'
Static water level (S.W.L.) below M.P. 54'

Time pump started 1100 Pumping rate 10 GPM
Total time 15 Min. to reach pumping water level 65' ft. below M.P.

[illegible]

OWNER: Mr. & Mrs. JOHN A. FISHER
6829 C RIVERDALE ROAD #2
RIVERDALE, MD. 20840
301-577-8191

NEW PLAT TO BE
SUBMITTED

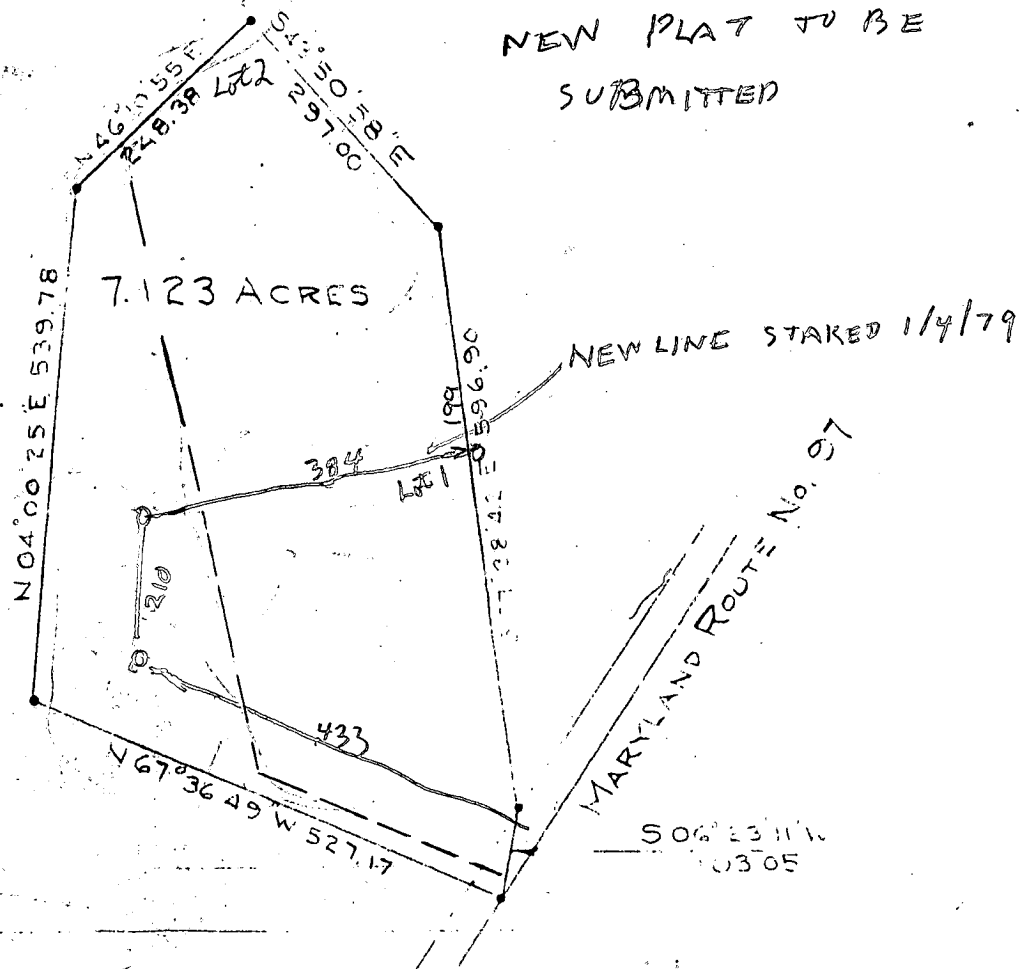

PLAT OF SURVEY
FOR
HOODS MILL FARMS
FOURTH ELECTION DIST. HOWARD COUNTY
WOODBINE, MARYLAND.
SCALE: 1" = 200 FT. MAY 23, 1973

Note: The lot shown hereon complies with the
minimum ownership and lot area as required
by the Maryland State Health Department.

Approved: Private Water & Private Sewer

APPLICATION

SYSTEM FIRST

SEWAGE DISPOSAL TESTING

STATE OF MARYLAND - DEPARTMENT OF HEALTH AND MENTAL HYGIENE

A 29120

P

HOWARD COUNTY HEALTH DEPARTMENT
ENVIRONMENTAL HEALTH SERVICES

P.O. BOX 476 ELLICOTT, MARYLAND 21043

TELEPHONE: 992-2330

TILE FILED 480 SP F7

BOTTOM AREA

DISTRICT 4th

INSTALLED 3 TO 4 FT

DATE 10/31/78

DEEP WITH 1/2 FT STONE

STARTING T.F. 185 F7

WHICH IS 199.85 F7 LONG & 10 F7 FROM
THE LOT LINE WHICH IS 383.96 F7 LONG
RUN THE DITCHES ALONG THE CONTOUR LINES

TO: THE COUNTY HEALTH OFFICER
ELLICOTT CITY, MARYLAND

AWAY FROM THE LOT LINE WHICH

IS 383.96 F7 LONG

I HEREBY APPLY FOR THE NECESSARY TEST IN ORDER TO CONSTRUCT (OR RECONSTRUCT) A SEWAGE DISPOSAL SYSTEM.

PROPERTY OWNER Mr. & Mrs. John A. Fisher Mr. & Mrs. Gary G. G.

805 Pointed Post Ct.

ADDRESS 6829C Riverdale Rd., #2, Riverdale, Md. 20840

PHONE 577-8191 484-6072

PROPERTY LOCATION:

442 2288 COSTELLO BUILDERS
Pikesville, Md

SUBDIVISION (Hoods Mill Farms)

LOT NO.

ROAD AND DESCRIPTION 760 Route 97

SIZE OF LOT 7.123 acres m/1 3 AC ±

TYPE BLDG. 4 bedrooms per B.P. 53009

THE SYSTEM INSTALLED UNDER THIS APPLICATION IS ACCEPTABLE ONLY UNTIL PUBLIC FACILITIES BECOME AVAILABLE.

I FULLY UNDERSTAND THE FEE CONNECTED WITH THE FILING OF THIS PERC TEST APPLICATION IS NON-REFUNDABLE UNDER

ANY CIRCUMSTANCES.

BLDG. PERMIT SIGNED

AND RETURNED 11/5/78

Sheet # 53009

SIGNATURE OF APPLICANT

/s/ William Young for Costello Builders

APPROVED BY

FOR

DATE

REJECTED BY

FOR

DATE

HOLD PENDING FURTHER TESTS

DATE

REASONS FOR REJECTION OR HOLDING

11/22/78 - HOLD FOR REVIEW ROCK HOLE TOO FAST

12/5/78 - HOLD FOR REVIEW NATID DM DIG TWO MORE HOLE




TEST FOR DRAIN FIELD CALLED COSTELLO BUILDERS

1/18/79 - HOLD FOR REVIEW WITH DM LOT IS OK
FOR TILE FIELD NO DEEPER THAN 3 FT

THIS IS NOT A PERMIT

ASSUMING CERTIFIED HOLES ARE OK R/H
BOT SYSTEM FIRST CALLED COSTELLO

① SOIL PROFILE

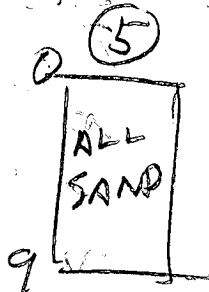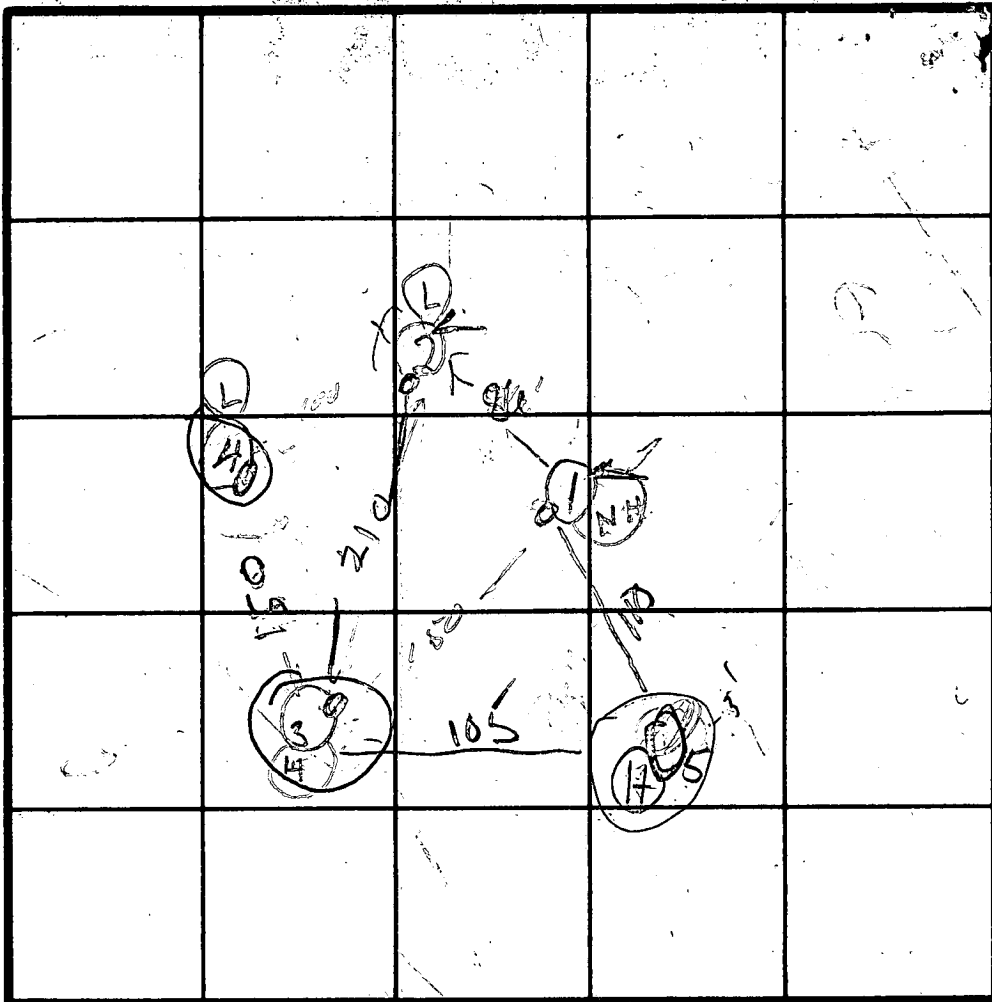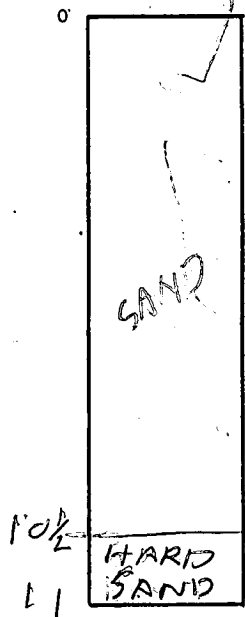

INDICATE NORTH - NAME ADJOINING ROADWAY AS BASE LINE.

ROUTE 97

DATE	TEST NO.	DEPTH	PRE-WET		TEST - 1" DROP		TIME
			START	STOP	START	STOP	
11/22/78	1S	2 1/2	1131	1034	1134	1136	2
	1V	11 1/2	SEE SOIL PROFILE				
	2S	4	1139	1140	1140	1142	2
	2D	13 1/2	1141	1151	1151	1210	19
	3D	11 1/2	1150	1150 1/4	1150 1/4	1150 1/4	15 SEC
	3Drefill	11 1/2	1151	1152	1152	1153	60 SEC
	3S	4	1156	1157	1157	1159	2
	4S	2 1/2	1208	1210	1210	1212	2
	4V	10 1/2	SEE SOIL PROFILE				
	4D	7	1215	1215 1/4	1215 1/4	1215 1/2	15 SEC
	4Drefill	7	1216	1216 1/2	1216 1/2	1217 1/2	60 SEC

REMARKS

11/22/78

TYPE OF SOIL

TESTED BY

BH

ALSO PRESENT



Retest
6/22/83
1:30 p.m.

APPLICATION

SEWAGE DISPOSAL TESTING

STATE OF MARYLAND - DEPARTMENT OF HEALTH AND MENTAL HYGIENE

HOWARD COUNTY HEALTH DEPARTMENT
ENVIRONMENTAL HEALTH SERVICES
P. O. BOX 476 ELLICOTT CITY, MARYLAND 21043
TELEPHONE: 992-2330

A 32862

P _____

DISTRICT 4th

DATE June 16, 1983

TO: THE COUNTY HEALTH OFFICER
ELLICOTT CITY, MARYLAND

I, HEREBY, APPLY FOR THE NECESSARY TEST IN ORDER TO CONSTRUCT (OR RECONSTRUCT) A SEWAGE DISPOSAL SYSTEM.

PROPERTY OWNER Mr. and Mrs. Gary Eng

ADDRESS 805 Pointed Post Court, Pikesville, Md. 21208 PHONE 484-6072

PROPERTY LOCATION:

SUBDIVISION Hoods Mill Farm LOT NO. 1

ROAD AND DESCRIPTION 760 Maryland Route 97

SIZE OF LOT 3 acres more or less TYPE BLDG. 4 bedrooms
(NUMBER OF BEDROOMS)

THE SYSTEM INSTALLED UNDER THIS APPLICATION IS ACCEPTABLE ONLY UNTIL PUBLIC FACILITIES BECOME AVAILABLE. I FULLY UNDERSTAND THE FEE CONNECTED WITH THE FILING OF THIS PERC TEST APPLICATION IS NON-REFUNDABLE UNDER ANY CIRCUMSTANCES. I ALSO AGREE TO COMPLY WITH ALL M.O.S.H.A. REQUIREMENTS IN TESTING THIS LOT. /s/ Robert Gosslein for Mr. and Mrs. Eng
(SIGNATURE OF APPLICANT)

APPROVED BY C. Williams FOR SHALLOW TRENCHES DATE 6-22-83



REJECTED BY _____ FOR _____ DATE _____

HOLD PENDING FURTHER TESTS _____ DATE _____

REASONS FOR REJECTION OR HOLDING _____

THIS IS NOT A PERMIT

1A + 2A

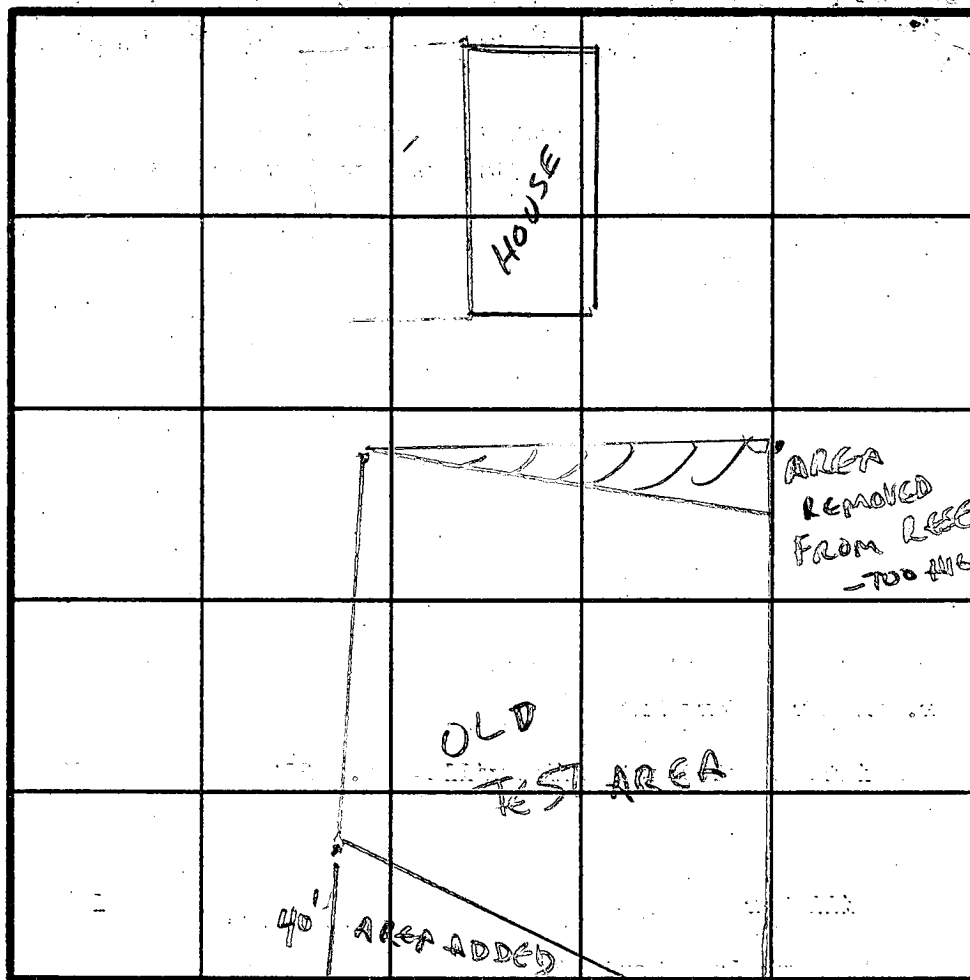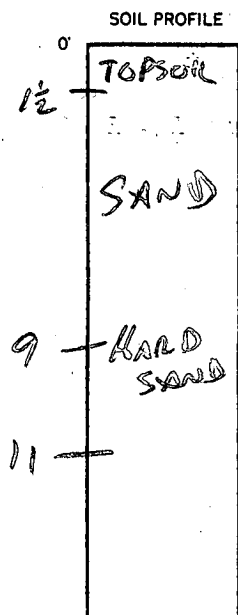

INDICATE NORTH - NAME ADJOINING ROADWAY AS BASE LINE.

DATE	TEST NO.	DEPTH	PRE-WET		TEST - 1" DROP		TIME
			START	STOP	START	STOP	
6-22-83	1 A	3	2:01	2:02	2:02	2:04	2 min
		6	2:01	2:02	2:02	2:04	
		11	SAND - GETTING HARD AT 9'				BUT DIGGABLE
6-22-83	2 A	3	2:07	2:09	2:09	2:11	2 min
		6	2:07	2:08	2:08	2:10	
		11	SAND - SAME AS HOLE 1A				

REMARKS OK FOR SHALLOW SYSTEM

TYPE OF SOIL SAND - HARD 9'-11' BUT DIGGABLE (SHOULD TAKE WATER)

TESTED BY C. W. Quinn ALSO PRESENT BOB GOSLIN

OK TO MOVE
TANK BUT
DISTRIBUTION
TO
HOUSE
SITE
HOUSE 32 F
5/10/93
House already built
297.37
58' 40" E
297.37
5/10/93
RH

HOUSE:

FIRST FLOOR	345.5
BASEMENT	336.5
INVERT	334.43

0
60
150
230
330

0
90
180
270
360

TANK:

EXISTING GRADE	337.5
PROPOSED GRADE	337.5
INVERT IN	334.05
INVERT OUT	333.80

DISTRIBUTION BOX:

EXISTING GRADE	336.2
PROPOSED GRADE	336.2
INVERT	333.70 ✓

TRENCHES:

<u>TRENCHES:</u>	<u>#1</u>	<u>#2</u>	<u>#3</u>	<u>#4</u>
WIDTH	2'	2'	2'	2'
LENTH	40'	60'	70'	30'
STONE	1.5'	1.5'	1.5'	1.5'
INVERT	334.5	332.5	330.5	328.7
BOTTOM	333.0	331.0	329.0	327.2

control line
may be off 6/13/83

LOT 1, NICHOLAS J. FISHER PROP.

4th ELECTION DISTRICT

HOWARD COUNTY MARYLAND


SCALE 1"=50' DATE 12/14/82

certify the above measurements and elevations are actual and true for this property.

J. Carl Hudgins


[illegible]

VICINITY MAP
SCALE: 1" = 1/4 MILE = 2640'
TAX MAP 3, PARCEL 30

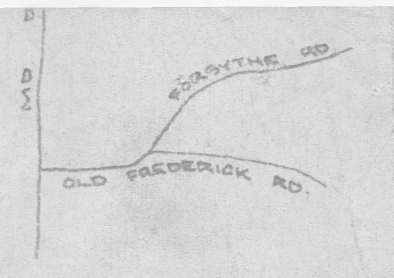

JAMES W. DICKEY
851/138

JOSEPH F. COLLIER
218/526

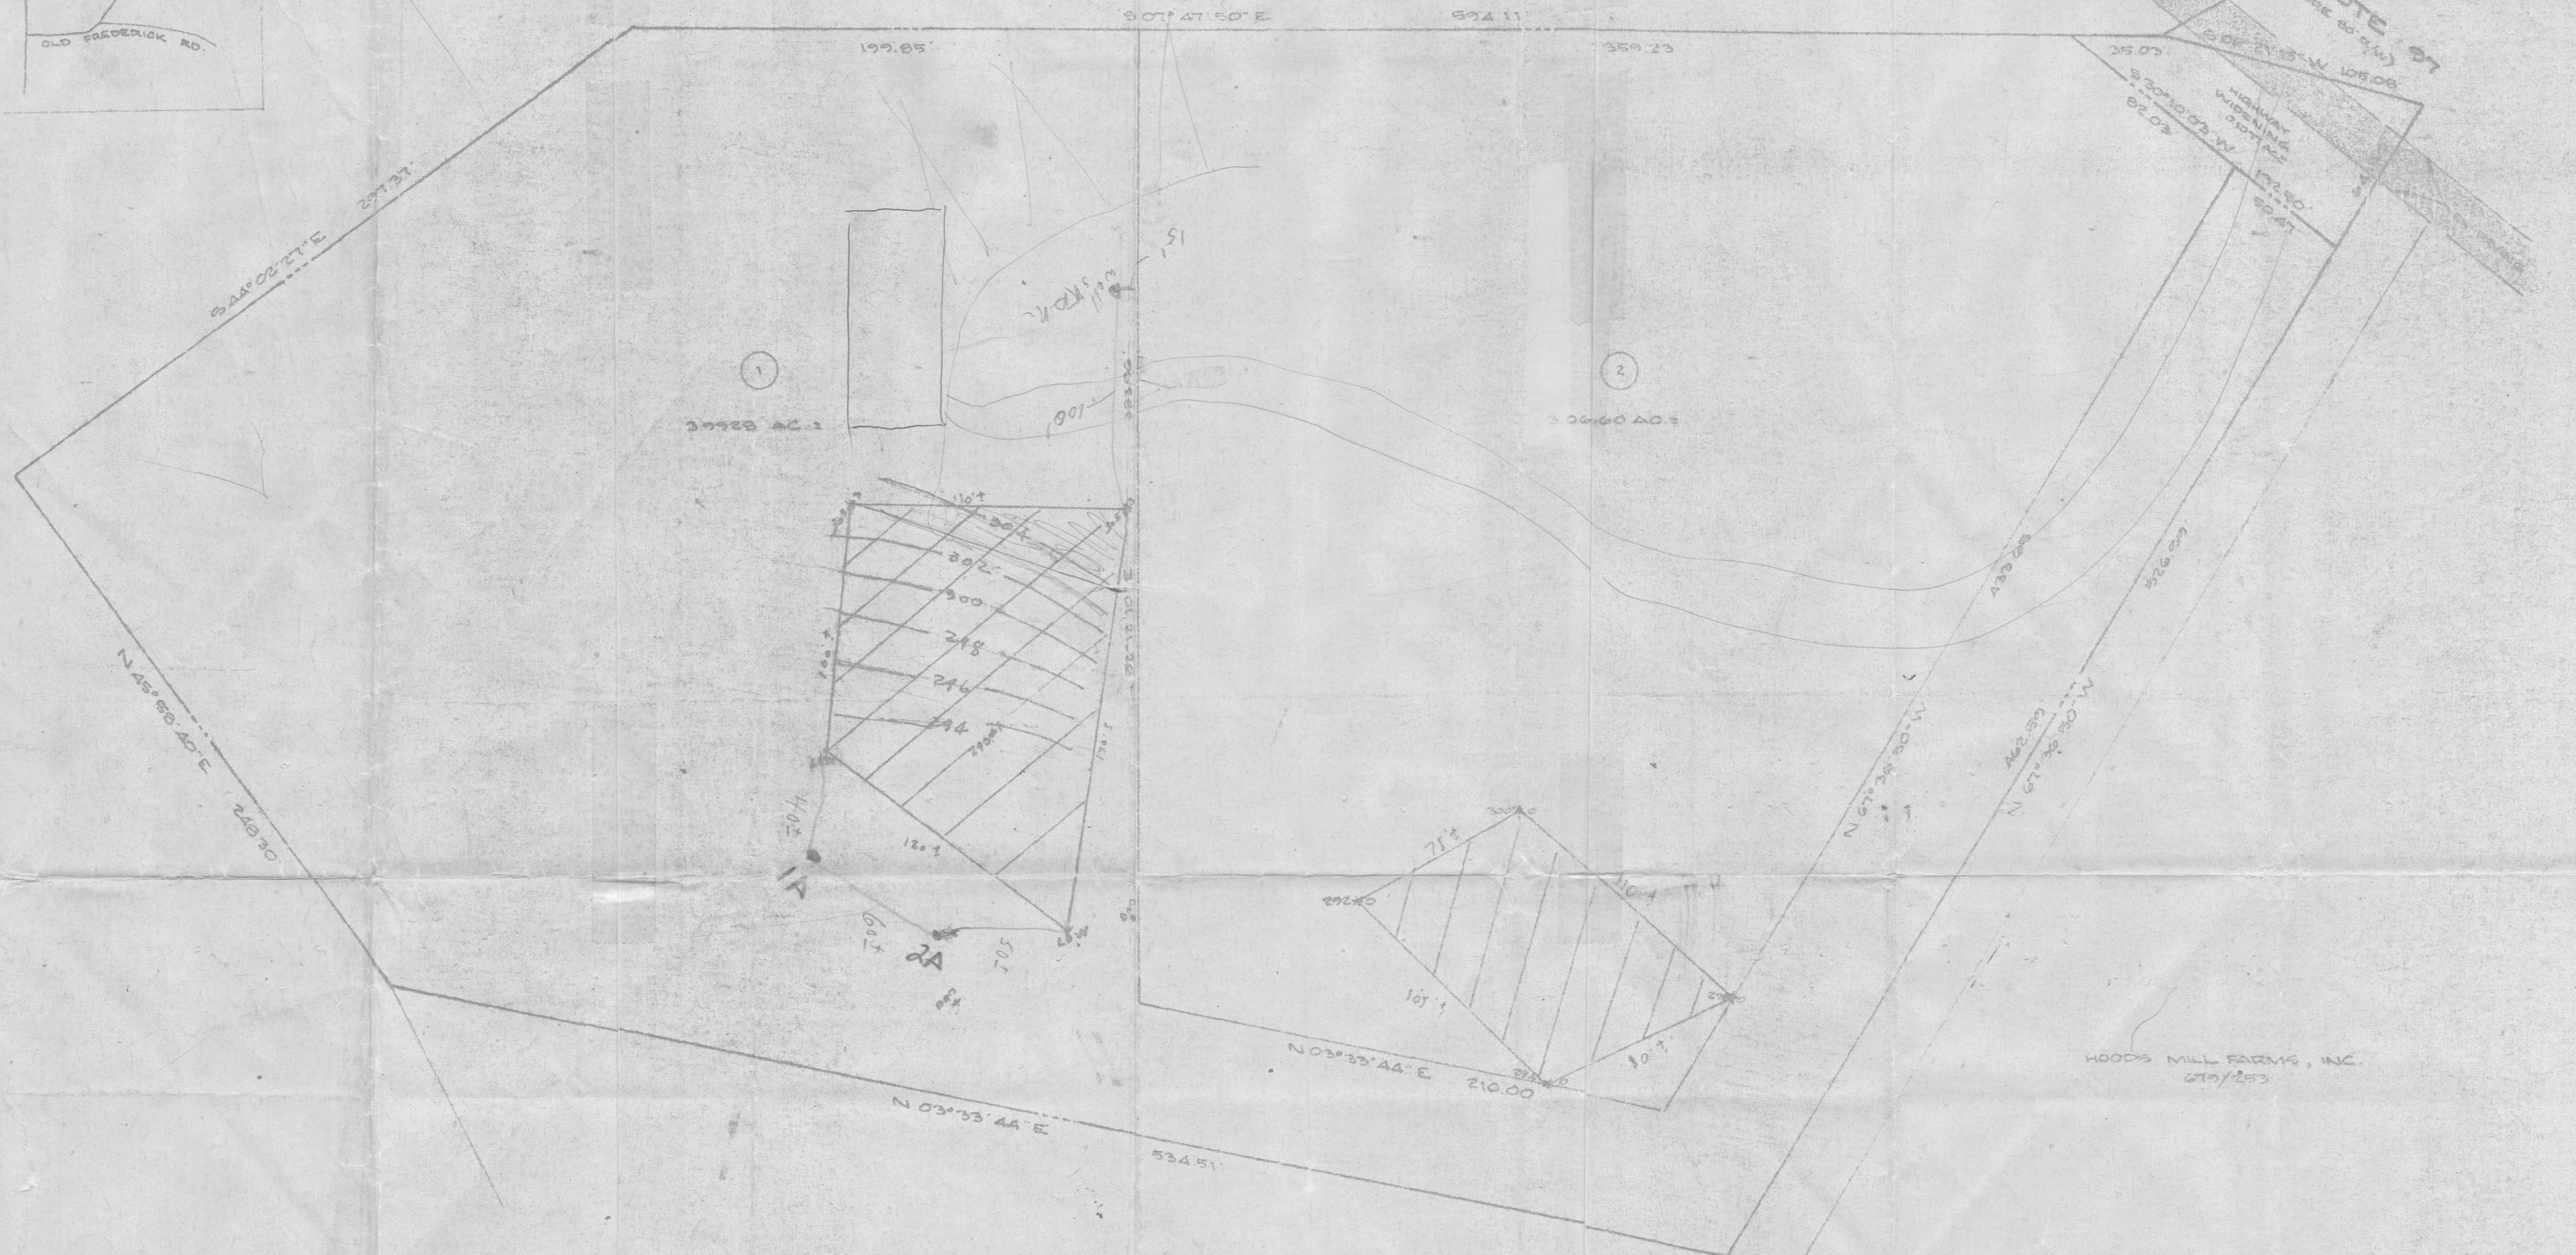

WALTER PARK, REG. L.S. #5537
HODKINS ASSOCIATES, INC.
231 JOSEPH SQUARE
COLUMBIA, MD. 21044

3000' DESIGNATES FIELD LOCATED PERC HOLES & ELEVATIONS.

614' of R/W = 3/4 ac

494 W
5090
409 6072

THIS AREA DESIGNATES A PRIVATE SEWAGE EASEMENT OF APPROXIMATELY 10,000' AS REQUIRED BY THE MD. STATE DEPT. OF HEALTH & MENTAL HYGIENE FOR INDIVIDUAL SEWAGE DISPOSAL. IMPROVEMENTS OF ANY NATURE IN THIS AREA ARE RESTRICTED UNTIL PUBLIC SEWER IS AVAILABLE & SERVICING ANY RESIDENTIAL STRUCTURE LOCATED ON THIS BUILDING SITE. THIS EASEMENT BECOMES NULL & VOID UPON CONNECTION TO A PUBLIC SEWERAGE SYSTEM.

THE LOTS SHOWN HEREON COMPLY WITH THE MINIMUM OWNERSHIP WIDTH & LOT AREA AS REQUIRED BY THE MARYLAND STATE DEPT. OF HEALTH & MENTAL HYGIENE.
TAX MAP 3, PARCEL 30

APPROVED FOR PRIVATE WATER & PRIVATE SEWAGE SYSTEMS.
HOWARD COUNTY HEALTH DEPARTMENT
Joseph Boyd
COUNTY HEALTH OFFICER
3-9-79
DATE

* FIELD-LOCATED PERC HOLES
LOTS 1 & 2
NICHOLAS J. FISHER PROPERTY
4TH ELEC. DIST. HOWARD CO., MD.
JANUARY 9, 1979 SCALE: 1"=100'