

11/5/79
around 2:00 P.M.
4/4/79
afternoon

PERMIT

SEWAGE DISPOSAL SYSTEM

MARYLAND STATE DEPARTMENT OF HEALTH

HOWARD COUNTY

05-341779

ELLICOTT CITY

DISTRICT 56h

DATE 12/1/78

INDEXED

P 29298

A 29279

Craig Camp IS PERMITTED TO INSTALL X ALTER

ADDRESS 8612 35th Avenue, College Park PHONE

SUBDIVISION Aintree Estates ROAD 6292 Linkythorn Lane LOT 3

PROPERTY OWNER Craig Camp

ADDRESS

SPECIFICATIONS 4 bedrooms

SEPTIC TANK CAPACITY 1250 GALLONS

DRAIN FIELD DEPTH FEET, BOTTOM AREA SQ. FT.

DEEP TRENCH DEPTH FEET, BOTTOM AREA SQ. FT.

SEEPAGE PITS ABSORBENT SIDE-WALL AREA SQ. FT.

INLET PIPE FT. BELOW ORIGINAL GRADE. MAXIMUM DEPTH FT. BELOW ORIGINAL GRADE

EFFECTIVE DEPTH AT FT. BELOW ORIGINAL GRADE.

LOCATE DISPOSAL AREA FT. FROM LOT LINE AND FT. FROM LOT LINE AS SEEN WHEN

FACING LOT FROM

BLDG. PERMIT SIGNED

AND RETURNED

7/2/80
Serial # 443648
Perol.

DRY WELL-Dig pit 15 ft. sq.-set block top in center for 12 ft. diameter and fill in rest of pit with gravel. Dry well to be 6 ft. deep below inlet pipe. Inlet pipe to be 4 ft. below grade at time of perc test. Come off dry well with 5 ft. earth buffer and begin trench. Trench to be 2 ft. wide, 10 ft. deep with 6 ft. of gravel and be 55 ft. long. Trench must follow contour of ground and be inspected before gravel is installed. Place dry well at point 99 ft. behind right rear of house (basement entrance) as seen when facing from the road.

PLANS APPROVED BY D.W. Monaghan DATE 11/28/78

COVER NO WORK UNTIL INSPECTED AND APPROVED.

NEITHER THE HOWARD COUNTY COUNCIL NOR THE HEALTH DEPARTMENT IS RESPONSIBLE FOR THE SUCCESSFUL OPERATION OF ANY SYSTEM.

NOTE: IF TRENCH IS USED CALL FOR INSPECTION BEFORE PLACING GRAVEL IN TRENCH.

NOTE: NO DRY WELL SHALL EXCEED 15 FOOT IN DIAMETER.


NOTE: ALL PIPE FROM HOUSE TO DISPOSAL AREA MUST BE CAST IRON.

PERMIT VOID AFTER THREE YEARS.

NOTE: INSTALL STAND PIPE ON SEPTIC TANK AND DRY WELL. STAND PIPES MUST BE 6 INCHES IN DIAMETER. CAST IRON, CONCRETE OR TERRA COTTA ACCEPTED.

*INSTALLER IS RESPONSIBLE FOR OBTAINING FINAL APPROVAL ON THIS PERMIT.

A 29279

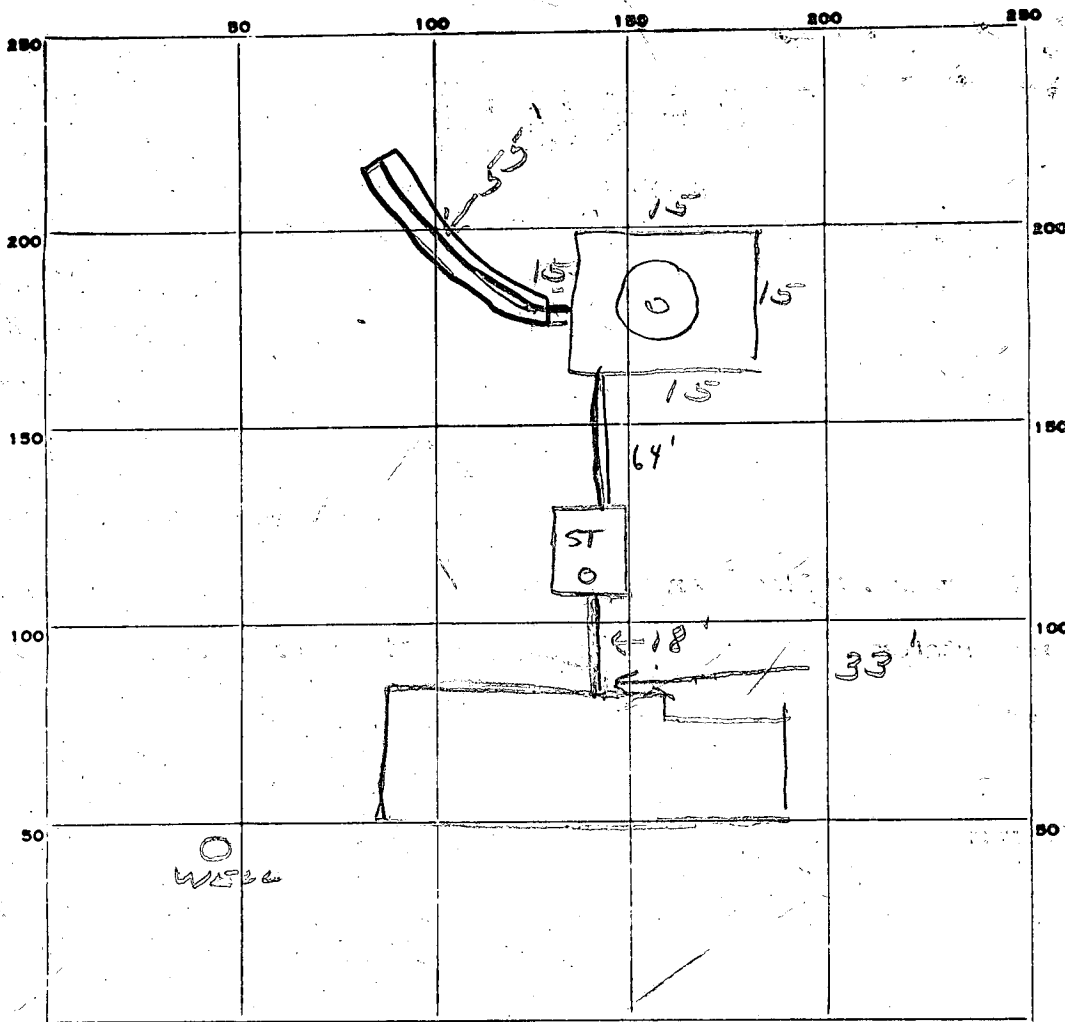

INDICATE NORTH. - NAME ADJOINING ROADWAY AS BASE LINE.

LINKYTHORN LANE

PERMIT CARD

Yes, Mr. Barthelme

SEPTIC TANK, LEVEL

CLEANOUTS

ST / DW
✓ / ✓

DISTRIBUTION BOX, LEVEL

N/A

TILE FIELD, DEPTH 10 FT. TRENCH WIDTH 2 FT.

GRAVEL DEPTH 6 IN. TOTAL LENGTH 55 FT. (1) 330'

NUMBER OF TRENCHES 1 TOTAL BOTTOM AREA

SEEPAGE PITS, INSIDE DIAMETER 60 FT. DEPTH BELOW INLET 6 FT. (2) 360'

ABSORBENT AREA 690 SQ. FT.

REMARKS 1/4/79 - OK TO continue work. Add cleanouts -
and gravel to trenches. Also pipe from septic to day well.
Call for final. JS
1/5/79 Paper on trench to 4' of surface. C.B.

DATE SYSTEM APPROVED

1/5/79 as per above

INSPECTOR

C. B. Theaker

APPLICATION

A 29279

SEWAGE DISPOSAL TESTING

P _____

STATE OF MARYLAND - DEPARTMENT OF HEALTH AND MENTAL HYGIENE

HOWARD COUNTY HEALTH DEPARTMENT
ENVIRONMENTAL HEALTH SERVICES

DISTRICT 5th

P. O. BOX 476, ELLICOTT CITY, MARYLAND 21043
TELEPHONE: 465-5000, EXT. 356

DATE 11/28/78

Septic Tank - 1250 gal

Dry Well - Dry pit 15' sq - set block - Top for 12' diameter pipe. Inlet pipe to be 4' below grade at time of perc. test. Come off sewer 5 ft. Earth buffer & begin trench. Trench to be 2 ft wide 10 ft deep with 6 ft of gravel and be 55' long. Trench must follow contour of ground & be inspected before gravel is installed.

TO: THE COUNTY HEALTH OFFICER
ELLICOTT CITY, MARYLAND

Place dry well at point 99 ft behind right rear of house (basement entrance), as seen when facing from the road.

I, HEREBY, APPLY FOR THE NECESSARY TEST IN ORDER TO CONSTRUCT (OR RECONSTRUCT) A SEWAGE DISPOSAL SYSTEM.

PROPERTY OWNER Dave Suder, Craig Camp

ADDRESS 8612 35th Ave., College Park, 20740 PHONE _____

PROPERTY LOCATION:

SUBDIVISION Aintree Estates LOT NO. 3

ROAD AND DESCRIPTION 6292 Linkythorn Lane

SIZE OF LOT 2.1 acres TYPE BLDG. 3 or 4 bedrooms

NUMBER OF BEDROOMS

IF NOT SINGLE RESIDENCE DESCRIBE _____

THE SYSTEM INSTALLED UNDER THIS APPLICATION IS ACCEPTABLE ONLY UNTIL PUBLIC FACILITIES BECOME AVAILABLE.

SIGNATURE OF APPLICANT _____


APPROVED BY [Signature] FOR Dry Well - Trench DATE 11-28-78
(KIND OF SYSTEM)

REJECTED BY _____ FOR _____ DATE _____
(KIND OF SYSTEM)

HOLD PENDING FURTHER TESTS _____ DATE _____

REASONS FOR REJECTION OR HOLDING _____

THIS IS NOT A PERMIT

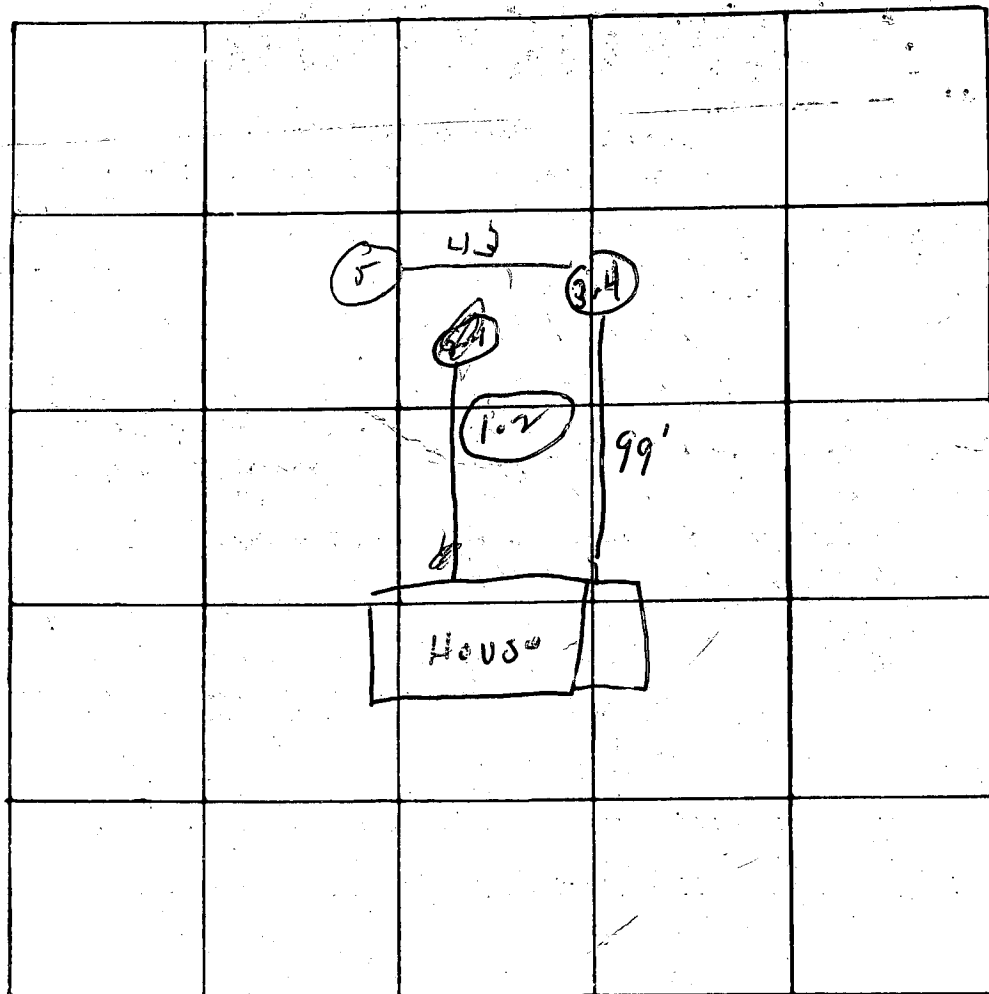

INDICATE NORTH - NAME ADJOINING ROADWAY AS BASE LINE

Linky then Or 6

DATE	TEST NO.	DEPTH	PRE-WET		TEST 1" DROP		TIME
			START	STOP	START	STOP	
11/28/76	1	4	11 03	11 06			
	2	13	wet				
	3	15'	11 13	11 20	11 20	11 35	15 min
	4	21'	11 13	11 18	11 18	11 25	7 min
	5	12'	dry				

REMARKS _____

TYPE OF SOIL _____

TESTED BY _____ ALSO PRESENT: _____

Preliminary

APPLICATION

SEWAGE DISPOSAL TESTING

MARYLAND STATE DEPARTMENT OF HEALTH

HOWARD COUNTY

ELLICOTT CITY

DISTRICT 5

DATE 3/30/66

TO: THE COUNTY HEALTH OFFICER
ELLICOTT CITY, MARYLAND

I, HEREBY, APPLY FOR THE NECESSARY TESTS IN ORDER TO CONSTRUCT (OR RECONSTRUCT) A SEWAGE DISPOSAL SYSTEM.

PROPERTY OWNER Aintree Estates, Inc.

ADDRESS 301 Cedar St., N. W.-Washington, D. C. PHONE HO 5-1635

PROPERTY LOCATION:

SUBDIVISION Aintree Estates, Inc. LOT NO. 3, Sec. 1

ROAD AND DESCRIPTION Road "A"

OCCUPANT _____ PHONE _____

PERSON TO CONSTRUCT SYSTEM _____

ADDRESS _____ PHONE _____

SIZE OF LOT 2.1 acres + TYPE BLDG. 3 or 4
NUMBER OF BEDROOMS

IF NOT SINGLE RESIDENCE DESCRIBE _____

SIGNATURE OF APPLICANT /s/ Mr. Brincefield per Mr. Sutherland

APPROVED BY J. Hennigan FOR Dry well DATE 4-29-66
(KIND OF SYSTEM)

REJECTED BY _____ FOR _____ DATE _____
(KIND OF SYSTEM)

HOLD PENDING FURTHER TESTS _____ DATE _____


REASONS FOR REJECTION OR HOLDING _____

THIS IS NOT A PERMIT

5909

Dale Suder
 935-5135 H
 434 1188 off
 Craig Camp
 8612 35th Ave.
 Col. Plk.
 20740

4BR
 SW 3 1/2 bths
 DW
 GG

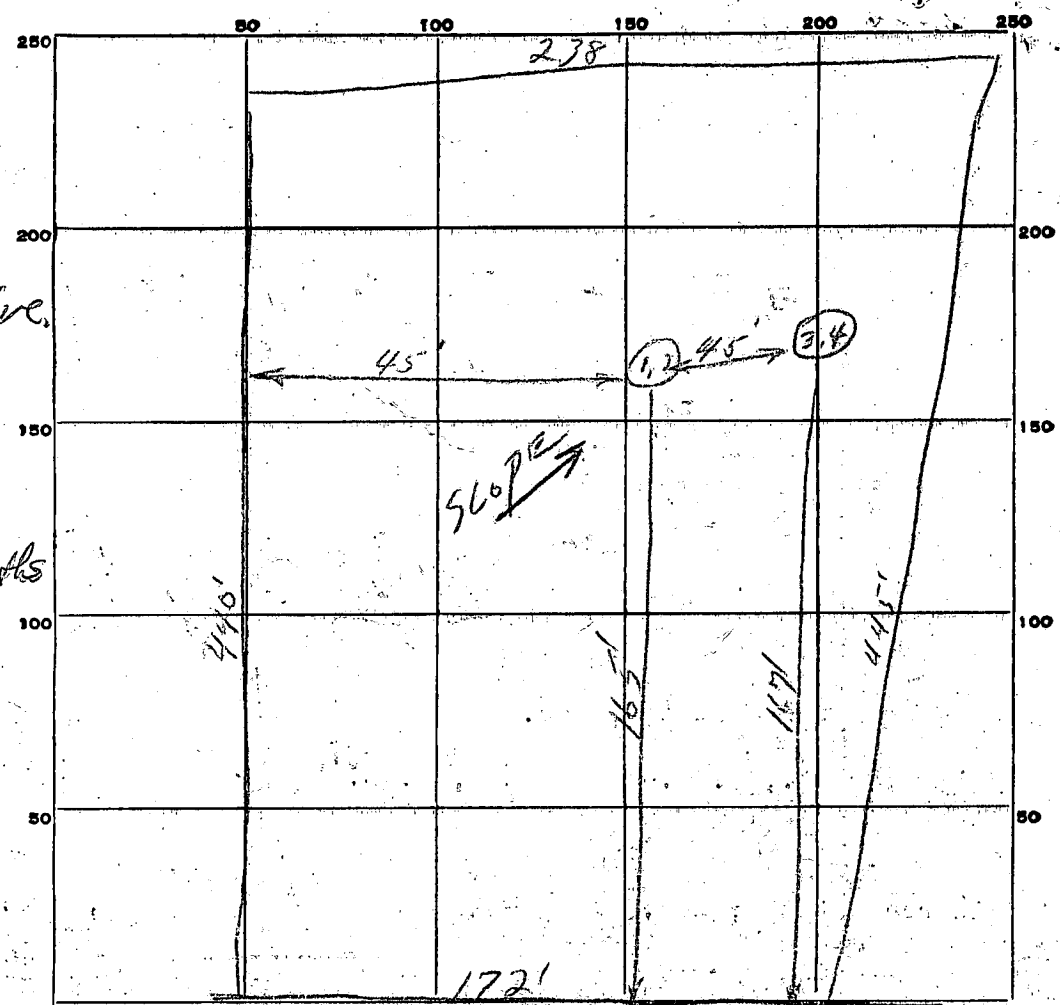

INDICATE NORTH - NAME ADJOINING ROADWAY AS BASE LINE.

Road A

DATE	TEST NO.	DEPTH	PRE-WET		TEST - 1" DROP		TIME
			START	STOP	START	STOP	
4-5-66	1 Same	9	12:19	12:25	12:25	12:40	15 min
	2 Pat	4	12:19	12:20	12:20	12:21	1 min
	3 Same	9	12:36	12:38	12:38	12:42	4 min
	4 Pat	4	12:37	12:40	12:41	12:49	8 min
9-20-78	Visual	11'	hard bottom		dry		

SOIL AUGER FINDING

TESTED BY

REMARKS

[Signature]
[Signature]

APPLICATION

SEWAGE DISPOSAL TESTING

A 11650

P _____

MARYLAND STATE DEPARTMENT OF HEALTH

HOWARD COUNTY

ELLCOTT CITY

DISTRICT 5

DATE 3/30/66

void
3 bedrooms - ¹⁰⁰⁰750 gal. septic Tank.
Dry well 15 ft. in dia. by 10 ft. deep
below the inlet located 165 ft. from the
front property line and 45 ft. off the left
side property line as seen when facing the
lot from road. A. Force inlet pipe 3 FT. below
the original grade.

TO: THE COUNTY HEALTH OFFICER
ELLCOTT CITY, MARYLAND

I, HEREBY, APPLY FOR THE NECESSARY TESTS IN ORDER TO CONSTRUCT (OR RECONSTRUCT) A SEWAGE
DISPOSAL SYSTEM.

PROPERTY OWNER Aintree Estates, Inc.

ADDRESS 301 Cedar St., N. W.-Washington, D. C. PHONE HO 5-1635

PROPERTY LOCATION:

SUBDIVISION Aintree Estates, Inc. LOT NO. 3, Sec. 1

ROAD AND DESCRIPTION Road "A"

OCCUPANT _____ PHONE _____

PERSON TO CONSTRUCT SYSTEM _____

ADDRESS _____ PHONE _____

SIZE OF LOT 2.1 acres + TYPE BLDG. 3 or 4

NUMBER OF BEDROOMS

IF NOT SINGLE RESIDENCE DESCRIBE _____

SIGNATURE OF APPLICANT /s/ Mr. Brincefield per Mr. Sutherland

APPROVED BY J. Henniger FOR Dry well DATE 4-29-66

(KIND OF SYSTEM)


REJECTED BY _____ FOR _____ DATE _____

(KIND OF SYSTEM)

HOLD PENDING FURTHER TESTS _____ DATE _____

REASONS FOR REJECTION OR HOLDING _____

THIS IS NOT A PERMIT

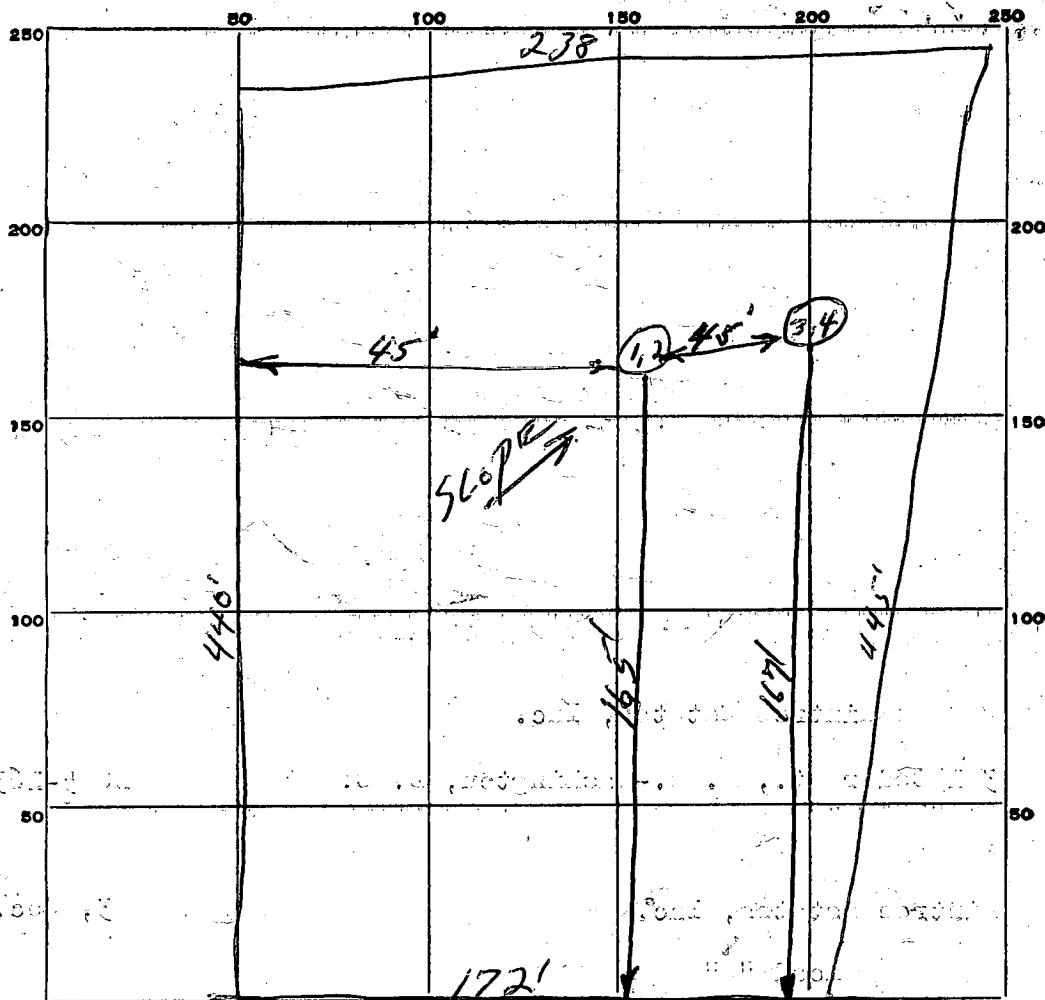

INDICATE NORTH. - NAME ADJOINING ROADWAY AS BASE LINE.

Road A

DATE	TEST NO.	DEPTH	PRE-WET		TEST - 1" DROP		TIME
			START	STOP	START	STOP	
4-5-66	1 Same	9	12:19	12:25	12:25	12:40	15 min
	2 Pit	4	12:19	12:20	12:20	12:21	1 min
	3 Same	9	12:36	12:38	12:38	12:42	4 min
	4 Pit	4	12:37	12:40	12:41	12:49	8 min

av. perc Time
7 min

SOIL AUGER FINDING

TESTED BY

REMARKS

[Signature]
[Signature]

Aintree Estates

Lot #3

37607

SEPTIC TANK: 3 BEDROOM, 1000 GALLON

4 BEDROOM, 1250 GALLON

Dishwasher & Disposal

1500 gallon

DRY WELL TO HAVE 600 SQUARE FEET OF SIDEWALL AREA PER BEDROOM.

DRY WELL INLET TO BE $3\frac{1}{2}$ FEET ^{net} BELOW ORIGINAL GRADE.

DRY WELL BOTTOM (MAXIMUM DEPTH) TO BE 8 FEET BELOW ORIGINAL GRADE.

PLACE THE DRY WELL 160 FEET FROM THE ~~front~~ LOT LINE AND 45 FEET FROM THE

left LOT LINE AS SEEN WHEN FACING THE LOT FROM the ROAD.

If 2 drywells, space double their size apart
If trenches, insp. before gravel installed & after gravel
installed. 1st trench must cross thru location of
drywell and follow a constant (grade) elevation.

Address: 6292 Linkyhorn Lane

Dare Sinder

Craig Camp

8612 35th Ave. College Park 20740 Md.

Please send spec's & elev. sample sheet

BLDG. PERMIT SIGNED

AND RETURNED 10/20/78

serial # 37607

238'

SECONDARY DRY WELL

PROPERTY LINES

ELEC. METER LOCATION

440'

5' EARTH BUFFER

TRENCH ON CONSTANT GRADE

ELEVATIONS

PERC TEST AREA

94.75' INVERT ELEV. (91.20')

INVERT ELEV. (92.16')

96.5' INVERT ELEV. (93.58')

97.7' INVERT ELEV. (94.0')

15" DRYWELLS

15' 15'

15' 15'

OUTLET 3" lower than inlet

SEPTIC TANK

TOP OF TANK

42' 160'

50'

BUILDING SETBACK LINE

INITIAL WELL SITE

65' 88' 70' 75'

ROAD

173'

2 Drywells 15' x 15' = 60' perum
2 x 60 = 120 ft perimeter
4 1/2 ft recovery wall height
270 ft recovery per drywell =
540 ft for both
60 ft (to total 600 ft of rec)
∴ need 10 ft trench (20 x
4 1/2 = 100 ft)
100 ft +

(1) DRYWELL AND/OR TRENCH TO TOTAL 150 ft WALL AREA PER BEDROOM.

(2) DRYWELL INLET TO BE 3 1/2 Feet below present Grade with bottom to max depth of 8 feet (4 1/2 ft/1 ft of wall)

MIN SLOPE = 1/8" / Lin Ft.
MAX SLOPE = 1/4" / Lin Ft.

4" cast iron line

ALTERNATE LOCATION FOR ELEC. METER

NORTH

CAMP - SLIDER 434-1188
LOT #3
LINKYTHORNE LANE
AINTREE ESTATES

app 10-10-78

and elevations are actual and correct
DATE

B 1 9018		STATE OF MARYLAND WATER RESOURCES ADMINISTRATION TAWES STATE OFFICE BLDG., ANNAPOLIS, MARYLAND 21401 APPLICATION FOR PERMIT TO DRILL WELL		WRA PERMIT NUMBER HO-70-244 FILL IN THIS FORM COMPLETELY									
DATE RECEIVED (WRA USE ONLY) 10/13/78 9:30 a.m.		OWNER <u>Edna P. Pitts</u> (SENDER) <u>1020 Pine Forest Ln</u> COL 15 - LAST NAME <u>Pitts</u> FIRST NAME <u>Edna</u> COL. 34 STREET OR RFD <u>Lincolnton Road</u> COL. 36 <u>Historic Estate</u> COL. 55 POST OFFICE <u>Chesapeake</u> COL. 57 <u>MD</u> COL. 76											
B 1 CONTINUED		B 3 DRILLER INFORMATION DATE <u>Sept 20, 1978</u> LICENSE NUMBER <u>273</u> FIRST NAME <u>RALPH</u> DRILLER <u>MAYNE</u> LAST NAME SIGNATURE <u>Ralph Mayne</u>											
B 2 WELL INFORMATION MAXIMUM PUMPING RATE (GALLONS PER MINUTE) <u>5</u> AVERAGE DAILY QUANTITY NEEDED (GALLONS PER DAY) <u>500</u> USE FOR WATER (CIRCLE APPROPRIATE BOX) ☒ HOME (SINGLE OR DOUBLE HOUSEHOLD UNIT ONLY) ☐ FARMING, AGRICULTURE, IRRIGATION ☐ INDUSTRIAL, COMMERCIAL, STATE AND FEDERAL GOVERNMENT ☐ MUNICIPAL WATER SUPPLY ☐ PRIVATE WATER COMPANY ☐ TEST MUST HAVE STATE HEALTH DEPT. APPROVAL		B 3 LOCATION OF WELL COUNTY <u>Howard</u> (DO NOT ABBREVIATE COUNTY NAME) SUBDIVISION <u>Historic Estate</u> SECTION <u>Block 1</u> LOT <u>3</u> NEAREST TOWN <u>Chesapeake</u> MILES FROM TOWN (ENTER 0 IF IN TOWN) <u>5</u> B 4 DIRECTION FROM TOWN (CIRCLE APPROPRIATE BOX) <table border="1" style="width: 100%; text-align: center;"><tr><td>☐ N NORTH</td><td>☐ E EAST</td><td>☐ NE NORTHEAST</td><td>☐ SE SOUTHEAST</td></tr><tr><td>☐ S SOUTH</td><td>☐ W WEST</td><td>☐ NW NORTHWEST</td><td>☐ SW SOUTHWEST</td></tr></table> NEAR WHAT ROAD <u>Lincolnton Road</u> ON WHICH SIDE OF ROAD (CIRCLE APPROPRIATE BOX) ☐ N ☐ S ☐ E ☒ W DISTANCE FROM ROAD (ENTER DISTANCE AND CIRCLE APPROPRIATE BOX) <u>34</u> DRAW A SKETCH BELOW SHOWING LOCATION OF WELL IN RELATION TO NEARBY TOWNS, ROADS AND STREAMS WITH NORTH IN THE DIRECTION OF THE ARROW, AND GIVE DISTANCE FROM WELL TO NEAREST ROAD JUNCTION OR STREAM CROSSING SHOWN ON THE SKETCH. ALSO SHOW, BY MEANS OF AN "X", THE WELL LOCATION IN THE BOX BELOW AND THE BOX NUMBER FROM THE WELL LOCATION MAP. 42' - CASING 2' - ABOVE GR. 39' - OPEN HOLE 81 - BAGS CEMENT OK 10/13/78				☐ N NORTH	☐ E EAST	☐ NE NORTHEAST	☐ SE SOUTHEAST	☐ S SOUTH	☐ W WEST	☐ NW NORTHWEST	☐ SW SOUTHWEST
☐ N NORTH	☐ E EAST	☐ NE NORTHEAST	☐ SE SOUTHEAST										
☐ S SOUTH	☐ W WEST	☐ NW NORTHWEST	☐ SW SOUTHWEST										
APPROXIMATE DEPTH OF WELL <u>150</u> FEET APPROXIMATE DIAMETER OF WELL <u>6</u> (NEAREST INCH) METHOD OF DRILLING USED (CIRCLE APPROPRIATE METHOD) ☒ BORED (OR AUGERED) ☐ JETTED ☐ DRIVEN ☒ AIR-ROTARY ☐ AIR-PERCUSSION ☐ ROTARY (HYDRAULIC ROTARY) ☐ CABLE ☐ REVERSE-ROTARY ☐ DRIVE-POINT OTHER (DESCRIBE)		REPLACEMENT OR DEEPEINED WELLS (CIRCLE APPROPRIATE BOX) ☒ N THIS WELL WILL NOT REPLACE AN EXISTING WELL ☐ Y THIS WELL WILL REPLACE A WELL THAT WILL BE ABANDONED-AND SEALED ☐ S THIS WELL WILL REPLACE A WELL THAT WILL BE USED AS A STANDBY ☐ D THIS WELL WILL DEEPEIN AN EXISTING WELL PERMIT NUMBER OF WELL TO BE REPLACED OR DEEPEINED (IF AVAILABLE) NOT TO BE FILLED IN BY DRILLER (WRA USE ONLY) APPROPRIATION PERMIT NUMBER <u>64</u> ENGINEER REVIEW DISTRICT NO. <u>63</u> FORCE <u>67</u> WRITE INITIALS IN BOX <u>68</u> CONDITIONS <u>70</u> <u>71</u> <u>72</u> <u>73</u> <u>74</u> <u>75</u> <u>76</u> <u>77</u> <u>78</u> <u>79</u>											
B 4 CONTINUED		B 4 HEALTH DEPARTMENT APPROVAL DATE <u>10/27/78</u> STATE HEALTH (CIRCLE BOX) <u>S</u> COUNTY NAME <u>Howard</u> COUNTY NO. <u>W28023</u> APPROVED BY <u>Donald W. Monaghan</u> SANITARIAN SPECIAL CONDITIONS 8-63 (WRA USE ONLY)											

C 1	2976	SEQUENCE NO. (WRA USE ONLY)	STATE OF MARYLAND WATER RESOURCES ADMINISTRATION TAWES STATE OFFICE BLDG., ANNAPOLIS, MD. 21401 WELL COMPLETION REPORT		THIS REPORT MUST BE SUBMITTED WITH- IN 30 DAYS AFTER WELL COMPLETION
(THIS NUMBER IS TO BE PUNCHED IN COLS. 3-6 ON ALL CARDS)				FILL IN THIS FORM COMPLETELY	
DATE RECEIVED (WRA USE ONLY)		08-13-1978		DEPTH OF WELL 285	
DATE WELL COMPLETED		22 (TO NEAREST FOOT)		PERMIT NO. FROM "PERMIT TO DRILL WELL" MC-M-9-2998	
8-13		15 20		28 29 30 31 32 33 34 35 36 37	
OWNER		CAMP GRAIG		FIRST NAME	
LAST NAME		LINKYTHORNE LA		CLARKSVILLE MD	
STREET OR RFD		LA		POST OFFICE	

WELL LOG			GROUTING RECORD			PUMPING TEST		
STATE THE KIND OF FORMATIONS PENETRATED, THEIR COLOR, DEPTH, THICKNESS AND IF WATER BEARING			WELL HAS BEEN GROUTED (CIRCLE APPROPRIATE BOX)			1 2 3 (SEQ. NO.) 6		
DESCRIPTION (USE ADDITIONAL SHEETS IF NECESSARY)			TYPE OF GROUTING MATERIAL (CIRCLE BOX)			HOURS PUMPED (TO NEAREST HOUR)		
FEET FROM TO CHECK IF WATER BEARING			CEMENT ☒ BENTONITE CLAY ☒			PUMPING RATE (GALLONS PER MINUTE TO NEAREST GALLON)		
Top Soil 0 12 ✓ Sandy 12 30 ✓ Sand Stone 30 85 ✓ Micka 35 55 ✓ Sand Stone 55 60 ✓ Micka 60 220 ✓ Sand Stone 220 225 ✓ Micka 225 225 ✓			NO. OF BAGS 11 NO. OF POUNDS 1000			METHOD USED TO MEASURE PUMPING RATE Bucket		
			GALLONS OF WATER 66			WATER LEVEL (DISTANCE FROM LAND SURFACE)		
			DEPTH OF GROUT SEAL (TO NEAREST FOOT)			BEFORE PUMPING 30 (NEAREST FOOT)		
			FROM 0 FT. TO 39 FT.			WHEN PUMPING 285 (NEAREST FOOT)		
			(ENTER 0 IF FROM SURFACE)			TYPE OF PUMPED USED (CIRCLE APPROPRIATE BOX) (FOR PUMPING TEST)		
			CASING RECORD			☒ AIR ☐ PISTON ☐ TURBINE ☐ CENTRIFUGAL ☐ ROTARY ☐ OTHER (DESCRIBE BELOW) ☐ JET ☐ SUBMERSIBLE		
			MAIN CASING TYPE 5+6			PUMP INSTALLED		
			NOMINAL DIAMETER TOP (MAIN) CASING (NEAREST INCH) 6			TYPE OF PUMP (WRITE APPROPRIATE LETTER IN BOX - SEE ABOVE: A, C, J, P, R, S, T, O)		
			TOTAL DEPTH OF MAIN CASING (NEAREST FOOT) 42			DRILLER WILL INSTALL PUMP (CIRCLE APPROPRIATE BOX)		
			OTHER CASING (IF USED)			CAPACITY:		
			DIA. (INCH) DEPTH (FEET)			GALLONS PER MINUTE (TO NEAREST GALLON)		
			SCREEN RECORD			PUMP HORSE POWER		
			SCREEN TYPE OR OPEN HOLE			PUMP COLUMN LENGTH (NEAREST FOOT)		
			STEEL BRASS OR BRONZE OPEN HOLE			CASING HEIGHT (CIRCLE APPROPRIATE BOX AND ENTER CASING HEIGHT)		
			PLASTIC OTHER			☒ ABOVE ☐ BELOW		
			C 2 (SEQ. NO.)			LOCATION OF WELL ON LOT		
			1 2 3 (SEQ. NO.) 6			SHOW PERMANENT STRUCTURE SUCH AS BUILDINGS, SEPTIC TANKS, AND/OR OTHER LAND MARKS AND INDICATE NOT LESS THAN TWO DISTANCES (MEASUREMENTS TO WELL).		
			DEPTH (NEAREST WHOLE FOOT)			Well 25' AC 15' PO 24' JEEP LINE		
			FROM 39 TO 285					
			EACH SCREEN					
			1 2 3					
			23 24 26 30 32 36					
			38 39 41 45 47 51					
			SLOT SIZE 1. 2. 3.					
			DIAMETER OF SCREEN 56 60 (NEAREST INCH)					
			FROM TO					
			GRAVEL PACK					
			IF WELL DRILLED WAS A FLOWING WELL CIRCLE BOX 68 F					
			WRA USE ONLY (NOT TO BE FILLED IN BY DRILLER)					
			T (E.R.O.S.) W Q					
			70 72 74 75 76					
			TELESCOPE CASING LOG INDICATOR OTHER DATA AVAILABLE					

CIRCLE APPROPRIATE BOXES

☐ A WELL WAS ABANDONED AND SEALED WHEN THIS WELL WAS COMPLETED

☐ E ELECTRIC LOG OBTAINED

☐ P TEST WELL CONVERTED TO PRODUCTION WELL

I HEREBY CERTIFY THAT I HAVE COMPLIED WITH ALL CONDITIONS STATED ON THE ABOVE-CAPTIONED "PERMIT TO DRILL WELL", AND THAT INFORMATION CONTAINED IN THIS REPORT IS TRUE, ACCURATE, AND COMPLETE TO THE BEST OF MY KNOWLEDGE, INFORMATION AND BELIEF.

DRILLERS NAME Ralph Mayne

(PLEASE PRINT) Ralph Mayne

SIGNATURE Ralph Mayne