

12/10/79

PERMIT

SEWAGE DISPOSAL SYSTEM

MARYLAND STATE DEPARTMENT OF HEALTH

HOWARD COUNTY

04-328744
INDEXED

ELLICOTT CITY

DISTRICT 4th

DATE 11/19/79

Floyd Seiss

IS PERMITTED TO INSTALL ☒ ALTER

ADDRESS _____ PHONE _____

SUBDIVISION _____ ROAD _____ LOT 4

PROPERTY OWNER James Everett

ADDRESS 10704 Eastwood Avenue, Silver Spring, Md. 20901 Phone: 593-3163

SPECIFICATIONS 3 bedrooms

SEPTIC TANK CAPACITY 1000 GALLONS

DRAIN FIELD _____ DEPTH _____ FEET, BOTTOM AREA _____ SQ. FT.

DEEP TRENCH _____ DEPTH _____ FEET, BOTTOM AREA _____ SQ. FT.

SEEPAGE PITS ☒ ABSORBENT SIDE-WALL AREA 176 SQ. FT. per bedroom

INLET PIPE 3 FT. BELOW ORIGINAL GRADE MAXIMUM DEPTH 12 FT. BELOW ORIGINAL GRADE

EFFECTIVE DEPTH AT _____ FT. BELOW ORIGINAL GRADE.

LOCATE DISPOSAL AREA 200 FT. FROM front LOT LINE AND 25 FT. FROM left LOT LINE AS SEEN WHEN

FACING LOT FROM Route 144.

Okay to add ditch off the dry well to obtain the necessary sidewall area. Make the ditch 12 ft. deep, filled with 8 ft. of stone. Leave 5 ft. earth buffer between trench and dry well. Trench to follow contour of the land. TWO INSPECTIONS OF TRENCH NEEDED.

PLANS APPROVED BY Raymond Hodges DATE 5/5/79

COVER NO WORK UNTIL INSPECTED AND APPROVED.

NEITHER THE HOWARD COUNTY COUNCIL NOR THE HEALTH DEPARTMENT IS RESPONSIBLE FOR THE SUCCESSFUL OPERATION OF ANY SYSTEM.

NOTE: IF TRENCH IS USED CALL FOR INSPECTION BEFORE PLACING GRAVEL IN TRENCH.

NOTE: NO DRY WELL SHALL EXCEED 15 FOOT IN DIAMETER.


NOTE: ALL PIPE FROM HOUSE TO DISPOSAL AREA MUST BE CAST IRON.

PERMIT VOID AFTER THREE YEARS.

NOTE: INSTALL STAND PIPE ON SEPTIC TANK AND DRY WELL. STAND PIPES MUST BE 6 INCHES IN DIAMETER. CAST IRON, CONCRETE OR TERRA COTTA ACCEPTED.

*INSTALLER IS RESPONSIBLE FOR OBTAINING FINAL APPROVAL ON THIS PERMIT.

A 29736

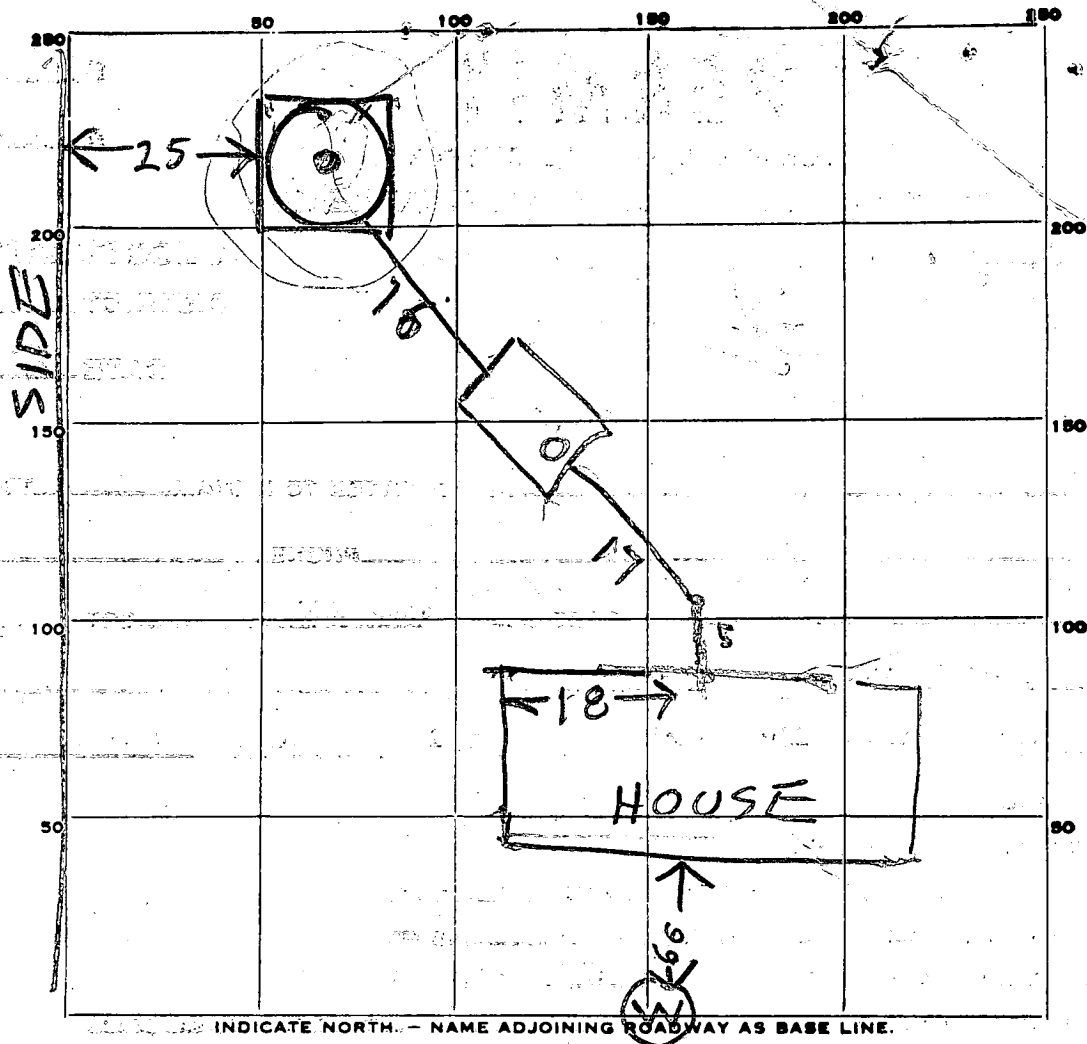

PERMIT CARD

SEPTIC TANK, LEVEL OK 1000

CLEANOUTS

ST | DW
OK | OK

DISTRIBUTION BOX, LEVEL TO 1 FT. BELOW GRADE

TILE FIELD, DEPTH _____ FT. TRENCH WIDTH _____ FT.

GRAVEL DEPTH _____ IN. TOTAL LENGTH _____ FT.

NUMBER OF TRENCHES _____ TOTAL BOTTOM AREA _____

SEEPAGE PITS, INSIDE DIAMETER PERIMETER 60 FT. DEPTH BELOW INLET 9 FT.

ABSORBENT AREA 540 SQ. FT.

REMARKS 12/10/79 - LOCATION OK PER PLANS DW INLET 3 FT
BELOW O. GRADE 3 BR - 528 SQ FT REQUIRED


DATE SYSTEM APPROVED

12/10/79


INSPECTOR

Raymond Hodges

COORDINATES			CURVE DATA					
N°	NORTH	EAST	FROM	RADIUS	LENGTH	TAN.	Δ	CHD. BEARING
1	5000.000	5000.000	6 TO 9	1185.22'	164.66'	82.46'	07°57'13"	N43°50'10"W 164.53'
2	5050.203	4243.264	9 TO 2	1185.22'	43.01'	21.51'	02°04'41"	N44°42'10"W 43.01'
3	5125.841	4787.133	6 TO 2	1185.22'	207.67'	104.10'	10°02'00"	N48°47'50"W 207.41'
4	5703.233	5158.352	6 TO 7	1185.22'	206.45'	103.49'	10°02'00"	N48°47'50"W 206.19'
5	5441.824	5461.022						
6	5190.191	4783.060						
7	5054.360	4238.210						
8	4995.156	4224.246						
9	5082.713	4212.243						
10	5523.872	5366.001						

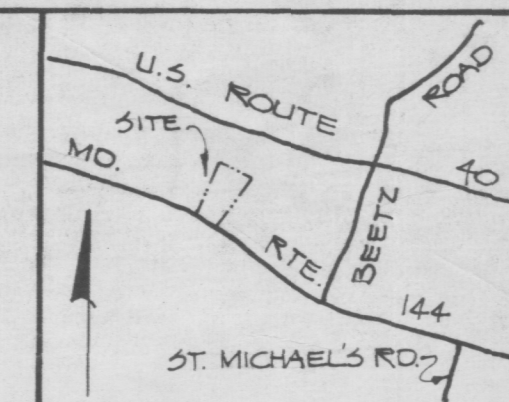

LOCATION MAP
SCALE: 1" = 2000'

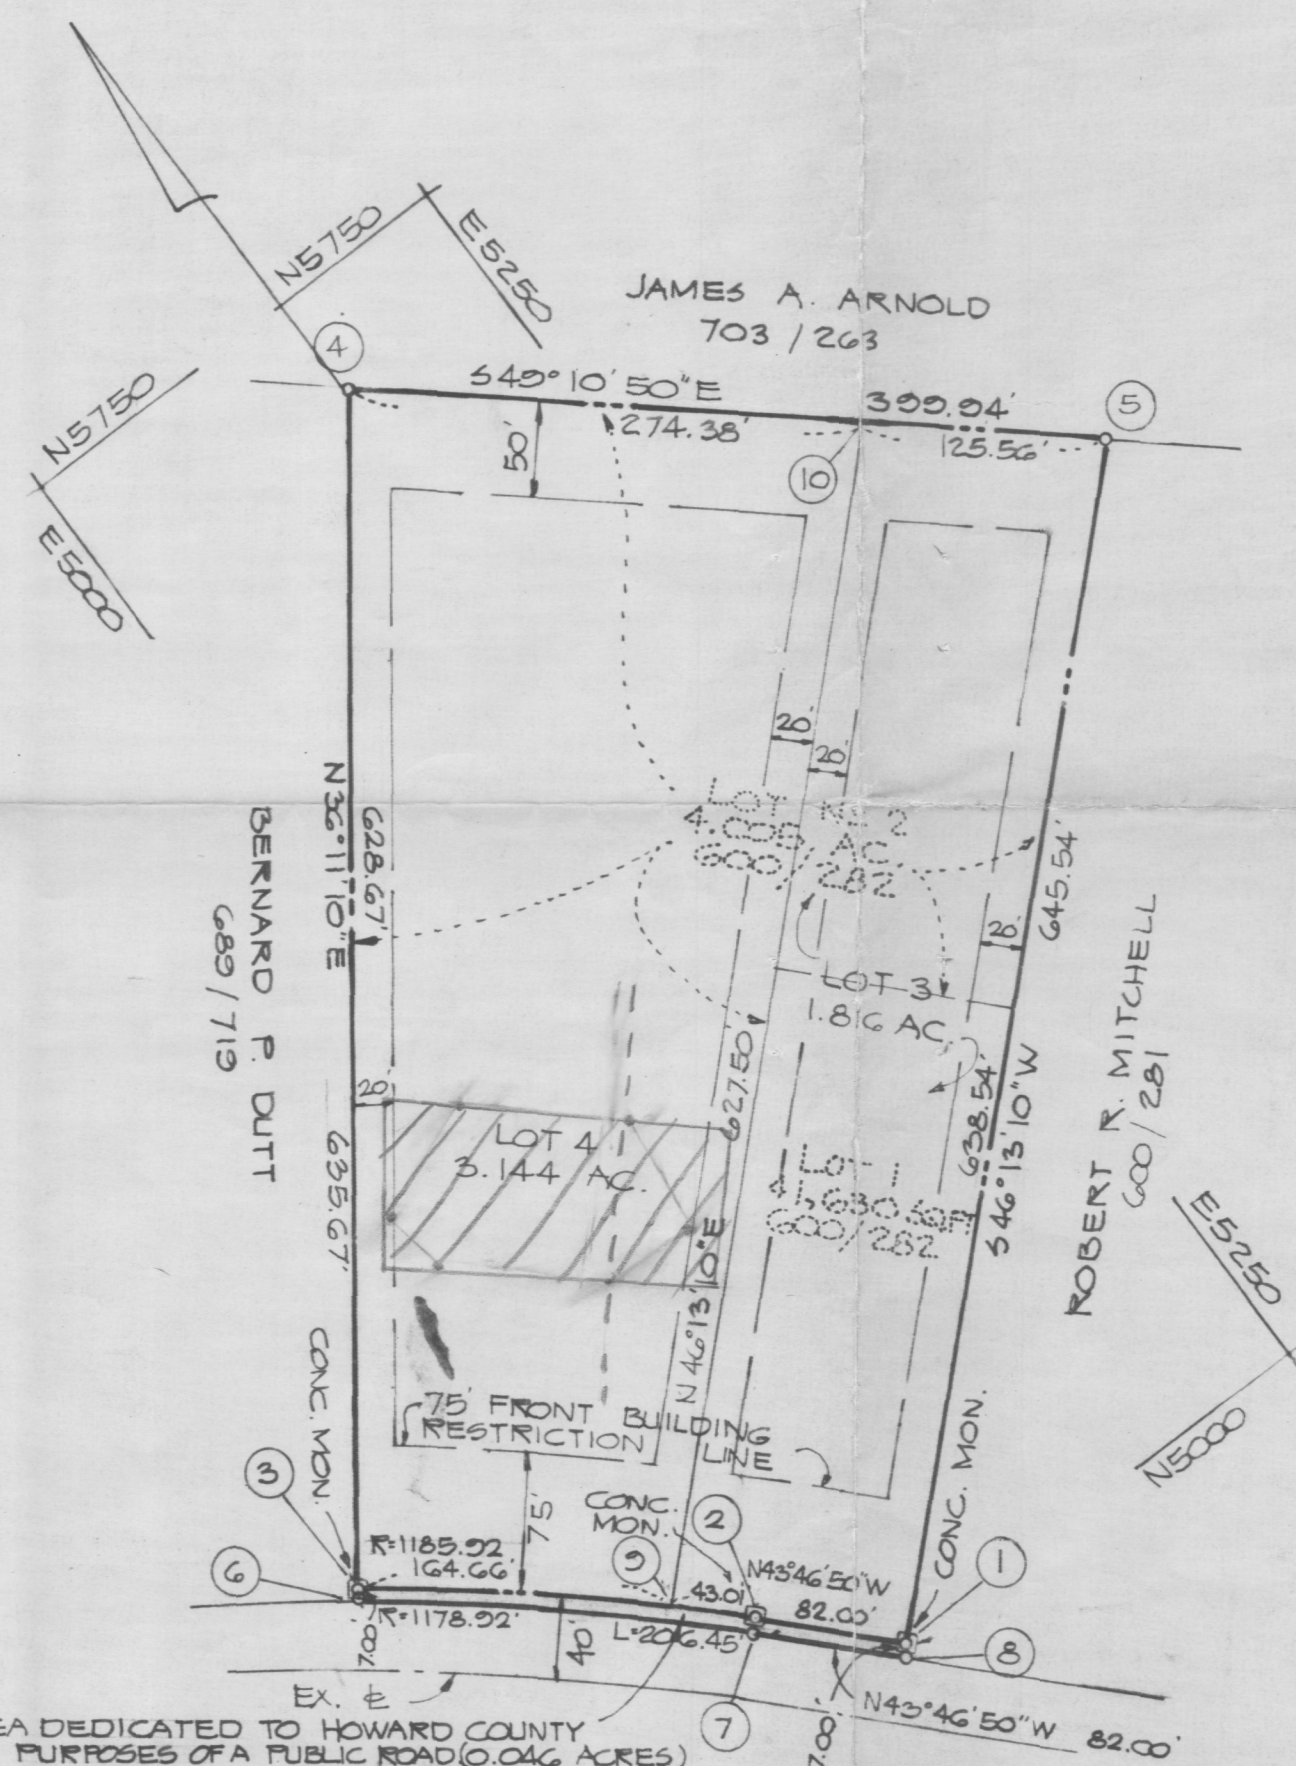

OWNER & DEVELOPER

ROBERT P. STEVENS
12630 LIME KILN ROAD
FULTON, MARYLAND, 20750

AREA TABULATIONS

1. TOTAL NO. OF LOTS: 2
2. TOTAL AREA OF LOTS: 4.960 ACRES
3. TOTAL AREA OF ROAD DEDICATION: 0.046 ACRES
4. TOTAL AREA OF PLAT: 5.006 ACRES

APPROVED FOR PRIVATE WATER AND PRIVATE SEWAGE SYSTEMS, HOWARD COUNTY HEALTH DEPARTMENT.

W. J. P. 4/9/76
COUNTY HEALTH OFFICER DATE

APPROVED: HOWARD COUNTY OFFICE OF PLANNING & ZONING

Thomas L. Harris 4/14/76

DIRECTOR DATE
APPROVED: STORM DRAINAGE SYSTEMS AND PUBLIC ROADS, HOWARD COUNTY DEPARTMENT OF PUBLIC WORKS

P. J. Rega Jr. 4-13-76
DIRECTOR DATE

OWNERS CERTIFICATE

WE ROBT. P. & EDNA C. STEVENS, & ROBT. R. & PEGGY R. MITCHELL, OWNERS OF THE PROPERTY SHOWN AND DESCRIBED HEREON, HEREBY ADOPT THIS PLAN OF SUBDIVISION, AND IN CONSIDERATION OF THE APPROVAL OF THIS FINAL PLAT BY THE OFFICE OF PLANNING & ZONING, ESTABLISH THE MINIMUM BUILDING RESTRICTION LINES AND GRANT UNTO HOWARD COUNTY, MD., ITS SUCCESSORS AND ASSIGNS, 1) THE RIGHT TO LAY, CONSTRUCT AND MAINTAIN SEWER, DRAIN, WATER PIPES AND OTHER MUNICIPAL UTILITIES AND SERVICES IN AND UNDER ALL ROADS & STREET RIGHT OF WAYS AND THE SPECIFIC EASEMENT AREAS SHOWN HEREON; 2) DEDICATE TO PUBLIC USE THE BEDS OF THE STREETS AND/OR ROADS AND FLOODPLAINS AND OPEN SPACE WHERE APPLICABLE, AND FOR ONE DOLLAR CONSIDERATION, HEREBY GRANT THE RIGHT AND OPTION TO HOWARD COUNTY TO ACQUIRE THE FEE SIMPLE TITLE TO THE BEDS OF THE STREETS AND/OR ROADS AND FLOODPLAINS AND OPEN SPACE WHERE APPLICABLE; 3) THAT NO BUILDING OR SIMILAR STRUCTURE OF ANY KIND SHALL BE ERECTED ON OR OVER THE SAID EASEMENTS AND RIGHT OF WAYS; AND 4) IT IS FURTHER AGREED THAT MAINTENANCE OF ALL WATERWAYS DRAINAGE EASEMENTS AND/OR FLOODPLAINS SHOWN HEREON ARE THE RESPONSIBILITY OF THE PROPERTY OWNER, ITS SUCCESSORS AND ASSIGNS.

WITNESS OUR HANDS THIS 10TH DAY OF FEBRUARY, 1976.

Edna C. Stevens

Peggy R. Mitchell

Robert R. Mitchell

Stewart D. Young
WITNESS

Robert P. Stevens

SURVEYORS CERTIFICATE

I HEREBY CERTIFY THAT THE FINAL PLAT SHOWN HEREON IS CORRECT, THAT IT IS A RESUBDIVISION OF ALL LANDS CONVEYED BY ROBERT P. STEVENS TO ROBT. P. & EDNA C. STEVENS, BY DEED DATED OCTOBER 10, 1974, AND RECORDED IN THE LAND RECORDS OF HOWARD COUNTY IN LIBER 600 OF FOLIO 468, AND ALSO, ALL OF THE LANDS CONVEYED BY ROBERT P. STEVENS TO ROBERT R. MITCHELL & PEGGY R. MITCHELL BY DEED DATED JULY 7, 1972 AND RECORDED AMONG THE AFORESAID LAND RECORDS IN LIBER 600 AT FOLIO 281, SAID PROPERTY ALSO BEING KNOWN AS LOTS 1 & 2 AS SHOWN ON A PLAT OF SUBDIVISION, RECORDED AMONG THE LAND RECORDS IN LIBER 600 AT FOLIO 282 AND THAT ALL MONUMENTS ARE IN PLACE AS SHOWN IN ACCORDANCE WITH THE ANNOTATED CODE OF MARYLAND, AS AMENDED.

William G. Hartel
WILLIAM G. HARTEL, P.L.S. # 2436



2-12-76
DATE

ENGINEERING
PLANNING
SURVEYING
BY:

BOENDER ASSOCIATES INC.

BALTIMORE, MD. 21043
PHONE: 465-7777

GENERAL NOTES

1. PROPERTY SHOWN HEREON IS LOCATED ON TAX MAP 7, PARCEL 308
2. THE LOTS SHOWN HEREON COMPLY WITH THE MINIMUM OWNERSHIP WIDTH AND LOT AREA AS REQUIRED BY THE MARYLAND STATE HEALTH DEPARTMENT.
3. COORDINATES SHOWN HEREON ARE ASSUMED.
4. DEED REFERENCE: 600/281 AND 600/468.

LOTS 3 & 4 A RESUBDIVISION OF LOTS 1 & 2

ROBERT P. STEVENS PROPERTY

FOURTH ELECTION DISTRICT HOWARD COUNTY, MD.
SCALE: 1" = 100' FEBRUARY 6, 1976

RECORDED PLAT 3420
ON 4-15-76 AMONG THE LAND RECORDS OF
HOWARD COUNTY, MD.

Need plat to be submitted

Final APPLICATION *RETEST*

SEWAGE DISPOSAL TESTING

STATE OF MARYLAND - DEPARTMENT OF HEALTH AND MENTAL HYGIENE

A 29736


P _____

HOWARD COUNTY HEALTH DEPARTMENT
ENVIRONMENTAL HEALTH SERVICES

P.O. BOX 476 ELLICOTT, MARYLAND 21043
TELEPHONE: 992-2330

DISTRICT 4th

DATE 4-13-79

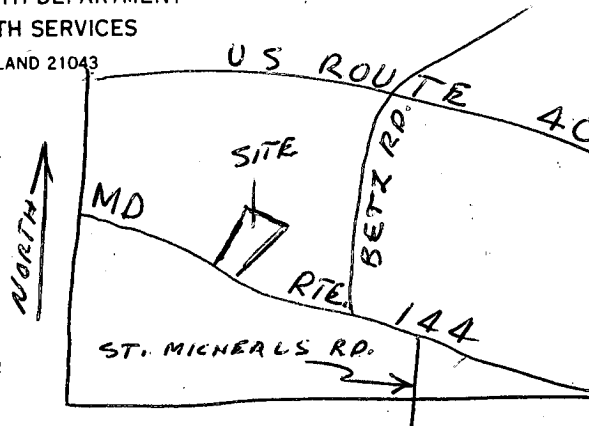

FORMERLY
JAMES BARTON
PROPERTY

TO: THE COUNTY HEALTH OFFICER
ELLICOTT CITY, MARYLAND

I, HEREBY, APPLY FOR THE NECESSARY TEST IN ORDER TO CONSTRUCT (OR RECONSTRUCT) A SEWAGE DISPOSAL SYSTEM.

PROPERTY OWNER

JAMES L. EVERETT

ADDRESS

10704 EASTWOOD AVE
SILVER SPRING, MD. 20901

PHONE

593-3163

PROPERTY LOCATION:

SUBDIVISION

RESUBDIVISION OF LOTS 1 & 2 OF
ROBT. P. STEVENS PROPERTIES ATHELEC. DISTR.

LOT NO.

4

ROAD AND DESCRIPTION

NORTH SIDE OF RT 144 WEST OF POPULAR SPRINGS

PLATT #3720 Recorded 5-19-76
PLATT #3420 Recorded 4-15-76 LIBER 767 FOLIO 143

SIZE OF LOT

3.144 Ac.

TYPE BLDG.

SINGLE FAMILY DWELLING

THE SYSTEM INSTALLED UNDER THIS APPLICATION IS ACCEPTABLE ONLY UNTIL PUBLIC FACILITIES BECOME AVAILABLE.

I FULLY UNDERSTAND THE FEE CONNECTED WITH THE FILING OF THIS PERC TEST APPLICATION IS NON-REFUNDABLE UNDER

ANY CIRCUMSTANCES.

SIGNATURE OF APPLICANT

Charles C. Martin - BUILDER-CONTRACTOR
TERI CONSTR. CO. 876-1401 875-2620

APPROVED BY

Thompson Rodger

FOR

Dry well

DATE

5/5/79

REJECTED BY

FOR



DATE

HOLD PENDING FURTHER TESTS

DATE

REASONS FOR REJECTION OR HOLDING

THIS IS NOT A PERMIT

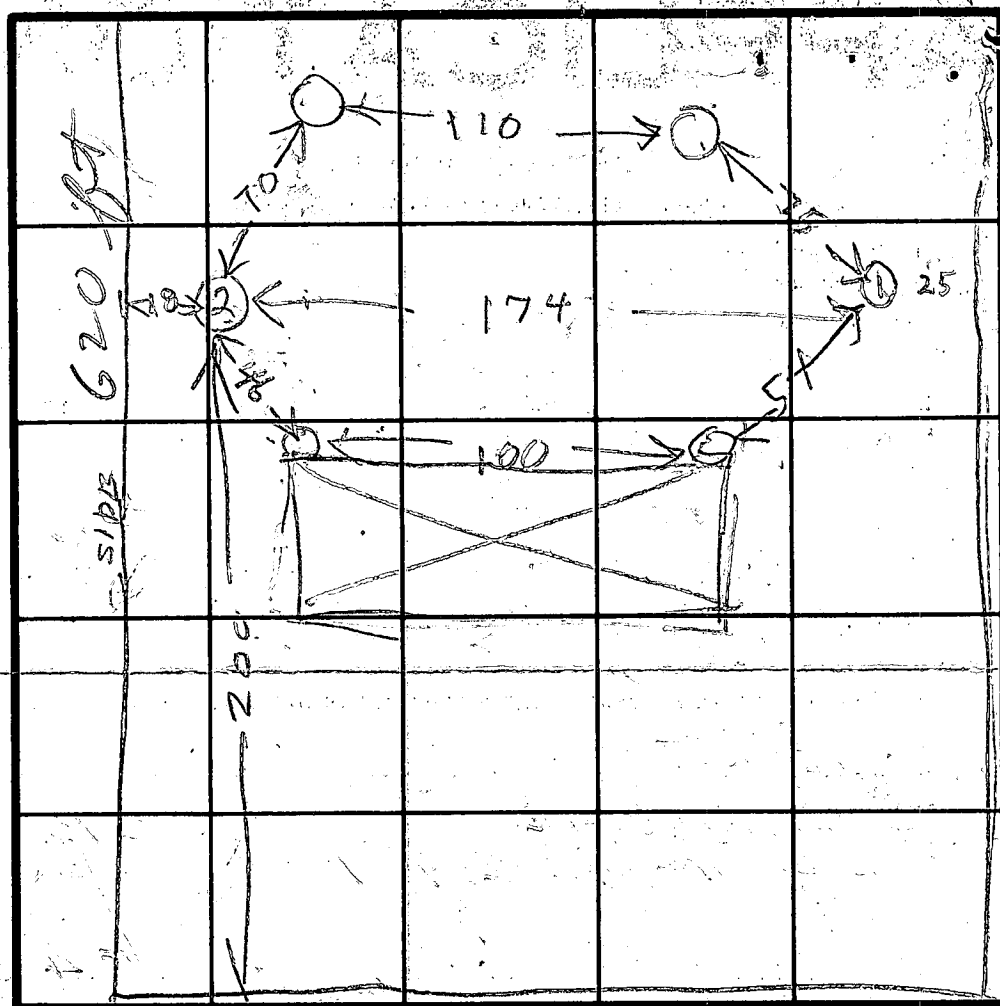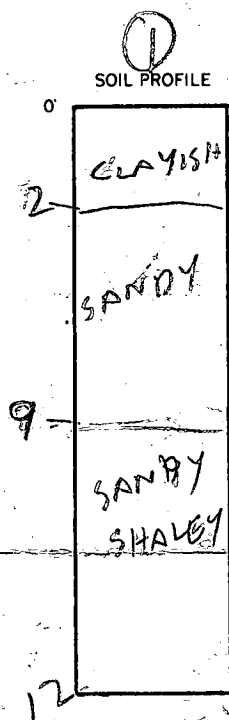

INDICATE NORTH - NAME ADJOINING ROADWAY AS BASE LINE.

ROUTE 144

DATE	TEST NO.	DEPTH	PRE-WET		TEST - 1" DROP		TIME
			START	STOP	START	STOP	
5/4/79	1S	3	1015	1029	1029	1041	12
	1D	7	1107	1109	1109	1113	4
	2S	3	1019	1026	1026	1036	10
	2D	12 1/2	1049	1102	1102	1124	22
5/4/79	1V	12	DRY	SEE	SOIL PROFILE		

REMARKS: Hole ① not tested deep due to cave in
 Retest MR PUSATERI IS OTO CALL IN INFORMATION
 TYPE OF SOIL: SO OLD PERC RESULTS CAN BE CHECKED AT
 TESTED BY: R. HODGES
 ALSO PRESENT: FLOYD SEIZZ
 CHARLES PUSATERI

STATE OF MARYLAND WATER RESOURCES ADMINISTRATION TAWES STATE OFFICE BLDG., ANNAPOLIS, MARYLAND 21401 APPLICATION FOR PERMIT TO DRILL WELL		WRA PERMIT NUMBER HO-73-3365 FILL IN THIS FORM COMPLETELY
1 2 3 (SEQ. NO.) 6 (THIS NUMBER IS TO BE PUNCHED IN COLS. 3-6 ON ALL CARDS) SEQUENCE NO. (WRA USE ONLY) 1241		
DATE RECEIVED (WRA USE ONLY) 7/11/79 1:30 P.M. OWNER <u>Everett</u> COL 15 LAST NAME 25 MA 80 @ P. JUL		
STREET OR RFD <u>10704 East Wood Avenue</u> COL 36 FIRST NAME <u>James</u> COL. 34		
POST OFFICE <u>Silver Spring, Md.</u> COL 57 20909 COL. 55		
8-13 COL. 76		
B 1 CONTINUED 1 2 3 (SEQ. NO.) 6 DRILLER INFORMATION		B 3 1 2 3 (SEQ. NO.) 6 LOCATION OF WELL
DATE <u>June 25, 1979</u> LICENSE NUMBER <u>30</u> 77 80		COUNTY <u>Howard</u> (DO NOT ABBREVIATE COUNTY NAME) 21
FIRST NAME <u>Dana</u> DRILLER <u>Kyler</u> LAST NAME		SUBDIVISION <u>Parcel 469</u> 42
SIGNATURE <u>Dana Kyler</u>		SECTION <u>44</u> LOT <u>4</u> 50
B 2 1 2 3 (SEQ. NO.) 6 WELL INFORMATION		NEAREST TOWN <u>Bridgeville</u> 71
MAXIMUM PUMPING RATE (GALLONS PER MINUTE) <u>500</u> 12		MILES FROM TOWN (ENTER 0 IF IN TOWN) <u>73</u> 76 77 78
AVERAGE DAILY QUANTITY NEEDED (GALLONS PER DAY) <u>14</u> 20		B 4 1 2 3 (SEQ. NO.) 6 DIRECTION FROM TOWN (CIRCLE APPROPRIATE BOX)
USE FOR WATER (CIRCLE APPROPRIATE BOX)		N NORTH E EAST NE NORTHEAST SE SOUTHEAST
D HOME (SINGLE OR DOUBLE HOUSEHOLD UNIT ONLY)		S SOUTH W WEST NW NORTHWEST SW SOUTHWEST
F FARMING, AGRICULTURE, IRRIGATION		NEAR WHAT ROAD <u>17330 Frederick Pike, St.</u>
I INDUSTRIAL, COMMERCIAL, STATE AND FEDERAL GOVERNMENT.		ON WHICH SIDE OF ROAD (CIRCLE APPROPRIATE BOX) N S E W
M MUNICIPAL WATER SUPPLY } MUST HAVE STATE HEALTH DEPT. APPROVAL		DISTANCE FROM ROAD (ENTER DISTANCE AND CIRCLE APPROPRIATE BOX) <u>34</u> 37 38 39
P PRIVATE WATER COMPANY		
T TEST		
APPROXIMATE DEPTH OF WELL <u>160'</u> 24 28 FEET		DRAW A SKETCH BELOW SHOWING LOCATION OF WELL IN RELATION TO NEARBY TOWNS, ROADS AND STREAMS WITH NORTH IN THE DIRECTION OF THE ARROW. AND GIVE DISTANCE FROM WELL TO NEAREST ROAD JUNCTION OR STREAM CROSSING SHOWN ON THE SKETCH. ALSO SHOW, BY MEANS OF AN "X", THE WELL LOCATION IN THE BOX BELOW AND THE BOX NUMBER FROM THE WELL LOCATION MAP.
APPROXIMATE DIAMETER OF WELL <u>6"</u> (NEAREST INCH)		7-11-79 80ft casing 2 ft over ground 66 ft open hole jetted to 77 ft 27 ft measurement at 1 dry location 0.14' sketch
METHOD OF DRILLING USED (CIRCLE APPROPRIATE METHOD)		
BORED (OR AUGERED) JETTED DRIVEN		
30-37 AIR-ROTARY AIR-PERCUSSION ROTARY (HYDRAULIC ROTARY)		
CABLE REVERSE-ROTARY DRIVE-POINT		
OTHER (DESCRIBE)		
REPLACEMENT OR DEEPEENED WELLS (CIRCLE APPROPRIATE BOX)		
N THIS WELL WILL NOT REPLACE AN EXISTING WELL		
Y THIS WELL WILL REPLACE A WELL THAT WILL BE ABANDONED AND SEALED		
S THIS WELL WILL REPLACE A WELL THAT WILL BE USED AS A STANDBY		
D THIS WELL WILL DEEPEN AN EXISTING WELL PERMIT NUMBER OF WELL TO BE REPLACED OR DEEPEENED (IF AVAILABLE)		
41 52		
NOT TO BE FILLED IN BY DRILLER (WRA USE ONLY)		
APPROPRIATION PERMIT NUMBER <u>54</u> ENGINEER REVIEW DISTRICT NO. <u>65</u>		
FORCE <u>67</u> WRITE INITIALS IN BOX CONDITIONS <u>70 71 72 73 74 75 76 77 78 79</u>		
B 4 CONTINUED 1 2 3 (SEQ. NO.) 6 HEALTH DEPARTMENT APPROVAL		BOX NUMBER <u>750</u> 550
41 S STATE HEALTH (CIRCLE BOX) HOWARD W29736 MD		NORTH COORDINATE <u>50 51 52 53 54 55</u>
MO. <u>7</u> DAY <u>9</u> YR. <u>79</u>		EAST COORDINATE <u>57 58 59 60 61 62 63</u>
DATE <u>7/5/79</u> APPROVED BY <u>Red Frommelt, Sanitarian</u>		ELEVATION AT WELL HEAD (FEET) <u>65 66 67 68</u>
B 5 1 2 3 (SEQ. NO.) 6 SPECIAL CONDITIONS 8-63 (WRA USE ONLY)		0/0 5/0

A29736

HEALTH

C 1	1655	SEQUENCE NO. (WRA USE ONLY)	STATE OF MARYLAND WATER RESOURCES ADMINISTRATION TAWES STATE OFFICE BLDG., ANNAPOLIS, MD. 21401 WELL COMPLETION REPORT	THIS REPORT MUST BE SUBMITTED WITHIN 30 DAYS AFTER WELL COMPLETION FILL IN THIS FORM COMPLETELY COUNTY NUMBER <u>1029736</u>
1 2 3 (SEQ. NO.) 6		DATE RECEIVED (WRA USE ONLY) <u>July 11, 1979</u>		
(THIS NUMBER IS TO BE PUNCHED IN COLS. 3-6 ON ALL CARDS)		DATE WELL COMPLETED <u>071179</u>		
8-13		DEPTH OF WELL <u>279</u> (TO NEAREST FOOT) 22 26		
PERMIT NO. FROM "PERMIT TO DRILL WELL" <u>HC-73-3365</u>		28 29 30 31 32 33 34 35 36 37		
DRILLERS IDENTIFICATION NO. <u>296</u>				

OWNER Everett LAST NAME James FIRST NAME
 STREET OR RFD 10704 Hawthood Avenue POST OFFICE Silver Spring, MD 20901

WELL LOG			GROUTING RECORD		PUMPING TEST	
STATE THE KIND OF FORMATIONS PENETRATED, THEIR COLOR, DEPTH, THICKNESS AND IF WATER BEARING			WELL HAS BEEN GROUTED (CIRCLE APPROPRIATE BOX) ☒ YES ☐ NO TYPE OF GROUTING MATERIAL (CIRCLE BOX) CEMENT ☒ BENTONITE CLAY ☐ NO. OF BAGS <u>29</u> NO. OF POUNDS <u>2,726</u> GALLONS OF WATER <u>1274</u> DEPTH OF GROUT SEAL (TO NEAREST FOOT) FROM <u>0</u> FT. TO <u>80</u> FT. (ENTER 0 IF FROM SURFACE)		HOURS PUMPED (TO NEAREST HOUR) <u>4</u> PUMPING RATE (GALLONS PER MINUTE TO NEAREST GALLON) <u>11</u> METHOD USED TO MEASURE PUMPING RATE <u>Flowmeter</u> WATER LEVEL: (DISTANCE FROM LAND SURFACE) BEFORE PUMPING <u>70</u> (NEAREST FOOT) WHEN PUMPING <u>210</u> (NEAREST FOOT)	
DESCRIPTION (USE ADDITIONAL SHEETS IF NECESSARY)			FEET FROM TO CHECK IF WATER BEARING		TYPE OF PUMPED USED (CIRCLE APPROPRIATE BOX) (FOR PUMPING TEST) ☒ AIR ☐ PISTON ☐ TURBINE ☐ CENTRIFUGAL ☐ ROTARY ☐ OTHER (DESCRIBE BELOW) ☐ JET ☐ SUBMERSIBLE	
Dirt 0 4 Soft Brown Schist & Brown & Yellow Sand 4 16 <u>X</u> Soft Brown Schist 16 35 <u>X</u> Hard & Soft, Brown Schist 35 50 <u>X</u> Hard Brown & Blue Schist 50 65 Soft Brown Schist & Sand 65 77 <u>X</u> Hard Blue Schist 77 89 Brown Schist & Flint 89 91 <u>X</u> Blue Schist & Quartz 91 131 Blue Silt & Quartz 131 196 Brown Silt & Quartz 196 197 <u>X</u> Blue Silt & Quartz 197 209			CASING RECORD INSERT APPROPRIATE CODE BELOW STEEL ☒ CONCRETE ☐ PLASTIC ☐ OTHER ☐ MAIN CASING TYPE <u>S</u> <u>2</u> <u>6</u> <u>32</u> NOMINAL DIAMETER TOP (MAIN) CASING (NEAREST INCH) TOTAL DEPTH OF MAIN CASING (NEAREST FOOT)		PUMP INSTALLED TYPE OF PUMP (WRITE APPROPRIATE LETTER IN BOX - SEE ABOVE: A, C, J, P, R, S, T, O) DRILLER WILL INSTALL PUMP (CIRCLE APPROPRIATE BOX) CAPACITY: GALLONS PER MINUTE (TO NEAREST GALLON) <u>31</u> <u>35</u> PUMP HORSE POWER <u>37</u> <u>41</u> PUMP COLUMN LENGTH (NEAREST FOOT) <u>43</u> <u>47</u>	
OTHER CASING (IF USED) DIAMETER (INCH) FROM TO SCREEN TYPE OR OPEN HOLE INSERT APPROPRIATE CODE BELOW STEEL ☐ BRASS OR BRONZE ☐ OPEN HOLE ☐ PLASTIC ☐ OTHER ☐			SCREEN RECORD INSERT APPROPRIATE CODE BELOW STEEL ☐ BRASS OR BRONZE ☐ OPEN HOLE ☐ PLASTIC ☐ OTHER ☐		CASING HEIGHT (CIRCLE APPROPRIATE BOX AND ENTER CASING HEIGHT) ☒ ABOVE ☐ BELOW LAND SURFACE <u>2</u> (NEAREST FOOT) 49 50 51	
CIRCLE APPROPRIATE BOXES ☐ A WELL WAS ABANDONED AND SEALED WHEN THIS WELL WAS COMPLETED ☐ E ELECTRIC LOG OBTAINED ☐ P TEST WELL CONVERTED TO PRODUCTION WELL			LOCATION OF WELL ON LOT SHOW PERMANENT STRUCTURE SUCH AS BUILDINGS, SEPTIC TANKS, AND/OR OTHER LAND MARKS AND INDICATE NOT LESS THAN TWO DISTANCES (MEASUREMENTS TO WELL).		I HEREBY CERTIFY THAT I HAVE COMPLIED WITH ALL CONDITIONS STATED ON THE ABOVE-CAPTIONED "PERMIT TO DRILL WELL", AND THAT INFORMATION CONTAINED IN THIS REPORT IS TRUE, ACCURATE, AND COMPLETE TO THE BEST OF MY KNOWLEDGE, INFORMATION AND BELIEF.	
DRILLERS NAME <u>Ronald Lee Kyker</u> SIGNATURE <u>Ronald Lee Kyker</u>			WRA USE ONLY (NOT TO BE FILLED IN BY DRILLER) (E.R.O.S.) ☐ W-O ☐ LOG INDICATOR <u>72</u> <u>74</u> <u>75</u> <u>76</u> OTHER DATA AVAILABLE		DEPTH (NEAREST WHOLE FOOT) FROM <u>82</u> TO <u>279</u> 1 2 3 51	

HEALTH

274.38'

Chas. P.

100.13*

Lot # 4

Tax Map # 77
Parcel 461

101.13*



17330 FREDERICK PIKE
ROUTE 144

I certify these elevations are true
and correct
Charles Pusater Presi.
Teri Constr. Inc.

106.13

106.13


ELEV. EXISTING + AT PERC. TIME 108.67'
105.67
106.67 (INV.)

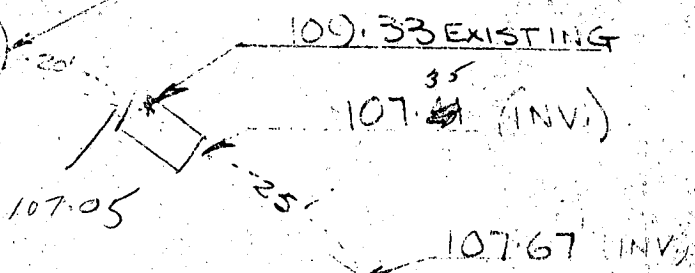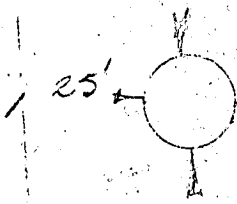

103.23*

20'		
FIRST FLOOR	118.33	GARAGE
BASEMENT	109.33	

96.34'

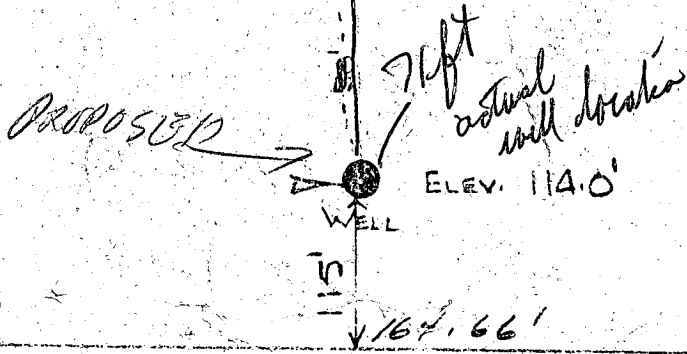

5/21/79
Plans Rejected

See plan

Property of JAS. EVERETT
Mail CORRESPONDENCE TO:-

PHONE 875-2620
848-2445
21776

TERI CONSTR. CO. 3938 Sam's Ck. Rd. New Windsor, Md.

Fill out in duplicate.
Make \$30.00 check payable to:
Howard County Health Dept. - Sanitation

APPLICATION

A 23165

P _____

SEWAGE DISPOSAL TESTING

STATE OF MARYLAND - DEPARTMENT OF HEALTH AND MENTAL HYGIENE

HOWARD COUNTY HEALTH DEPARTMENT
ENVIRONMENTAL HEALTH SERVICES

P. O. BOX 476, ELLICOTT CITY, MARYLAND 21043
TELEPHONE: 465-5000, EXT. 356

DISTRICT 3RD 4th

DATE 4-26-76

5/7/76
1:30

DW: 125 ft per bedroom
inlet to DW @ 3', max depth of DW 12'
Locate DW 169' ft Rt 144, and 40' from
left lot line as seen when facing lot from
Rt 144.

TO: THE COUNTY HEALTH OFFICER
ELLICOTT CITY, MARYLAND

RETESTED UNDER NAME
OF JAMES EVERETT

I, HEREBY, APPLY FOR THE NECESSARY TEST IN ORDER TO CONSTRUCT (OR RECONSTRUCT) A SEWAGE
DISPOSAL SYSTEM. SEE RETEST SHEET

PROPERTY OWNER

R.P. STEVENS James Barton

ADDRESS

Time Kilo Rd Fulton Md.

PHONE

725-0354

PROPERTY LOCATION:

11421 Columbia Pike

SUBDIVISION

Silver Spring, Md. 20904

ROAD AND DESCRIPTION

Rt. 144 west of Poplar Springs (North side of 144)

SIZE OF LOT

3.144 ACRES

TYPE BLDG.

SINGLE family dwelling
NUMBER OF BEDROOMS _____

IF NOT SINGLE RESIDENCE DESCRIBE _____

THE SYSTEM INSTALLED UNDER THIS APPLICATION IS ACCEPTABLE ONLY UNTIL PUBLIC
FACILITIES BECOME AVAILABLE.

SIGNATURE OF APPLICANT

James A. Barton

APPROVED BY

William H. Zapp

FOR

D.W.

DATE

10/6/78

(KIND OF SYSTEM)

REJECTED BY _____

FOR _____

DATE _____

(KIND OF SYSTEM)

HOLD PENDING FURTHER TESTS

WWZ or HB

DATE

5/7/76

REASONS FOR REJECTION OR HOLDING

final plat

THIS IS NOT A PERMIT

APPLICATION

A 23165

P _____

SEWAGE DISPOSAL TESTING

STATE OF MARYLAND - DEPARTMENT OF HEALTH AND MENTAL HYGIENE

HOWARD COUNTY HEALTH DEPARTMENT
ENVIRONMENTAL HEALTH SERVICESP. O. BOX 476, ELLICOTT CITY, MARYLAND 21043
TELEPHONE: 465-5000, EXT. 356DISTRICT 3RDDATE 4-26-76TO: THE COUNTY HEALTH OFFICER
ELLICOTT CITY, MARYLANDI, HEREBY, APPLY FOR THE NECESSARY TEST IN ORDER TO CONSTRUCT (OR RECONSTRUCT) A SEWAGE
DISPOSAL SYSTEM.PROPERTY OWNER R.P. StevensADDRESS Lime Kiln Rd Fulton Md. PHONE 725-0354

PROPERTY LOCATION:

SUBDIVISION Opposite old barn foundation (Webb Prop.) LOT NO. _____ROAD AND DESCRIPTION Rt. 144 west of Poplar Springs (North side of 144)SIZE OF LOT 3.144 ACRES TYPE BLDG. SINGLE family dwelling
NUMBER OF BEDROOMS _____

IF NOT SINGLE RESIDENCE DESCRIBE _____


THE SYSTEM INSTALLED UNDER THIS APPLICATION IS ACCEPTABLE ONLY UNTIL PUBLIC
FACILITIES BECOME AVAILABLE.SIGNATURE OF APPLICANT James A. BortonAPPROVED BY _____ FOR _____ DATE _____
(KIND OF SYSTEM)REJECTED BY _____ FOR _____ DATE _____
(KIND OF SYSTEM)

HOLD PENDING FURTHER TESTS _____ DATE _____

REASONS FOR REJECTION OR HOLDING _____

THIS IS NOT A PERMIT

Trees

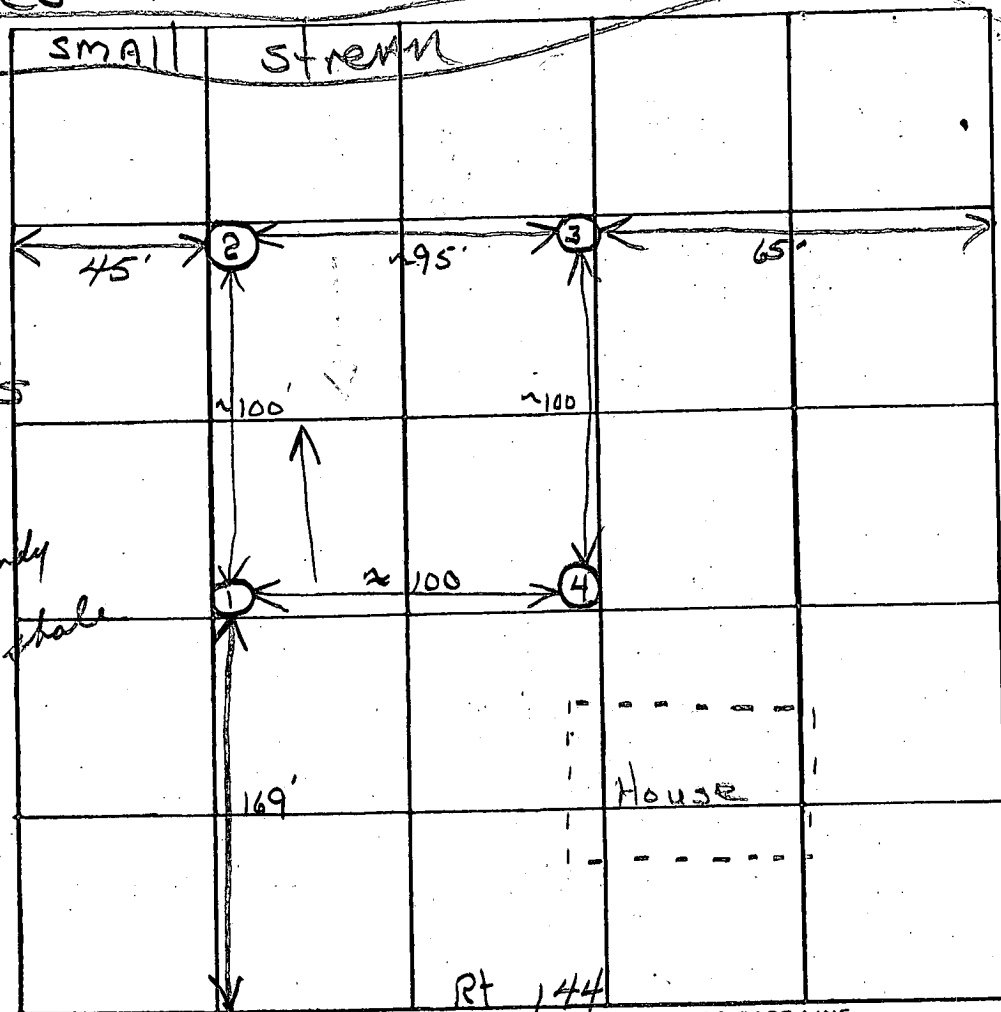

INDICATE NORTH. - NAME ADJOINING ROADWAY AS BASE LINE.

DATE	TEST NO.	DEPTH	PRE-WET		TEST - 1" DROP		TIME
			START	STOP	START	STOP	
MAY 7/26	1s	4	2 00	2 01	2 01	2 03	2
	1d	13	2 00	2 01	2 01	2 04	3
	2s	3 1/2	2:05	2:06	2 06	2:08	2
	2d	12 1/2	2:05	2:09	2:09	2:14	5
	3s	3 1/2	2 17	2:20	2 20	2:23	3
	3d	12 1/2	2 17	2 19	2 19	2:27	8
	4v	12 1/2	similar soil - dry				

REMARKS system in either #1 or #4 (choice of owner)

TYPE OF SOIL

TESTED BY hb & wwz

ALSO PRESENT: Arnold, Barton