

12-9-96
ASAP Repair

PERMIT

SEWAGE DISPOSAL SYSTEM

DEPARTMENT OF HEALTH AND MENTAL HYGIENE

HOWARD COUNTY HEALTH DEPARTMENT

BUREAU OF ENVIRONMENTAL HEALTH

~~461-8933~~ 313-2640

INDEXED

P 57574D

A REPAIR

DISTRICT _____

DATE 11/25/96

DATE SYSTEM APPROVED 12/9/96

INSPECTOR M. R. Pitkin

Jack Fyock Septic Service

IS PERMITTED TO INSTALL _____ ALTER X

ADDRESS 4105 Ten Oaks Road Glenelg, MD 21737 PHONE 988-9270

SUBDIVISION Burntwoods LOT 3, Sect. 1 ROAD 14120 Burntwoods Road

PROPERTY OWNER Mr. Harig

ADDRESS _____

SEPTIC TANK CAPACITY 1250 GALLONS

NUMBER OF BEDROOMS 4

125 SQUARE FEET PER BEDROOM

LINEAR FEET OF TRENCH REQUIRED 83+

REPAIR - PURPOSE - DRYWELLS HAVE FAILED.

Call for inspection when ground is opened so sanitarian can recommend repair. 11/25/96

PLANS APPROVED BY _____ DATE _____

COVER NO WORK UNTIL INSPECTED AND APPROVED

NEITHER THE HOWARD COUNTY COUNCIL NOR THE HEALTH DEPARTMENT IS RESPONSIBLE FOR THE SUCCESSFUL OPERATION OF ANY SYSTEM

NOTE: CLEANOUT REQUIRED EVERY 70 FEET OF SEWER LINE AND/OR AT 90° SWEEPS IN LINES FROM HOUSE TO DRAIN FIELDS, 90° ELBOWS NOT ACCEPTABLE.

NOTE: ALL PARTS OF SEPTIC SYSTEMS (I.E. TANK, DISTRIBUTION BOX TRENCHES) TO BE 100 FEET FROM WELL (UNLESS OTHERWISE SPECIFICALLY AUTHORIZED)

NOTE: IF DEEP TRENCH(ES) ARE USED CALL FOR INSPECTION BEFORE AND AFTER PLACING GRAVEL IN TRENCH(ES)

NOTE: NO DRY WELL SHALL EXCEED 15 FOOT IN DIAMETER NO ABSORPTION TRENCH TO EXCEED 100 FEET IN LENGTH

NOTE: ALL PIPE FROM HOUSE TO SEPTIC TANK MUST BE CAST IRON OR SCHEDULE 35/40 PVC OR ABS


PERMIT VOID AFTER TWO YEARS

NOTE: INSTALL STAND PIPE ON SEPTIC TANK AND DRY WELL STAND PIPES MUST BE 6 INCHES IN DIAMETER CAST IRON. CONCRETE OR TERRA COTTA OR PVA OR ABS ACCEPTED. IF TOP OF SEPTIC TANK IS DEEPER THAN 3 FEET. MANHOLE TO GRADE REQUIRED.

NOTE: DISTRIBUTION BOXES MUST HAVE BAFFLES

***INSTALLER IS RESPONSIBLE FOR OBTAINING FINAL APPROVAL ON THIS PERMIT**

R 57574D

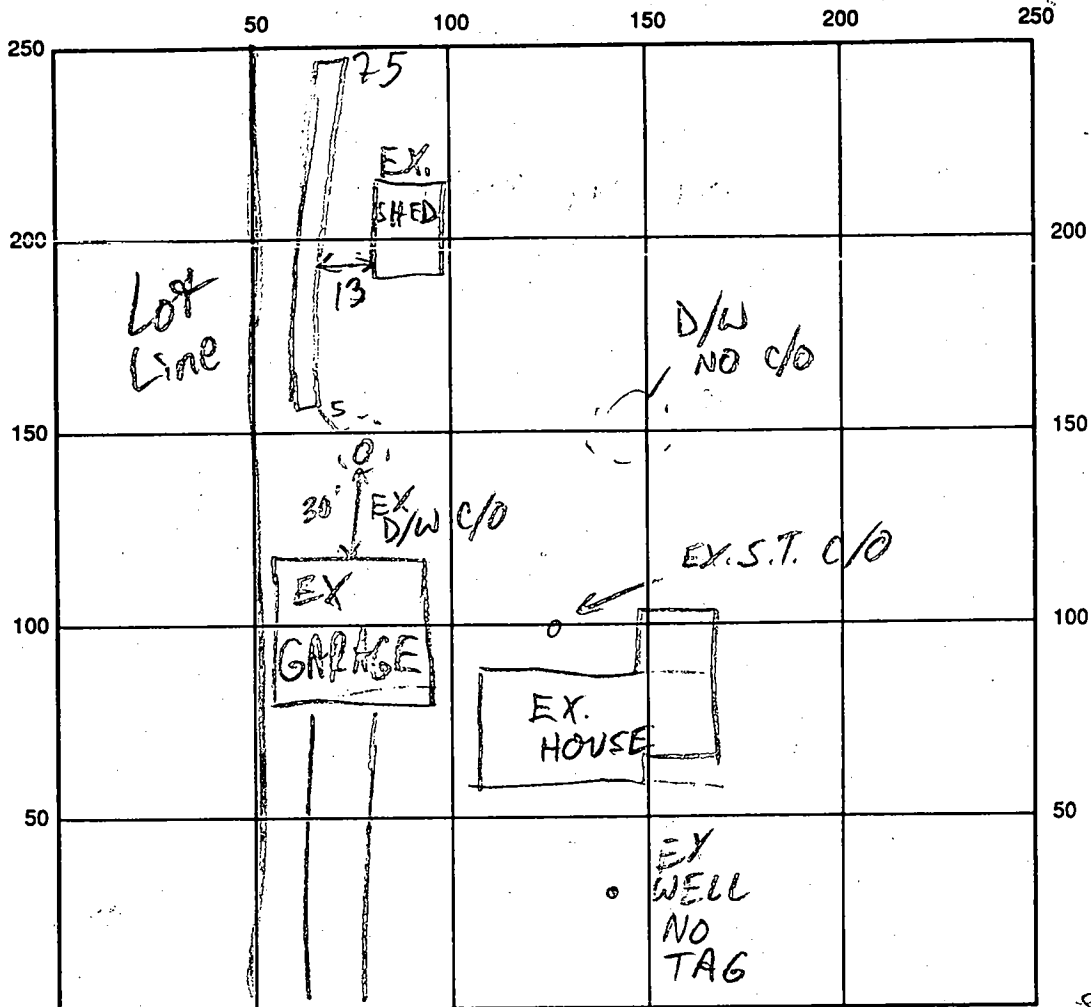

BURNT WOODS RD

INDICATE NORTH - NAME ADJOINING ROADWAY AS BASE LINE

→ SHARP RD

SEPTIC TANK LEVEL EX-1250 GAL CLEANOUTS OK

DISTRIBUTION BOX LEVEL —

DRAIN FIELD/TITLE DEPTH 11 FT. TRENCH WIDTH 2 FT. INLET DEPTH 5 FT.

EFFECTIVE GRAVEL DEPTH 6 FT. TOTAL LENGTH 75 FT.

NUMBER OF TRENCHES 1 ONE SIDEWALL/BOTTOM AREA 450 SQ. FT.

DRYWALL INSIDE DIAMETER — FT. EFFECTIVE DEPTH BELOW INLET — FT.

ABSORBENT AREA 450 SQ. FT.

REMARKS: 12/9/96 #1 OK TO CONTINUE MR

12/9/96 #2 OK TO COVER MR

DATE SYSTEM APPROVED 12/9/96 INSPECTOR M. Rifkin

PERMIT

SEWAGE DISPOSAL SYSTEM

MARYLAND STATE DEPARTMENT OF HEALTH

HOWARD COUNTY

INDEXED

ELLCOTT CITY

DISTRICT 3

DATE 2-26-73

Jack Fyrak

IS PERMITTED TO INSTALL 1 ALTER 0

ADDRESS Ten Oaks Rd., Glenage, Md 21737

PHONE 286-2939

A SEWAGE DISPOSAL SYSTEM LOCATED AT _____

SUBDIVISION BURNT WOODS

ROAD 14100 14100 Burnt Woods Rd.

LOT 3

PROPERTY OWNER Burnt Woods Development Co. Inc.

ADDRESS 212 Greenwood Rd., E.C.,

Mr. + Mrs. Dale Harris

SPECIFICATIONS 4 - Bedrooms

DRAIN FIELD _____ DEPTH _____ FEET, BOTTOM AREA _____ SQ. FT.

SEEPAGE PITS _____ ABSORBENT SIDE WALL AREA _____ SQ. FT.

SEPTIC TANK CAPACITY 1200 GALLONS

FOR GARBAGE GRINDER, INCREASE DISPOSAL AREA 25% & TANK CAPACITY 50%.

OTHER Two Dry Wells--dig each pit 15 ft. sq. set block - top for 12 ft. diameter fill in rest of pit with gravel. Each dry well to have 5 ft. effective depth of the first 6 ft. of non absorbent ground. Maximum depth for Dry Wells is 12 ft. below original grade.

Place each Dry Well 145 ft. from front lot line with first dry well about 75 ft. from left side line and second dry well about 75 ft. from left side line. Wells must be 45 ft. apart edge to edge and connected in series.

NOTE: ALL PIPE FROM HOUSE TO TANK MUST BE CAST IRON.

PERMIT VOID AFTER THREE YEARS.

PLANS APPROVED BY Donald W. Monaghan

DATE 4-16-64

FILL SEPTIC TANK AND DISTRIBUTION BOX WITH WATER BEFORE CALLING FOR AN INSPECTION. COVER NO WORK UNTIL INSPECTED AND APPROVED.

NEITHER THE HOWARD COUNTY COMMISSIONERS NOR THE HEALTH DEPARTMENT IS RESPONSIBLE FOR THE SUCCESSFUL OPERATION OF ANY SYSTEM.

BLDG. PERMIT SIGNED
AND RETURNED 4/23

Serial # 48976
family room

BLDG. PERMIT SIGNED
AND RETURNED 4/4/62

Serial # 43202
Garage


BLDG. PERMIT SIGNED

AND RETURNED 4/23/62

Serial # 42520

deck

40222

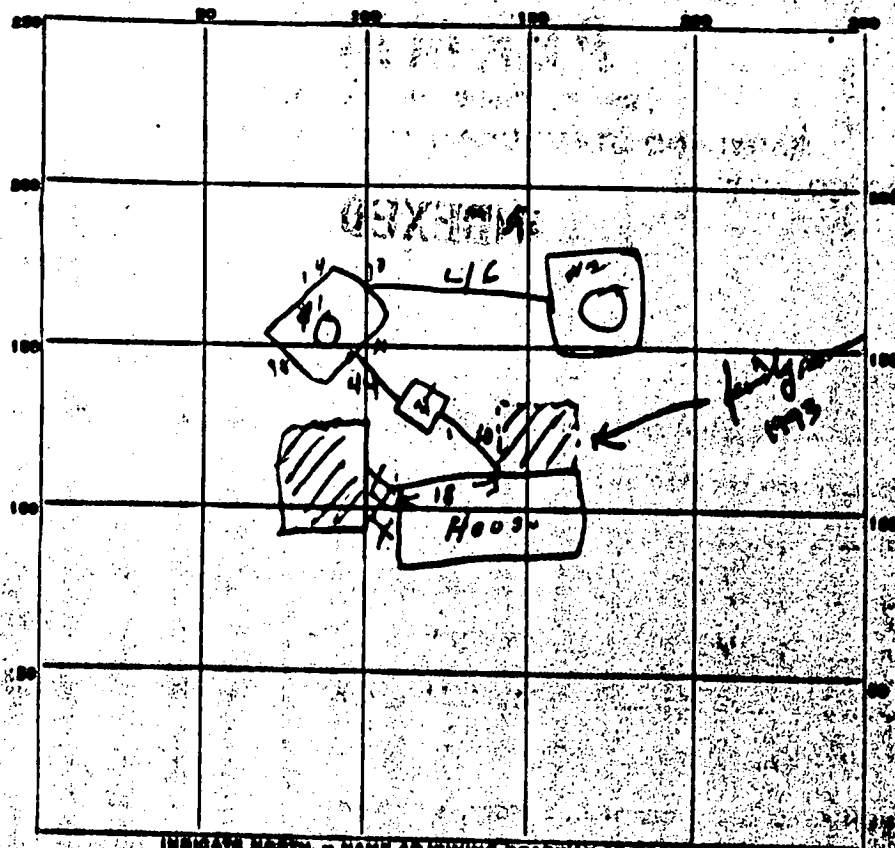

PERMIT CARD OK

SEPTIC TANK, LEVEL _____

CLEANOUTS 9.14

DISTRIBUTION BOX, LEVEL

TILE FIELD, DEPTH _____ FT. TRENCH WIDTH _____ FT.

GRAVEL DEPTH _____ IN. TOTAL LENGTH _____ FT

NUMBER OF TRENCHES _____ TOTAL BOTTOM AREA _____

SEEPAGE PITS, INSIDE DIAMETER _____ FT. DEPTH BELOW INLET _____ FT.

ABSORBENT AREA _____ SQ. FT.

REMARKS 7-16-71 Dig Well #1 - Penetration 60 ft + 5' 1/2" effective depth 310+ } 600+ sq ft
Dig Well #2 " 60 ft + 5 ft effective depth 300+ } additional

DATE SYSTEM APPROVED 3-16-71

...INSPECTOR W. J. M. M. M.