

APPLICATION

SEWAGE DISPOSAL TESTING

MARYLAND STATE DEPARTMENT OF HEALTH

A 09615

P

HOWARD COUNTY

ELLICOTT CITY

DISTRICT 3

DATE 2/8/65

3 bedrooms
Dry well 12 ft. in diam. by 10 ft deep below the inlet pipe located 190 ft. from the front property line and 18 ft. from the right side property line as seen when facing the lot from Tolly Quarter Drive. Locate inlet 4 ft. below original grade. 750 gal. septic tank.

TO: THE COUNTY HEALTH OFFICER
ELLICOTT CITY, MARYLAND

I, HEREBY, APPLY FOR THE NECESSARY TESTS IN ORDER TO CONSTRUCT (OR RECONSTRUCT) A SEWAGE DISPOSAL SYSTEM.

PROPERTY OWNER Walter A. Shank

ADDRESS Avoca Ave., Ellicott City, Md. PHONE HO 5-3464

PROPERTY LOCATION:

SUBDIVISION ~~XXXXXXXXXXXX~~ Shepherds Glen LOT NO. 13

ROAD AND DESCRIPTION ~~XXXXXXXXXXXX~~ Walt-Ann Drive

OCCUPANT _____ PHONE _____

PERSON TO CONSTRUCT SYSTEM _____

ADDRESS _____ PHONE _____

SIZE OF LOT 1.08 acres TYPE BLDG. 3 or 4
NUMBER OF BEDROOMS

IF NOT SINGLE RESIDENCE DESCRIBE _____

SIGNATURE OF APPLICANT /s/ Walter A. Shank


APPROVED BY [Signature] FOR Dry Well DATE 5-27-65
(KIND OF SYSTEM)

REJECTED BY _____ FOR _____ DATE _____
(KIND OF SYSTEM)

HOLD PENDING FURTHER TESTS _____ DATE _____

REASONS FOR REJECTION OR HOLDING _____

THIS IS NOT A PERMIT

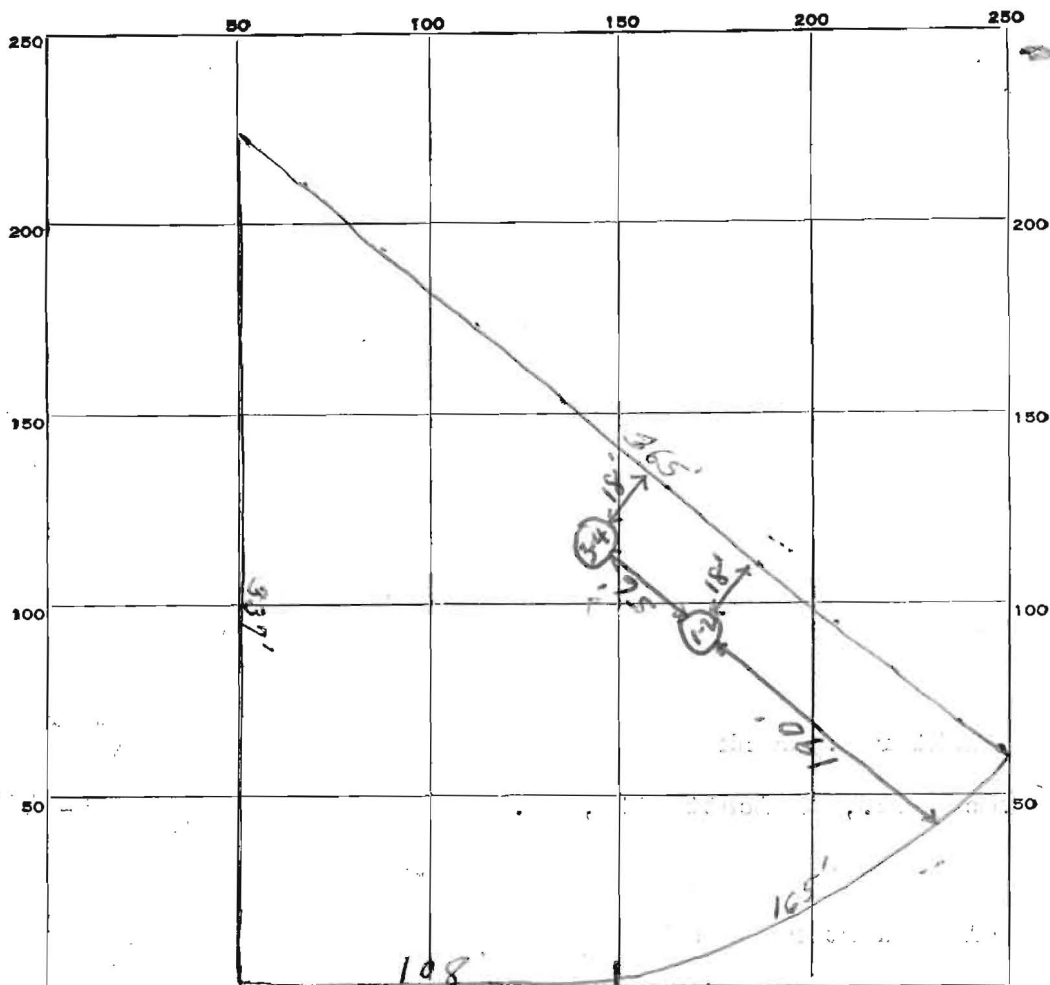

INDICATE NORTH. - NAME ADJOINING ROADWAY AS BASE LINE.

FOLLY QTR. DRIVE

DATE	TEST NO.	DEPTH	PRE-WET		TEST - 1" DROP		TIME
			START	STOP	START	STOP	
2-24-65	1 Same	10'	2:28	2:34	2:34	2:41	7
	2 Pit	5 1/2'	2:27	2:38	2:38	2:51	13
	3 Same	6'	2:33	2:36	2:36	2:41	5
	4 Pit	12'	2:34	2:49	2:49	3:10	21

av. perc
Time 11.5 Min

SOIL AUGER FINDING

TESTED BY

J.H. + J.K.

REMARKS

good soil starts at 4 FT. below top.

ALSO PRESENT

Daniel Miller

LOT NO.

13