

Pa. #330

PUB. SEWER STATUS VERIFIED BY _____

ISSUE DATE: 6/23/2005

APPROVAL DATE: 8/4/2005

PERMIT

INDEXED

02-379058

P 522547

A REPAIR/30936

**ON-SITE SEWAGE DISPOSAL SYSTEM
HOWARD COUNTY HEALTH DEPARTMENT
BUREAU OF ENVIRONMENTAL HEALTH**

Farm & Homes Excavating, Inc. IS PERMITTED TO INSTALL ☐ ALTER ☒

ADDRESS: 901 Driver Road, Marriottsville PHONE NUMBER: 410-442-2139

SUBDIVISION: 3173 St. Charles Place LOT NUMBER: 106

ADDRESS: Terra Maria PROPERTY OWNER: Peter Horowitz

SEPTIC TANK CAPACITY (GALLONS): _____

PUMP CHAMBER CAPACITY (GALLONS): _____

NUMBER OF BEDROOMS: 4

SQUARE FEET PER BEDROOM: 180

LINEAR FEET OF TRENCH REQUIRED: 120

2' Wide
Inlet 5'
Bottom 10'
2-60' Trenches

TRENCHES:	Trench to be _____ feet wide. Inlet _____ feet below original grade. Bottom maximum depth _____ feet below original grade. Effective area begins at _____ feet below original grade. _____ feet of stone below distribution pipe.
LOCATION:	
PURPOSE:	Existing septic system has failed. Call for inspection when ground is opened so sanitarian can recommend repair.

PLANS APPROVED: _____ DATE: _____

NOTE: PERMIT VOID AFTER 2 YEARS

NOTE: CONTRACTOR RESPONSIBLE FOR SCHEDULING A PRE-CONSTRUCTION INSPECTION FOR ALL INSTALLATIONS

NOTE: WATERTIGHT SEPTIC TANKS REQUIRED


NOTE: ALL PARTS OF SEPTIC SYSTEM SHALL BE 100 FEET FROM ANY WATER WELL

NOTE: MANHOLE RISERS REQUIRED ON ALL SEPTIC TANKS AND PUMP CHAMBERS

**NEITHER THE HOWARD COUNTY COUNCIL OR THE HEALTH DEPARTMENT IS
RESPONSIBLE FOR THE SUCCESSFUL OPERATION OF ANY SYSTEM
PERMITTEE RESPONSIBLE FOR OBTAINING FINAL APPROVAL ON THIS PERMIT
CALL 410-313-2640 FOR INSPECTION OF SEPTIC SYSTEM**

PS 22547
A30436

NOT TO SCALE

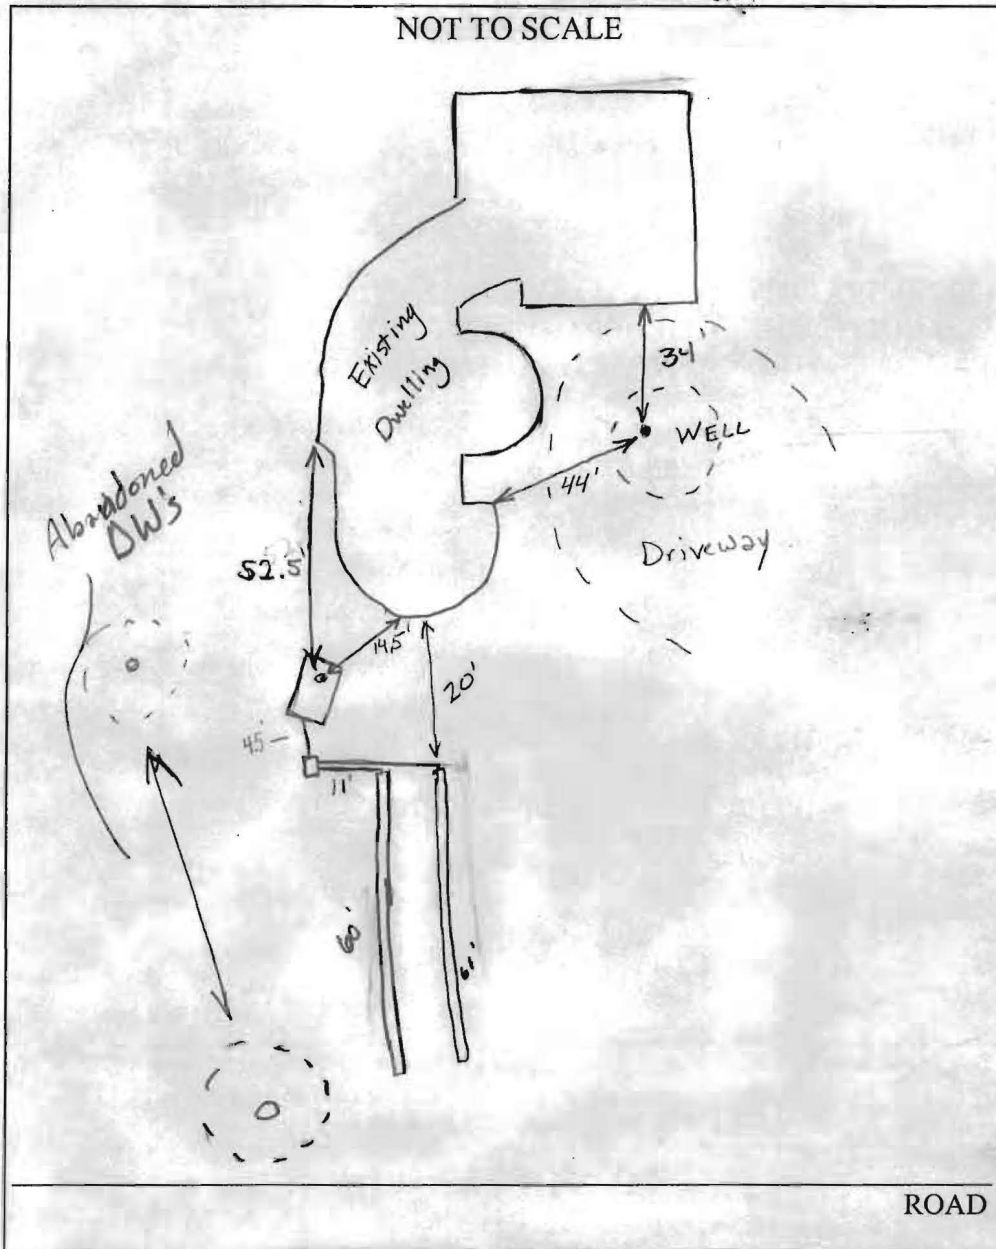

TRENCH/DRAINFIELD DATA		
WIDTH	INLET	BOTTOM
2	5	10
NUMBER OF TRENCHES		2
TOTAL LENGTH		
ABSORPTION AREA		
DISTRIBUTION BOX LEVEL		✓
DISTRIBUTION BOX BAFFLE		
DISTRIBUTION BOX PORT		No

SEPTIC TANK DATA	
SEPTIC TANK 1 LEVEL	?
Existing CAPACITY	1000 GAL
SEAM LOC	M10
TANK LID DEPTH	
BAFFLES	✓
BAFFLE FILTER	N/A
MANHOLE LOC	N/A
6" PORT LOC	Front
WATERTIGHT TEST	?
SEPTIC TANK 2 LEVEL	
CAPACITY	GAL
SEAM LOC	
TANK LID DEPTH	
BAFFLES	
BAFFLE FILTER	
MANHOLE LOC	
6" PORT LOC	
WATERTIGHT TEST	

PRE-CONSTRUCTION 6/30/05 Install 2 - 60' trenches on contour away from house. Start trenches near where existing distribution box is. Fill in drywells with dirt or gravel after they are pumped out. Well is buried to top of cap in bushes in driveway circle. (BB)

8/3/05 am 1st trench dug halfway! 8/3/05 pm 1st trench finished ok to cover. (GAC) 8/4/05 2nd trench done lines finished, d-box grouted. Drywells pumped & filled. (GAC)

FINAL INSPECTOR Garth A. Aegler DATE OF APPROVAL 8/4/05