

APPLICATION

SEWAGE DISPOSAL TESTING

STATE OF MARYLAND - DEPARTMENT OF HEALTH AND MENTAL HYGIENE

A 30936

P _____

HOWARD COUNTY HEALTH DEPARTMENT
ENVIRONMENTAL HEALTH SERVICES

P.O. BOX 476 ELLICOTT, MARYLAND 21043
TELEPHONE: 992-2330

SEE ATTACHED SHEET FOR SPECS

DISTRICT 2

DATE 9/17/80

BLDG. PERMIT SIGNED
AND RETURNED 9/27/81
Serial # 472 48
Swimming Pool.

BLDG. PERMIT SIGNED
AND RETURNED 5/12/81
Serial # 461 75

TO: THE COUNTY HEALTH OFFICER
ELLICOTT CITY, MARYLAND

I, HEREBY, APPLY FOR THE NECESSARY TEST IN ORDER TO CONSTRUCT (OR RECONSTRUCT) A SEWAGE DISPOSAL SYSTEM.

PROPERTY OWNER MR + MRS ROBERT J. LANCELLOTTA

ADDRESS 2121 OAK LODGE RD PHONE 788-4344

PROPERTY LOCATION: 21229 0 485-8300

SUBDIVISION _____ LOT NO _____

ROAD AND DESCRIPTION BETWEEN RT 40 WEST AND 144

DIRECTLY ACROSS FROM TRUNNOR LANE NORTH NEAR THRIFT SHOP

SIZE OF LOT 55 ACRES TYPE BLDG. 4 Bedroom HOUSE

THE SYSTEM INSTALLED UNDER THIS APPLICATION IS ACCEPTABLE ONLY UNTIL PUBLIC FACILITIES BECOME AVAILABLE.

I FULLY UNDERSTAND THE FEE CONNECTED WITH THE FILING OF THIS PERC TEST APPLICATION IS NON-REFUNDABLE UNDER

ANY CIRCUMSTANCES.

SIGNATURE OF APPLICANT Robert J. Lancellotta

APPROVED BY Raymond Hodges FOR _____ DATE _____

REJECTED BY _____ FOR _____ DATE _____

HOLD PENDING FURTHER TESTS _____ DATE _____



REASONS FOR REJECTION OR HOLDING 10/17/80 - FS SAID PERC TIME OK

BUT CERTIFIED HOLES & PLAT NEEDED TOLD

LANCELLOTTA SOMETHING RH 2/2/81 PERC

PLAT SIGNED

THIS IS NOT A PERMIT

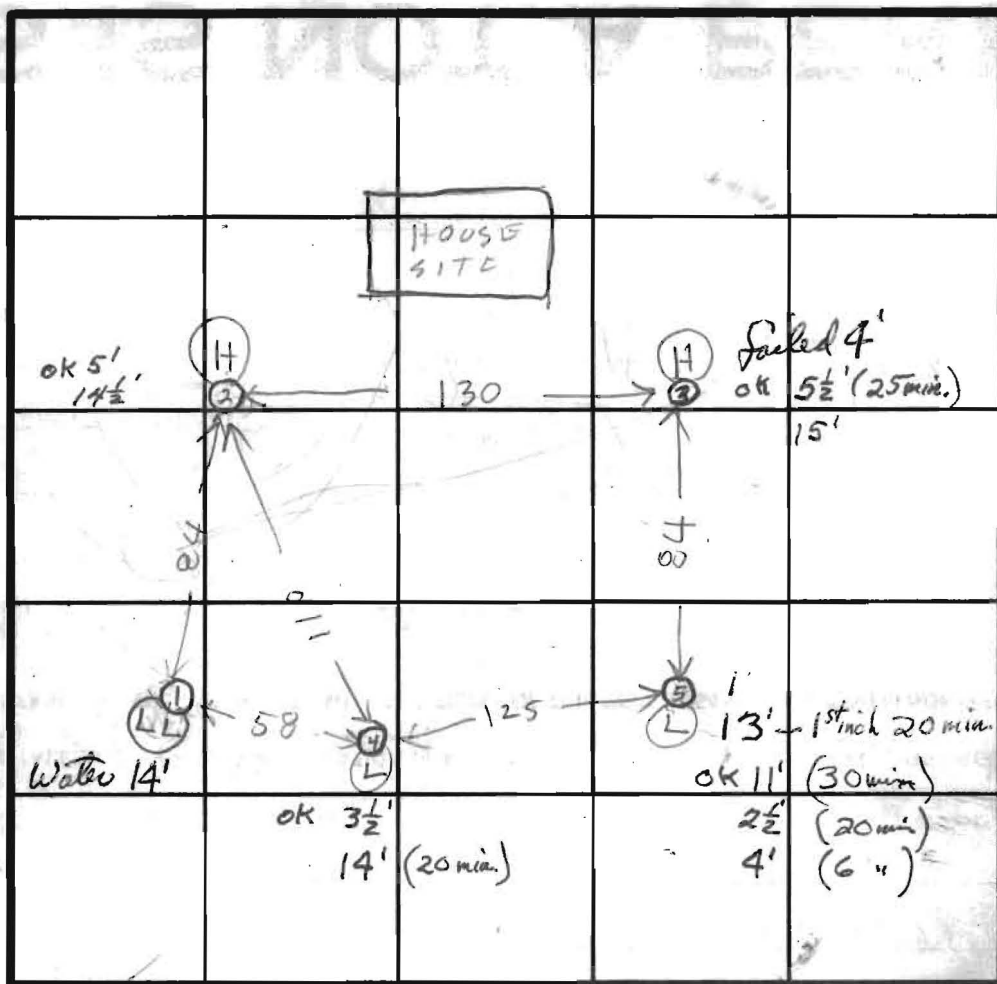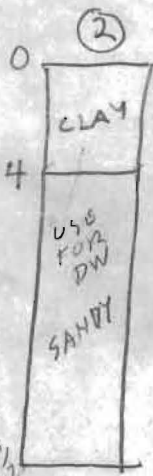

Hole Elevations
 H = High about Same
 L = Low about same
 LL = Lowest

INDICATE NORTH - NAME ADJOINING ROADWAY AS BASE LINE.

DATE	TEST NO.	DEPTH	PRE-WET		TEST - 1" DROP		TIME
			START	STOP	START	STOP	
10/7/80	1 S	5	1010	1015	1015	1020	5
	1 V	1 1/4	WATER		14 FT		
	2 D	14 1/2	1023	1025	1025	1028	3
	2 S	5	1024	1027	1027	1030	3
	3 D	1 1/2	1042	1044	1044	1047	3
	3 S	4	1045	1100	LITTLE PERL FAIL		
	4 S	3 1/2	1106	1109	1109	1112	3
	4 D	1 1/4	1106	1122	1123	1142	20
	3 M	5 1/2	1120	1140	1140	1205	25
	5 S	4	1147	1148	1148	1154	6
10/7/80	5 D	1 3/4	1147	1207	1ST INCH 20 MIN		
	5 FS	2 1/2	1230	1240	1240	1200	20
	* 5 M	11	1255	110	1ST INCH 15 MIN		

* HAD TO LEAVE FOR ANOTHER APPOINTMENT

REMARKS 10/7/80 a little difficult to find BH, NO Boundary plat

TYPE OF SOIL copy 9 Castles

BROWN & RAYMOND OF COSTELLO CO

TESTED BY R. HODGES

ALSO PRESENT LANCET LOTTA