


SHANABERGER & LANE
8726 TOWN & COUNTRY BVD
SUITE 104
ELLICOTT CITY, MD 21043
(410) 461-9563

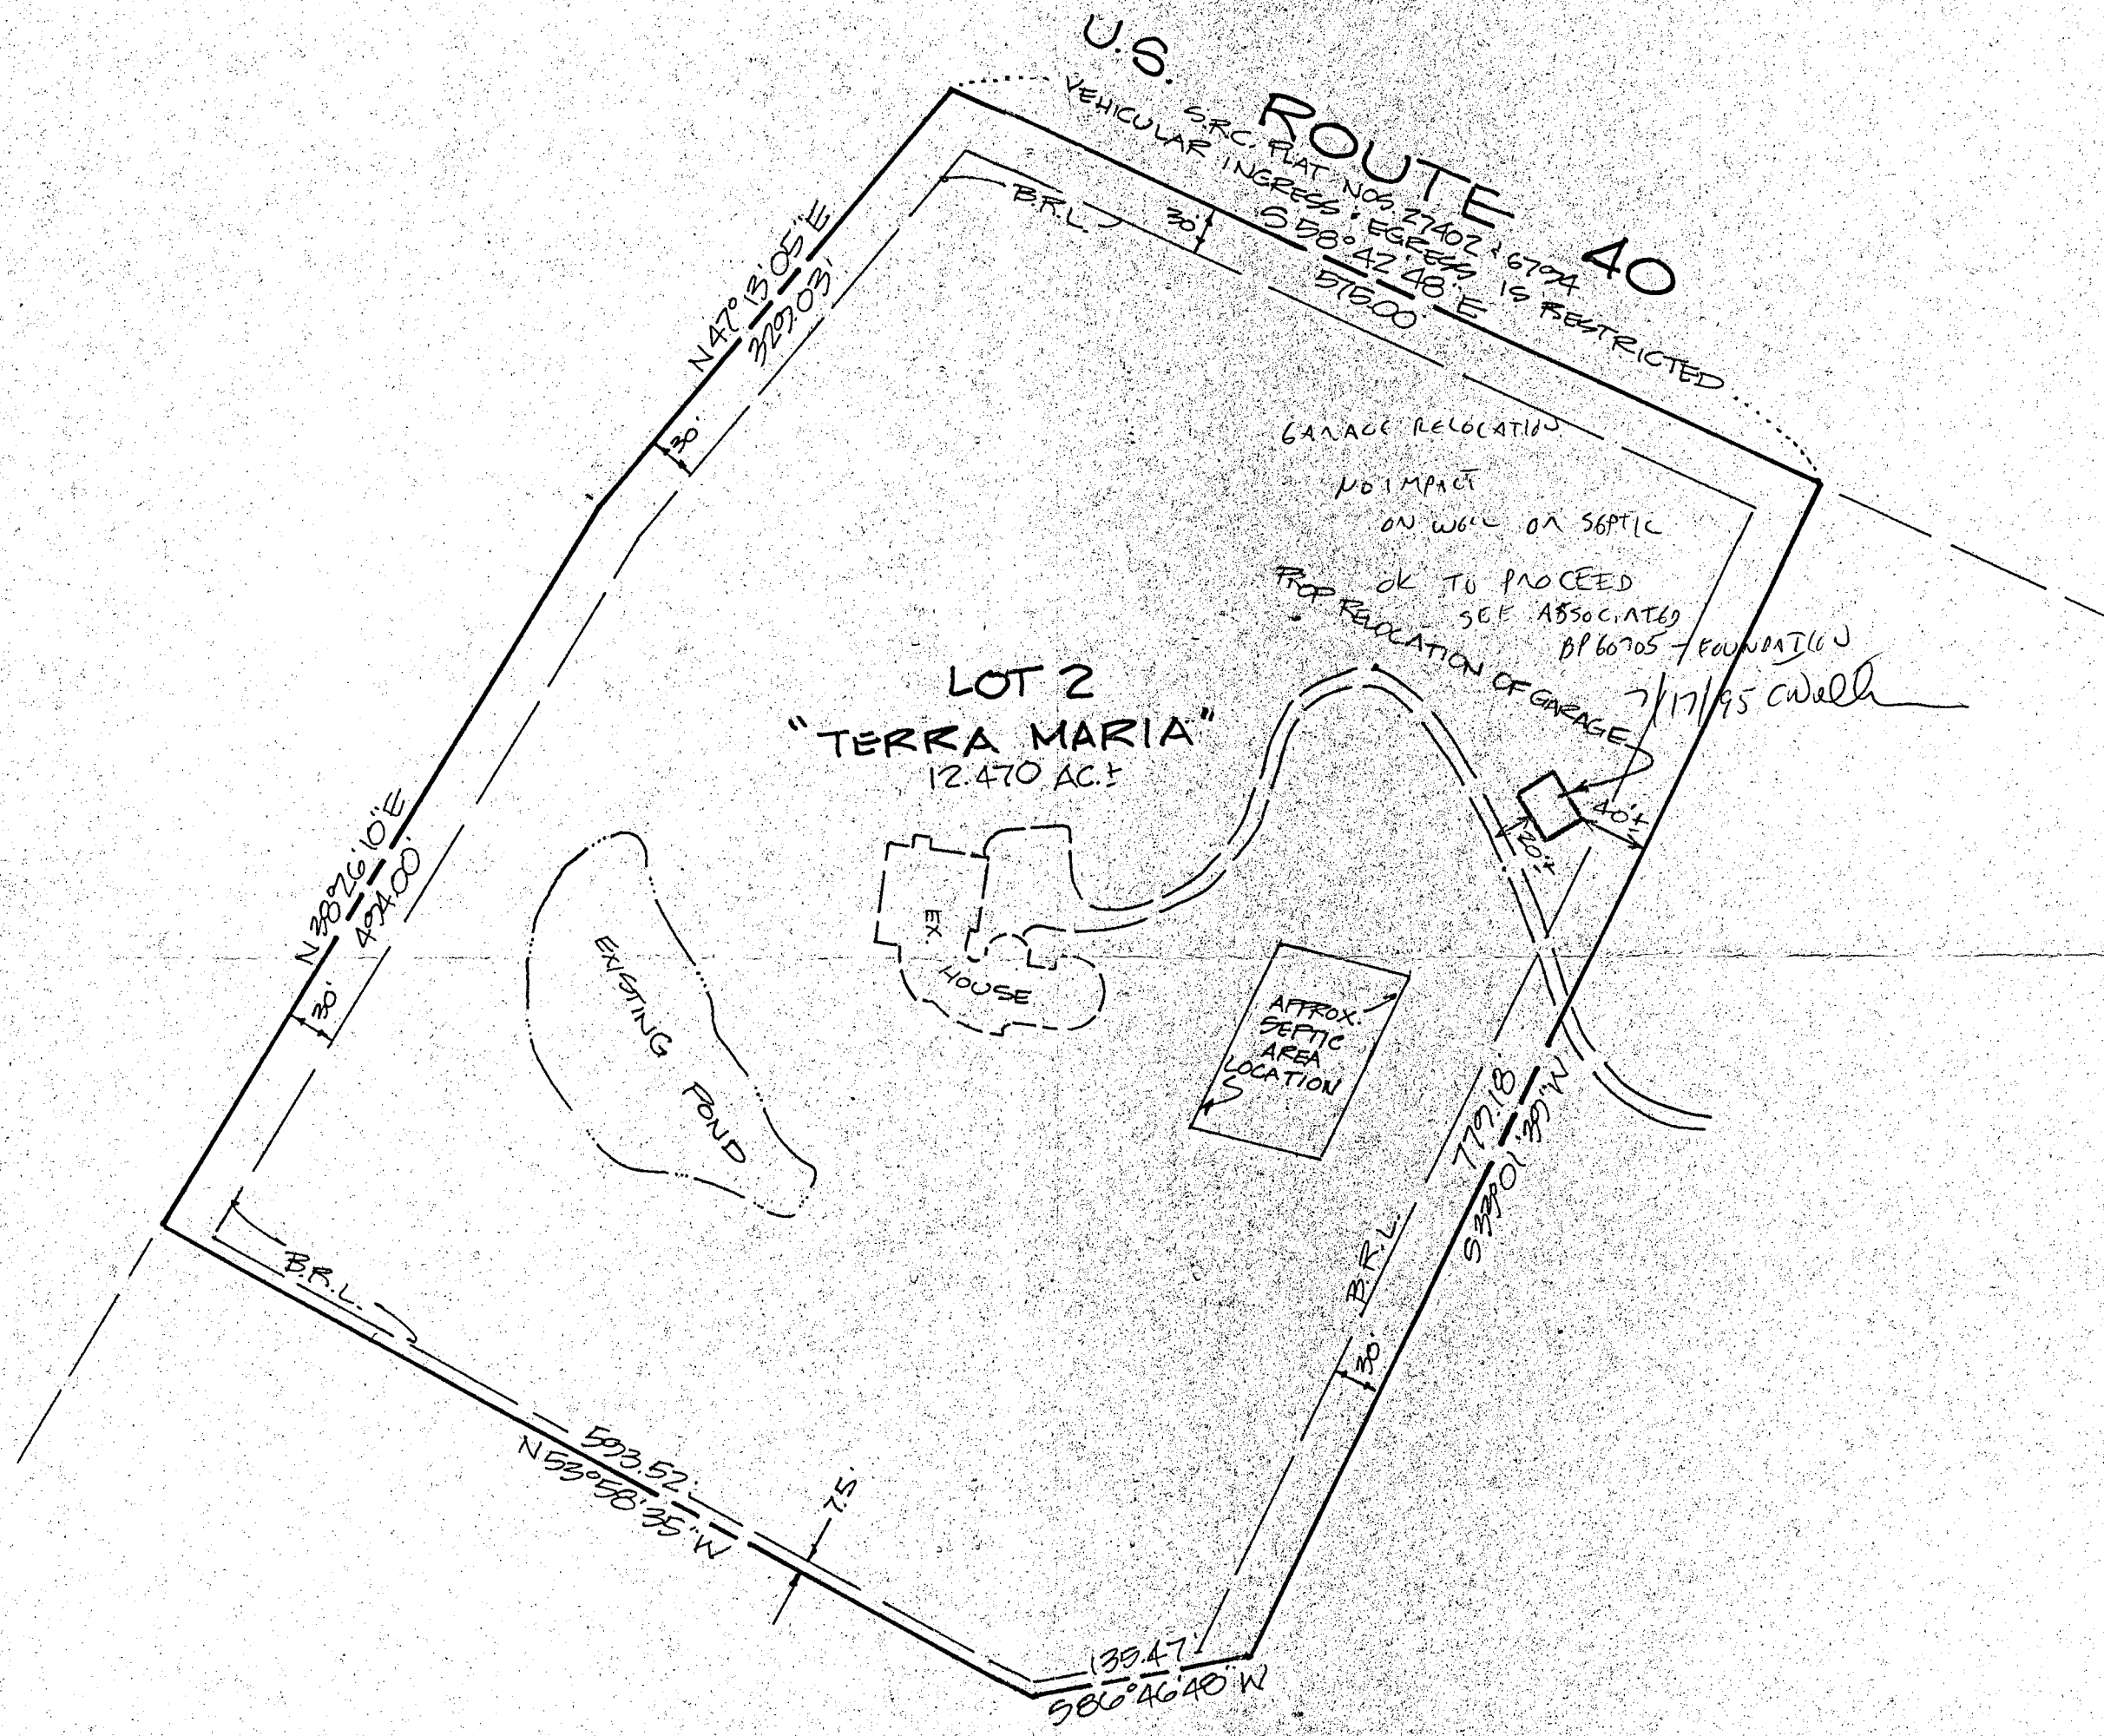

SITE PLAN
TO RELOCATE GARAGE
LOT 2
TERRA MARIA
FLAT # 10804
2ND ELECTION DIST. HOWARD CO. MD.
SCALE: 1" = 100' JUNE 26, 1995