

LAYOUT 8/5/05 INSP 4 \_\_\_\_\_  
INSP 2 8/16/05 INSP 5 \_\_\_\_\_  
INSP 3 \_\_\_\_\_ INSP 6 \_\_\_\_\_

ISSUE DATE: 8/5/05

APPROVAL DATE: 8/29/05

**PERMIT**  
**INDEXED**  
**TAX ID #05-413427**

P 523117  
A 525257  
A 526042

**ON-SITE SEWAGE DISPOSAL SYSTEM**  
**HOWARD COUNTY HEALTH DEPARTMENT**  
**BUREAU OF ENVIRONMENTAL HEALTH**

Fyock's Septic Service, Inc. IS PERMITTED TO INSTALL ☒ ALTER ☐

ADDRESS: P. O. Box 89, Glenelg MD 21737 PHONE NUMBER: 410-531-2739

SUBDIVISION: The Warfields LOT NUMBER: 24

ADDRESS: 14831 Sapling Way PROPERTY OWNER: Charles Griesser

SEPTIC TANK CAPACITY (GALLONS): 1250 OUTLET BAFFLE FILTER REQUIRED ☐

PUMP CHAMBER CAPACITY (GALLONS) n/a COMPARTMENTED TANK REQUIRED ☒

NUMBER OF BEDROOMS: 4

SQUARE FEET PER BEDROOM: 180

LINEAR FEET OF TRENCH REQUIRED: 200 HOUSE SERVED BY PUBLIC WATER ☐

TRENCHES:	Trench to be 3.0 feet wide. Inlet 3.5 feet below original grade. Bottom maximum depth 5.0 feet below original grade. Effective area begins at 4.0 feet below original grade. 1.5 feet of stone below distribution pipe.
LOCATION:	
NOTES:	Install a 104' trench 12' down slope of existing 96' trench, abandon top 2 trenches (higher in elevation) and relocate distribution box.

PLANS APPROVED: Peter Yencsik Reviewed by: \_\_\_\_\_ DATE: 8/5/05

NOTES: PERMIT VOID AFTER 2 YEARS

CONTRACTOR IS RESPONSIBLE FOR SCHEDULING A PRE-CONSTRUCTION INSPECTION FOR ALL INSTALLATIONS

WATERTIGHT SEPTIC TANKS REQUIRED

ALL PARTS OF SEPTIC SYSTEM SHALL BE 100 FEET FROM ANY WATER WELL UNLESS SPECIFICALLY AUTHORIZED

MANHOLE RISERS REQUIRED ON ALL SEPTIC TANKS AND PUMP CHAMBERS UNLESS SPECIFICALLY AUTHORIZED

CONTRACTOR RESPONSIBLE FOR COMPLIANCE WITH APPLICABLE REGULATIONS, GUIDELINES AND THE TERMS OF THIS PERMIT

**NEITHER THE HOWARD COUNTY COUNCIL NOR THE HEALTH DEPARTMENT IS RESPONSIBLE FOR THE SUCCESSFUL OPERATION OF ANY SYSTEM**

**PERMITTEE RESPONSIBLE FOR OBTAINING FINAL APPROVAL ON THIS PERMIT**


**ALL 410-313-1771 FOR INSPECTION OF SEPTIC SYSTEM**

**BUILDING PERMIT SIGNED**

**AND RETURNED**

9-21-05 BOO 156114 JG POOL

A 525257

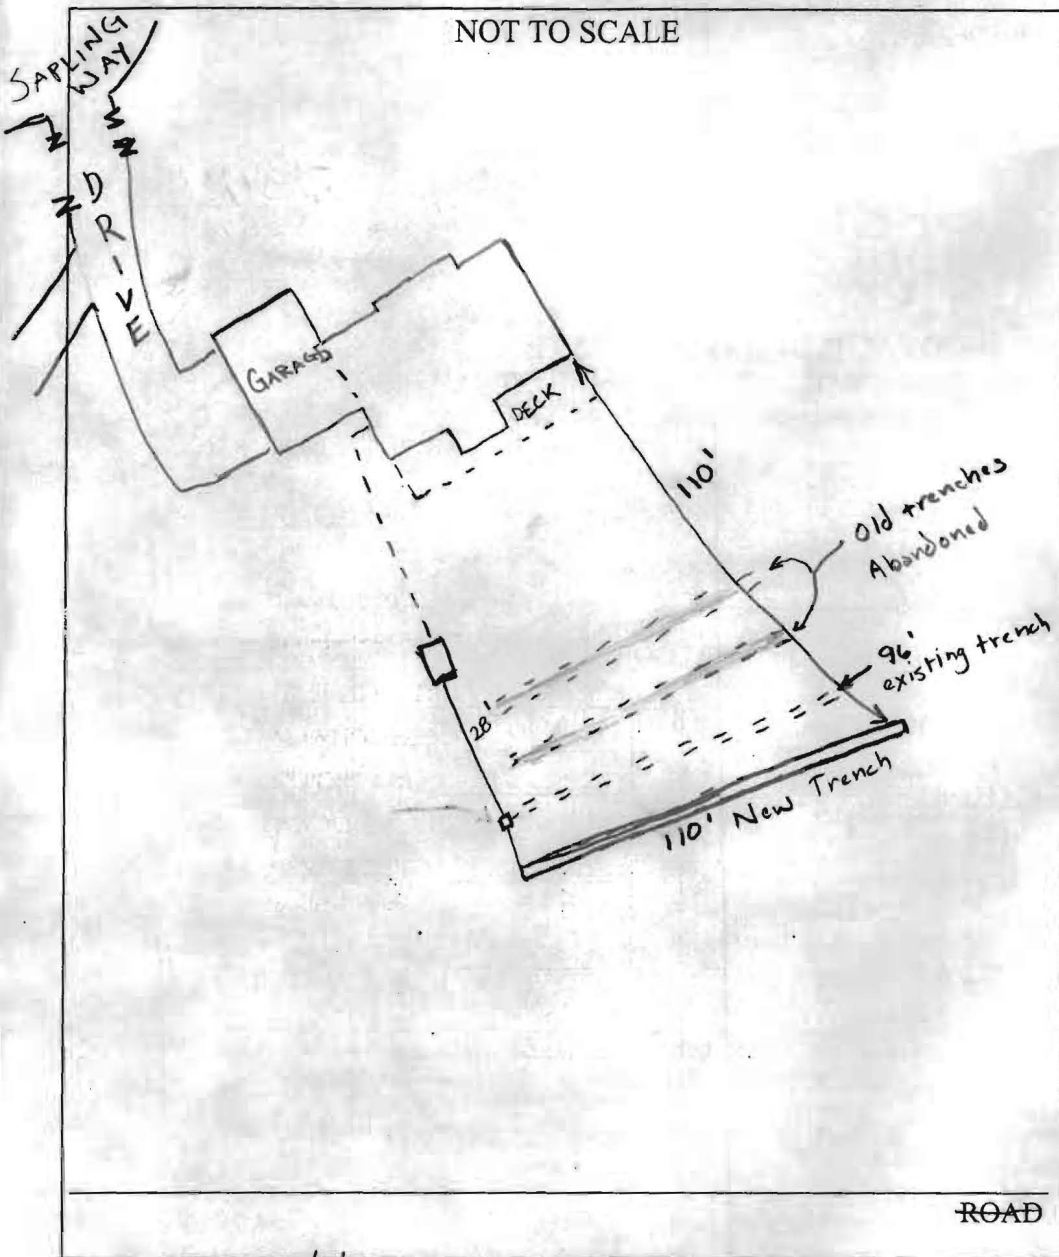

$\frac{96}{x 3} = 288$

TRENCH DRAINFIELD DATA		
WIDTH	INLET	BOTTOM
3	3	5'
NUMBER OF TRENCHES <u>1 new</u>		
TOTAL LENGTH <u>110' + (96 existing)</u>		
ABSORPTION AREA <u>330 + (288) + SW</u>		
DISTRIBUTION BOX LEVEL <u>✓</u>		
DISTRIBUTION BOX BAFFLE <u>Bricks</u>		
DISTRIBUTION BOX PORT <u>No</u>		

SEPTIC TANK DATA	
SEPTIC TANK 1 LEVEL	
Existing CAPACITY	<u>1250</u> GAL
SEAM LOC	<u>MID</u>
TANK LID DEPTH	<u>~2'</u>
BAFFLES	<u>Outlet OK</u>
BAFFLE FILTER	<u>N/A</u>
MANHOLE LOC	<u>N/A</u>
6" PORT LOC	<u>Outlet</u>
WATERTIGHT TEST	<u>N/A</u>
SEPTIC TANK 2 LEVEL	
CAPACITY	_____ GAL
SEAM LOC	_____
TANK LID DEPTH	_____
BAFFLES	_____
BAFFLE FILTER	_____
MANHOLE LOC	_____
6" PORT LOC	_____
WATERTIGHT TEST	_____

8/5/05 PRE-CONSTRUCTION Install a 104' trench below existing 96' trench  
to make up for 2 upper trenches to be abandoned to make room  
 INSTALLATION for pool. (GAC) for PAYN

8/16/05 New 110' trench installed + OK to cover D-box  
Relocated ~20' downhill from previous location 2 upper trenches  
abandoned. (GAC)

BUILDING PERMIT SIGNED  
AND RETURNED

FINAL INSPECTOR John A. Creighton DATE OF APPROVAL 8/16/05