
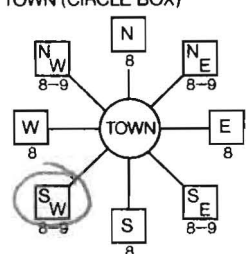


C 1 5120		SEQUENCE NO. (DENV USE ONLY)		STATE OF MARYLAND WELL COMPLETION REPORT		THIS REPORT MUST BE SUBMITTED WITHIN 45 DAYS AFTER WELL IS COMPLETED.	
(THIS NUMBER IS TO BE PUNCHED IN COLS. 3-6 ON ALL CARDS)				FILL IN THIS FORM COMPLETELY PLEASE PRINT OR TYPE		COUNTY NUMBER A = 40788	
ST/CO-USE ONLY DATE Received		DATE WELL COMPLETED		Depth of Well		PERMIT NO. FROM "PERMIT TO DRILL WELL"	
8 13		15 20		22 26 58 (TO NEAREST FOOT)		28 29 30 31 32 33 34 35 36 37	
OWNER		last name		first name		TOWN	
STREET OR RFD		SUBDIVISION		SECTION		LOT	
WELL LOG		GROUTING RECORD		C 3		PUMPING TEST	
Not required for driven wells		WELL HAS BEEN GROUTED (Circle Appropriate Box)		YES NO Y N 44 44		HOURS PUMPED (nearest hour)	
STATE THE KIND OF FORMATIONS PENETRATED, THEIR COLOR, DEPTH, THICKNESS AND IF WATER BEARING		TYPE OF GROUTING MATERIAL		CEMENT BENTONITE CLAY CM BC 45 46 45 46		PUMPING RATE (gal. per min. to nearest gal.)	
DESCRIPTION (Use additional sheets if needed)		FEET		NO. OF BAGS NO. OF POUNDS		METHOD USED TO MEASURE PUMPING RATE	
FROM TO		Check if water bearing		GALLONS OF WATER		WATER LEVEL (distance from land surface)	
Top Soil 0 2				DEPTH OF GROUT SEAL (to nearest foot)		BEFORE PUMPING	
Sandy 2 30				from ft. to ft.		WHEN PUMPING	
Sand Stone 30 35				(enter 0 if from surface)		TYPE OF PUMP USED (for test)	
MICKA 35 60				Casing types insert appropriate code below		A air P piston T turbine	
Sand Stone 60 65				MAIN CASING TYPE		C centrifugal R rotary O other (describe below)	
MICKA 65 90				Nominal diameter top (main) casing (nearest inch)		J jet S submersible	
Sand Stone 90 95				Total depth of main casing (nearest foot)		PUMP INSTALLED	
MICKA 95 265				OTHER CASING (if used)		DRILLER WILL INSTALL PUMP YES NO	
				diameter inch depth (feet) from to		IF DRILLER INSTALLS PUMP, THIS SECTION MUST BE COMPLETED FOR ALL WELLS EXCEPT HOME USE	
				screen type or open hole		TYPE OF PUMP INSTALLED	
				insert appropriate code below		PLACE (A,C,J,P,R,S,T,O) IN BOX - SEE ABOVE:	
				ST BR HO STEEL BRASS OPEN PL BRONZE HOLE PLASTIC OTHER		CAPACITY: GALLONS PER MINUTE (to nearest gallon)	
				C 2		PUMP HORSE POWER	
				DEPTH (nearest ft.)		PUMP COLUMN LENGTH (nearest ft.)	
				1 2 3 100		CASING HEIGHT (circle appropriate box and enter casing height)	
				CIRCLE APPROPRIATE LETTER		LAND SURFACE	
				A A WELL WAS ABANDONED AND SEALED WHEN THIS WELL WAS COMPLETED		+ above } (nearest foot)	
				E ELECTRIC LOG OBTAINED		- below }	
				P TEST WELL CONVERTED TO PRODUCTION WELL		LOCATION OF WELL ON LOT	
				HEREBY CERTIFY THAT THIS WELL HAS BEEN CONSTRUCTED IN ACCORDANCE WITH COMAR 26.04.04 "WELL CONSTRUCTION" AND IN CONFORMANCE WITH ALL CONDITIONS STATED IN THE ABOVE CAPTIONED PERMIT, AND THAT THE INFORMATION PRESENTED HEREIN IS ACCURATE AND COMPLETE TO THE BEST OF MY KNOWLEDGE.		SHOW PERMANENT STRUCTURE SUCH AS BUILDING, SEPTIC TANKS, AND/OR LANDMARKS AND INDICATE NOT LESS THAN TWO DISTANCES (MEASUREMENTS TO WELL)	
				DRILLERS IDENT. NO.		well 20' 110' 200'	
				DRILLERS SIGNATURE		Prop Line	
				MUST MATCH SIGNATURE ON APPLICATION)		C 1	
				SITE SUPERVISOR (sign. of driller or journeyman responsible for sitework if different from permittee)			
				GRVEL PACK			
				IF WELL DRILLED WAS FLOWING WELL INSERT F IN BOX 68			
				OEP USE ONLY (NOT TO BE FILLED IN BY DRILLER)			
				T (E.R.O.S.) W Q			
				70 72 74 75 76			
				TELESCOPE CASING LOG INDICATOR OTHER DATA			
				COUNTY			

<b>B 1</b> <span style="font-size: 24pt; font-weight: bold;">1241</span> <small>(THIS NUMBER IS TO BE PUNCHED IN COLS. 3-6 ON ALL CARDS)</small>	SEQUENCE NO. (DP USE ONLY)	<b>STATE OF MARYLAND</b> <b>APPLICATION FOR PERMIT TO DRILL WELL</b> please print or type	STATE PERMIT NUMBER <div style="border: 1px solid black; padding: 2px; display: inline-block;">             H0-94-0122           </div> <small>fill in this form completely</small>
<b>Date Received (APA)</b> <div style="border: 1px solid black; padding: 2px; display: inline-block;">             070194           </div> <b>OWNER INFORMATION</b> <div style="border: 1px solid black; padding: 2px; display: inline-block;">             REICH MARK  <small>15 Last Name Owner First Name 34</small> </div> <div style="border: 1px solid black; padding: 2px; display: inline-block;">             6030 SHEPHERD SQUARE  <small>36 Street or RFD 65</small> </div> <div style="border: 1px solid black; padding: 2px; display: inline-block;">             COLUMBIA MD 21044  <small>57 Town 70 State 72 Zip 76</small> </div>		<b>B 3</b> <span style="font-size: 24pt; font-weight: bold;">3</span> <b>LOCATION OF WELL</b> <div style="border: 1px solid black; padding: 2px; display: inline-block;">             HOWARD  <small>8 COUNTY 21</small> </div> <div style="border: 1px solid black; padding: 2px; display: inline-block;">             THE WARFIELD  <small>23 SUBDIVISION 42</small> </div> <div style="border: 1px solid black; padding: 2px; display: inline-block;">             SECTION 44 46 LOT 29 48 50  <small>52 NEAREST TOWN 71</small> </div> <div style="border: 1px solid black; padding: 2px; display: inline-block;">             GLENECLA  <small>73 76 77 78</small> </div> <div style="border: 1px solid black; padding: 2px; display: inline-block;">             2 MI  <small>MILES FROM TOWN (enter 0 if in town)</small> </div>	
<b>DRILLER INFORMATION</b> <div style="border: 1px solid black; padding: 2px; display: inline-block;">             Ralph MAYNE  <small>Driller's Name 77 License No. 80</small> </div> <div style="border: 1px solid black; padding: 2px; display: inline-block;">             Ralph MAYNE (well drilling)  <small>Firm Name</small> </div> <div style="border: 1px solid black; padding: 2px; display: inline-block;">             9120 Brown Church rd. Mt Airy  <small>Address</small> </div> <div style="border: 1px solid black; padding: 2px; display: inline-block;">             Ralph Mayne  <small>Signature Date 6/29/94</small> </div>		<b>B 4</b> <span style="font-size: 24pt; font-weight: bold;">4</span> <b>DIRECTION OF WELL FROM TOWN (CIRCLE BOX)</b>  <b>NEAR WHAT ROAD</b> <div style="border: 1px solid black; padding: 2px; display: inline-block;">             Saplins way  <small>11 30</small> </div> <b>ON WHICH SIDE OF ROAD (CIRCLE APPROPRIATE BOX)</b> <div style="border: 1px solid black; padding: 2px; display: inline-block;">             105  <small>34 37</small> </div> <b>DISTANCE FROM ROAD</b> <div style="border: 1px solid black; padding: 2px; display: inline-block;">             4  <small>ENTER FT OR MI 38 39</small> </div> <b>TAX MAP: _____ BLK: _____ PARCEL _____</b>	
<b>B 2</b> <span style="font-size: 24pt; font-weight: bold;">2</span> <b>WELL INFORMATION</b> <b>APPROX. PUMPING RATE (GAL. PER MIN.)</b> <div style="border: 1px solid black; padding: 2px; display: inline-block;">             5  <small>8 12</small> </div> <b>AVERAGE DAILY QUANTITY NEEDED (GAL. PER DAY)</b> <div style="border: 1px solid black; padding: 2px; display: inline-block;">             500  <small>14 20</small> </div>		<b>USE FOR WATER (CIRCLE APPROPRIATE BOX)</b> <div style="border: 1px solid black; padding: 2px; display: inline-block;">             D HOME (SINGLE OR DOUBLE HOUSEHOLD UNIT ONLY)           </div> <div style="border: 1px solid black; padding: 2px; display: inline-block;">             F FARMING (LIVESTOCK WATERING &amp; AGRICULTURAL IRRIGATION)           </div> <div style="border: 1px solid black; padding: 2px; display: inline-block;">             I INDUSTRIAL, COMMERCIAL, STATE AND FEDERAL GOV. OTHER (REQUIRES APPROPRIATION PERMIT)           </div> <div style="border: 1px solid black; padding: 2px; display: inline-block;">             P PUBLIC OR PRIVATE WATER COMPANY (REQUIRES APPROPRIATION PERMIT AND STATE HEALTH DEPARTMENT APPROVAL)           </div> <div style="border: 1px solid black; padding: 2px; display: inline-block;">             T TEST, OBSERVATION, MONITORING (MAY REQUIRE APPROPRIATION PERMIT)           </div>	
<b>APPROXIMATE DEPTH OF WELL</b> <div style="border: 1px solid black; padding: 2px; display: inline-block;">             150  <small>24 28</small> </div> FEET <b>APPROXIMATE DIAMETER OF WELL</b> 6" <b>NEAREST INCH</b>		<b>NOT TO BE FILLED IN BY DRILLER HEALTH DEPARTMENT APPROVAL</b> <div style="border: 1px solid black; padding: 2px; display: inline-block;">             HOWARD  <small>COUNTY NAME</small> </div> <div style="border: 1px solid black; padding: 2px; display: inline-block;">             40788  <small>COUNTY NO.</small> </div> <div style="border: 1px solid black; padding: 2px; display: inline-block;">             STATE SIGNATURE  <small>DATE ISSUED</small> </div> <div style="border: 1px solid black; padding: 2px; display: inline-block;">             070894  <small>43 48 CO SIGNATURE</small> </div> <div style="border: 1px solid black; padding: 2px; display: inline-block;">             NORTH GRID 514000  <small>50 55</small> </div> <div style="border: 1px solid black; padding: 2px; display: inline-block;">             EAST GRID 0794000  <small>57 63</small> </div>	
<b>METHOD OF DRILLING (circle one)</b> <div style="border: 1px solid black; padding: 2px; display: inline-block;">             BORED (or Augered)           </div> <div style="border: 1px solid black; padding: 2px; display: inline-block;">             JETTED           </div> <div style="border: 1px solid black; padding: 2px; display: inline-block;">             Jetted &amp; DRIVEN           </div> <div style="border: 1px solid black; padding: 2px; display: inline-block;">             AIR-ROTARY           </div> <div style="border: 1px solid black; padding: 2px; display: inline-block;">             AIR-PERCussion           </div> <div style="border: 1px solid black; padding: 2px; display: inline-block;">             ROTARY (Hydraulic Rotary)           </div> <div style="border: 1px solid black; padding: 2px; display: inline-block;">             CABLE           </div> <div style="border: 1px solid black; padding: 2px; display: inline-block;">             REVERSE-ROTARY           </div> <div style="border: 1px solid black; padding: 2px; display: inline-block;">             Drive-POINT           </div> <div style="border: 1px solid black; padding: 2px; display: inline-block;">             other           </div>		<b>SHOW MAJOR FEATURES OF BOX &amp; LOCATE WELL WITH AN X</b> <b>SOURCES OF DRILLING WATER</b> 1. well 2. 3. <b>WRITE THE BOX NUMBER FROM THE MAP HERE</b> <div style="border: 1px solid black; padding: 2px; display: inline-block;">             750 4  <small>5 4</small> </div> <div style="border: 1px solid black; padding: 2px; display: inline-block;">             514 2  <small>5 4</small> </div> <div style="border: 1px solid black; padding: 2px; display: inline-block;">             000  <small>000</small> </div>	
<b>REPLACEMENT OR DEEPEMED WELLS (CIRCLE APPROPRIATE BOX)</b> <div style="border: 1px solid black; padding: 2px; display: inline-block;">             N THIS WELL WILL NOT REPLACE AN EXISTING WELL           </div> <div style="border: 1px solid black; padding: 2px; display: inline-block;">             Y THIS WELL WILL REPLACE A WELL THAT WILL BE ABANDONED AND SEALED           </div> <div style="border: 1px solid black; padding: 2px; display: inline-block;">             S THIS WELL WILL REPLACE A WELL THAT WILL BE USED AS A STANDBY-CONTACT LOCAL APPROVING AUTHORITY FOR POLICY ON STANDBY WELLS           </div> <div style="border: 1px solid black; padding: 2px; display: inline-block;">             D THIS WELL WILL DEEPEN AN EXISTING WELL           </div> <b>PERMIT NUMBER OF WELL TO BE REPLACED OR DEEPEMED (IF AVAILABLE)</b> <div style="border: 1px solid black; padding: 2px; display: inline-block;">             41  <small>52</small> </div>		<b>DRAW A SKETCH BELOW SHOWING LOCATION OF WELL IN RELATION TO NEARBY TOWNS AND ROADS AND GIVE DISTANCE FROM WELL TO NEAREST ROAD JUNCTION</b> 	
<b>Not to be filled in by driller (OEP USE ONLY)</b> <b>APPROX. PERMIT NUMBER</b> <div style="border: 1px solid black; padding: 2px; display: inline-block;">             54  <small>63</small> </div> <b>FORCE</b> <div style="border: 1px solid black; padding: 2px; display: inline-block;">             C  <small>67 68</small> </div> <b>WRITE INITIALS IN BOX</b> <b>PERMIT No.</b> <div style="border: 1px solid black; padding: 2px; display: inline-block;">             H0-94-0122  <small>70 71 72 73 74 75 76 77 78 79</small> </div>			
<b>SPECIAL CONDITIONS</b> NOTE = APPROVING AUTHORITIES SHOULD USE SEPARATE SHEET IF NEEDED =			

<b>B 1</b> <div style="border: 1px solid black; padding: 2px; font-size: 24px; font-weight: bold;">5935</div> <small>(THIS NUMBER IS TO BE PUNCHED IN CQLS, 3-6 ON ALL CARDS)</small>	SEQUENCE NO. (DP USE ONLY)	<b>STATE OF MARYLAND</b> <b>PERMIT TO DRILL WELL</b> please print or type	STATE PERMIT NUMBER <div style="border: 1px solid black; padding: 2px; font-size: 18px; font-weight: bold;">H0-88-1033</div> <small>fill in this form completely</small>
<b>Date Received (AFA)</b> <div style="border: 1px solid black; padding: 2px; font-size: 18px; font-weight: bold;">08/22/89</div>		<b>B 3</b> <b>LOCATION OF WELL</b>	
<b>OWNER INFORMATION</b> <div style="border: 1px solid black; padding: 2px; font-size: 18px; font-weight: bold;">LAND DESIGN AND DEVL</div> <div style="border: 1px solid black; padding: 2px; font-size: 18px; font-weight: bold;">8307 MAIN STREET</div> <div style="border: 1px solid black; padding: 2px; font-size: 18px; font-weight: bold;">ELLICOTT CITY MD 21043</div>		<div style="border: 1px solid black; padding: 2px; font-size: 18px; font-weight: bold;">HOWARD</div> <div style="border: 1px solid black; padding: 2px; font-size: 18px; font-weight: bold;">SAPLING RANGE</div> <div style="border: 1px solid black; padding: 2px; font-size: 18px; font-weight: bold;">SECTION 44 LOT 24</div> <div style="border: 1px solid black; padding: 2px; font-size: 18px; font-weight: bold;">DAYTON</div>	
<b>DRILLER INFORMATION</b> <div style="border: 1px solid black; padding: 2px; font-size: 18px; font-weight: bold;">Frank Delph</div> <div style="border: 1px solid black; padding: 2px; font-size: 18px; font-weight: bold;">Frank Delph Well Drillers Inc.</div> <div style="border: 1px solid black; padding: 2px; font-size: 18px; font-weight: bold;">18234 Penn Shop Rd Mt Airy</div> <div style="border: 1px solid black; padding: 2px; font-size: 18px; font-weight: bold;">Frank Delph 6/17/89</div>		<div style="border: 1px solid black; padding: 2px; font-size: 18px; font-weight: bold;">4</div> <div style="border: 1px solid black; padding: 2px; font-size: 18px; font-weight: bold;">M I</div>	
<b>B 2</b> <b>WELL INFORMATION</b>		<b>B 4</b> <b>DIRECTION OF WELL FROM TOWN (CIRCLE BOX)</b>	
APPROX. PUMPING RATE (GAL. PER MIN.) <div style="border: 1px solid black; padding: 2px; font-size: 18px; font-weight: bold;">5</div> AVERAGE DAILY QUANTITY NEEDED (GAL. PER DAY) <div style="border: 1px solid black; padding: 2px; font-size: 18px; font-weight: bold;">520</div>		<div style="border: 1px solid black; padding: 2px; font-size: 18px; font-weight: bold;">CONF B</div> <div style="border: 1px solid black; padding: 2px; font-size: 18px; font-weight: bold;">300</div> <div style="border: 1px solid black; padding: 2px; font-size: 18px; font-weight: bold;">FT</div>	
<b>USE FOR WATER (CIRCLE APPROPRIATE BOX)</b> <input checked="" type="radio"/> HOME (SINGLE OR DOUBLE HOUSEHOLD UNIT ONLY) <input type="radio"/> FARMING (LIVESTOCK WATERING & AGRICULTURAL IRRIGATION) <input type="radio"/> INDUSTRIAL, COMMERCIAL, STATE AND FEDERAL GOV. OTHER (REQUIRES APPROPRIATION PERMIT) <input type="radio"/> PUBLIC OR PRIVATE WATER COMPANY (REQUIRES APPROPRIATION PERMIT AND STATE HEALTH DEPARTMENT APPROVAL) <input type="radio"/> TEST, OBSERVATION, MONITORING (MAY REQUIRE APPROPRIATION PERMIT)		NOT TO BE FILLED IN BY DRILLER HEALTH DEPARTMENT APPROVAL <div style="border: 1px solid black; padding: 2px; font-size: 18px; font-weight: bold;">HOWARD</div> <div style="border: 1px solid black; padding: 2px; font-size: 18px; font-weight: bold;">A = 40788</div> <div style="border: 1px solid black; padding: 2px; font-size: 18px; font-weight: bold;">08/31/89</div> <div style="border: 1px solid black; padding: 2px; font-size: 18px; font-weight: bold;">514000</div> <div style="border: 1px solid black; padding: 2px; font-size: 18px; font-weight: bold;">6794000</div>	
APPROXIMATE DEPTH OF WELL <div style="border: 1px solid black; padding: 2px; font-size: 18px; font-weight: bold;">200</div> FEET APPROXIMATE DIAMETER OF WELL <div style="border: 1px solid black; padding: 2px; font-size: 18px; font-weight: bold;">6</div> INCH		SHOW MAJOR FEATURES OF BOX & LOCATE WELL WITH AN X SOURCES OF DRILLING WATER 1. WELL 2. 3.	
<b>METHOD OF DRILLING (circle one)</b> <input checked="" type="radio"/> BORED (or Augered) <input type="radio"/> JETTED <input type="radio"/> Jetted & DRIVEN <input type="radio"/> AIR-ROTARY <input type="radio"/> AIR-PERCUSION <input checked="" type="radio"/> ROTARY (Hydraulic Rotary) <input type="radio"/> CABLE <input type="radio"/> REVERSE-ROTARY <input type="radio"/> DRIVE-POINT other _____		WRITE THE BOX NUMBER FROM THE MAP HERE <div style="border: 1px solid black; padding: 2px; font-size: 18px; font-weight: bold;">798</div> <div style="border: 1px solid black; padding: 2px; font-size: 18px; font-weight: bold;">5184</div>	
<b>REPLACEMENT OR DEEPEMED WELLS (CIRCLE APPROPRIATE BOX)</b> <input checked="" type="radio"/> THIS WELL WILL NOT REPLACE AN EXISTING WELL <input type="radio"/> THIS WELL WILL REPLACE A WELL THAT WILL BE ABANDONED AND SEALED <input type="radio"/> THIS WELL WILL REPLACE A WELL THAT WILL BE USED AS A STANDBY <input type="radio"/> THIS WELL WILL DEEPEM AN EXISTING WELL PERMIT NUMBER OF WELL TO BE REPLACED OR DEEPEMED (IF AVAILABLE) <div style="border: 1px solid black; padding: 2px; font-size: 18px; font-weight: bold;">H0-88-1033</div>		DRAW A SKETCH BELOW SHOWING LOCATION OF WELL IN RELATION TO NEARBY TOWNS AND ROADS AND GIVE DISTANCE FROM WELL TO NEAREST ROAD JUNCTION <div style="border: 1px solid black; padding: 2px; font-size: 18px; font-weight: bold;">Road A</div> <div style="border: 1px solid black; padding: 2px; font-size: 18px; font-weight: bold;">300'</div> <div style="border: 1px solid black; padding: 2px; font-size: 18px; font-weight: bold;">Tridelpia Hill Rd</div>	
Not to be filled in by driller (OEP USE ONLY) APPROP. PERMIT NUMBER <div style="border: 1px solid black; padding: 2px; font-size: 18px; font-weight: bold;">G A P</div> FORCE <div style="border: 1px solid black; padding: 2px; font-size: 18px; font-weight: bold;">C</div> WRITE INITIALS IN BOX PERMIT No. <div style="border: 1px solid black; padding: 2px; font-size: 18px; font-weight: bold;">H0-88-1033</div>			
SPECIAL CONDITIONS			

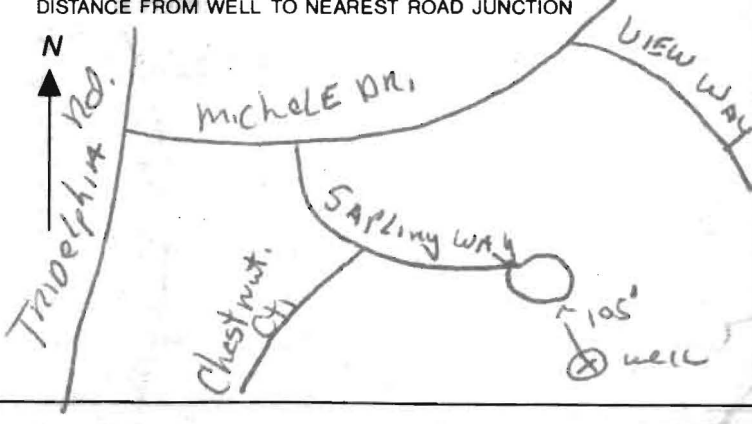

HOWARD COUNTY HEALTH DEPARTMENT  
Bureau of Environmental Health  
3525-W Ellicott Mills Drive  
Ellicott City, MD 21043  
461-8933

APPLICATION FOR PITLESS ADAPTER, WELL PUMP AND PRESSURE TANK INSTALLATION

New Installation ☒  
Replacement ☐

Receipt #  
Date 2/17/95

Name of Installer CHARLES A. KLEIN & SONS, Inc. Telephone (410) 549-6960

License Number # 6521

Certified Well Pump Installer ☒ Well Driller ☐ Registered Plumber ☐

Name of Property Owner \_\_\_\_\_

Subdivision WARFIELDS Lot # 24 Telephone \_\_\_\_\_

Site Address 14831 JAPANESE WAY Well Tag # HO - 74 - 0122

Pump

1. Type

- a. Deep well jet \_\_\_\_\_  
b. Shallow well jet \_\_\_\_\_  
c. Submersible \_\_\_\_\_

2. Make \_\_\_\_\_

3. Model # \_\_\_\_\_

4. Capacity \_\_\_\_\_ GPM

5. Pump exceeds well capacity Yes \_\_\_\_\_ No \_\_\_\_\_

6. If Yes, is low pressure cutoff switch installed? Yes \_\_\_\_\_ No \_\_\_\_\_

7. What methods are used to protect the pump and electrical wiring from vibrations? Torque arrestors \_\_\_\_\_ Cable guards \_\_\_\_\_ Other \_\_\_\_\_

Motor

1. Horsepower \_\_\_\_\_  
2. RPM \_\_\_\_\_  
3. Voltage \_\_\_\_\_  
a. 110 \_\_\_\_\_  
b. 220 \_\_\_\_\_

Pitless Adapter

1. Make \_\_\_\_\_  
2. Model # \_\_\_\_\_  
3. Depth \_\_\_\_\_

Tank

1. Capacity \_\_\_\_\_  
2. Pressure relief valve? \_\_\_\_\_

Piping

1. Type \_\_\_\_\_  
2. Size \_\_\_\_\_  
3. NSF and/or BOCA Code approved \_\_\_\_\_  
4. Depth of supply line \_\_\_\_\_

Well data

1. Depth 265 ft.  
2. Yield 5 GPM  
3. Static water level \_\_\_\_\_ ft.  
4. Will water supply be disinfected by installer? \_\_\_\_\_

I understand that it is my responsibility to notify the Howard County Health Department when the installation is ready for inspection (otherwise this permit is null and void).

All information given above is true to the best of my knowledge.

Signature of Applicant: Charles A. Klein Jr.

Date: 2/17/95

Note: A sticker indicating approval/status of the installation will be placed on the well casing at the time of the inspection.