


Building Permit Application
Howard County Maryland
Department of Inspections, Licenses and Permits
3430 Court House Drive

Permits: 410-313-2455 www.howardcountymd.gov Date Received: 10/14/14

Permit No.: 814003777

Building Address: 12402	54110		Property Owner's Name: Th	Diocenia	1 1 medi
		Address: 3675 Par	L Trestave	- Di Wall	
City: Day + Con State:	Zip Code	036	City: CLY COH Crty St	tate: DA	Zin Code-QKM3
Suite/Apt. #SDP	/WP/BA #:	1	Phone:	Fax:	_2.10 0000.5.00.6.5
Census Tract:		Maraell			
Section: Area			Applicant's Name & Mailing A	ddress, (if other th	ıan stated herein)
Tax Map: Parcel:			Applicant's Name: LYCN		*
		75.00	Address 125	3	O STREET
Zoning: Map Coordinate	es:Lot Size:	15 NC	CitySylvesnin	State:	_ Zip Code
			Phone 443,340 1229	1 Fax:	24 0.00.014
Existing Use: 5			Email: Jex emy @	Mouston	· CCCP POVEOR
Proposed Use:	, wI Tank	ا ر	Contractor Company:	wy nat	MAN ACE
Estimated Construction Cost: \$ %		-	Contact Person: \\\\\\\\\\\\\\\\\\\\\\\\\\\\\\\\\\\\	om frem	الماد
			Contact Person: (A) 1140 Address: 7201 MCA	te nedo	848
Description of Work: \\\\\\\\\\\\\\\\\\\\\\\\\\\\\\\\\\\\	1 500 yell		Citres Swe State	e: Co Zip (	Code: 2079 4
undergrand	orpoone to	0k -	Cit State License No.:	13	<b>G</b>
	1		Phone: 107991114	Fax:	
			Email:		
Occupant or Tenant:	w o /				
Was tenant space previously occupied?		□No	Engineer/Architect Company	0 10	
			Engineer/Architect Company:	CON	iet
Contact Name:			Responsible Design Prof.:		
Address:			Address:		
City:	State: Zin Code		City:State	e: 7in C	nde:
		1			
Phone:	Fax:	<del></del>	Phone:	Fax:	•
Email:			Email:		
				Green	
Commercial Building Characteristics	Residential Building Cha		Utilities		
Height:	SF Dwelling SF Town	NAME OF THE PARTY	<u>Water Supply</u>	10.46	
No. of stories:	Depth 1 <sup>st</sup> floor:	Width	☐ Public		
Gross area, sq. ft./floor:	2 <sup>nd</sup> floor:		Private	33.63	SECONDARY CONTRACTOR
Area of construction (sq. ft.):	Basement:		Sewage Disposal		A BANK BURNER BURNER
Area of construction (sq. 1t.).	☐ Finished Basement	<del></del>	☐ Public	753600	
Use group:	☐ Unfinished Basement		Private		CAPONE DISCO
ose group.	☐ Crawl Space			<b>th</b> p	
Construction type:	☐ Slab on Grade			7 TO 6 TO	
☐ Reinforced Concrete	No. of Bedrooms:			No	near the second
☐ Structural Steel	Multi-family Dwe	lling	Heating System		
☐ Masonry	No. of efficiency units:		☐ Electric ☐ Oil		
☐ Wood Frame	No. of 1 BR units:		☐ Natural Gas ☐ Propane	Gas	
☐ State Certified Modular	No. of 2 BR units:		Other:		<b>《</b> 特别》,"我们是这个
	No. of 3 BR units:		Sprinkler System:	1000	
	Other Structure:		☐ Yes		
> Roadside Tree Project Permit	Dimensions:				
Yes Project Permit	Footings: Roof:		Grading Perm	7 (0.000) 71 (0.000)	2004643040999447444444
Roadside Tree Project Permit #	☐ State Certified Modula	r			, -
The state of the s	☐ Manufactured Home		Building Shell Perm	nit Number:	
			3		
THE UNDERSIGNED HEREBY CERTIFIES AND AGRE	ES.AS FOLLOWS: (1) THAT HE/SHE!	IS AUTHORIZED TO I	MAKE THIS APPLICATION: (2) THAT THE INF	ORMATION IS CORRECT	; (3) THAT HE/SHE WILL COMPLY
WITH ALL REGULATIONS OF HOWARD COUNTY THIS APPUCATION; (5) THAT HE/SHE GRANTS COU	HICH ARE APPLICABLE THERETO; (	(4) THAT HE/SHE W	ILL PERFORM NO WORK ON THE ABOVE R	EFERENCED PROPERTY	NOT SPECIFICALLY DESCRIBED IN
THIS APPUT AHON; (5) THAT HE/SHE GRANTS COL	INTO OFFICIALS THE RIGHT TO ENTE	ER ONTO THIS PROP	PERTY IN THE BURPOSE OF INSPECTING TH	CORK PERMITTED AN	D POSTING NOTICES.
Applicant's Signature		Pr	int Name	U My	
Joro mi Dandiso	gargosbian	ad com	Kulle	DIAPPION 1	, man
Email Address	voiddonner	60.00x	te Olialia	SES & PERMITS  MOINWIN	יוכנא
	1				
Title/Company	p			LI & SOIA	_30
rac, company	Checks Payable to	· DIRECTOR OF F	INANCE OF HOWARD COUNTY	- 1997	VIV.
			TLY & LEGIBLY**	LEIVED	DEC
		-FOR OFFICE	USE ONLY		
AGENCY DATE S	IGNATURE OF APPROVAL	DPZ SETBACK	INFORMATION	Filing Fee	\$
	21	Front:		Permit Fee	\$ 100.00
State Highways		Rear:		Tech Fee	\$ 10.00
Building Officials		Side:		PSFS	\$
PSZA (Zoning)	20.5		setbacks met?	Guaranty Fund	\$
PSZA (Engineering)			ermit Required?  Yes No	Add'l per Fee	\$
Health W/17/201	U Dollar	Historic Distri	· · · · · · · · · · · · · · · · · · ·	Total Fees	\$ 10.00
Is Sediment Control approval required for	or issuance? Tives Tives		for New Town Zone:	Sub-Total Paid	\$
☐ CONTINGENCY CONSTRUCTION STAR		SDP/Red-line	approval date:	Balance Due	\$ 4010

#4018

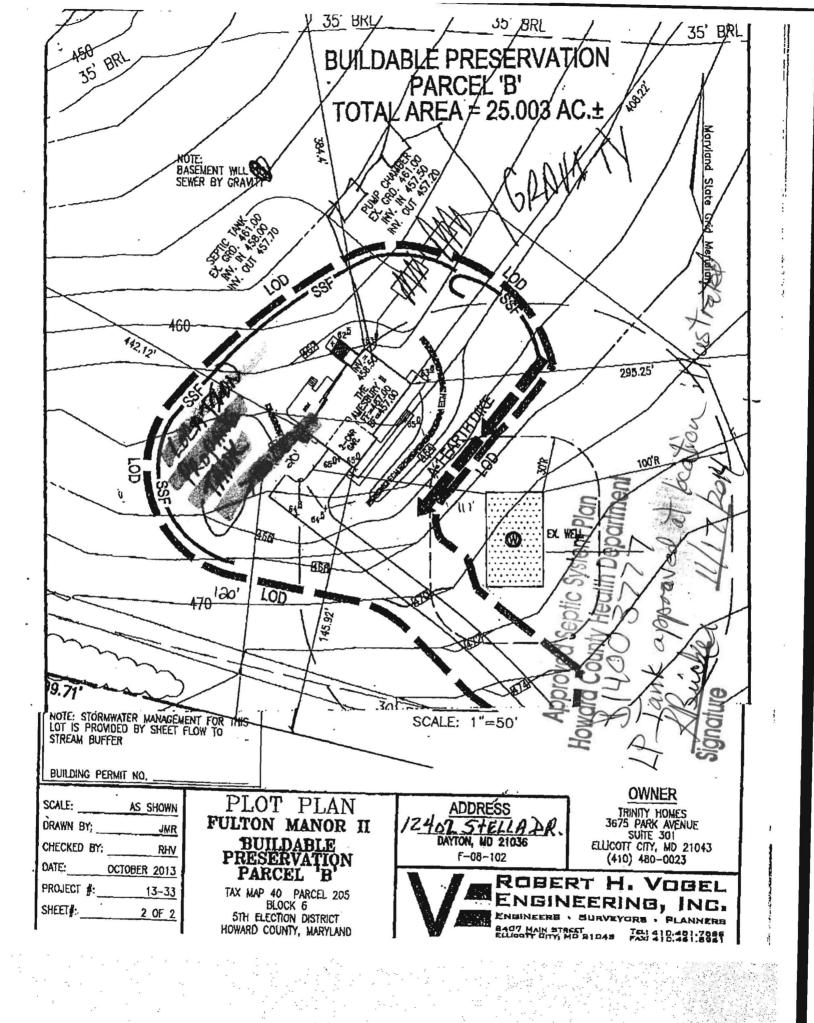

## Real Property Data Search (w1)

Guide to searching the database

Search Result for HOWARD COUNTY

View M			View GroundRent Redemption				View GroundRent Registration				
Account	ldentif	ier:	District -	05 Account N							
					er Information	1					
Owner Name: Mailing Address:		THE PRESERVE AT WAVERLY GLEN LLC  3675 PARK AVE ELLICOTT CITY MD 21043				RESIDENTIAL NO					
						e:					
				Location &	Structure Info	rmation					
Premises Address:		12402 STELLA DR FULTON 20777-0000		Legal Description:		PAR B 25.003 A BUILDABLE PRESERVATION 12402 STELLA DR FULTON MANOR II					
Map: 0040	Grid: 0006	Parcel: 0205	Sub District:	Subdivision: 2479	Section:	Block:	Lot: PAR	Assessment Year: 2014	Plat No: Plat	22479-	
0040	0000	0203		2413			B	2014	Ref:	481	
Special	Tax A	eas:	:		Town: Ad Valorer Tax Class:	n:		N 10			
Primary Built	Struct	ture	Above Grad Area	de Enclosed	Finished Ba Area	asement		Property Land Area 25.0030 AC	Us	ounty e 0000	
Stories	Ва	sement	Туре	Exterior	Full/Half Bath	G	arage	Last Major	Renovat	ion	
				Valu	e Information						
		Base Value		Value	Value Phas		-in Assessme	nts			
				As of		As of	2014	As of 07/01/20	16		
Land:			85,800		01/01/2014 85,800		07/01/	4014	07/01/20	וט	
	nprovements 0		0								
Total:			85,800		85,800 85,8		)	85,800			
Preferer	ntial La	nd:	0						0		
				Trans	fer Informatio	n					
Seller:				Date:				Price:			
Type:				Deed				Deed2:			
Seller:				Date:				Price:			
Type:				Deed				Deed2:			
Seller: Type:			Date: Deed1:			Price: Deed2:					
Type.					tion Informati	on					
Partial Ex			Class		07/01/2		0	7/01/2015			
Assessme County:	ents:		000		0.00						
State:			000		0.00						
	l:		000		0.00 0.	00	0	0.00 0.00			
Municipai				Spec	ial Tax Recap				estimate and a second		
Municipal Tax Exe Exempt				NONE	E						

- 1. This screen allows you to search the Real Property database and display property records.
- 2. Click here for a glossary of terms.
- 3. Deleted accounts can only be selected by Property Account Identifier.
- 4. The following pages are for information purpose only. The data is not to be used for legal reports or documents. While we have confidence in the accuracy of these records, the Department makes no warranties, expressed or implied, regarding the information.