

Building Permit Application
Howard County Maryland
Department of Inspections, Licenses and Permits 3430 Court House Drive Permits: 410-313-2455

Date Received:	
Bato Hoodilou.	

Permit No.: _ www.howardcountymd.gov

Building Address: 1186				Property Owner's Name:	Henry H. H.	ORN
City: FULTON	State	e: <u>MD</u> Zip Code: _2	0759	Address: 1/863 JOHG	States MA	Zin Code: 2075
Suite/Apt. #		4		Phone: 301 · 498 · 82	54 Fax:	zip code:
Census Tract:			1/5	Email:		
			10.7	Applicant's Name & Mailing	Address. (If other	than stated herein)
Section:	Darco	89 Grid:		Applicant's Name:		
Tax Map: Parcel: Grid: Zoning: Map Coordinates: Lot Size:			Address: State: Zip Code:			
Zoning: Miap	Coordii	nates:Lot Size	:	Phone:		
Existing Use: 5009/2	. t	Amily Devellin	4	Email:		
Proposed Use: 54m -				Contractor Company:	W. MA	BARN NA
Estimated Construction Costs	. 5	940.24 .	1-80-1	Contact Person: Henr		
Estimated Construction Cost: \$ 5940.24 * Description of Work: PrefAL BA 5he D			Address:	Address:		
			THE PROPERTY OF THE PROPERTY O	City: Zip Code:		
FOR STORAGE 12XZ4			License No. :	Phone: <u>301 498 8254</u> Fax:		
				_ Phone:	- Fax:	
Occupant or Tenant:		The state of	No.	. Litali.		I E
Was tenant space previously	occupie	ed? □Yes	□No	Engineer/Architect Company	The state of the s	100
Contact Name:			Tole !	_ Responsible Design Prof.:		Co.
Address:		The second secon	£452	_ Address:		H a
City:			權能力		Still Bridge State	Code:
Phone:						
					Fax:	
Email:		5 - 10 R 5 1 - 10 M	See a line	_ Email:		
Commercial Building Charac	cteristic	s Residential Building Ch	aracteristi	s Utilities		
Height:	par TA	■ SF Dwelling □ SF Tow	- 1-02	Water Supply		The contains in a
No. of stories:		Depth 1 st floor:	Width	Public	PATE AND THE RESERVE OF THE PATE AND THE PAT	
Gross area, sq. ft./floor:		2 nd floor:	MATERIAL III	□ Private	THE SHARE -	
Area of construction (sq. ft.):		Basement:		Sewage Dispos	<u>al</u>	
		☐ Finished Basement	W.	Public		
Use group:		☐ Unfinished Basement ☐ Crawl Space		□ Private		A
Construction type:		☐ Slab on Grade	100	1 In the Chart is a	□ No	
☐ Reinforced Concrete		No. of Bedrooms:			□ No	
☐ Structural Steel		Multi-family Dw	elling	Heating System ☐ Electric ☐ Oil	<u>u</u>	
☐ Masonry ☐ Wood Frame		No. of efficiency units: No. of 1 BR units:	271	□ Natural Gas □ Propar	ne Gas	
☐ State Certified Modular		No. of 2 BR units:	No. of P.	Other:	ie das	
		No. of 3 BR units:			<u>m:</u>	
		Other Structure:		☐ Yes ☐ No		
Roadside Tree Project P	Permit	Dimensions: Footings:		E CONTRACTOR		
□Yes □N		Roof:	HERM	Grading Per	rmit Number:	
Roadside Tree Project Per	rmit#	☐ State Certified Modul	ar			
	- 4	☐ Manufactured Home		Building Shell Per	rmit Number:	
with all regulations of howar this application; (5) that he/she Applicant's Signature	D COUNT	Y WHICH ARE APPLICABLE THERETO;	(4) THAT HE	TO TO MAKE THIS APPLICATION; (2) THAT THE IS SHE WILL PERFORM NO WORK ON THE ABOVE PROPERTY FOR THE PURPOSE OF INSPECTING Print Name	REFERENCED PROPERTY	Y NOT SPECIFICALLY DESCRIBED IN
Email Address		100	100	Date		
Title/Company	- 31	and the second			25	
ALL STATES TO SERVE	i dia		PLEASE WRI	OF FINANCE OF HOWARD COUNTY E NEATLY & LEGIBLY** FICE USE ONLY-		
ACENOV	DATE	SIGNATURE OF ARRECUAL		BACK INFORMATION	Filing Fee	\$
	DATE	SIGNATURE OF APPROVAL	Front:		Permit Fee	\$
State Highways			Rear:		Tech Fee	\$

PSZA (Engineering) Health Is Sediment Control approval required for issuance? ☐ CONTINGENCY CONSTRUCTION START

Side St.: All minimum setbacks met? ☐ Yes ☐ No Is Entrance Permit Required? ☐ Yes ☐ No ☐ Yes ☐No Historic District? Lot Coverage for New Town Zone: SDP/Red-line approval date:

PSFS **Guaranty Fund** Add'l per Fee **Total Fees** Sub-Total Paid **Balance Due** Check

Distribution of Copies:

PSZA (Zoning)


White: Building Officials

Green: PSZA,Zoning

Yellow: PSZA,Engineering

Pink: Health

Gold: SHA

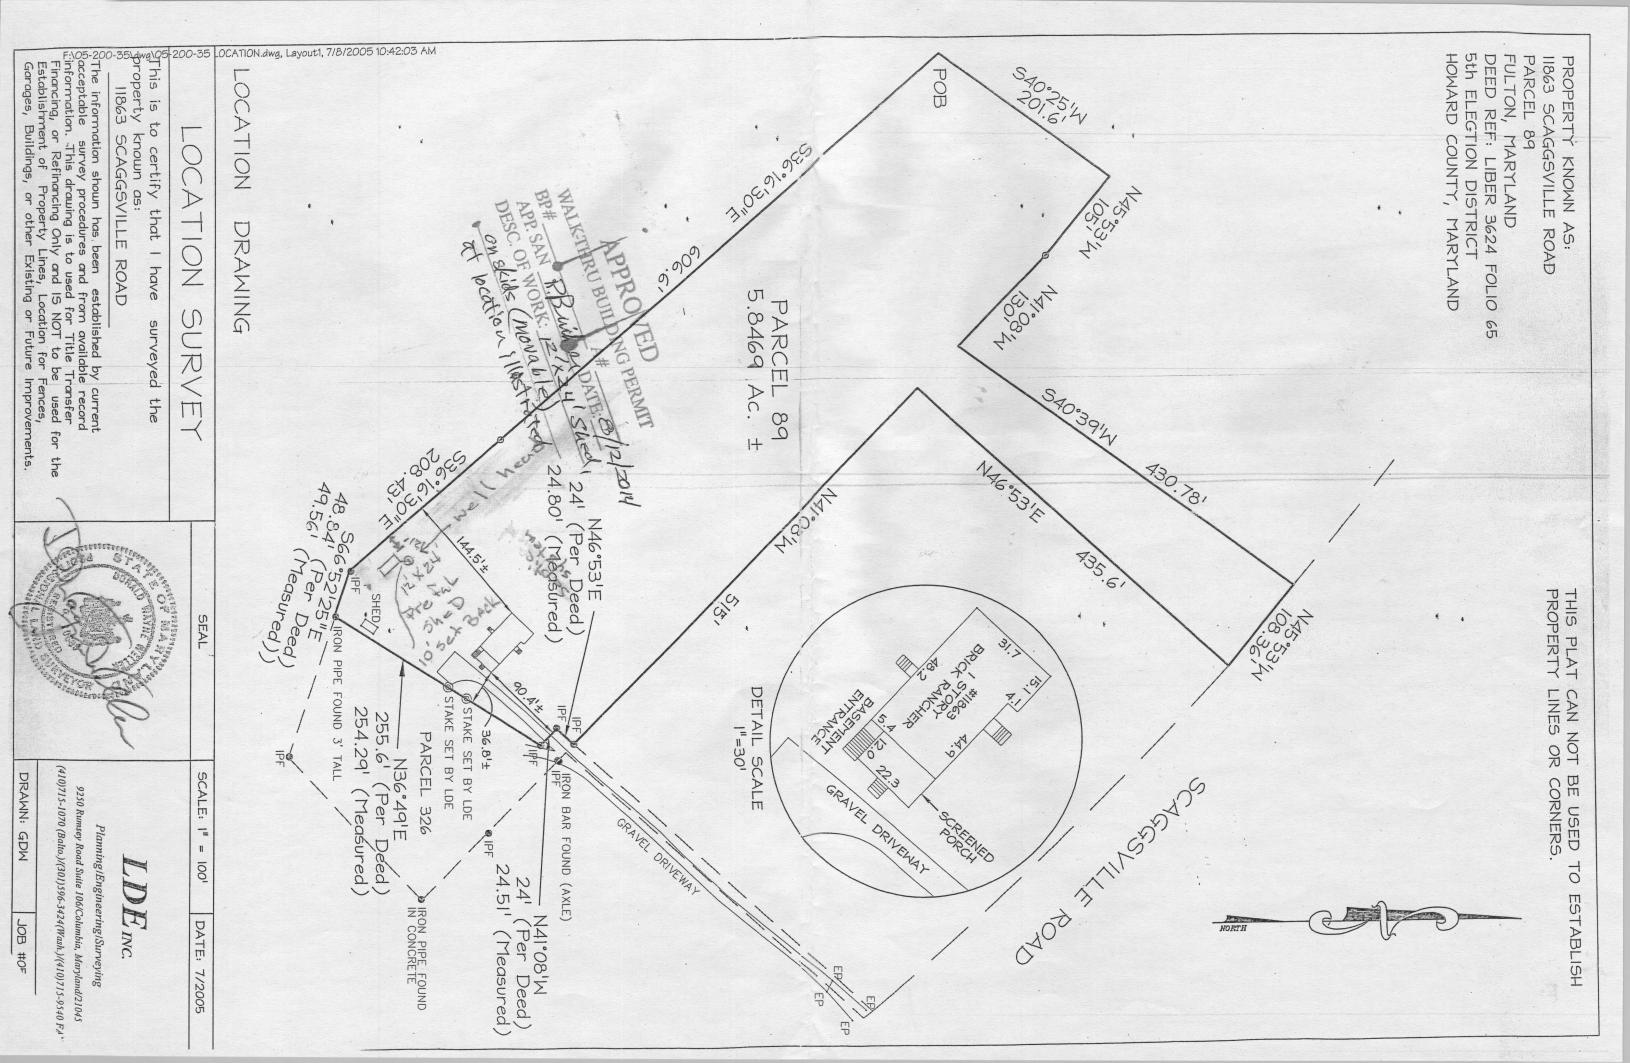

DRAWN: GDW

JOB

#04