

HD-216 (3/92)


517 904

NOT TO SCALE

COUNTY #

SOIL PROFILE

3575

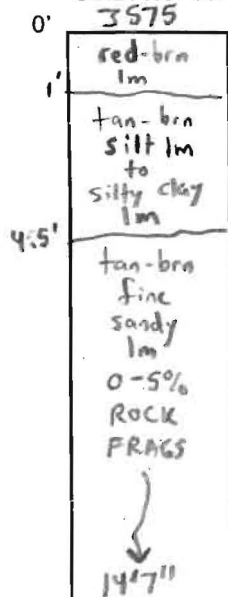

3576/3577

SAME
AS
3575

EXCEPT

20-30%
ROCK
Soil around
rocks
OK



3578

SEE
3575

15'6"

SOIL PROFILE

3578A

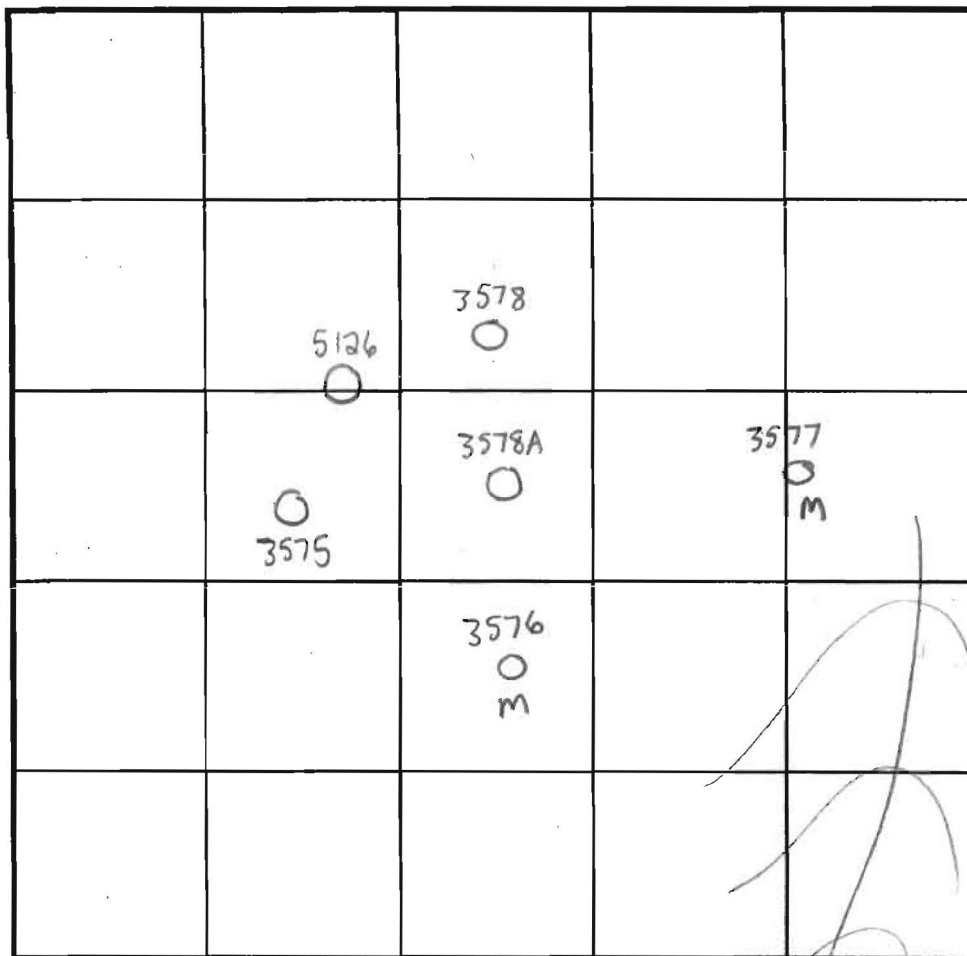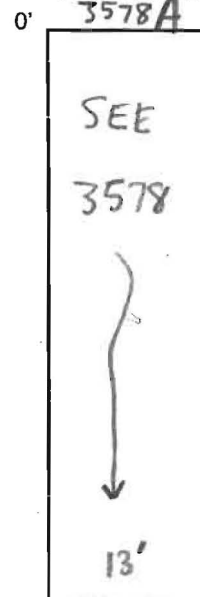

INDICATE NORTH - NAME ADJOINING ROADWAY AS BASE LINE

DATE	TEST NO.	DEPTH	PRE-WET		TEST - 1" DROP		TIME	
			START	STOP	START	STOP		
12/6/02	3575	14'7"V	(VISUAL	OK SEE	SOIL PROFILE)		NA	OK
	3576	13'V	("	" "	" "	")	NA	marginal) OK
		(Adjust off)						
	3577	14'V	("	" "	" "	")	NA	"
		(Adjust off)						
	3578	15'6"V	(VISUAL	OK SEE	SOIL PROFILE)		NA	OK
	3578A	13'V	("	" "	" "	")	NA	OK
10/10/00	5126	4'6"V 13'6"V	(PREVIOUSLY EVAL. BY RJP)				23min	OK

REMARKS

TYPE OF SOIL GlenelgTESTED BY SRKDonnie Simpson = Backhoe

ALSO PRESENT

Jim Selfridge
Bob Shearsly

12/9/02

TRENCH DESIGN DATA: AVERAGE PERCOLATION TIME

2-7min est

TRENCH WIDTH

3'

INLET DEPTH

4.5'

MAXIMUM BOTTOM DEPTH

6.5'

SQ. FT/BEDROOM

180