

APPLICATION

PERCOLATION TESTING

A 517904

F _____

HOWARD COUNTY HEALTH DEPARTMENT

BUREAU OF ENVIRONMENTAL HEALTH

3525-H ELLICOTT MILLS DRIVE/ELLICOTT CITY, MARYLAND 21043
TELEPHONE: 313-2640

DISTRICT _____

DATE 9/5/02

TO: THE COUNTY HEALTH OFFICER
ELLICOTT CITY, MARYLAND

I HEREBY APPLY FOR THE NECESSARY TEST PRIOR TO APPLICATION FOR PERMIT TO CONSTRUCT (OR RECONSTRUCT) A SEWAGE DISPOSAL SYSTEM.

PROPERTY OWNER DORSEY MILL L.L.C.
14045 GARET DRIVE
ADDRESS GLENWOOD, MD 21738 PHONE 410-531-8930
FAX 410-531-8939

AGENT OR PROSPECTIVE BUYER _____

ADDRESS _____ PHONE _____

PROPERTY LOCATION:

SUBDIVISION DORSEY MILL ROAD LOT NO. _____

ROAD AND DESCRIPTION 14445 DORSEY MILL RD, GLENELG, MD 21737

TAX MAP 21 PARCEL # 227

SIZE OF LOT 53.87 AC. TYPE BLDG. SINGLE FAMILY DWELLING
(SINGLE FAMILY DWELLING OR COMMERCIAL)

THE SYSTEM INSTALLED UNDER THIS APPLICATION IS ACCEPTABLE ONLY UNTIL PUBLIC FACILITIES BECOME AVAILABLE. I FULLY UNDERSTAND THE
FEE CONNECTED WITH THE FILING OF THIS PERC TEST APPLICATION IS NON-REFUNDABLE UNDER ANY CIRCUMSTANCES. I ALSO AGREE TO
COMPLY WITH ALL M.O.S.H.A. REQUIREMENTS IN TESTING THIS LOT.

James A. A. [Signature]
(SIGNATURE OF APPLICANT)

APPROVED BY _____ FOR _____ DATE _____

DISAPPROVED BY _____ FOR _____ DATE _____

HOLD PENDING FURTHER TESTS _____

REASONS FOR REJECTION OR HOLDING _____

PERCOLATION TEST PLAT/PRELIMINARY PLAT - TITLE OR I.D. # _____ DATE _____

SITE DEVELOPMENT PLAN/FINAL PLAT - TITLE OR I.D. # _____ DATE _____

THIS IS NOT A PERMIT

517904


COUNTY #

NOT TO SCALE


SOIL PROFILE



3580

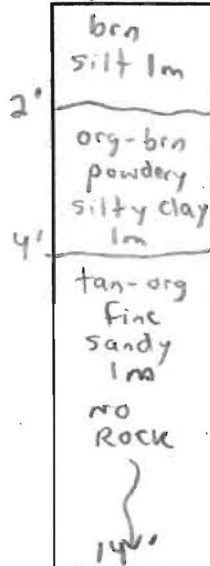


3581

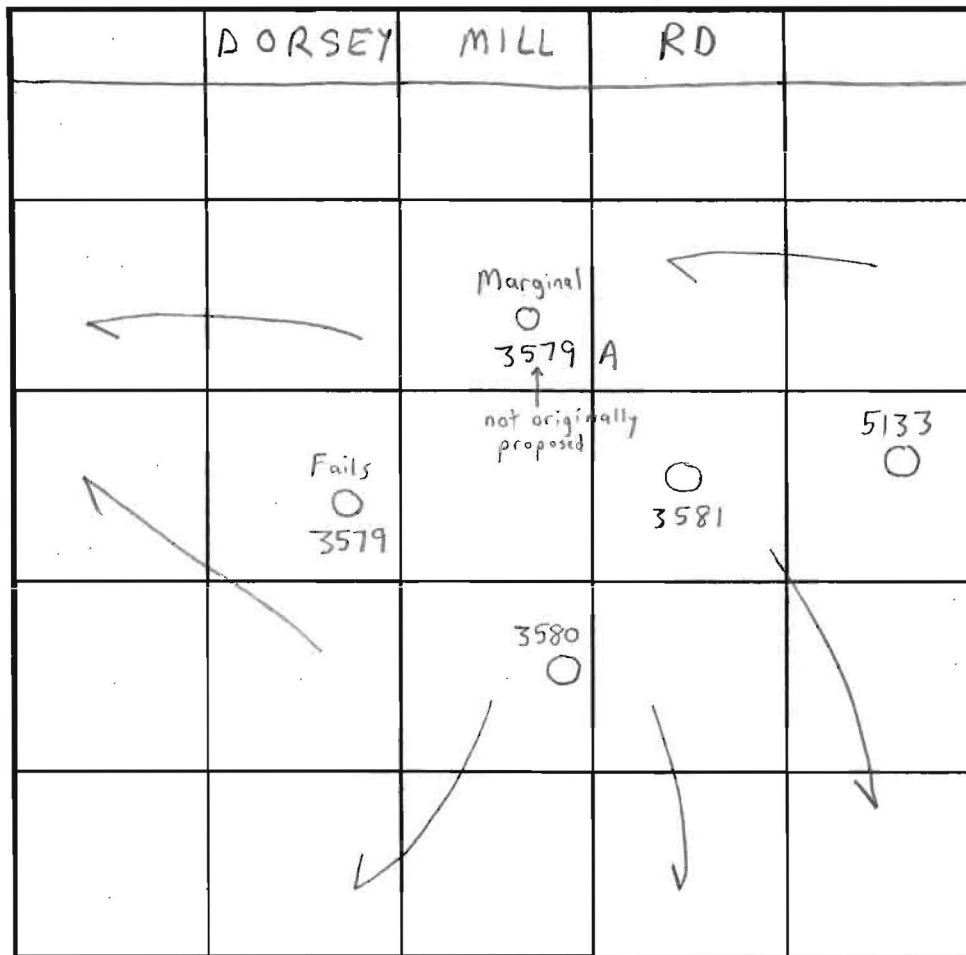

INDICATE NORTH - NAME ADJOINING ROADWAY AS BASE LINE.

SOIL PROFILE

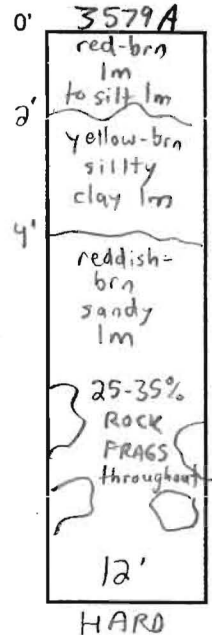

DATE	TEST NO.	DEPTH	PRE-WET START	PRE-WET STOP	TEST - 1" DROP START	TEST - 1" DROP STOP	TIME	
12/6/02	3579	10'V	(45-55 % ROCK FRAGS)				NA	Fails
			NOT TESTED - LOOK FOR BETTER AREA					
12/3/02	3580	6'T / 14'V	3:39pm	3:41pm	3:41pm	3:43pm	2min	OK
	3581	7'T / 15'V	3:48pm	3:50pm	3:50pm	3:52pm	2min	OK
12/6/02	3579A	12'V	(VISUAL OK SEE SOIL PROFILE)				NA	Marginal
		not staked	prior to excavation					
8/30/00	5133	6'T / 15'6"V	(PREVIOUSLY EVAL. BY RJP)				5min	OK


REMARKS Adjust proposed SDA to use better holes & to minimize drainage to Lot 265 well site. Also adjust Lot 265 well site


TYPE OF SOIL Glenelg

TESTED BY SRK Donnie Simpson = Backhoe ALSO PRESENT Jim Selfridge - 10/31/02 & 12/6/02 Bob Sheesly - 12/6/02

TRENCH DESIGN DATA: AVERAGE PERCOLATION TIME 2-7min est TRENCH WIDTH 3'

INLET DEPTH 4 MAXIMUM BOTTOM DEPTH 6 SQ. FT/BEDROOM 180

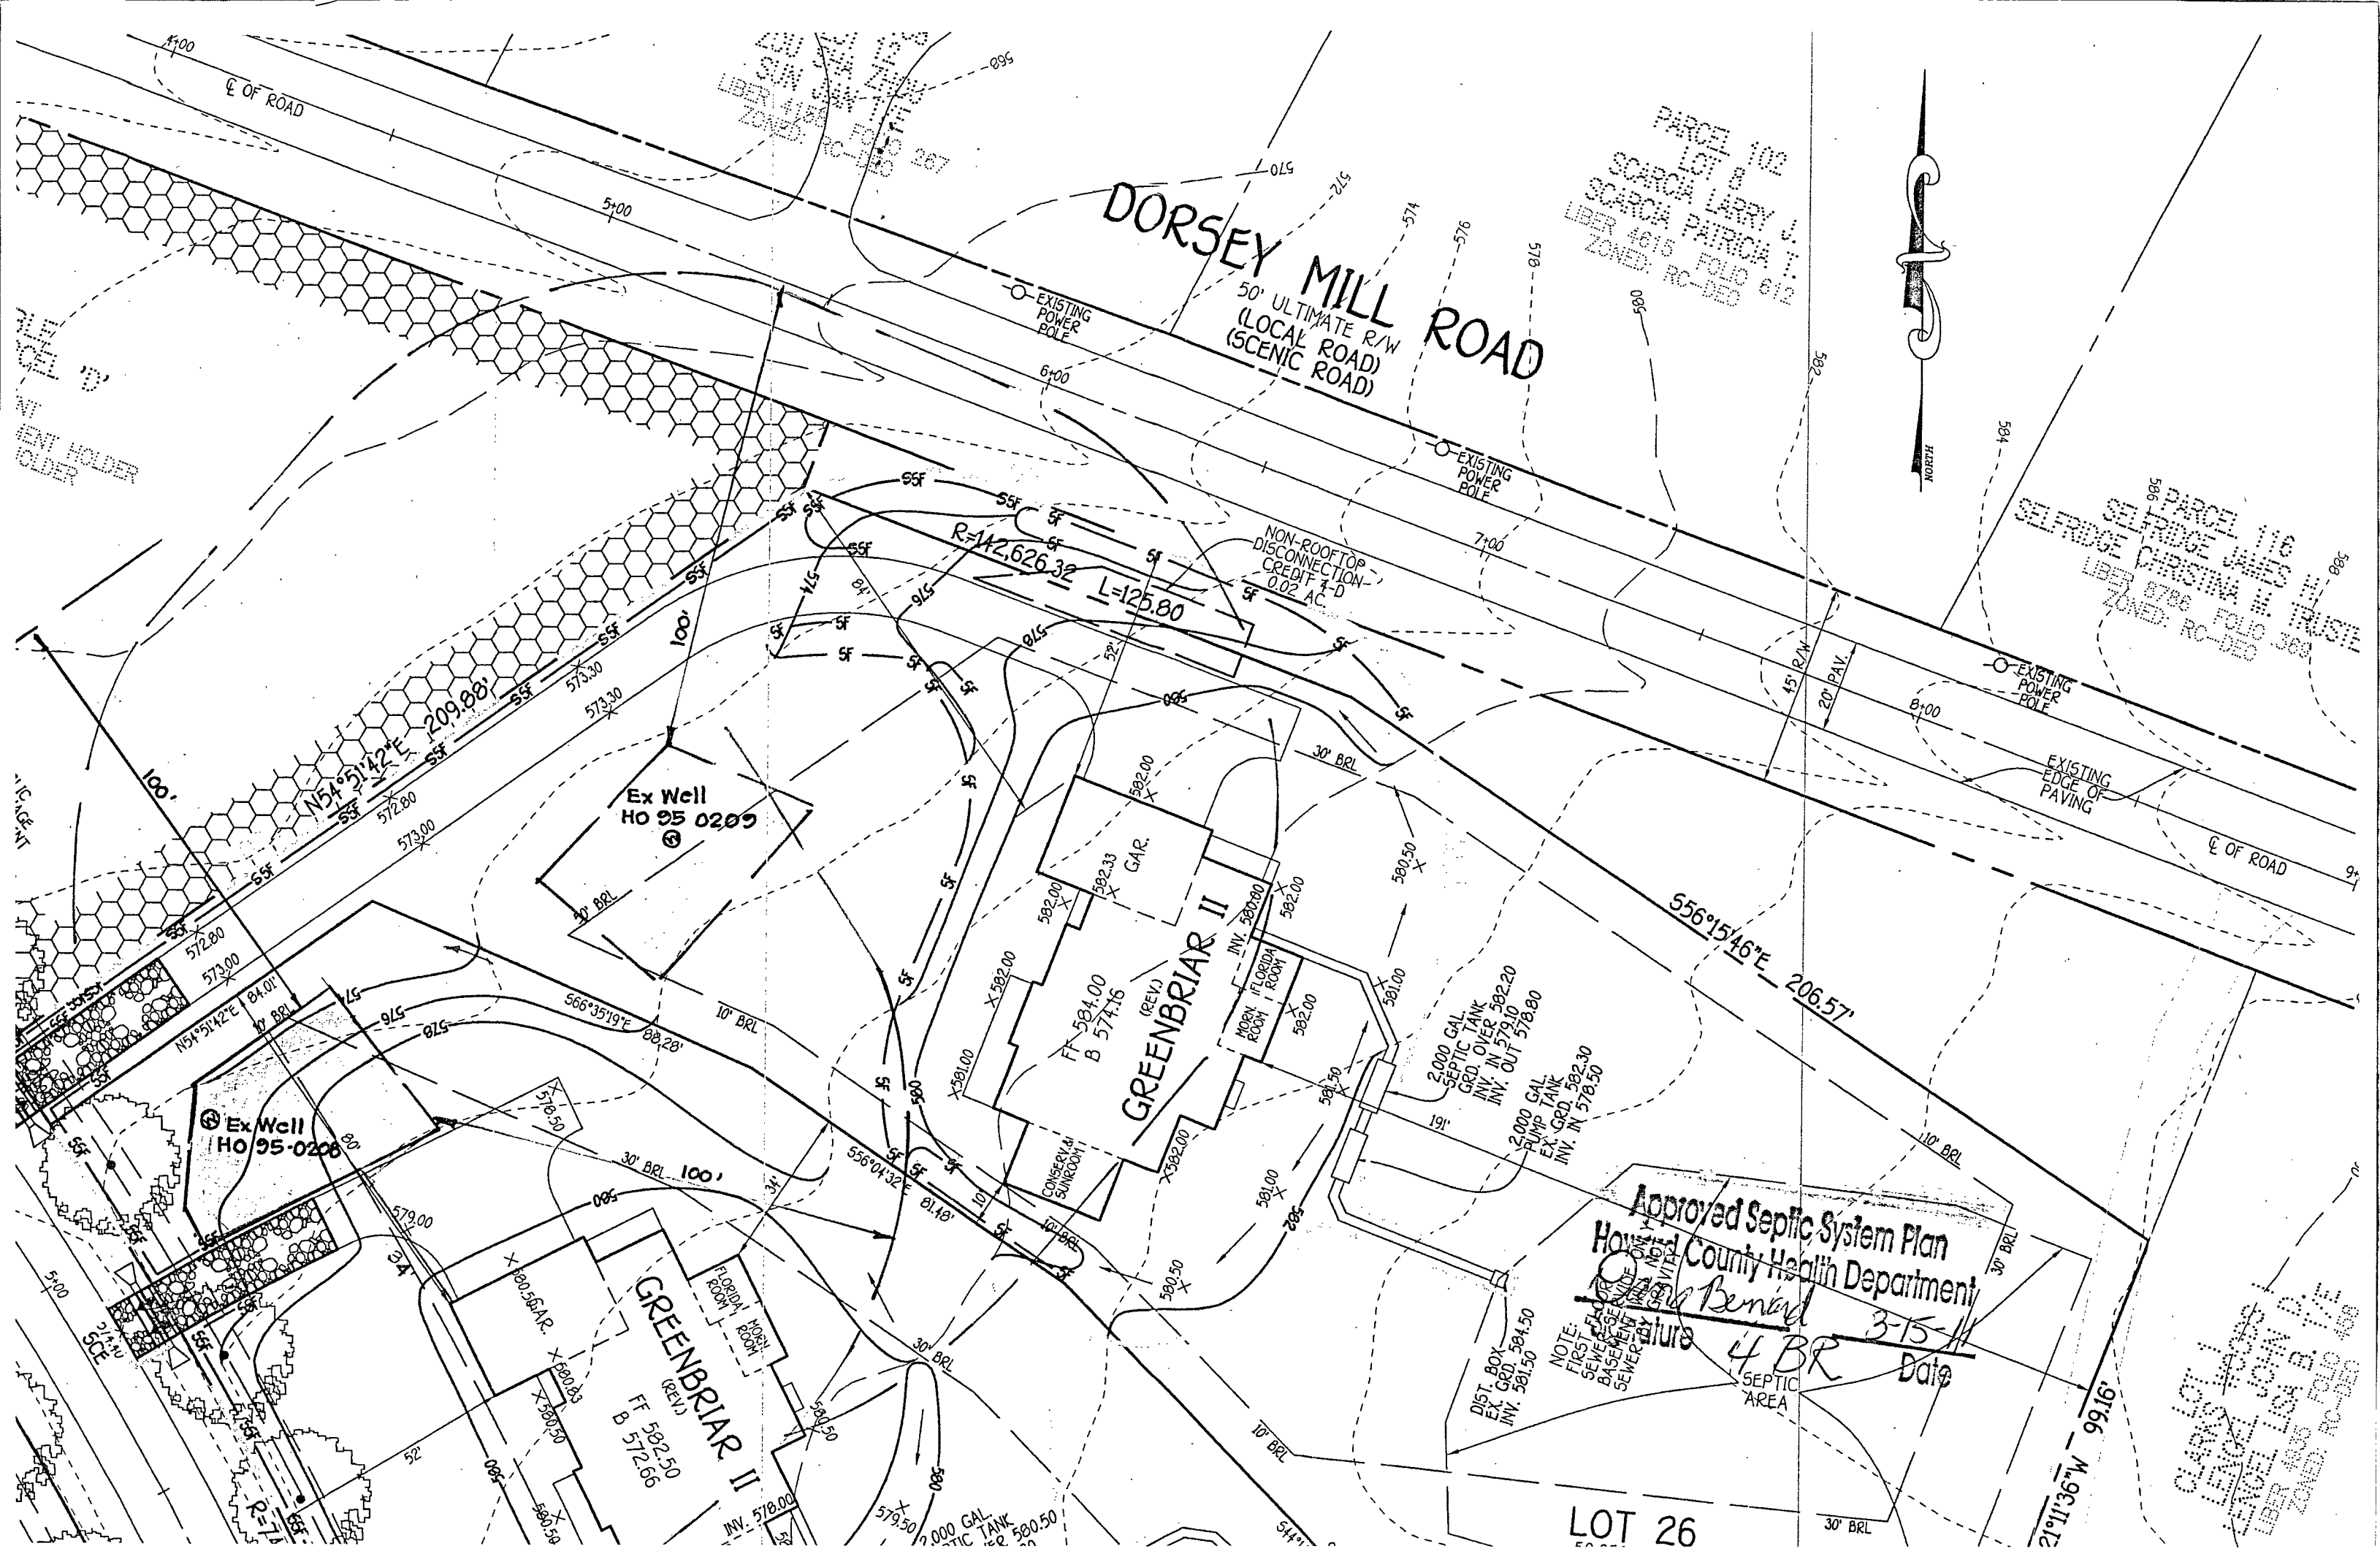

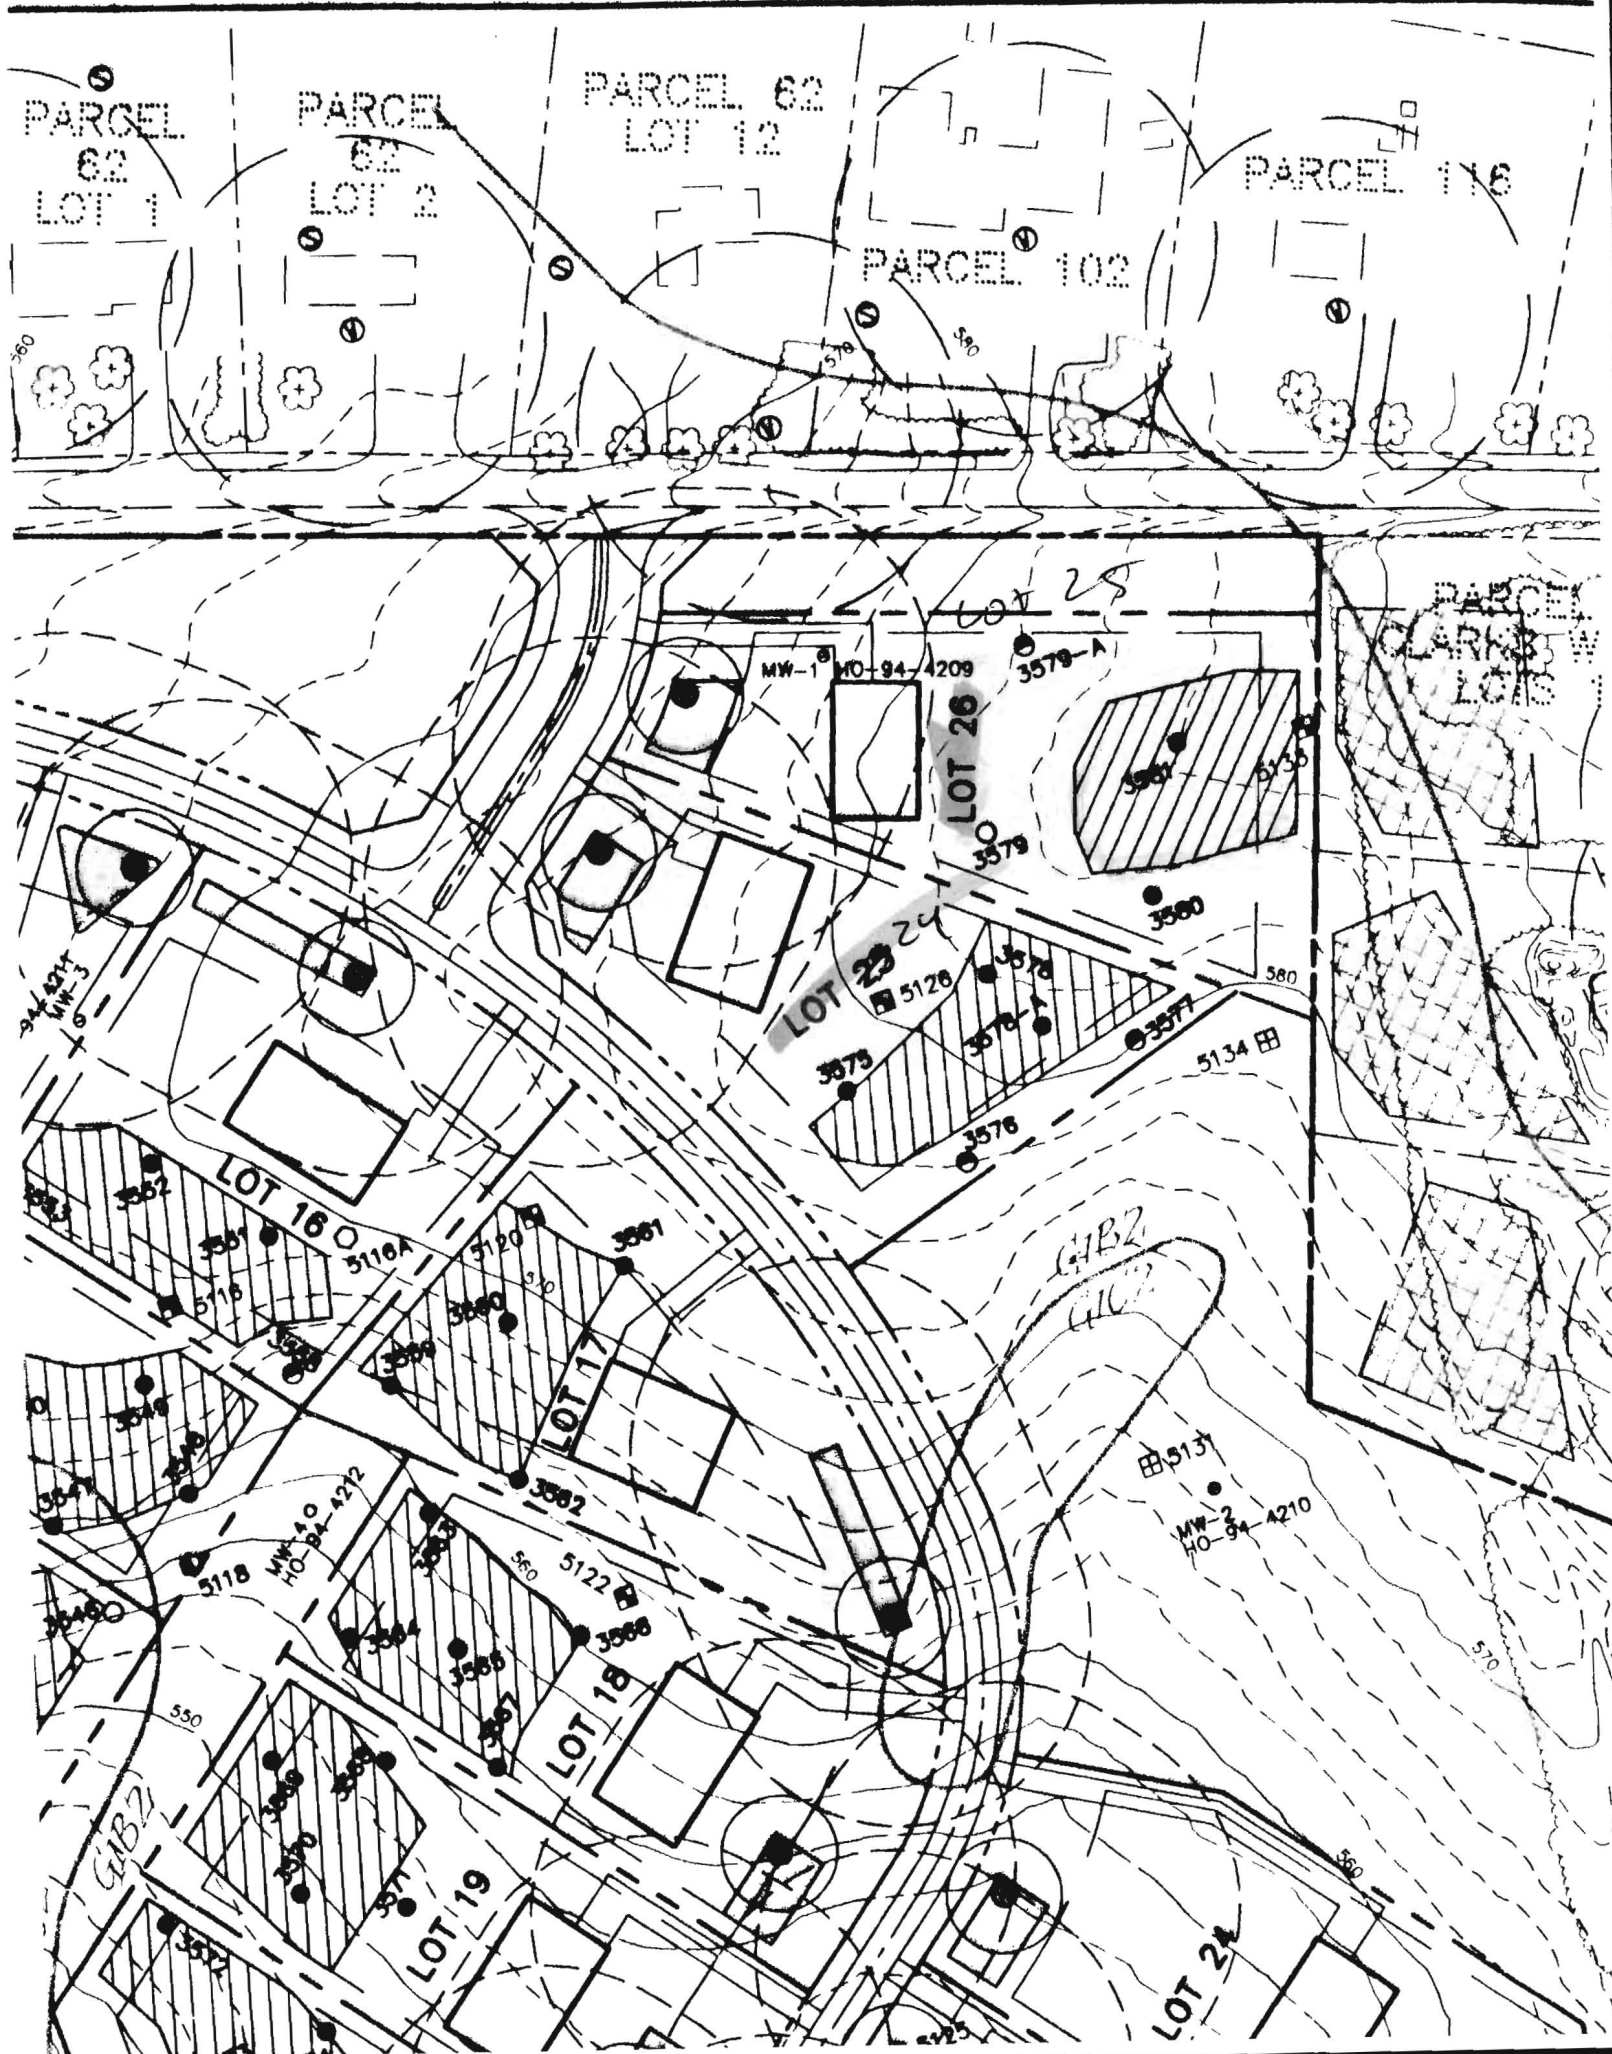

Maryland Department of Assessments and Taxation
Real Property Data Search (vw5.1A)
HOWARD COUNTY

[Go Back](#)
[View Map](#)
[New Search](#)
[GroundRent](#)
[Redemption](#)
[GroundRent](#)
[Registration](#)

Account Identifier: District - 04 Account Number - 371089

Owner Information

<u>Owner Name:</u>	DORSEY MILL LLC	<u>Use:</u>	RESIDENTIAL
		<u>Principal Residence:</u>	NO
<u>Mailing Address:</u>	5034 DORSEY HALL DR STE 102 ELLICOTT CITY MD 21042-7501	<u>Deed Reference:</u>	1) /06377/ 00654 2)

Location & Structure Information

<u>Premises Address</u>	<u>Legal Description</u>
14305 ROXBURY MEADOW DR GLENWOOD 21738-0000	LOT 26 1.149 A 14305 ROXBURY MEADOW DR CLARKS MEADOW RSB LOT 4

<u>Map</u>	<u>Grid</u>	<u>Parcel</u>	<u>Sub District</u>	<u>Subdivision</u>	<u>Section</u>	<u>Block</u>	<u>Lot</u>	<u>Assessment Area</u>	<u>Plat No:</u>	18484
0021	0017	0271		0000			26	2	<u>Plat Ref:</u>	

	<u>Town</u>	NONE
<u>Special Tax Areas</u>	<u>Ad Valorem</u>	100
	<u>Tax Class</u>	

<u>Primary Structure Built</u>	<u>Enclosed Area</u>	<u>Property Land Area</u>	<u>County Use</u>
		1.1400 AC	000000

<u>Stories</u>	<u>Basement</u>	<u>Type</u>	<u>Exterior</u>
----------------	-----------------	-------------	-----------------

Value Information

	<u>Base Value</u>	<u>Value</u>	<u>Phase-in Assessments</u>	
		As Of	As Of	As Of
		01/01/2011	07/01/2010	07/01/2011
<u>Land</u>	363,900	201,400		
<u>Improvements:</u>	0	0		
<u>Total:</u>	363,900	201,400	363,900	201,400
<u>Preferential Land:</u>	0			0

Transfer Information

<u>Seller:</u>	<u>Date:</u>	<u>Price:</u>
<u>Type:</u>	<u>Deed1:</u>	<u>Deed2:</u>
<u>Seller:</u>	<u>Date:</u>	<u>Price:</u>
<u>Type:</u>	<u>Deed1:</u>	<u>Deed2:</u>
<u>Seller:</u>	<u>Date:</u>	<u>Price:</u>
<u>Type:</u>	<u>Deed1:</u>	<u>Deed2:</u>

Exemption Information

<u>Partial Exempt Assessments</u>	<u>Class</u>	07/01/2011	07/01/2012
<u>County</u>			0.00
<u>State</u>			0.00
<u>Municipal</u>			0.00
<u>Tax Exempt:</u>	<u>Special Tax Recapture:</u>		
<u>Exempt Class:</u>	* NONE *		