

APPLICATION

PERCOLATION TESTING

A _____

P _____

HOWARD COUNTY HEALTH DEPARTMENT

BUREAU OF ENVIRONMENTAL HEALTH

3525-H ELLICOTT MILLS DRIVE/ELLICOTT CITY, MARYLAND 21043
TELEPHONE: 313-2640

DISTRICT _____

DATE _____

TO: THE COUNTY HEALTH OFFICER
ELLICOTT CITY, MARYLAND

I HEREBY APPLY FOR THE NECESSARY TEST PRIOR TO APPLICATION FOR PERMIT TO CONSTRUCT (OR RECONSTRUCT) A SEWAGE DISPOSAL SYSTEM.

PROPERTY OWNER Edgewood Farms, Inc.

ADDRESS 14943 Roxbury Road, Glenelg PHONE 410 531-4355

AGENT OR PROSPECTIVE BUYER TOLL BROS., Inc.

ADDRESS 7164 Columbia Gateway Drive, Suite 230 PHONE 410 872-9105

PROPERTY LOCATION: Columbia, MD 21046
Attn: Bill Wainger

SUBDIVISION _____ LOT NO. ① OF 32

ROAD AND DESCRIPTION TRIADELPHIA ROAD OPPOSITE OF HOWARD ROAD

64± ACRES, PARCEL P 90 (1295/48) & P 32 BORDER EAST & P 227 BORDER
TO THE NORTH. THIS PARCEL IS THE
RESIDUE OF FIFTH PARCEL LIBER 1295
FOLIO 98

TAX MAP Page 21 PARCEL # P 97

SIZE OF LOT 1± ACRE TYPE BLDG. SINGLE FAMILY
(SINGLE FAMILY DWELLING OR COMMERCIAL)

THE SYSTEM INSTALLED UNDER THIS APPLICATION IS ACCEPTABLE ONLY UNTIL PUBLIC FACILITIES BECOME AVAILABLE. I FULLY UNDERSTAND THE
FEE CONNECTED WITH THE FILING OF THIS PERC TEST APPLICATION IS NON-REFUNDABLE UNDER ANY CIRCUMSTANCES. I ALSO AGREE TO
COMPLY WITH ALL M.O.S.H.A. REQUIREMENTS IN TESTING THIS LOT. WKS
(SIGNATURE OF APPLICANT)

APPROVED BY _____ FOR _____ DATE _____

DISAPPROVED BY _____ FOR _____ DATE _____

HOLD PENDING FURTHER TESTS _____

REASONS FOR REJECTION OR HOLDING _____





PERCOLATION TEST PLAT/PRELIMINARY PLAT - TITLE OR I.D. # _____ DATE _____

SITE DEVELOPMENT PLAN/FINAL PLAT - TITLE OR I.D. # _____ DATE _____


THIS IS NOT A PERMIT

COUNTY #

SOIL PROFILE

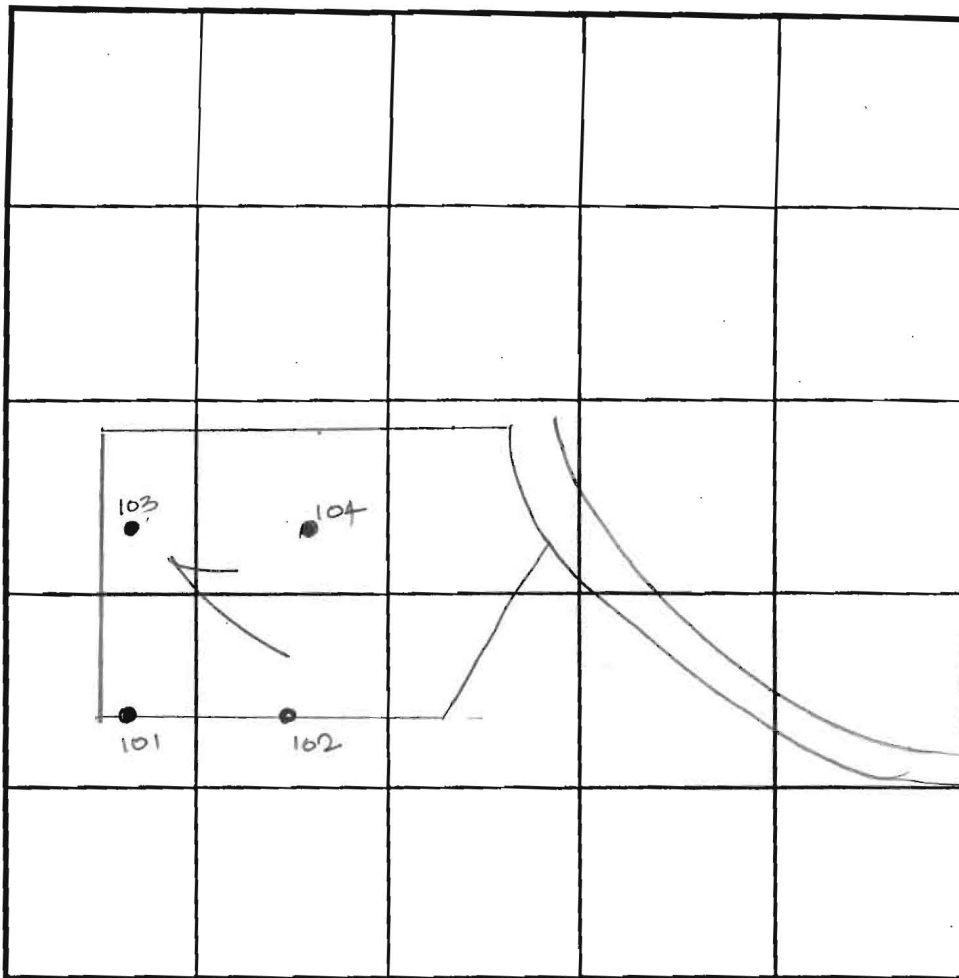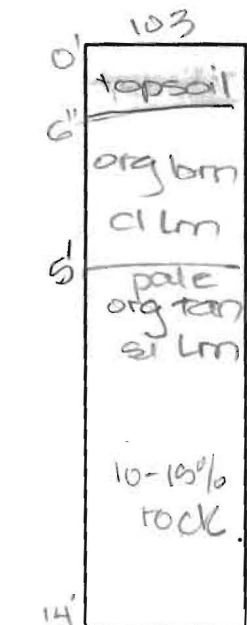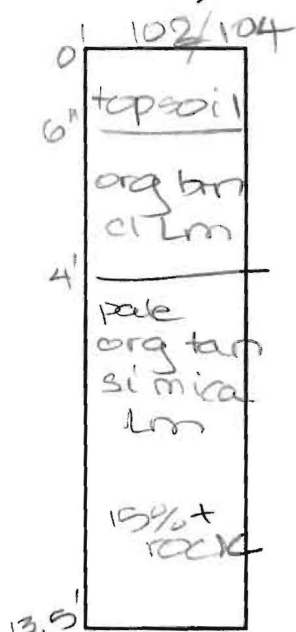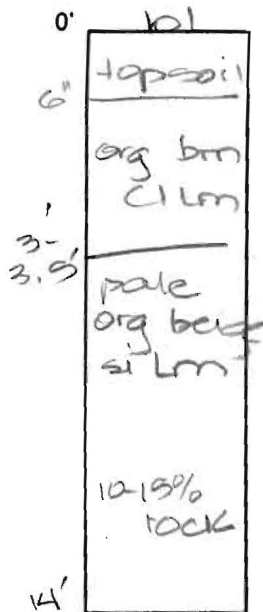

SOIL PROFILE

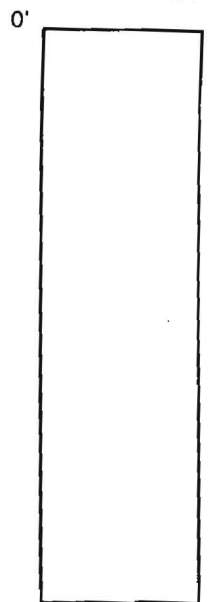

INDICATE NORTH - NAME ADJOINING ROADWAY AS BASE LINE.

Roxbury Road

DATE	TEST NO.	DEPTH	PRE-WET		TEST - 1" DROP		TIME
			START	STOP	START	STOP	
12-4-00	101	4.0'S	1:14	1:16	1:16	1:20	4
		14.0'D	visual - see profile				OK
	102	5.0'S	1:15	1:17	1:17	1:19	3
		13.5'D	visual - see profile				OK
	103	5.0'S	1:33	test	stopped		OK
		14.0'D	visual - see profile				OK
	104	5.0'S	1:53	1:56	1:56	2:06	10
		13.5'D	visual - see profile				OK

REMARKS: holes tested as stated

TYPE OF SOIL

TESTED BY: DCC ALSO PRESENT: Fogle's, Mr. Waring

TRENCH DESIGN DATA: AVERAGE PERCOLATION TIME TRENCH WIDTH

INLET DEPTH MAXIMUM BOTTOM DEPTH SQ. FT./BEDROOM

6162

6162

CHB2

CHB2

NON-BUILD
PRESERVATION
FOR STORMWAT
H.O.A. OW
HO. CO. ESMI
3.01 AC

FOREST CONSERVATION
EASEMENT #2

NON-BUILD
PRESERVATION
DEDICATED
ENVIRONMENTAL TRUS
HO. CO. ESMI
1.79

FOREST CONSERVATION
EASEMENT #1

4" TULIP
POPLAR
EX. C&P
POLY 72"

EX. CABLE BOX

EX. 12 CMP

EX. TRANSFORMER

EX. ROAD
CURVE SIGN

