

Building Permit Application

Howard County Maryland

Department of Inspections, Licenses and Permits

3430 Court House Drive
Permits: 410-313-2455

29		*	
Date !	Receive	d:	

www.howardcountymd.gov

A STATE OF

Permit No.: 8140037

		1xens Path		Property Owner's Name:	481 K	4 / 11	
City: State: Zip Code:				Address: 11667		زرا	
Suite/Apt. #SDP/WP/BA #:			City: S	tate:Fa			
Census Tract: Subdivision:			Phone: Email:		ix:		
		rea:Lot:		Applicant's Name & Mailing A	ddress, (If ot	her than	stated herein)
Tax Map: Parcel: Grid: Grid:				Applicant's Name: Address:			Section of the second
Zoning: Mar	p Coordi	nates:Lot Size:	2.427	City:	State:		Zip Code: 30 /63
				Phone: Email:	fax:		The state of the s
Existing Use:	, <u></u>						12 C/11(= 1)
		1 13855		Contractor Company:	E		7 7
Estimated Construction Cost		1.		Contact Person:			
			Lim i	Address:			
i die		200 m. 1 1668	2000	City:State	e:	_ Zip Cod	de:
# Polis	1,1	a 70 10 2/2 -		License No. :			
				Phone:	Fax:		ii Hen-
Occupant or Tenant:				Email:			
			□No.	Engineer/Architect Company:	Van de	7 KG	21182.11
		ed? □Yes	LINO	Engineer/Architect Company:	100	1 1	7
Contact Name:		· · · · · · · · · · · · · · · · · · ·	· }.	Responsible Design Prof.:	116/-12	- Cu	
Address:				Address:	1.31 1.	je -"	
City:		State: Zip Code:		City: Stat	e: / a.)	Zip Code	e: ") // "
Phone: Fax:				Phone: (5-1) 100-2			
to the state of				Email: 124 7	~/ TAX.	Suc. 201	Calira Ellet
Email:				Email:			
Commercial Building Chard	acteristic	Residential Building Chara	cteristics	Utilities	1 1 1		
Height:		SF Dwelling SF Townh		Water Supply	:		
No. of stories:			/idth	☐ Public		訓練講	
Gross area, sq. ft./floor:		1 st floor:		Private			
A	· ·	2 nd floor:		Sewage Disposa			
Area of construction (sq. ft.):	Basement:		□ Public			
Use group:		☐ Unfinished Basement		□ Private			
		☐ Crawl Space		Electric: 🗅 Yes 🗆 No			
Construction type	=	☐ Slab on Grade		Gas: Pyes D No			
☐ Reinforced Concrete		No. of Bedrooms:		Heating System		Market S	
☐ Structural Steel		Multi-family Dwelli	<u>ng</u>	☐ Electric ☐ Oil	· ·	Contract of	
☐ Masonry ☐ Wood Frame		No. of efficiency units: No. of 1 BR units:		□ Natural Gas □ Propane Gas			
☐ State Certified Modular		No. of 2 BR units:		Natural Gas La Propane Gas			
		No. of 3 BR units:		Sprinkler System		715020	
	1	Other Structure:		☐ Yes ☐ No	<u> </u>		
		Dimensions:			- 144 - 14	2 -	
Roadside Tree Project	-	Footings:		Cuading Don		57 (1847.4)	CAST INVESTMENT OF THE PARTY OF THE
	No	Roof:		Grading Perr	nit Number:		
Roadside Tree Project P	ermit #	☐ State Certified Modular ☐ Manufactured Home		Building Shell Perr	nit Number:	 	
WITH ALL REGULATIONS OF HOWA	ARD COUN	GREES AS FOLLOWS: (1) THAT HE/SHE IS A	THAT HE/SHE W	MAKE THIS APPLICATION; (2) THAT THE IN	FORMATION IS C	PERTY NO	T SPECIFICALLY DESCRIBED IN
2				1 11 THERE ROLL			
Applicant's Signature	2.1.	in to the same		nt Name			
Frank Address	6-1	HE SECHICUS		0/0/10/			<u> </u>
Email Address		¥	Da	ite		ř	
THE COMMENT OF THE CO	-	<u></u>	× 55	¥ 90.	ā		*
Title/Company		Ch. L. C. III.	NIDECTOR OF T	NAMES OF HOMES COMMEN			
		PLE		NANCE OF HOWARD COUNTY TLY & LEGIBLY USE ONLY-		7 5 14	
AGENCY	DATE	SIGNATURE OF APPROVAL	DPZ SETBACK	INFORMATION	Filing Fee		\$ 25
*			Front:		Permit Fee	2	\$

AGENCY	DATE	SIGNATURE OF APPROVAL			
State Highways					
Building Officials					
PSZA (Zoning)					
PSZA (Engineering)					
Health	10/28	IN H. Oswal			

☐ CONTINGENCY CONSTRUCTION START

White: Building Officials

Green: PSZA,Zoning

Rear: All minimum setbacks met? ☐ Yes ☐No Is Entrance Permit Required? Yes No ☐ Yes ☐ No Historic District? Lot Coverage for New Town Zone: SDP/Red-line approval date:

Yellow: PSZA,Engineering

Filing Fee	\$ 05
Permit Fee	\$
Tech Fee	\$
Excise Tax	\$
PSFS	\$.
Guaranty Fund	\$.
Add'l per Fee	\$
Total Fees	\$
Sub-Total Paid	\$
Balance Due	\$
Check	# 3/5

\Operations\Updated Forms\Building appimp 8.2012.docx

Oswald, Hank

From:

kogut_architects@comcast.net

Sent:

Wednesday, October 22, 2014 2:19 PM

To:

Oswald, Hank

Subject:

Re: B14003733 11627 Vixens Path

Mr. Oswald,

I just left a voice mail at your office. The plans for the garage are for a shell building only. There are no plans for living space, nor plumbing as a part of this permit submittal. The immediate owner need is for car storage, not living space. If you still need a set of plans please let me know and we will drop off a set at your office. If you have any questions, please feel free to call me.

From: "Hank Oswald" < hoswald@howardcountymd.gov>

To: "Kogut, Michael" < KOGUT ARCHITECTS@COMCAST.NET >

Sent: Wednesday, October 22, 2014 2:05:34 PM

Subject: B14003733 11627 Vixens Path

Michael Kogut:

This letter is in response to building permit B14003733. Our office did not receive a set of floor plans for the proposed garage. Please forward a set of floor plans for the proposed garage so this office can confirm the presence or absence of plumbing and living space.

Building permit approval is being withheld until confirmation is forwarded to the Health Department. I may be reached at (410) 313-1786 if you would like to discuss the project.

Respectfully,

Hank

Hank Oswald, L.E.H.S. Howard County Health Department Well and Septic Program (410) 313 - 1786

Oswald, Hank

From:

Oswald, Hank

Sent:

Wednesday, October 22, 2014 2:06 PM

To:

'KOGUT_ARCHITECTS@COMCAST.NET'

Subject:

B14003733_11627 Vixens Path

Michael Kogut:


This letter is in response to building permit B14003733. Our office did not receive a set of floor plans for the proposed garage. Please forward a set of floor plans for the proposed garage so this office can confirm the presence or absence of plumbing and living space.

Building permit approval is being withheld until confirmation is forwarded to the Health Department. I may be reached at (410) 313-1786 if you would like to discuss the project.

Respectfully,

Hank

Hank Oswald, L.E.H.S. Howard County Health Department Well and Septic Program (410) 313 - 1786

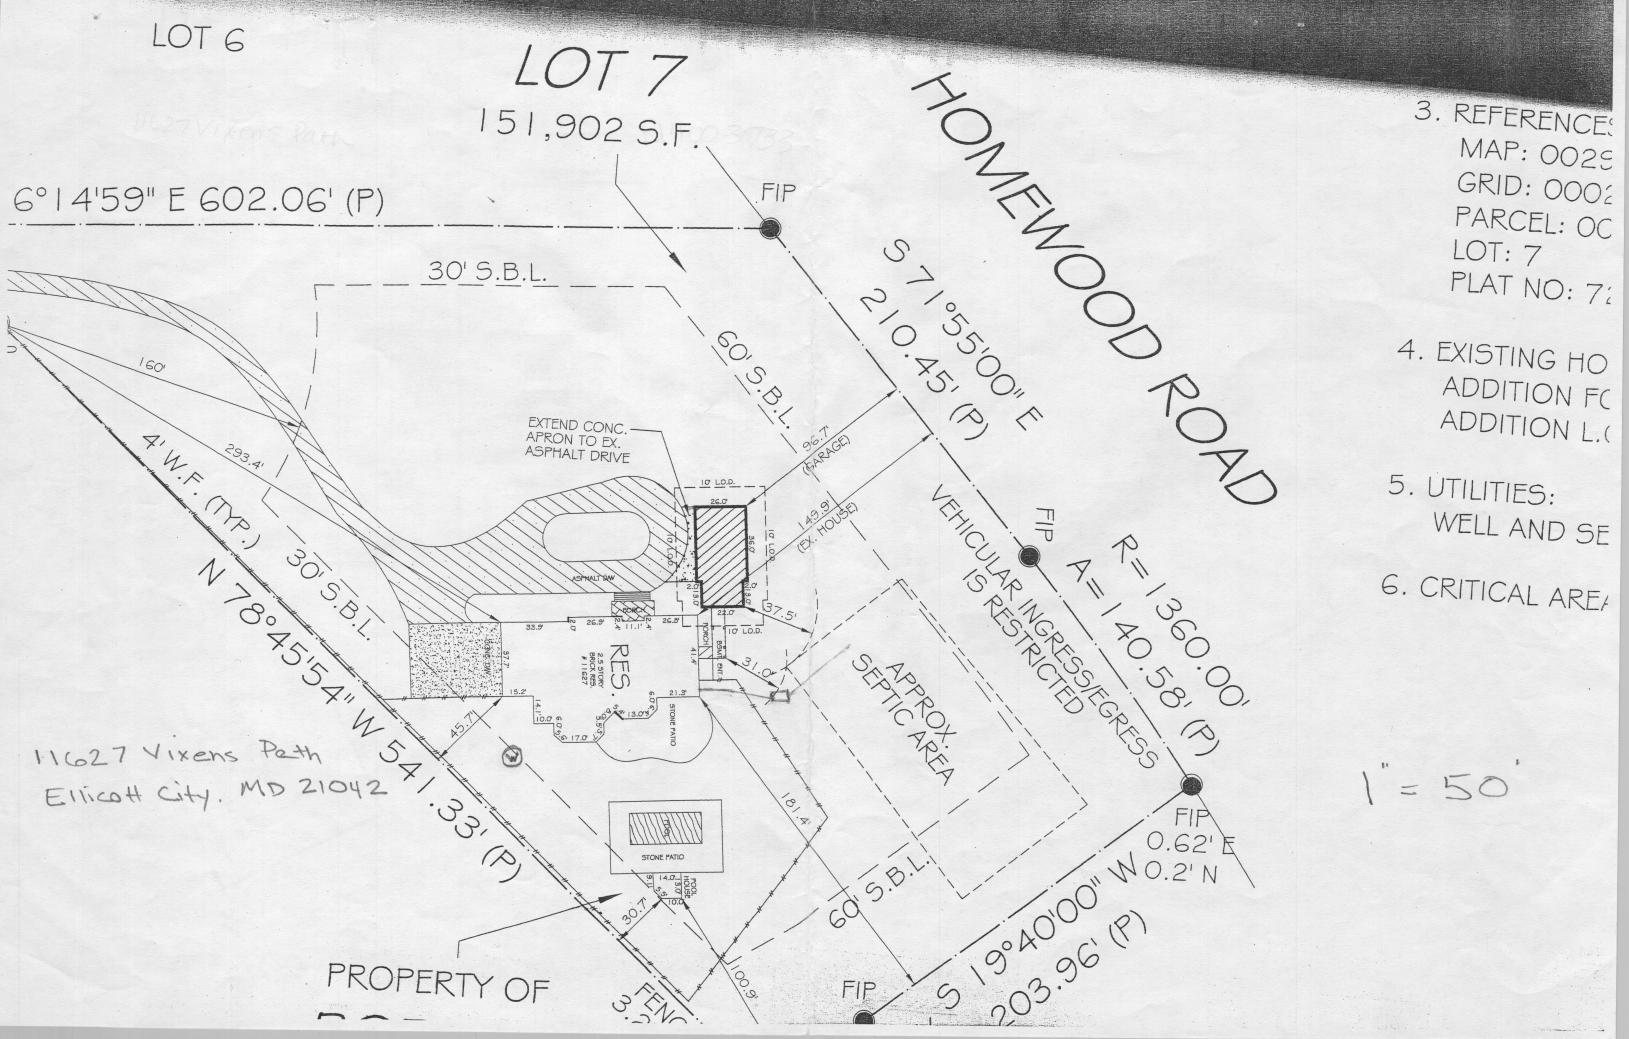

3. REFERENCES MAP: 0025

PARCEL: OC

4. EXISTING HO ADDITION FC ADDITION L.(

WELL AND SE