

APPLICATION

SEWAGE DISPOSAL TESTING

MARYLAND STATE DEPARTMENT OF HEALTH

HOWARD COUNTY

ELLICOTT CITY

DISTRICT 3

DATE 1/12/71

TO: THE COUNTY HEALTH OFFICER
ELLICOTT CITY, MARYLAND

I, HEREBY, APPLY FOR THE NECESSARY TESTS IN ORDER TO CONSTRUCT (OR RECONSTRUCT) A SEWAGE DISPOSAL SYSTEM.

PROPERTY OWNER Walter A. Shank

ADDRESS Walt-Ann Drive, Ellicott City, Md. PHONE 531-5631

PROPERTY LOCATION:

SUBDIVISION _____ LOT NO. _____

ROAD AND DESCRIPTION End of Sky Way in back of brick building

OCCUPANT _____ PHONE _____

PERSON TO CONSTRUCT SYSTEM _____

ADDRESS _____ PHONE Barn will be remodelled

SIZE OF LOT 22 acres ± TYPE BLDG 3
NUMBER OF BEDROOMS

IF NOT SINGLE RESIDENCE DESCRIBE _____

SIGNATURE OF APPLICANT W. A. Shank


APPROVED BY James H. Hays FOR Ray W. Hays DATE 1/20/71

REJECTED BY _____ FOR _____ DATE _____

HOLD PENDING FURTHER TESTS _____ DATE _____

REASONS FOR REJECTION OR HOLDING _____

THIS IS NOT A PERMIT

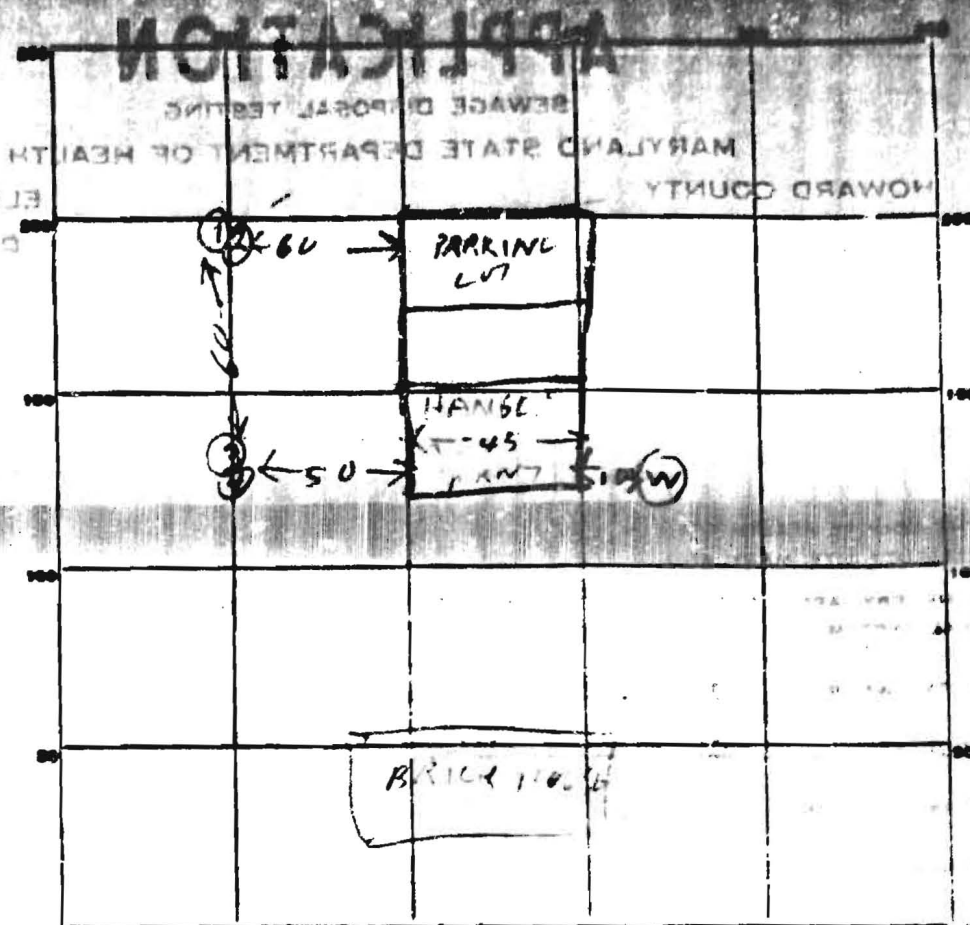


DATE	TEST NO.	DEPTH	PNE-WET START	STOP	TEST - 1" DROP START	STOP	TIME
1/2/71	1	10 1/2	941	942	941	943	1
	2	3 1/2	943	143	943	947	4
	3	10 1/2	952	958	958	1004	6
	4	3 1/2	954	956	956	959	2

DOIL AUGER FINISH

TESTED BY

REMARKS

THIS IS NOT A PERMIT

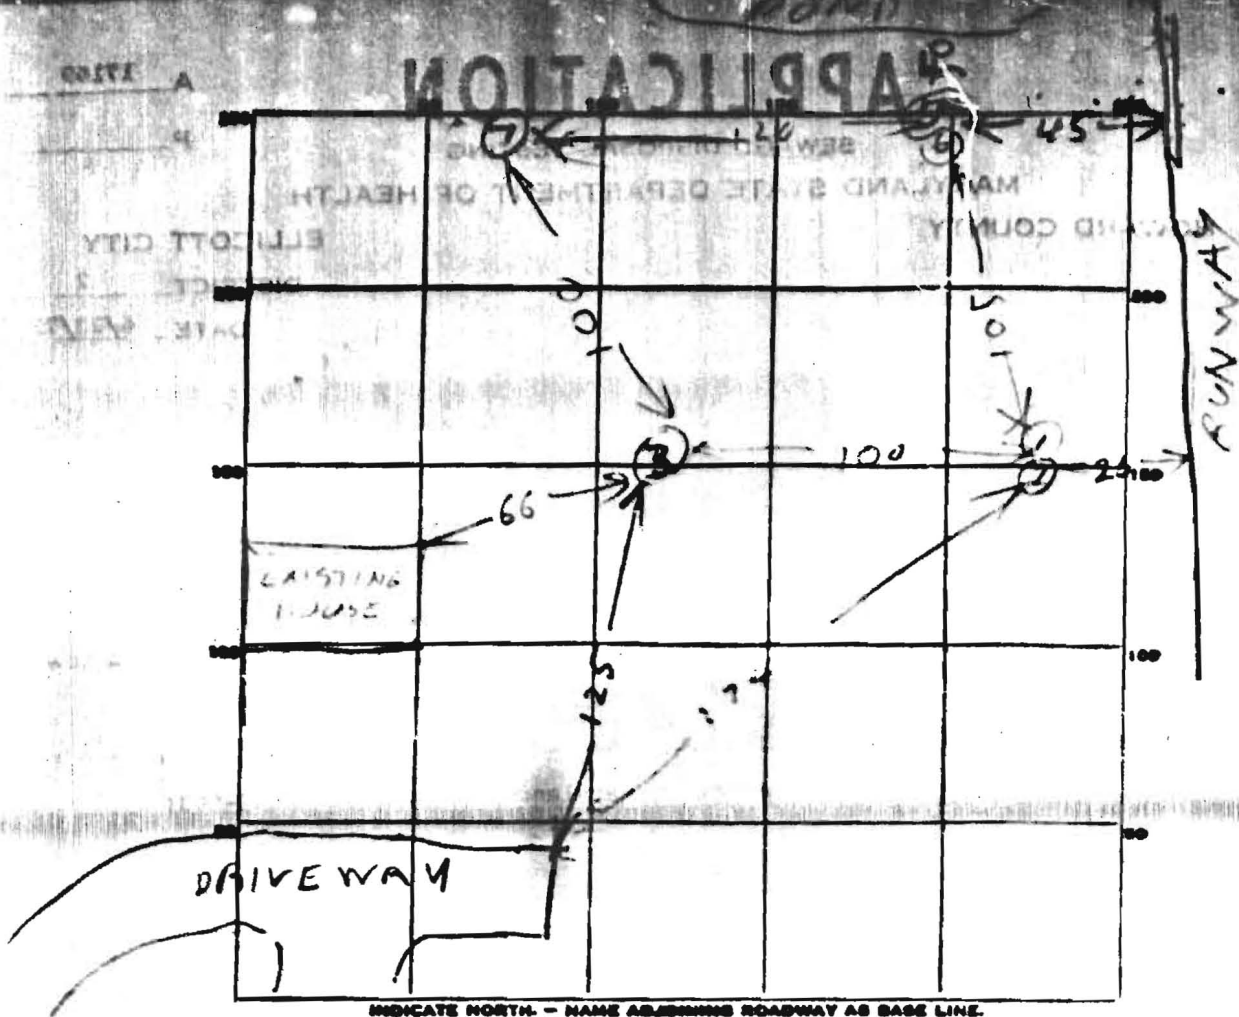

DATE	TEST NO.	DEPTH	PRE-WET		TEST - 1" DROP		TIME
			START	STOP	START	STOP	
11/12/72	1	1 1/2	1001	1003	1013	1026	18
	2	5	1004	1005	1014	1021	16
	3	1 1/2	1008	1012	1012	1017	5
	5	11	1022	1023	1019	1036	10
	6	5	1025	1032	1032	1041	9
7/12/72	7	10	1044	1047	1047	1054	

TOP 4 FT
CLAY

SOIL AUGER FINDING

TESTED BY

REMARKS