

10:30 AM

Thurs

PERMIT

SEWAGE DISPOSAL SYSTEM

MARYLAND STATE DEPARTMENT OF HEALTH

WARD COUNTY

ELLICOTT CITY

INDEXED

DISTRICT 2nd

DATE 8/15/72

Walter Shank IS PERMITTED TO INSTALL ☒ ALTER

13196 Sky Way, Ellicott City, Md.

PHONE 331-5631

DISPOSAL SYSTEM LOCATED AT

13196?

13196

N. ROAD Sky Way off Malt-Ann DR LOT

OWNER Walter Shank and wife

same as above

ROOMS 4 bedrooms

DRAIN FIELD DEPTH FEET. BOTTOM AREA SQ. FT.

SEEPAGE PITS ABSORBENT SIDE WALL AREA SQ. FT.

SEPTIC TANK CAPACITY 1250 GALLONS

FOR GARBAGE GRINDER, INCREASE DISPOSAL AREA 25% & TANK CAPACITY 50%.

DRY WELL - 500 sq. ft. sidewall area below the inlet no deeper than

5 ft. and the bottom of the dry well no deeper than 12 ft. Place the

dry well 115 ft. from the right rear corner of the existing house as seen when facing the existing house from the driveway and 150 ft. from the end of the existing driveway.

PERMIT VOID AFTER THREE YEARS.

NOTE: ALL PIPE FROM HOUSE TO SEPTIC TANK MUST BE CAST IRON.

NOTE: XI INSTALL STAND PIPE ON SEPTIC TANK AND DRY WELL.

APPROVED BY Raymond Hodges

DATE 7/13/72


SEPTIC TANK AND DISTRIBUTION BOX WITH WATER BEFORE CALLING FOR AN INSPECTION. COVER NO WORK EXCEPTED AND APPROVED.

THE HOWARD COUNTY COMMISSIONERS NOR THE HEALTH DEPARTMENT IS RESPONSIBLE FOR THE OPERATION OF ANY SYSTEM.

(LT B)

ref. to dwg of 13196 Sky Way

SKYWAY Drive

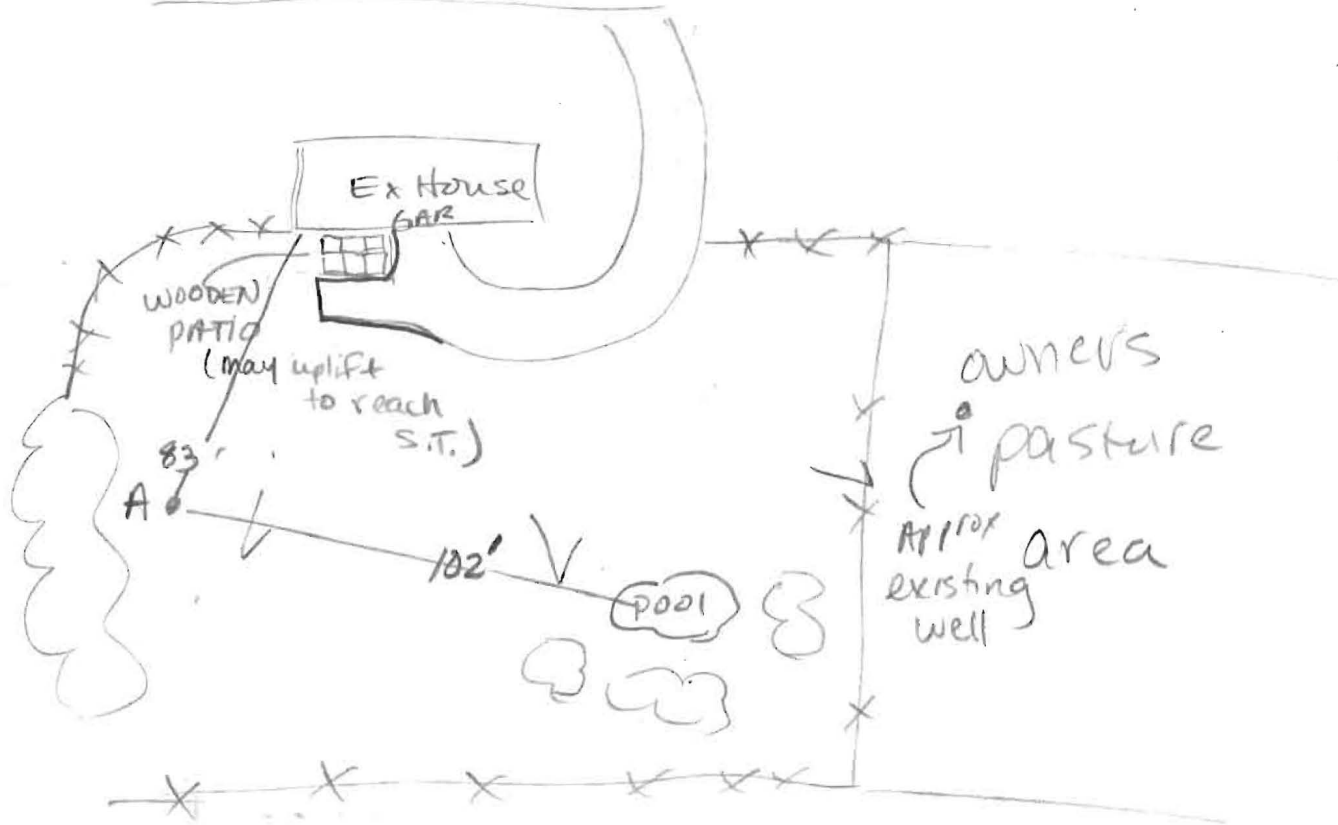

(A)

Strangorg
brn
Lm
Str. brn
Micae.
SLm
Saprolite small frags
& shist $\approx 15\%$
Bottom 13 $\frac{1}{2}$ '

3 $\frac{1}{2}$ ' S

10:59:40

11:13

11:27

15 min


210

210
x 4
1840

280 3'
10'

#2 smalls

120
7 840
7
-14

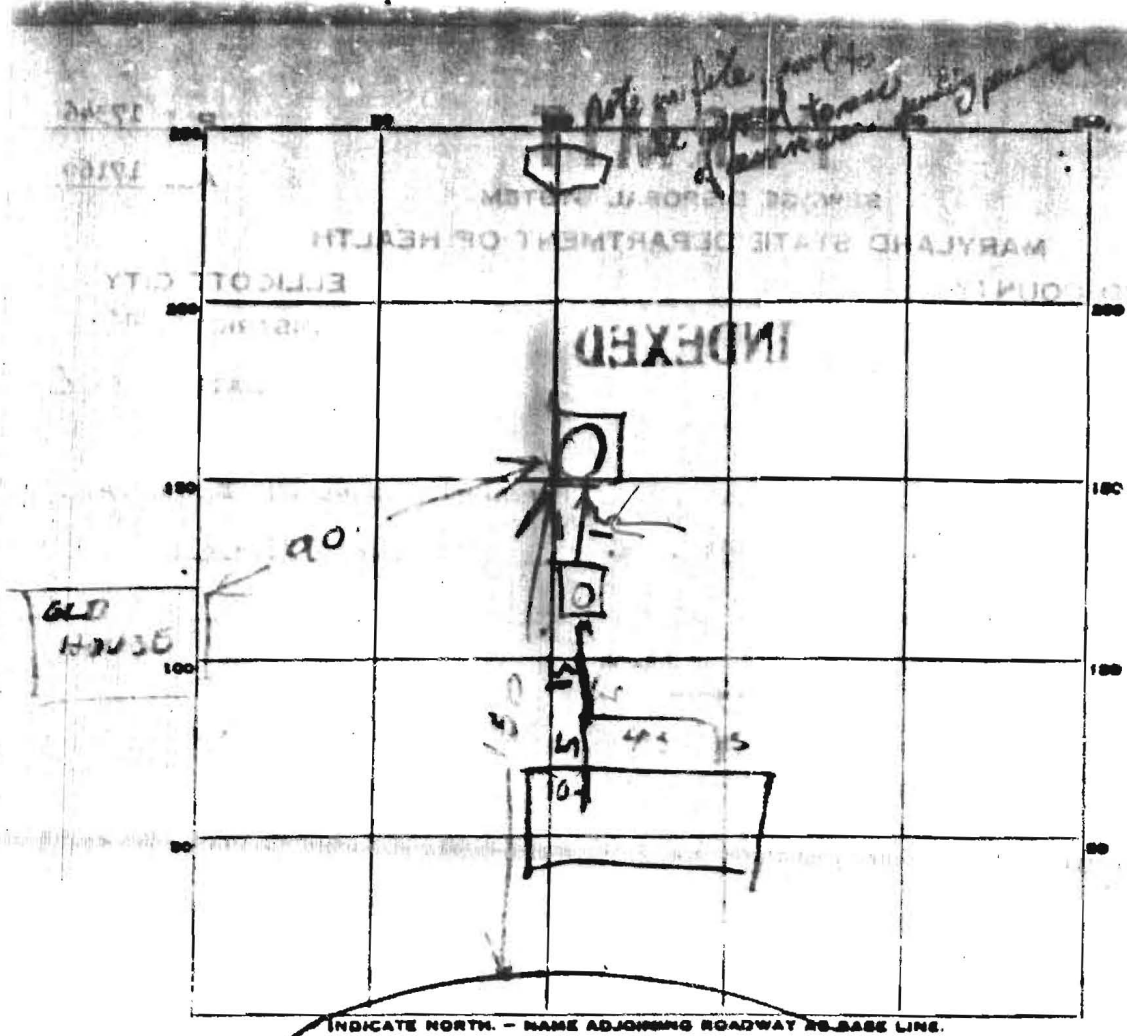

PERMIT CARD _____

SEPTIC TANK, LEVEL _____ CLEANOUTS _____

DISTRIBUTION BOX, LEVEL _____

PILE FIELD, DEPTH _____ FT. TRENCH WIDTH _____ FT.

GRAVEL DEPTH _____ IN. TOTAL LENGTH _____ FT.

NUMBER OF TRENCHES _____ TOTAL BOTTOM AREA _____

DEEPAGE PITS, INSIDE DIAMETER 12 FT. DEPTH BELOW INLET 10 FT.

ABSORBENT AREA 650 SQ. FT.

REMARKS Drywell inlet 4 ft
perimeter 65'

DATE SYSTEM APPROVED 3-5-12 INSPECTOR [Signature]