

PERMIT

SEWAGE DISPOSAL SYSTEM

MARYLAND STATE DEPARTMENT OF HEALTH

HOWARD COUNTY

ELLICOTT CITY

DISTRICT 2

DATE 1/21/71

INDEXED

2/1/71
of possible
ap! W. A. Shank
Walter A. Shank

IS PERMITTED TO INSTALL ☒ ALTER

ADDRESS Walt-John Drive, Ellicott City, Maryland

PHONE 531-5621

A SEWAGE DISPOSAL SYSTEM LOCATED AT _____

SUBDIVISION _____

ROAD End of Sky Way

LOT _____

PROPERTY OWNER Walter A. Shank

ADDRESS _____

SPECIFICATIONS - barn or hangar being remodelled in 3 bedrooms

DRAIN FIELD _____ DEPTH _____ FEET, BOTTOM AREA _____ SQ. FT.

SEEPAGE PITS _____ ABSORBENT SIDE-WALL AREA _____ SQ. FT.

SEPTIC TANK CAPACITY 1,000 GALLONS

FOR GARBAGE GRINDER, INCREASE DISPOSAL AREA 22% & TANK CAPACITY 50%.

OTHER Dry well - 300 sq. ft. sidewall area below the inlet with a maximum depth of

11 ft. below grade at time of perc test. Place the dry well between 50 ft. and 70 ft. from
the side of the building opposite from the side of the building where the well is located.

NOTE: ALL PIPE FROM REMODELLED BARN TO SEPTIC TANK MUST BE CAST IRON.

PERMIT VOID AFTER THREE YEARS.

PLANS APPROVED BY Raymond Rodges

DATE 1/20/71


FILL SEPTIC TANK AND DISTRIBUTION BOX WITH WATER BEFORE CALLING FOR AN INSPECTION. COVER NO WORK UNTIL INSPECTED AND APPROVED.

NEITHER THE HOWARD COUNTY COMMISSIONERS NOR THE HEALTH DEPARTMENT IS RESPONSIBLE FOR THE SUCCESSFUL OPERATION OF ANY SYSTEM.

(let A)

refer to 13196 SK, Way Hwy.

A 15682

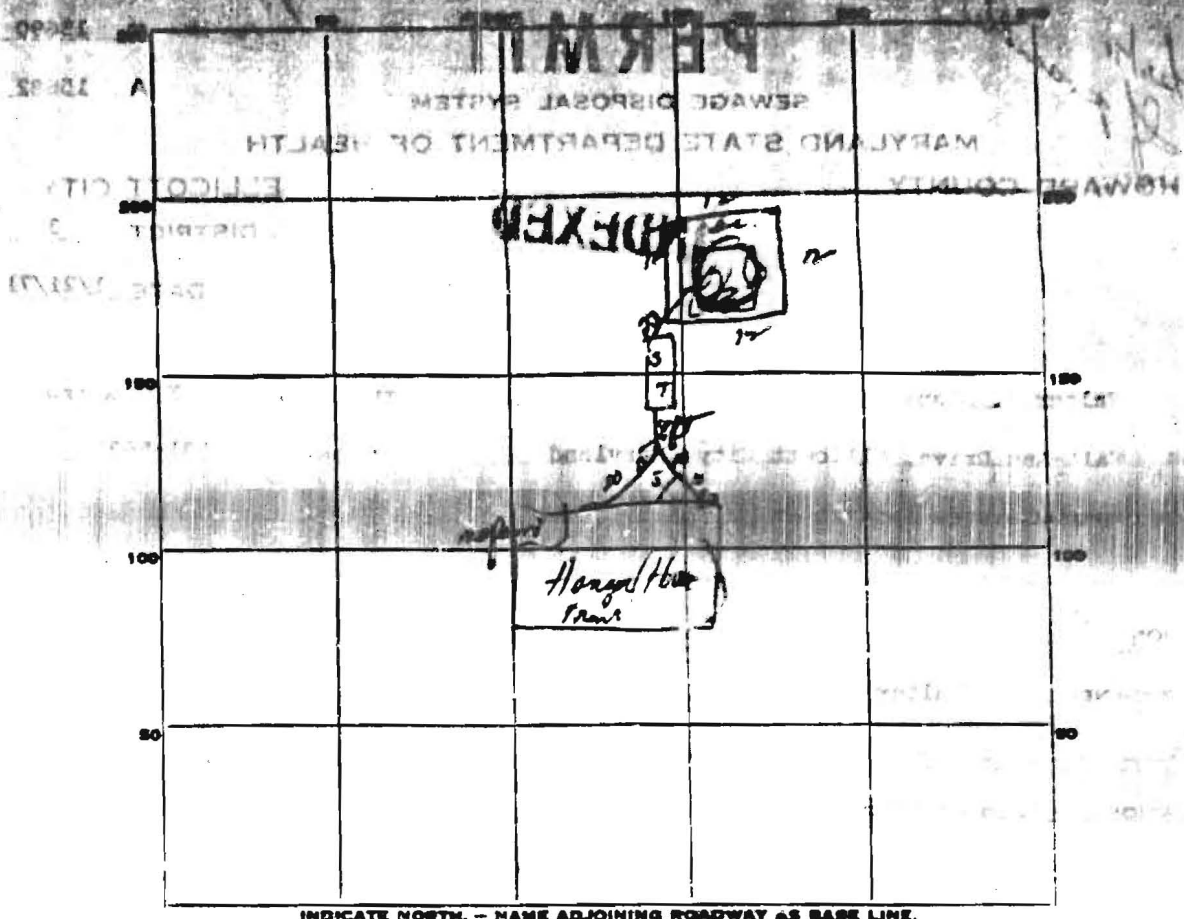

PERMIT CARD new parties
 SEPTIC TANK, LEVEL 12 CLEANOUTS 0/1
 DISTRIBUTION BOX, LEVEL _____
 TILE FIELD, DEPTH _____ FT. TRENCH WIDTH _____ FT.
 GRAVEL DEPTH _____ IN. TOTAL LENGTH _____ FT.
 NUMBER OF TRENCHES _____ TOTAL BOTTOM AREA _____
 SEEPAGE PITS, INSIDE DIAMETER Perimeter 48 FT. DEPTH BELOW INLET 7 FT.
 ABSORBENT AREA 336 SQ. FT.

REMARKS _____

DATE SYSTEM APPROVED 2-26-71 INSPECTOR W. J. [Signature]