

# APPLICATION

SEWAGE DISPOSAL TESTING

STATE OF MARYLAND - DEPARTMENT OF HEALTH AND MENTAL HYGIENE

HOWARD COUNTY HEALTH DEPARTMENT  
ENVIRONMENTAL HEALTH SERVICES

P. O. BOX 476 ELLICOTT CITY, MARYLAND 21043  
TELEPHONE: 992-2330

A 39513

P \_\_\_\_\_

DISTRICT 30

DATE April 20, 1987

TO: THE COUNTY HEALTH OFFICER  
ELLICOTT CITY, MARYLAND

I, HEREBY, APPLY FOR THE NECESSARY TEST IN ORDER TO CONSTRUCT (OR RECONSTRUCT) A SEWAGE DISPOSAL SYSTEM.

PROPERTY OWNER John A. Brender Brian Isaac + Sharon Isaac

ADDRESS Rover Mill Road 696-9200 (w) PHONE 382-6227  
465-4777

PROPERTY LOCATION:

SUBDIVISION Mc Connick Property LOT NO. #10 on Final

ROAD AND DESCRIPTION on the East side of Rover Mill Road, at the intersection of  
Old Rover Road (13940 Rover Mill Road)

SIZE OF LOT 3 Acre Minimum TYPE BLDG. 3-4  
(NUMBER OF BEDROOMS)

THE SYSTEM INSTALLED UNDER THIS APPLICATION IS ACCEPTABLE ONLY UNTIL PUBLIC FACILITIES BECOME AVAILABLE. I FULLY UNDERSTAND THE  
FEE CONNECTED WITH THE FILING OF THIS PERC TEST APPLICATION IS NON-REFUNDABLE UNDER ANY CIRCUMSTANCES. I ALSO AGREE TO COMPLY  
WITH ALL M.O.S.H.A. REQUIREMENTS IN TESTING THIS LOT.

Dennis M. Ruoli

(SIGNATURE OF APPLICANT)

APPROVED BY \_\_\_\_\_ FOR \_\_\_\_\_ DATE \_\_\_\_\_

REJECTED BY \_\_\_\_\_ FOR \_\_\_\_\_ DATE \_\_\_\_\_

HOLD PENDING FURTHER TESTS \_\_\_\_\_ DATE \_\_\_\_\_

REASONS FOR REJECTION OR HOLDING 5-2782 Rec. construction, hold for PERM 5/16/87 6-29-87 NO



ADJUSTMENT IN PERC AREA PERMITTED DOWNSLOPE SA

BLDG. PERMIT SIGNED

AND RETURNED

10/16/91  
Serial # 39934 - SFD

# THIS IS NOT A PERMIT

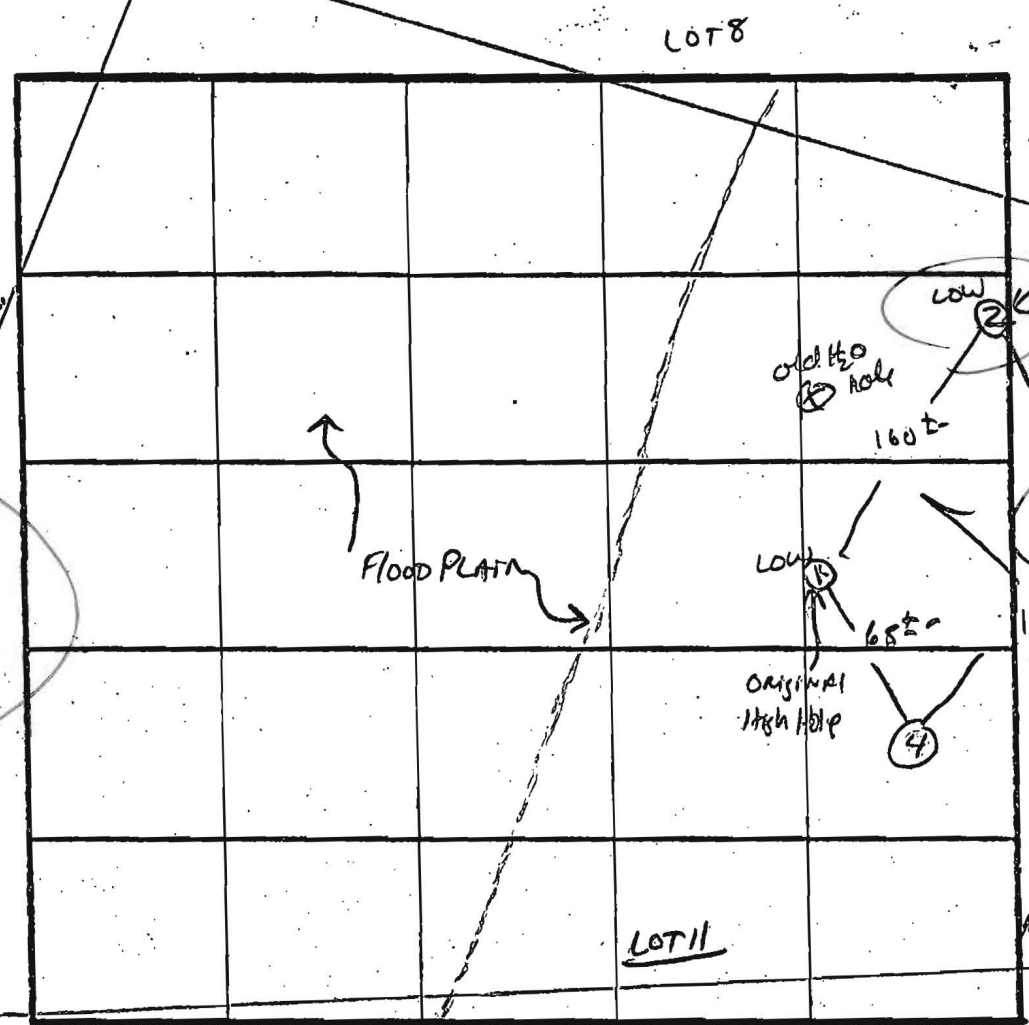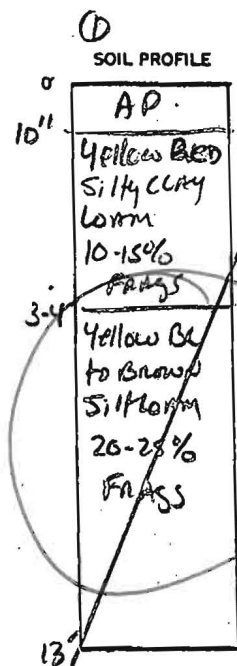

15' OFF FROM ORIGINAL High Hole

95±

120±

LOT 9

7' x 8' m

190 ± 1 BR

MAX INLET 3'

BOTTOM S

LOT 10 INDICATE NORTH, NAME ADJOINING ROADWAY AS BASE LINE.

↓ ROVER #11 RD.

| DATE    | TEST NO. | DEPTH                               | PRE-WET |       | TEST - 1" DROP |      | TIME   |
|---------|----------|-------------------------------------|---------|-------|----------------|------|--------|
|         |          |                                     | START   | STOP  | START          | STOP |        |
| 4/27/87 | 1 S      | 4.5'                                | 12:40   | 12:52 | 12:52          | 1:15 | 23 min |
|         | 1 V      | 13' UNIFORM Soil below 4'           |         |       |                |      |        |
|         | 2 S      | 3.5'                                | 1:18    | 1:24  | 1:24           | 1:33 | 9 min  |
|         | 2 V      | 13' WATER AT 12.5' UNIFORM below 3' |         |       |                |      |        |
|         | 3 S      | 4'                                  | 1:21    | 1:22  | 1:22           | 1:24 | 2 min  |
|         | 3 V      | 7.5'                                | 1:22    | 1:23  | 1:23           | 1:25 | 2 min  |
|         | 3 V      | 12' UNIFORM Soil below 3.5'         |         |       |                |      |        |
|         | 4 S      | 4'                                  | 1:25    | 1:27  | 1:27           | 1:32 | 5 min  |
|         | 4 V      | 12' UNIFORM Soil below 3.5'         |         |       |                |      |        |
|         |          |                                     |         |       |                |      |        |
|         |          |                                     |         |       |                |      |        |
REMARKS Holes Diff Than Plat - Shallow Syst only

TYPE OF SOIL Chester

S. Am

DR. R. H. D. W. T. L.