


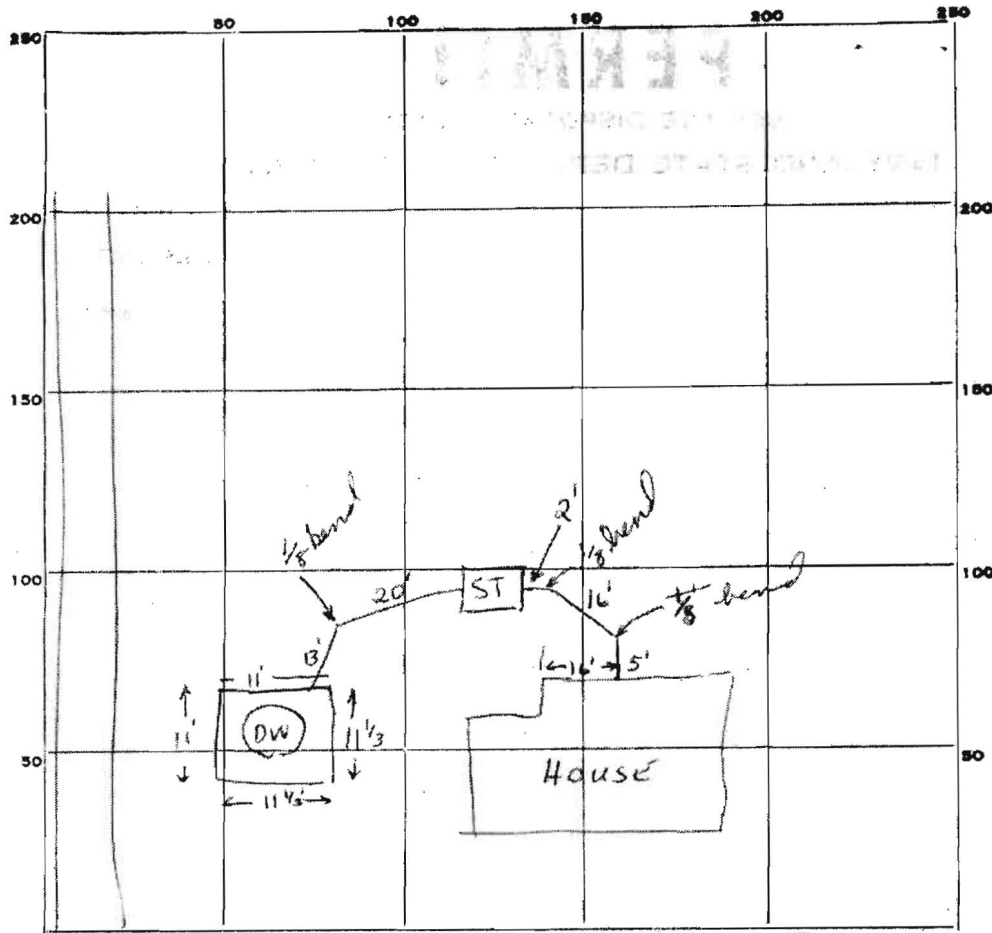

INDICATE NORTH - NAME ADJOINING ROADWAY AS BASE LINE.

HENRYTON RD

PERMIT CARD none seen

SEPTIC TANK, LEVEL 1000 gal

CLEANOUTS ST / DW ☒ / ☒

DISTRIBUTION BOX, LEVEL

TRENCH TILE FIELD, DEPTH 11 FT. TRENCH WIDTH 2 FT.

GRAVEL DEPTH 7 IN. TOTAL LENGTH 17 FT.

NUMBER OF TRENCHES 1 TOTAL BOTTOM AREA 102

SEEPAGE PITS, INSIDE DIAMETER 44 2/3 FT. DEPTH BELOW INLET 7 FT. 6' eff

ABSORBENT AREA 268 SQ. FT. in DW ; 370 TOTAL (eff)

REMARKS 5/10/77 OK to cover system

BUILDING PERMIT SIGNED
AND RETURNED

DATE SYSTEM APPROVED

5/10/77

INSPECTOR

William H. Japp