

APPLICATION

A 19296

SEWAGE DISPOSAL TESTING

P _____

STATE OF MARYLAND - DEPARTMENT OF HEALTH AND MENTAL HYGIENE

HOWARD COUNTY HEALTH DEPARTMENT
ENVIRONMENTAL HEALTH SERVICES

DISTRICT 3rd

P. O. BOX 476, ELLICOTT CITY, MARYLAND 21043
TELEPHONE: 465-8000, EXT. 386

DATE 11/14/73

Preliminary
DRY WELL - 360 SQ FT SIDEWALL AREA BELOW TOP 5 FT CLAY
480 SQ FT SIDEWALL AREA BELOW TOP 5 FT CLAY

DRY WELL INLET TO BE 4 FT DEEP AND
BOTTOM OF DRY WELL TO BE 12 FT DEEP
PLACE THE DRY WELL 125 FT FROM THE
LOT LINE ALONG HENRYTON RD
AND 25 FT FROM THE LOT LINE
TO THE COUNTY HEALTH OFFICER

ELLICOTT CITY, MARYLAND

ALONG RAMSBURG RD

I, HEREBY, APPLY FOR THE NECESSARY TEST IN ORDER TO CONSTRUCT (OR RECONSTRUCT) A SEWAGE
DISPOSAL SYSTEM. LOT ALSO SUITABLE FOR

PROPERTY OWNER E. L. Ramsburg and wife

TRENCHES

ADDRESS 185 Henryton Road, Marriottsville, Md.

Any questions call Purdum and
Jeschke, 46-5-1635

PHONE

PROPERTY LOCATION:

SUBDIVISION

Henryton Heights

LOT NO.

Now 11 sect 1
B, Sect. 1

ROAD AND DESCRIPTION

Unnamed road off Henryton Road

SIZE OF LOT 40,000 sq. ft. ±

TYPE BLDG.

(3) or 4 bedrooms

NUMBER OF BEDROOMS

IF NOT SINGLE RESIDENCE DESCRIBE _____

THE SYSTEM INSTALLED UNDER THIS APPLICATION IS ACCEPTABLE ONLY UNTIL PUBLIC
FACILITIES BECOME AVAILABLE.

SIGNATURE OF APPLICANT /s/ E. L. Ramsburg

APPROVED BY Raymond Hodges

FOR

Dry Well
(KIND OF SYSTEM)

DATE

12/1/75

REJECTED BY _____

FOR _____

(KIND OF SYSTEM)

DATE _____


HOLD PENDING FURTHER TESTS _____

DATE _____

REASONS FOR REJECTION OR HOLDING _____

BLDG. PERMIT SIGNED
AND RETURNED 8/9/76

THIS IS NOT A PERMIT

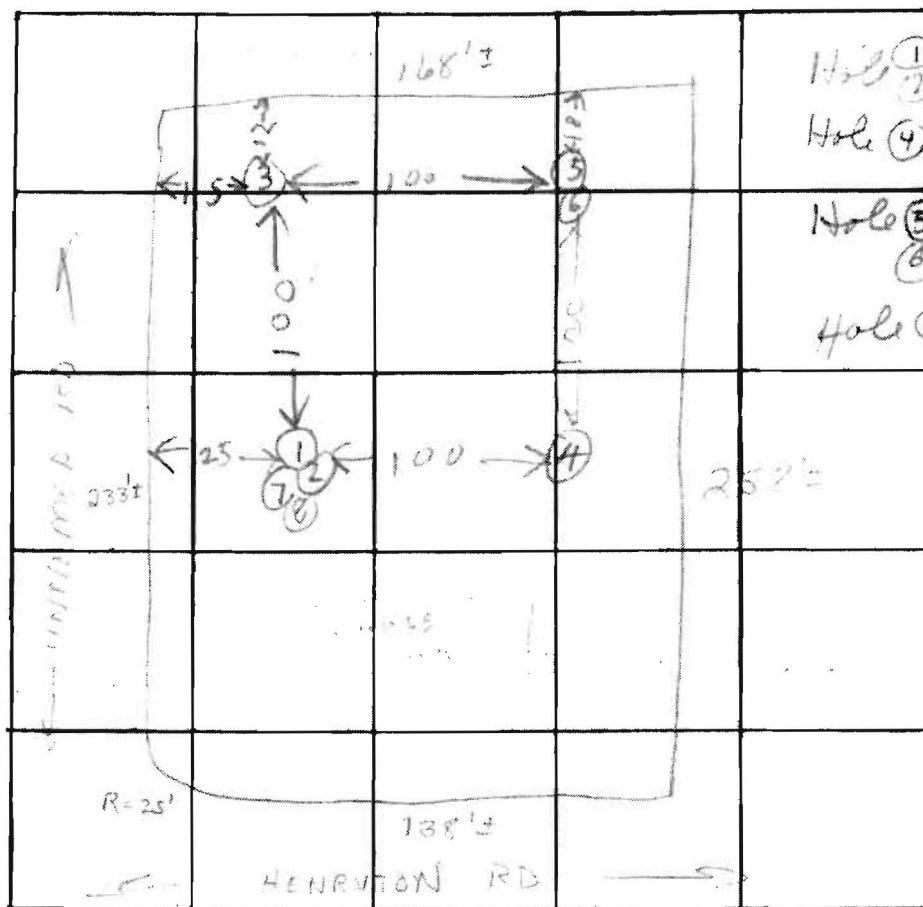

INDICATE NORTH - NAME ADJOINING ROADWAY AS BASE LINE

DATE	TEST NO.	DEPTH	PRE-WET		TEST - 1" DROP		TIME
			START	STOP	START	STOP	
11/6/73	1	1'	946	949	949	952	3
	2	4'	947	1002	little per		
	3	11'	TOP 3 FT CLAY		SANDY		DRY
	4	11'	TOP 2 1/2 FT CLAY		SAND		DRY
	3	3 1/2'	955	957	957	959	1
	6	11'	956	957	957	959	1
	7	12 1/2'	TOP 5 FT CLAY		SANDY		DRY
11/6/73	8	6'	1010	1011	1011	1012	1

artesian
1 man

Max Depth
4 FT. inlet

REMARKS

TYPE OF SOIL