

03-296997

APPROVED
4 DEC 86 R12
P 38076

PERMIT

SEWAGE DISPOSAL SYSTEM

A 34958

MARYLAND STATE DEPARTMENT OF HEALTH

HOWARD COUNTY

BUREAU OF ENVIRONMENTAL HEALTH

X992-2330X

461-9933

INDEXED

ELLICOTT CITY

DISTRICT 3rd

DATE 11/19/86

{ I.C.O.P. issued only }
Time expired

Fogle's Septic Service, Inc.

IS PERMITTED TO INSTALL ☒ ALTER ☐

ADDRESS 6430 Woodbine Road, Woodbine, Maryland 21797 PHONE 795-5670

SUBDIVISION Breezewood Farms ROAD 1888 Breezewood Farms LOT 5

PROPERTY OWNER Curtis R. Sauer

ADDRESS

IF GARBAGE GRINDER IS USED INCREASE SEPTIC TANK CAPACITY BY 50% AND ABSORPTION AREA BY 22%.

GARBAGE GRINDER? YES ☐ NO ☒

SEPTIC TANK CAPACITY 1500 GALLONS NUMBER OF BEDROOMS 5

TRENCHES - 158 sq. ft. per bedroom. Trench to be 2 feet wide. Inlet 3 feet below original grade. Bottom maximum depth 7 feet below original grade. Effective area begins at 3 feet below original grade. 4 feet of stone below distribution pipe.

LOCATION - Place the distribution box 110 feet from the rear (236.05') lot line and 70 feet from the right (665.21') lot line as seen when facing the lot from Woodstock Road. Run trenches on contour toward the left lot line.

NOTE: MAINTAIN 100 FEET FROM WELL WITH SEPTIC TANK.

NOTE - No trench to exceed 100 feet in length. If more than one trench used, a distribution box is required. Call for inspection of trench(s) before and after gravel is installed. Provide 6" - 8" diameter cleanout and cap to grade or above on septic tank. dclw

BLDG. PERMIT SIGNED

AND RETURNED 4/18/87

Serial # 10856 P.M. Can

PLANS APPROVED BY S. Abel

DATE 2/21/86

COVER NO WORK UNTIL INSPECTED AND APPROVED.

NEITHER THE HOWARD COUNTY COUNCIL NOR THE HEALTH DEPARTMENT IS RESPONSIBLE FOR THE SUCCESSFUL OPERATION OF ANY SYSTEM.

NOTE: IF TRENCH IS USED CALL FOR INSPECTION BEFORE AND AFTER PLACING GRAVEL IN TRENCH.

NOTE: NO DRY WELL SHALL EXCEED 15 FOOT IN DIAMETER. NO ABSORPTION TRENCH TO EXCEED 100 FEET IN LENGTH.

NOTE: ALL PIPE FROM HOUSE TO SEPTIC TANK MUST BE CAST IRON OR SCHEDULE 40 PVC OR ABS.

PERMIT VOID AFTER THREE YEARS.


NOTE: INSTALL STAND PIPE ON SEPTIC TANK AND DRY WELL. STAND PIPES MUST BE 6 INCHES IN DIAMETER CAST IRON, CONCRETE OR TERRA COTTA, OR PVC OR ABS ACCEPTED. IF TOP OF SEPTIC TANK IS DEEPER THAN 3 FEET MANHOLE TO GRADE REQUIRED.

*INSTALLER IS RESPONSIBLE FOR OBTAINING FINAL APROVAL ON THIS PERMIT

*CALL 992-2330 FOR INSPECTION OF SEPTIC SYSTEMS.

EH - 2-1082

34958

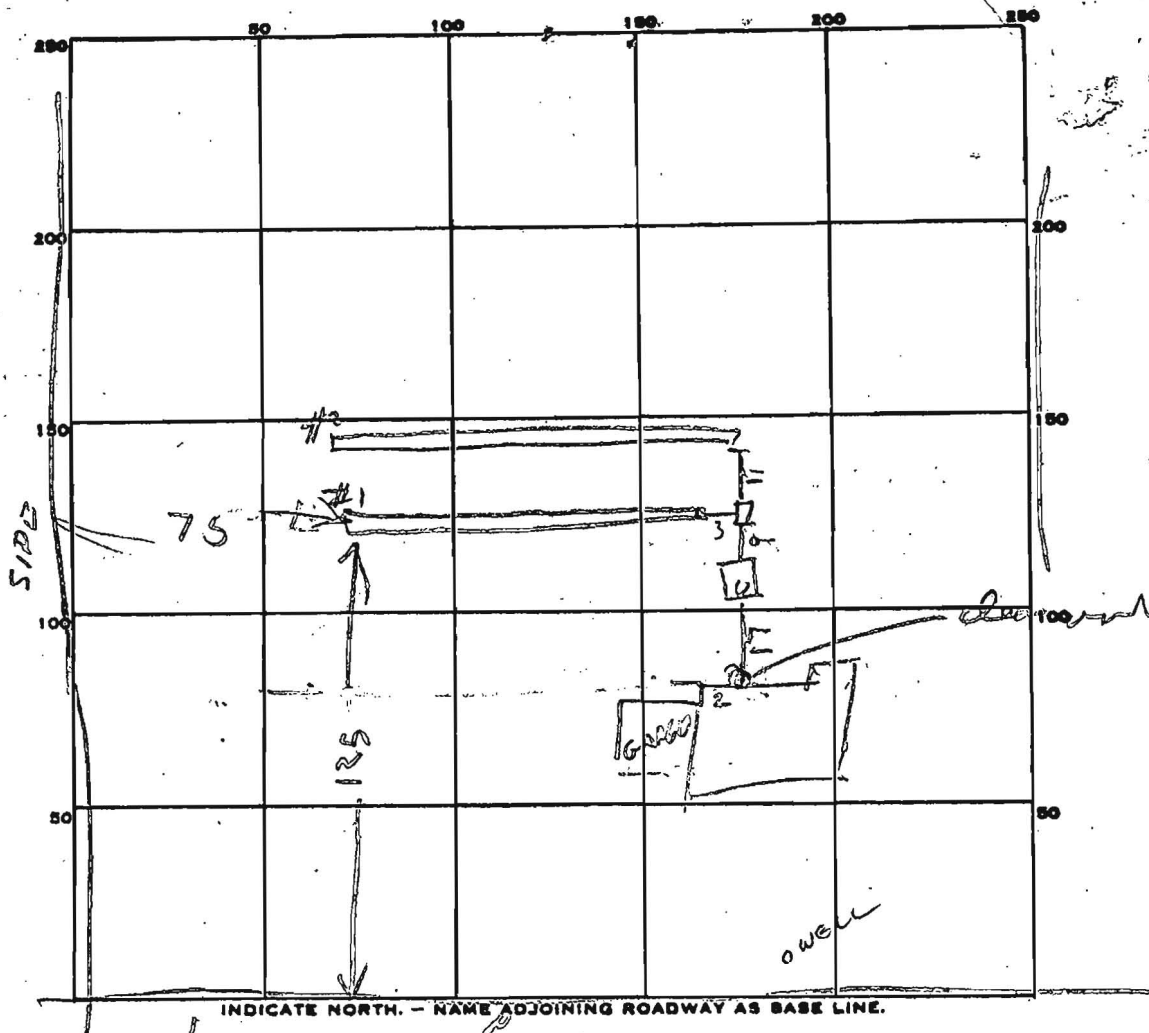

PERMIT CARD

SEPTIC TANK, LEVEL

1300 (6 WIDE 8 FT LONG)

CLEANOUTS

ST HOUSESEWER
012 012

DISTRIBUTION BOX, LEVEL

TILE FIELD, DEPTH

#1 7
#2 7

FT. TRENCH WIDTH

#1 2
#2 2

FT.

GRAVEL DEPTH

#1 4
#2 4

IN.

TOTAL LENGTH

#1 100
#2 103
TOTAL 203

NUMBER OF TRENCHES

2

TOTAL BOTTOM AREA

28 12

790 REQUIRED

SEEPAGE PITS, INSIDE DIAMETER

FT.

DEPTH BELOW INLET

FT.

ABSORBENT AREA

SQ. FT.

REMARKS

12/3/86 - OK TO CHANGE TANK LOCATION FROM PLANS & TRENCH LOCATION IS

1 TO REMAIN UNCHANGED AS

12/4/86 - TRENCH #1 DUG FILL TRENCH #1 WITH STONE

DIG TRENCH #2


12/4/86 100 PM - TRENCH #1 OK. TRENCH #2 DUG. ADD STONE TO #2

12/4/86 300 PM TRENCH #2 FINISHED

DATE SYSTEM APPROVED

12/4/86

Raymond Hodge

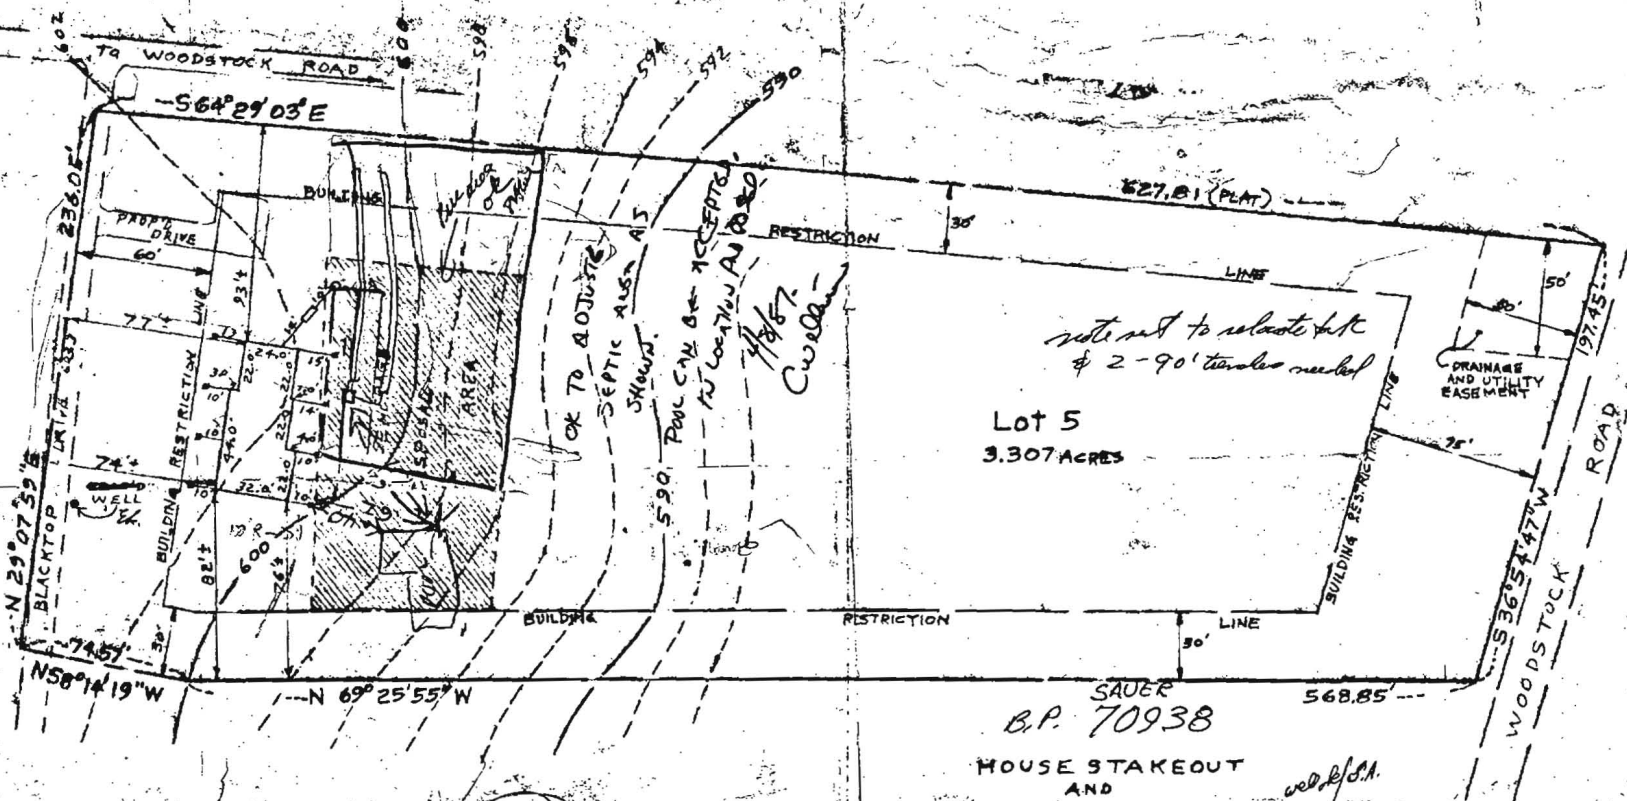

DEPT. HOUSE FOUNDATION BOX	601.70
INV. IN DISTR. BOX	597.60
INV. CUT OF SEPTIC TANK	597.80
INV. INTO SEPTIC TANK	598.20
INV. OUT OF DWELLING	594.48
FIRST FLOOR ELEV.	605.00
CELLAR ELEV.	596.00
WELL ELEV.	604.00
NO. OF BEDROOMS	3
ACREAGE	3.307 ACRES

4BR = 1SR TRUNK
 3-7 158 1/2 BR
 3S INLET WILL SEEK IF NECESSARY AND BOTTOM AT 7.5'
 I CERTIFY THE ABOVE MEASUREMENTS AND ELEVATIONS ARE ACTUAL AND CORRECT FOR THIS PROPERTY
 signed *William E. Doyle*

SAUER
 B.P. 70938
 HOUSE STAKEOUT
 AND
 PLOT PLAN
 WOODSTOCK ROAD
 LOT 5
 REUER'S BREEZEWOOD FARMS
 ELECTION DISTRICT 3
 HOWARD COUNTY, MARYLAND



DRAWN: APRIL 7, 1986
 SCALE: 1"=50'
 REVISED: MAY 29, 1986

WILLIAM E. DOYLE
 Registered Land Surveyor 8446
 8312 Emerald Dr. Ph. 795-2218
 SYKESVILLE, MD 21784