

APPLICATION

SEWAGE DISPOSAL TESTING

STATE OF MARYLAND - DEPARTMENT OF HEALTH AND MENTAL HYGIENE

HOWARD COUNTY HEALTH DEPARTMENT
ENVIRONMENTAL HEALTH SERVICES
P. O. BOX 476 ELLICOTT CITY, MARYLAND 21043
TELEPHONE: 992-2330

A 34958

P _____

DISTRICT 3rd

DATE 2/11/85

TO: THE COUNTY HEALTH OFFICER
ELLICOTT CITY, MARYLAND

I, HEREBY, APPLY FOR THE NECESSARY TEST IN ORDER TO CONSTRUCT (OR RECONSTRUCT) A SEWAGE DISPOSAL SYSTEM.

PROPERTY OWNER Donald R. Reuwer
12533 Folly Quarter Road
ADDRESS Ellicott City, Maryland 21043 PHONE 531-6455

PROPERTY LOCATION:

SUBDIVISION Reuwer Property LOT NO. 5

ROAD AND DESCRIPTION Woodstock Road

SIZE OF LOT 3.0 Acres TYPE BLDG. 3 or 4 Bedrooms
(NUMBER OF BEDROOMS)

THE SYSTEM INSTALLED UNDER THIS APPLICATION IS ACCEPTABLE ONLY UNTIL PUBLIC FACILITIES BECOME AVAILABLE. I FULLY UNDERSTAND THE
FEE CONNECTED WITH THE FILING OF THIS PERC TEST APPLICATION IS NON-REFUNDABLE UNDER ANY CIRCUMSTANCES. I ALSO AGREE TO COMPLY
WITH ALL M.O.S.H.A. REQUIREMENTS IN TESTING THIS LOT. /s/ Don Reuwer

(SIGNATURE OF APPLICANT)

APPROVED BY _____ FOR _____ DATE _____

REJECTED BY _____ FOR _____ DATE _____

HOLD PENDING FURTHER TESTS _____ DATE _____

REASONS FOR REJECTION OR HOLDING _____

THIS IS NOT A PERMIT

467

CONCRETE
MONUMENT

5

SOIL PROFILE

CLAY
Gypsum

3

1 1/2	WATER
-------	------------------

66-74708

PLAN
OF CARE

⑤

CLAY
SAND

12

INDICATE NORTH - NAME ADJOINING ROADWAY AS BASE LINE

WOOD STOCK RD

DATE	TEST NO.	DEPTH	PRE-WET		TEST - 1" DROP		TIME
			START	STOP	START	STOP	
2/27/85	15 1V	4 12	109 WATER	112 112	112 115	3	
	25 2V	3 1/2 11 1/2	117 WATER	119 119	119	1	
	35 3V	3 11 1/2	121 LOOKS OK	123 OK	123	3	
	45 4V	3 12	133 LOOKS OK	134 OK	134	2	
2/27/85	55 5V	5 12	141 LOOKS OK	147 OK	147	7	
2/27/85	65 6V	4 11 1/2	155 LOOKS OK	156 OK	156	2	

✓ PERC TIME
3 min
INLET 3
BOTTOM 7
1580/BR

REMARKS


TYPE OF SOIL

TESTED BY _____

R. HODGES

ALSO PRESENT

EH-12-1079

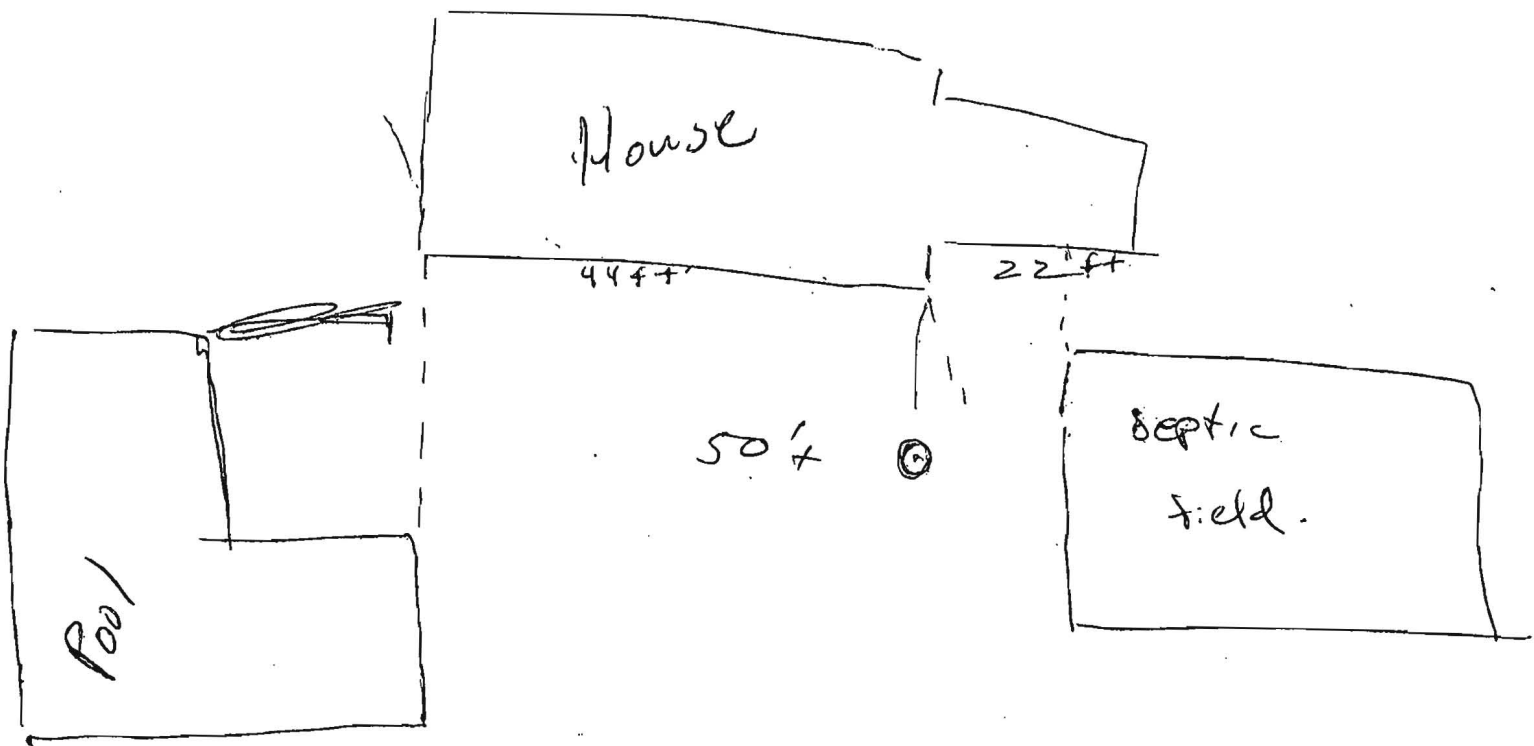

RECEIVED
HOWARD COUNTY
HEALTH DEPT.
APR 29 9 02 AM '87
DIVISION OF
ENVIRONMENTAL
HEALTH