

2791

brown
yellow
brown
silt
heavy

orange
b-silt
heavy
rice clam

yellow
brown
silt

silt/silt
mic

2788
2791

GARAGE



Howard County
Health Department

brown
o-b-silt
silt
ab

o-b-r
silt
heavy
to med

yellow
brown
silt

15

2788

brown
red brown
silt
ab
micaceous

r-b-o
silt

white
brown
15

o-brown
silt
5% clay
frag

2789

brown/till

r-o-b
micaceous
silt

o-b-r
silt

o-b
silt

white ST
w/ 15% quartz
frag

2793 A

brown
5/4 10R
weak red
silt
(ab)
silt
micaceous

o-b-r
silt (heavy)
to light

4/4 104R
dark yellowish
brown
micaceous silt
(fine)

2792

brown
fill

weak
red
silt
& silt

4/4 104R
dark
yellowish
brown
fine
silt

micaceous
flatter
greasy
silt

DATE	TEST #	DEPTH	START	BREAK 1" DROP	STOP 2" DROP	TIME OF 2nd INCH	P/F/H
5/31/05	2793	6/13	9:44	9:50	9:59	9	P
✓	2792	6/13	9:37	9:39 ³⁰	9:42 ⁰⁰	2.5	P
✓	2791	8/13	9:30	Slow			F
✓	2789	6/13	9:59	10:20	10:46	26	P
✓	2788	7/13	10:14	10:23	10:31	8	P
✓	2790	6/13	12:08	12:10	12:12	2	P
✓	2792A	13	12:19	12:22	12:15	3	P

REMARKS - Perc #'s not on new plan! / Soils incos. start

SANITARIAN PKY BACKHOE K+K OTHERS _____

TEST HOLES USED IN SDA _____ AVG. PERC TIME _____ SQ. FT/BR _____

TRENCH WIDTH _____ INLET DEPTH _____ MAX. BOT DEPTH _____ EFFECTIVE SW _____

A/P

(F)

Br Heavy
LoamRed Br
Loam

Trace Rock

Red Br

Sa Loam

~25%

Saprolite

13'


(G)

Red Br
Loam and
Heavy LoamRed Br
Sa Loam

~10% Rock

Beige
Sa Loam~25%
Saprolite

13'

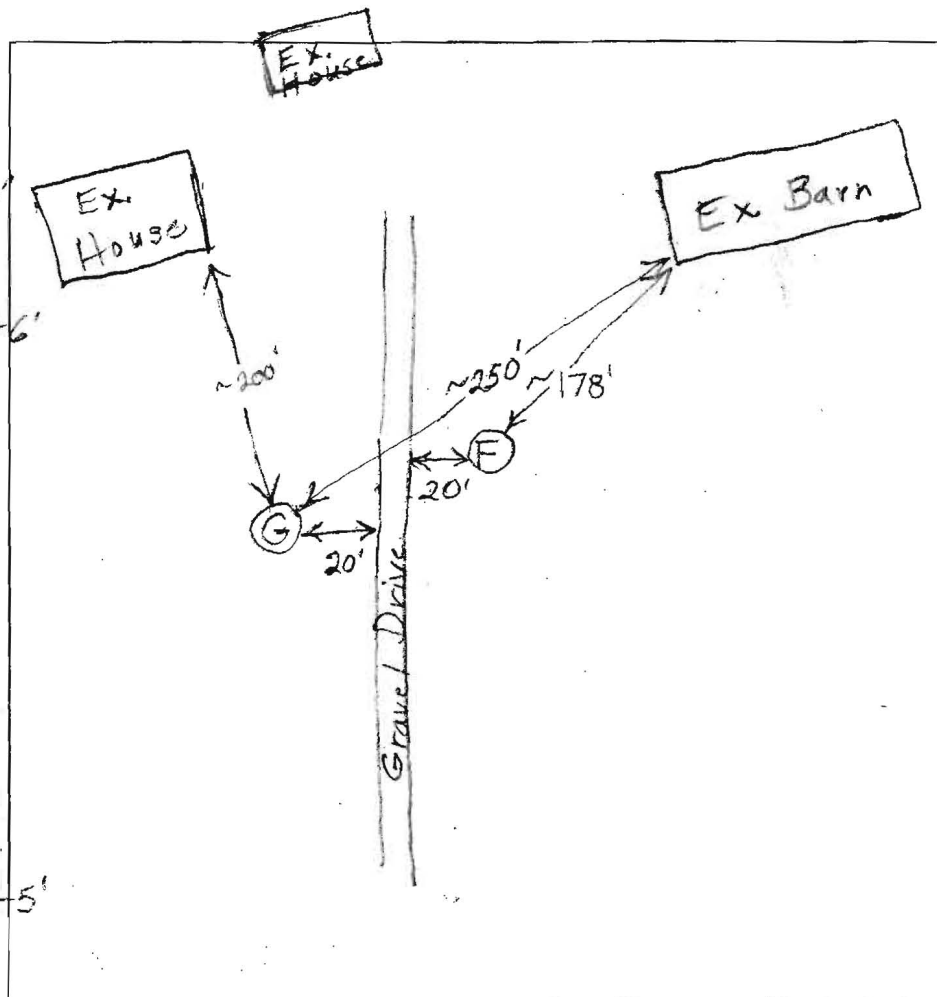

DATE	TEST #	DEPTH	START	BREAK 1" DROP	STOP 2" DROP	TIME OF 2nd INCH	P/F/H
9/18/03	F	6'2"/13'V	8:50	8:53	8:53	8:58	5
	G	13'V					0.K.

REMARKS Field Locate Holes F+GSANITARIAN B. Baker BACKHOE K+K OTHERS _____

TEST HOLES USED IN SDA _____ AVG. PERC TIME _____ SQ. FT/BR _____

TRENCH WIDTH _____ INLET DEPTH _____ MAX. BOT DEPTH _____ EFFECTIVE SW _____

AP 4351


Red Br Heavy Loam 3.5'-5'
 Red Br Si Loam and Or Br Sa Loam ~10% Rock 5.5'
 Or Br Sa Loam ~10% Rock 13.5'

4352

Red Br Heavy Loam 4'
 Red Br Loam Very Little Rock 5.5'
 Tan Sa Loam 10-15% Saprolite 13.5'

4353

Red Br Heavy Loam 4'-5'
 Red Br Loam Very Little Rock 5.5'-6'
 Beige Sa Loam ~15% Saprolite

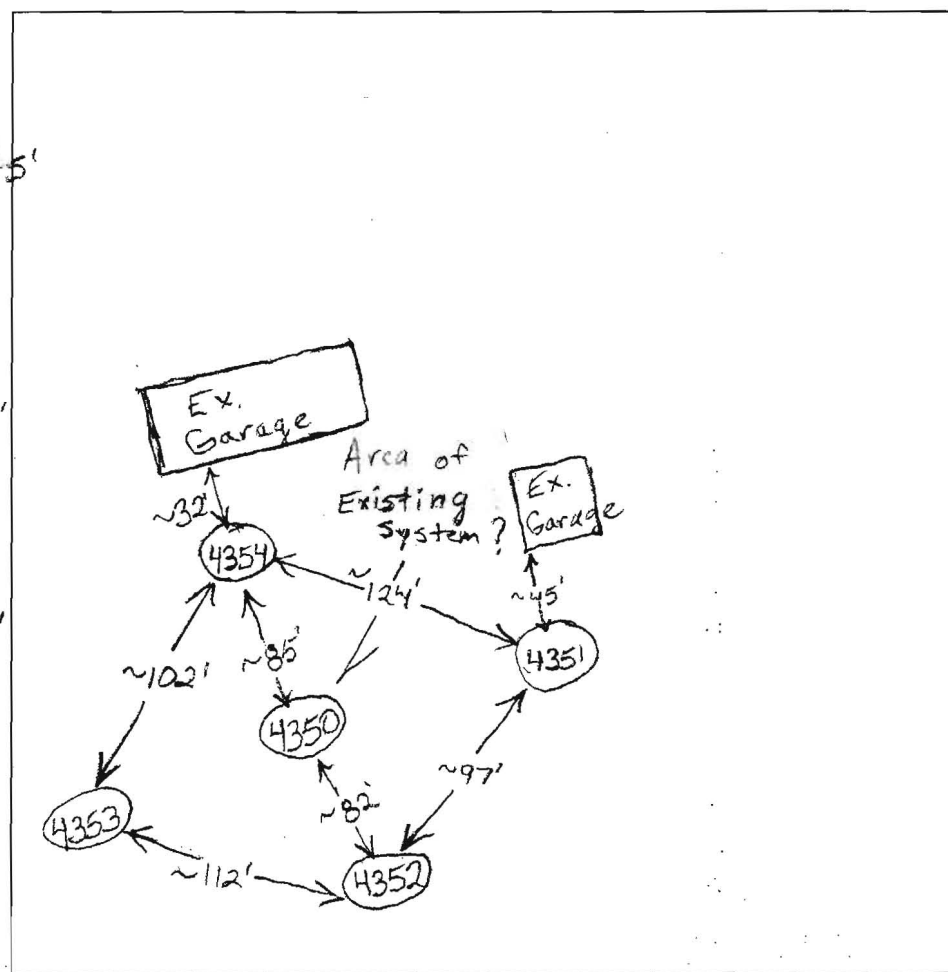

4354
 Red Br Heavy Loam 4'-5'
 Red Br Loam Very Little Rock 5.5'-5.5'
 Light Br Sa Loam 10-15% Saprolite 13.5'

4350

Red Br Heavy Loam 4'-4.5'
 Red Br Loam Scarce Rock 5.5'-6'
 Or Br Sa Loam 15-20% Saprolite 13.5'

DATE	TEST #	DEPTH	START	BREAK 1" DROP	STOP 2" DROP	TIME OF 2nd INCH	P/F/H
9/17/03	4351	7' / 13.5' V	9:53	9:54:45	9:54:45	9:58	~3
	4352	6'3" / 13.5' V	10:03:30	10:05	10:05	10:07	2
	4350	13.5' V	— See Profile —				→ O.K.
	4353	6.5' / 13.5' V	10:18:15	10:20:15	10:20:15	10:23:45	3 1/2
	4354	6.5' / 13.5' V	10:33	10:34:20	10:34:20	10:35:45	~1 1/2

REMARKS _____
 SANITARIAN B. Baker BACKHOE K + K OTHERS _____
 TEST HOLES USED IN SDA _____ AVG. PERC TIME _____ SQ. FT/BR _____
 13.5' TRENCH WIDTH _____ INLET DEPTH _____ MAX. BOT DEPTH _____ EFFECTIVE SW _____

