

Building Permit Application
Howard County Maryland
Department of Inspections, Licenses and Permits
3430 Court House Drive
Permits: 410-313-2455 www.howardcountymd.gov

Date Received	•
---------------	---

Permit No.: \_\_\_

	2		
Building Address: 12225 Ru	ming fonce lu-	Property Owner's Name: Pha M	
City: Clarksulle State:		Address: 1223 S. Running For City CLARKE VILLE State: Mol.	nce Liv.
Suite/Apt. # SDP/	i	Phone: 4110-549-5050 Fax	ra
	Subdivision: WALNING GOUE	Email: Classic Designation (	@) NOTUM, L. CON
Section: Area		Applicant's Name & Mailing Address, (If ot)	
	•	Applicant's Name: Perior Sorge (	CLASSIC DESIGN GOND
Tax Map: Parcel:	<b>\$</b>	Applicant's Name: Pero Sorge (Address: 5433 Dood No. 2)	1 7.700
Zoning: Map Coordinat	es: Lot Size:	City: Wood 5:50. State: Med Phone: 410-549-5050 Fax: 4	. Zip Code: <u>014-14</u>
Existing Use: 5. wile four		Email: BSOIGE B) EARthlink	1,006
Proposed Use: 5 miles		Contractor Company: Classic D	ESIAN Grown Thica
Estimated Construction Cost: \$ 8 (	- 000	Contact Person: Poten Sorge #	
		Address: 5433 Wood bing Kil	
Description of Work: 31 X ( 3	scrooked poneb other	City: Workling State: Mol.	Zip Code: <u>217-97</u>
Stone patro Sto	SOS TO CROS	License No. : 83116  Phone: 410-549-5050 Fax: 4	10 -500 5009
62+4 stone p	74.0 98.0 × 947	Email: CLCSS, C DESIGN Grove	(C) HCT 114 - C - W
Occupant or Tenant:			
Was tenant space previously occupied?	□Yes □No	Engineer/Architect Company:	70, 1110
Contact Name:		Responsible Design Prof.:	-
Address:		Address:	
City:		City:State:	Zip Code:
Phone:		Phone: Fax:	
Email:		Email:	
Commercial Building Characteristics	Residential Building Characteristics	Utilities	
Height: No. of stories:	☐ SF Dwelling ☐ SF Townhouse  Depth Width	Water Supply	
Gross area, sq. ft./floor:	1 <sup>st</sup> floor:	☐ Public	
	2 <sup>nd</sup> floor:	Private	
Area of construction (sq. ft.):	Basement:	Sewage Disposal  Public	
Use group:	☐ Finished Basement ☐ Unfinished Basement	Private, SANJOOL SOPTIC	
	☐ Crawl Space	Electric: Yes No	
Construction type:	☐ Slab on Grade	Gas: Yes No	
Reinforced Concrete	No. of Bedrooms:	Heating System	
☐ Structural Steel ☐ Masonry	Multi-family Dwelling  No. of efficiency units:	☐ Electric ☐ Oil	
☐ Wood Frame	No. of 1 BR units:	□ Natural Gas □ Propane Gas	
☐ State Certified Modular	No. of 2 BR units:	Other:	
	No. of 3 BR units:	Sprinkler System:	
	Other Structure:	☐ Yes ☐ No	×
	Dimensions:		
Roadside Tree Project Permit	Footings:	Grading Permit Number:	
☐Yes ☐No  Roadside Tree Project Permit #	Roof:  State Certified Modular	Stading Lettine realibet.	
Addustree Froject Permit #	☐ Manufactured Home	Building Shell Permit Number:	
	110110		
WITH ALL REGULATIONS OF HOWARD COUNTY N	WHICH ARE APPLICABLE THERETO: (4) THAT HE/SHE \	ILL.  MAKE THIS APPLICATION; (2) THAT THE INFORMATION IS COMMITTED THE PROPERTY OF THE PURPOSE OF INSPECTING THE WORK PERMIT  PERTY FOR THE PURPOSE OF INSPECTING THE WORK PERMIT	PERTY NOT SPECIFICALLY DESCRIBED IN
Applicant's Signature	D	Print Name:	
· · · · · · · · · · · · · · · · · · ·			
3	@ Endline	2/13/15	
Email Address PSOSe 3	@ Enathlink . NOT	3/19/15	
Email Address PSOSE 3	@ Enathlink . NOT	<u> </u>	
Email Address Title/Company	© Enathlink NOT	<u> </u>	
Email Address PSOSe 3	Checks Payable to: DIRECTOR OF	FINANCE OF HOWARD COUNTY	
Email Address PSOSe 3	Checks Payable to: DIRECTOR OF  **PLEASE WRITE NE	FINANCE OF HOWARD COUNTY	

AGENCY	DATE	SIGNATURE OF APPROVAL
State Highways		
Building Officials		
PSZA (Zoning)		
PSZA ( Engineering )		
Health	2/12/	15 H. Carwald


Is Sediment Control approval required for issuance? ☐ Yes

-	ocum, com		o, opp,				
	CONTING	ENCY	CONST	RUCT	ION	STA	RT

	111000
	Lot C
□ No	SDP/

Front:		
Rear:		
Side:		
Side St.:		
All minimum setbacks met?	□Yes	□No
Is Entrance Permit Required?	☐ Yes	□No
Historic District?	☐ Yes	□No
Lot Coverage for New Town Z	one:	
SDP/Red-line approval date:		

Filing Fee	\$
Permit Fee	\$
Tech Fee	\$
Excise Tax	\$
PSFS	\$
Guaranty Fund	\$
Add'I per Fee	\$
Total Fees	\$
Sub-Total Paid	\$
Balance Due	\$
Check	#

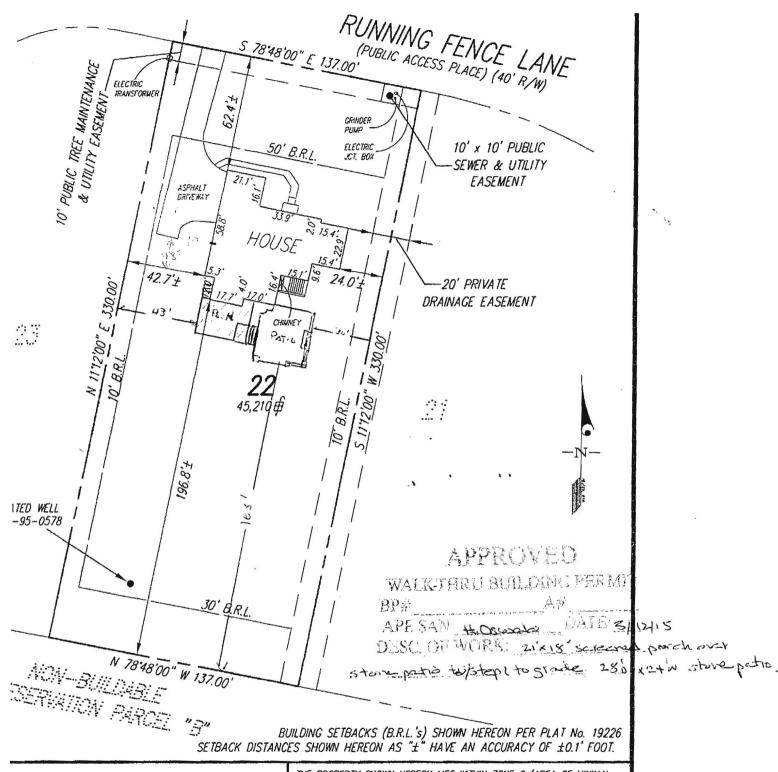

## GUTSCHICK LITTLE &WEBER, P.A.

LAND SURVEYORS, LAND PLANNERS, LANDSCAPE ARCHITECTS ) NATIONAL DRIVE - SUITE 250 - BURTONSMILE OFFICE PARK BURTONSVILE, MARYLAND 20866 24 BALT: 410-880-1820 DC/VA: 301-989-2524 FAX: 301-421-4166

THE PROPERTY SHOWN HEREON LIES WITHIN ZONE C (AREA OF MINIMAL FLOODING) AS SHOWN ON THE F.E.M.A. FLOOD INSURANCE RATE MAP, COMMUNITY PANEL No. 240044 0026 B, REVISED DECEMBER 4, 1986.

REFERENCE : PLAT No. 19226 02-28-2012 DATE OF LATEST FIELD WORK: DRAWN BY : JVC G.L.W. FILE No. 1"=50 132, 09057 CHECKED BY :

## SURVEYOR'S CERTIFICATE

THIS IS TO CERTIFY TO: "NVR, INC.",

THAT TO THE BEST OF MY KNOWLEDGE, INFORMATION AND BELIEF, THIS LOCATION DRAWING WAS PREPARED IN ACCORDANCE WITH THE MINIMUM STANDARDS OF PRACTICE LOCATION DRAWING

"WALNUT GROVE" LOT 22

12225 RUNNING FENCE LANE