



APPLICATION

FOR PERCOLATION TESTING AND SITE EVALUATION

TEST DATE(S) _____ TEST TIME _____ A/P 530266

AGENCY REVIEW: _____ DATE 12/30/08

DO NOT WRITE ABOVE THIS LINE

I HEREBY APPLY FOR THE NECESSARY TESTING/EVALUATION PRIOR TO ISSUANCE OF SEWAGE DISPOSAL SYSTEM PERMIT(S) TO:

CHECK AS NEEDED:

- ☒ CONSTRUCT NEW SEPTIC SYSTEM(S)
- ☐ REPAIR/ADD TO AN EXISTING SEPTIC SYSTEM
- ☐ REPLACE AN EXISTING SEPTIC SYSTEM

CHECK AS NEEDED:

- ☒ NEW STRUCTURE(S)
- ☐ ADDITION TO AN EXISTING STRUCTURE
- ☐ REPLACE AN EXISTING STRUCTURE

CHECK ONE:

- ☒ CREATE NEW LOT(S)
- ☐ BUILD ON AN EXISTING LOT IN A SUBDIVISION
- ☐ BUILD ON AN EXISTING PARCEL OF RECORD

IS THE PROPERTY WITHIN 2500' OF ANY RESERVOIR?

- ☐ YES
- ☒ NO

THE TYPE OF STRUCTURE IS:

- ☒ RESIDENTIAL WITH UNKNOWN PROPOSED BEDROOMS IN THE COMPLETED STRUCTURE (NOTE UNKNOWN IF APPROPRIATE)
- ☐ COMMERCIAL (PROVIDE DETAIL OF NUMBERS AND TYPES OF EMPLOYEES/CUSTOMERS ON ACCOMPANYING PLAN)
- ☐ INSTITUTIONAL/GOVERNMENT (PROVIDE DETAIL OF NUMBERS AND TYPES OF EMPLOYEES/USERS ON ACCOMPANYING PLAN)

PROPERTY OWNER(S) ST. PAUL'S LUTHERAN CHURCH OF FULTON, MARYLAND

DAYTIME PHONE 301-405-1401 CELL _____ FAX _____

MAILING ADDRESS 11795 ROUTE 216, FULTON, MARYLAND 20759
STREET CITY/TOWN STATE ZIP

APPLICANT GUTSCHICK, LITTLE & WEBER, P.A. ATTN: PAUL CLARK

DAYTIME PHONE 410-880-1820 CELL _____ FAX 301-421-4186

MAILING ADDRESS 3909 NATIONAL DRIVE, SUITE 250, BURTONSVILLE, MD 20866
STREET CITY/TOWN STATE ZIP

APPLICANT'S ROLE: DEVELOPER BUILDER BUYER RELATIVE/FRIEND REALTOR CONSULTANT

PROPERTY LOCATION
SUBDIVISION/PROPERTY NAME ST. PAUL'S CHURCH PROPERTY LOT NO. 1

PROPERTY ADDRESS 11815 LIME KILN ROAD, FULTON, MD 20759
STREET TOWN/POST OFFICE


AX MAP PAGE(S) 46 GRID 2 PARCEL(S) 105 PROPOSED LOT SIZE 3.46+

I, AS APPLICANT, I UNDERSTAND THE FOLLOWING: THE SYSTEM INSTALLED SUBSEQUENT TO THIS APPLICATION IS ACCEPTABLE ONLY UNTIL PUBLIC SEWERAGE IS AVAILABLE. THIS APPLICATION IS COMPLETE WHEN ALL APPLICABLE FEES AND A HITTABLE SITE PLAN HAVE BEEN RECEIVED. I ACCEPT THE RESPONSIBILITY FOR COMPLIANCE WITH ALL M.O.S.H.A. AND "ISS UTILITY" REQUIREMENTS. APPROVAL IS BASED UPON SATISFACTORY REVIEW OF A PERC CERTIFICATION PLAN. TEST RESULTS WILL BE MAILED TO APPLICANT.

SIGNATURE OF APPLICANT

HOWARD COUNTY HEALTH DEPARTMENT, BUREAU OF ENVIRONMENTAL HEALTH, WELL AND SEPTIC PROGRAM
7178 COLUMBIA GATEWAY DRIVE COLUMBIA, MARYLAND 21046 (410) 313-1771 FAX (410) 313-2648
TDD (410) 313-2323 TOLL FREE 1-877-4MD-DHMH

A/P _____

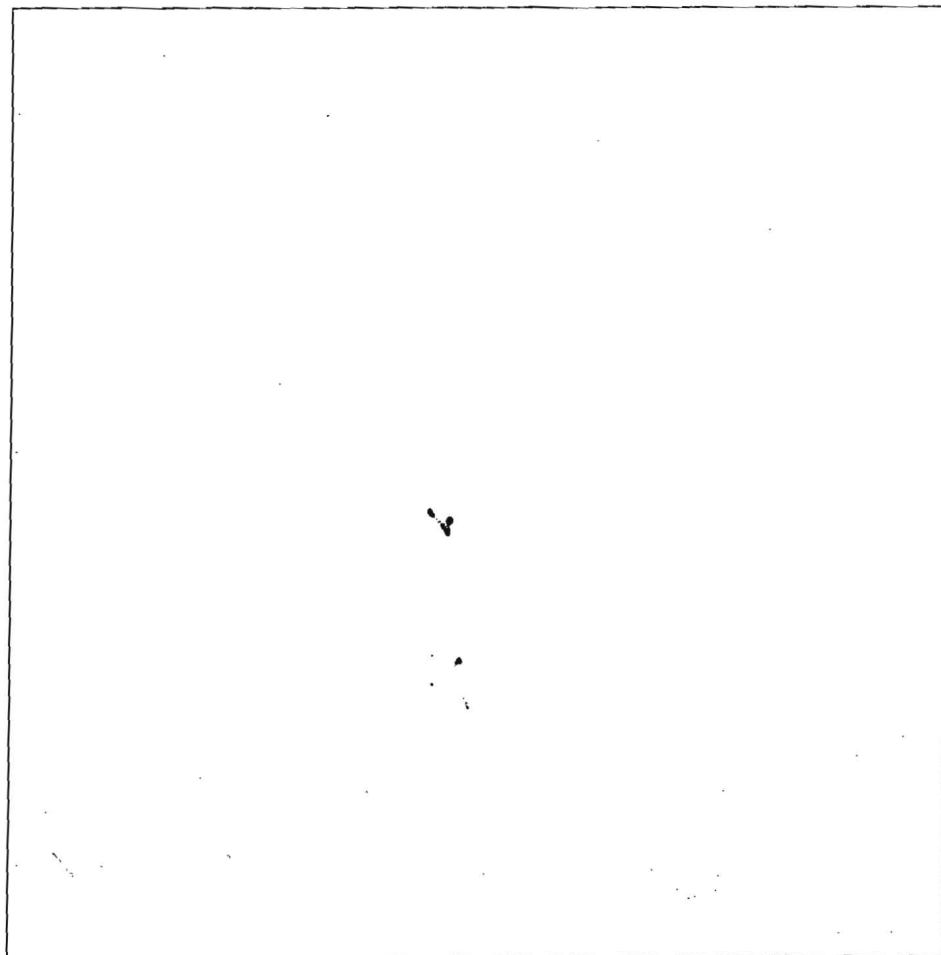

DATE	TEST #	DEPTH	START	BREAK 1" DROP	STOP 2" DROP	TIME OF 2ND INCH	P/F/H

REMARKS _____

SANITARIAN _____ BACKHOE _____ OTHERS _____


TEST HOLES USED IN SDA _____ AVG. PERC TIME _____ SQ. FT/BR _____

TRENCH WIDTH _____ INLET DEPTH _____ MAX. BOT DEPTH _____ EFFECTIVE SW _____

1 A

Dark Gray, Brn
Black 2 SBK
SL
-----0.8'
Red-Brown
SCL
-----3'
Red Brown
SL
Much Mica

Few Small
Stones
↓
-----13.5'

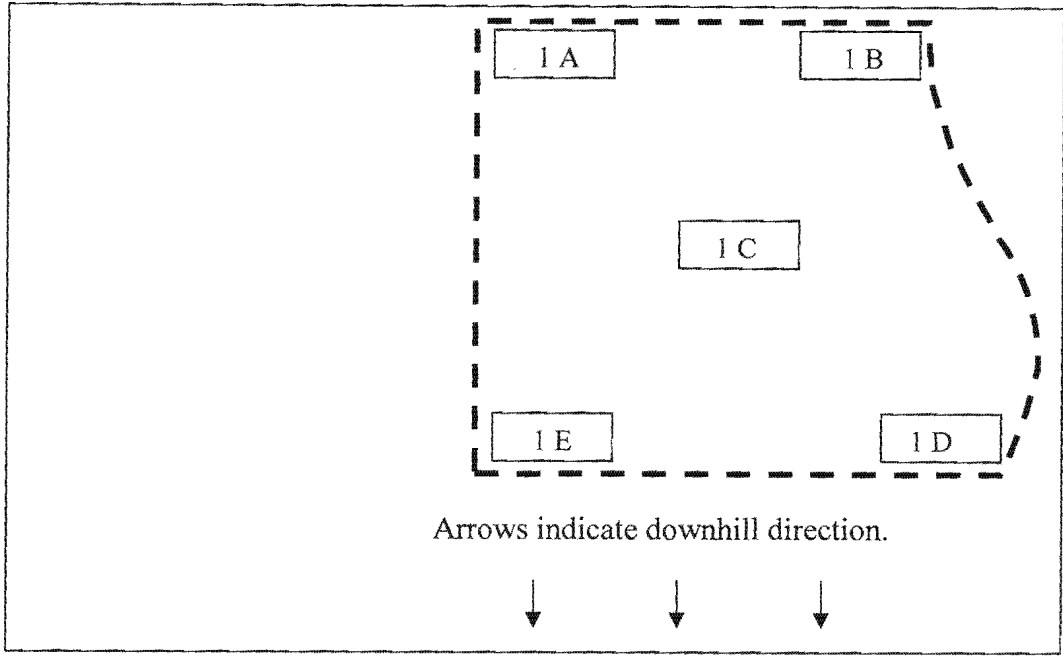

1 B

Grey Brown SL
2 SBK
-----0.8'
Red Brown SCL
-----4'
Red-Brown
SL
Much Mica
↓
Wet
-----13'

1 C

Same
Profile

As

1 D

Date	Test #	Depth	Start	Break 1" Drop	Break 2" Drop	Time of 2 nd Inch	P/F/H
05-13-09	1 A	4.5' / 13.5'	1:27 min.	1:33 min.	1:40 min.	7 min.	Pass
05-13-09	1 B	4.5' / 13'	1:10 min.	1:15 min.	1:24 min.	9 min.	Pass
05-13-09	1 C	13'	Visual Observation 3-8 feet Good Soil				Pass
05-13-09	1 D	4.5' / 13'	12:56 min.	1:01 min.	1:05 min.	4 min.	Pass
05-13-09	1 E	4.5' / 13'	1:44 min.	2:01 min.	2:14 min.	13 min.	Pass
							#

1 D

Dk Brown
SL, SBK
-----0.8'
Red Brown
SCL
-----2'
Red Brown
SL
↓
10'
Rd Brown
Small
Stones
Traces of
MnO
-----13'

1 E

Dark Brown
SL, SBK
-----0.8'
Red- Brown
SCL
-----3'
↓


Red - Brown
SL
Wet Mica
-----13'

Remark _____

Sanitarians _DB_____ Backhoe _Jason_____ Others_____

Test Holes Used in _SDA_ Avg. Perc Time _7_ SQ.FT/BR _5 Bedrooms

Trench Width _2_ Inlet Depth _4.5_ Max Bot.Depth _6_ Effective S/W _

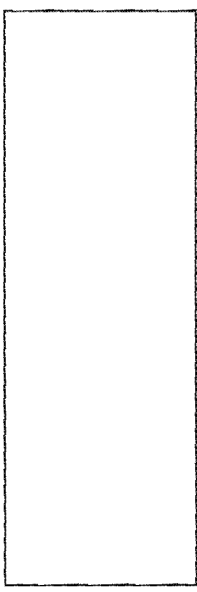


Signed perc
cert 7-11-12

1/P
N/F PR
CORDON FI
L 255

P110
L.J. & M.L. WELDRICK
L 5778 F 394

MURPHY

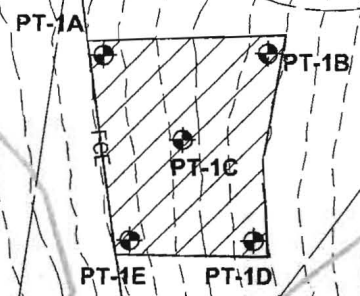

APPROXIMATE
SEPTIC
LOCATION

BEAN PROPERTY
PB 10 PN 81

BEAN
PB

APPROXIMATE
SEPTIC
LOCATION

STABEAN DRIVE

BEAN PROPERTY
PB 9 PN 89

BEAN PROPERTY
PB 12 PN 88

BEAN PROPERTY
PB 9 PN 89

BEAN PROPERTY
PB 9 PN 64

PARCEL A