

APPLICATION

PERCOLATION TESTING

A 516057

P _____

HOWARD COUNTY HEALTH DEPARTMENT

BUREAU OF ENVIRONMENTAL HEALTH

3525-H ELLICOTT MILLS DRIVE/ELLICOTT CITY, MARYLAND 21043
TELEPHONE: 313-2640

DISTRICT _____

DATE 10/5/01

TO: THE COUNTY HEALTH OFFICER
ELLICOTT CITY, MARYLAND

I HEREBY APPLY FOR THE NECESSARY TEST PRIOR TO APPLICATION FOR PERMIT TO CONSTRUCT (OR RECONSTRUCT) A SEWAGE DISPOSAL SYSTEM.

PROPERTY OWNER JOHN C PEWLEY, REVOCABLE TRUST
15355 UNION CHAPEL RD.
ADDRESS WOODBINE MD 21797 PHONE _____

AGENT OR PROSPECTIVE BUYER GRAYSON DEV. CO. LLC. c/o KOREN DEV. Co.
815 CENTER PARK DR. STE 104
ADDRESS COLUMBIA MD 21045 PHONE _____

PROPERTY LOCATION:

DIVISION BEWLEY PROPERTY LOT NO. 41

ROAD AND DESCRIPTION UNION CHAPEL RD

TAX MAP 14 PARCEL # 666

SIZE OF LOT ± 1 AC TYPE BLDG. SF. DWELLING
(SINGLE FAMILY DWELLING OR COMMERCIAL)

THE SYSTEM INSTALLED UNDER THIS APPLICATION IS ACCEPTABLE ONLY UNTIL PUBLIC FACILITIES BECOME AVAILABLE. I FULLY UNDERSTAND THE
FEE CONNECTED WITH THE FILING OF THIS PERC TEST APPLICATION IS NON-REFUNDABLE UNDER ANY CIRCUMSTANCES. I ALSO AGREE TO
COMPLY WITH ALL M.O.S.H.A. REQUIREMENTS IN TESTING THIS LOT.

DAVID B. YANNOY GRAYSON DEVELOPMENT
(SIGNATURE OF APPLICANT) COMPANY, LLC

APPROVED BY _____ FOR _____ DATE _____

DISAPPROVED BY _____ FOR _____ DATE _____

HOLD PENDING FURTHER TESTS _____

REASONS FOR REJECTION OR HOLDING Needs Wet Season Tests

PERCOLATION TEST PLAT/PRELIMINARY PLAT - TITLE OR I.D. # _____ DATE _____

SITE DEVELOPMENT PLAN/FINAL PLAT - TITLE OR I.D. # _____ DATE _____





THIS IS NOT A PERMIT

516057

NOT TO SCALE



COUNTY #

SOIL PROFILE

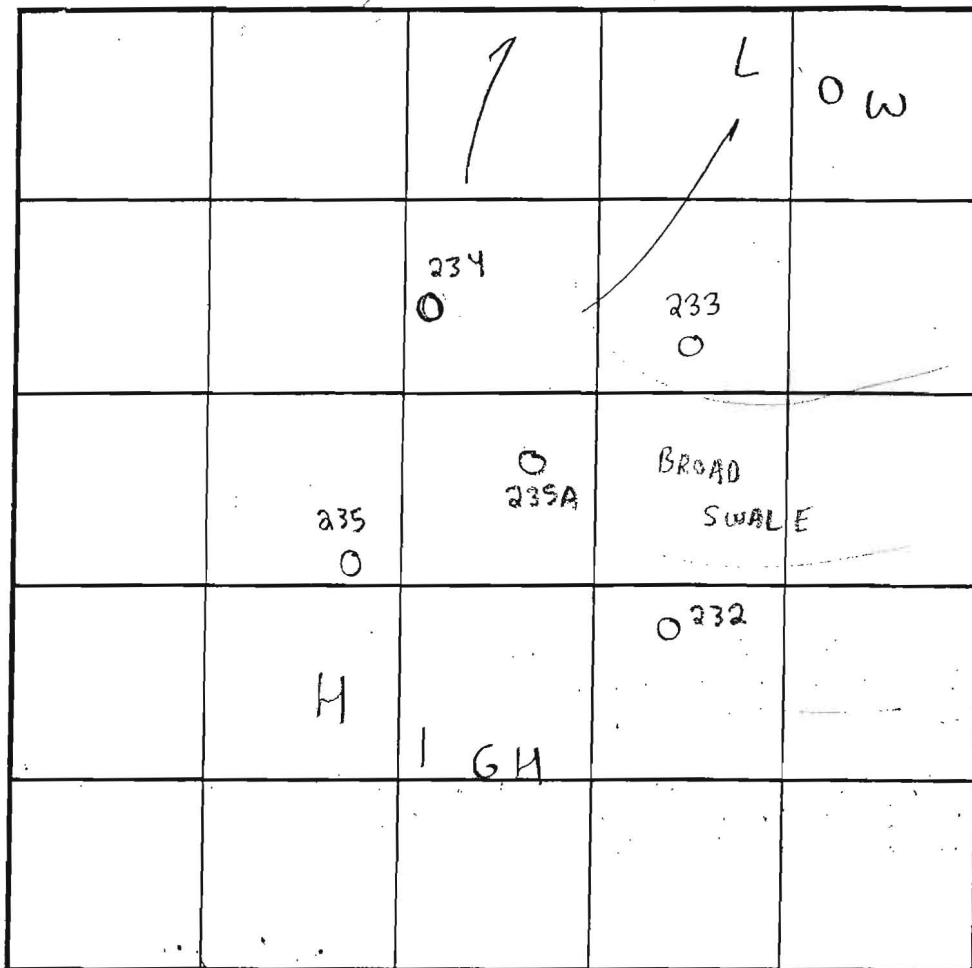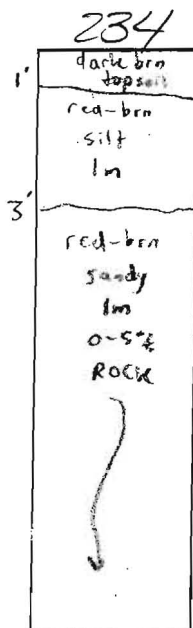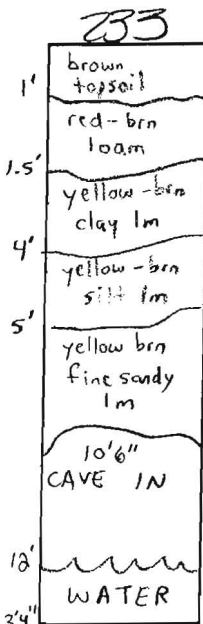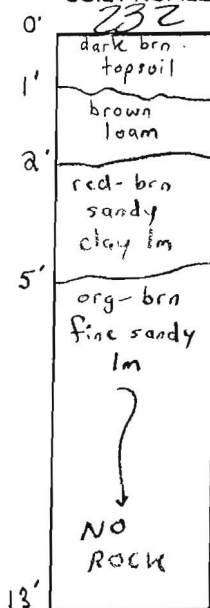

INDICATE NORTH - NAME ADJOINING ROADWAY AS BASE LINE.

SOIL PROFILE

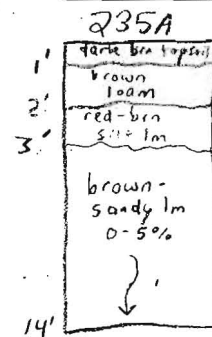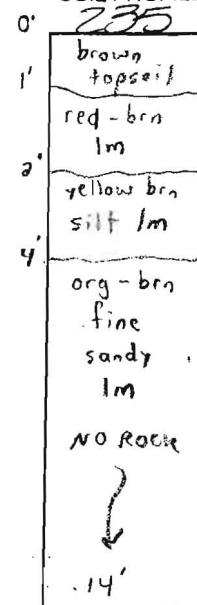

DATE	TEST NO.	DEPTH	PRE-WET		TEST - 1" DROP		TIME	
			START	STOP	START	STOP		
4/16/03	232	13'V	(VISUAL OK)		SEE SOIL PROFILE)		NA	OK
	233	5' T 10'6" V	4:45pm	4:50pm	4:50pm	5:00pm	Slow	Marginal
		(pull SDA	uphill & trim corner)		(peg pulled slow 1/2" movement)			
	234	4' T 12' V	11:40	11:42	11:42	11:46	4min	OK
	235	14'V	(VISUAL OK SEE SOIL PROFILE)				NA	OK
	235A	4'6" T 14' V	11:06	11:08	11:08	11:10	2min	OK

REMARKS Visual holes textured & picked w/ trowel (All tests in woods)

TYPE OF SOIL Chester - Visual holes consistent

TESTED BY FA & SRK ALSO PRESENT Todd Parks = Backhoe Steve Duncan = helper

TRENCH DESIGN DATA: AVERAGE PERCOLATION TIME 2-7min est. TRENCH WIDTH 3'

INLET DEPTH 4' MAXIMUM BOTTOM DEPTH 6' SQ. FT/BEDROOM 180

KEY PROPERTY SUBDIVISION
P.246
BULK PARCEL "C"
RRC-DE0

SIGNED *AC*
11/21/03

WELLINGTON
SECTION 2, AREA 1
PRESERVATION PARCEL "B"
RC-DE0

MB2
PREDER

