

APPLICATION

A 17507

SEWAGE DISPOSAL TESTING

P _____

MARYLAND STATE DEPARTMENT OF HEALTH

HOWARD COUNTY

ELLICOTT CITY

DISTRICT 5th

DATE Aug 1972

TO: THE COUNTY HEALTH OFFICER
ELLICOTT CITY, MARYLAND

I, HEREBY, APPLY FOR THE NECESSARY TESTS IN ORDER TO CONSTRUCT (OR RECONSTRUCT) A SEWAGE DISPOSAL SYSTEM.

PROPERTY OWNER Phase One, Ltd.

ADDRESS Urban Life Center, Columbia, Md

PHONE 730-8200

PROPERTY LOCATION:

SUBDIVISION Adjacent to Clarksville Ridge

LOT NO. 9

ROAD AND DESCRIPTION Intersection Rt 32 & Whitegate Lane

OCCUPANT _____

PHONE _____

PERSON TO CONSTRUCT SYSTEM _____

ADDRESS _____

PHONE _____

SIZE OF LOT 3 acres +

TYPE BLDG. 4 Bedroom Res.

NUMBER OF BEDROOMS

IF NOT SINGLE RESIDENCE DESCRIBE _____

SIGNATURE OF APPLICANT _____

Alan C. Borg
Alan C. Borg, Pres.

APPROVED BY _____

FOR _____

(KIND OF SYSTEM)

DATE _____

REJECTED BY _____

FOR _____

(KIND OF SYSTEM)

DATE _____


HOLD PENDING FURTHER TESTS _____

DATE _____

REASONS FOR REJECTION OR HOLDING _____

THIS IS NOT A PERMIT

Wet line

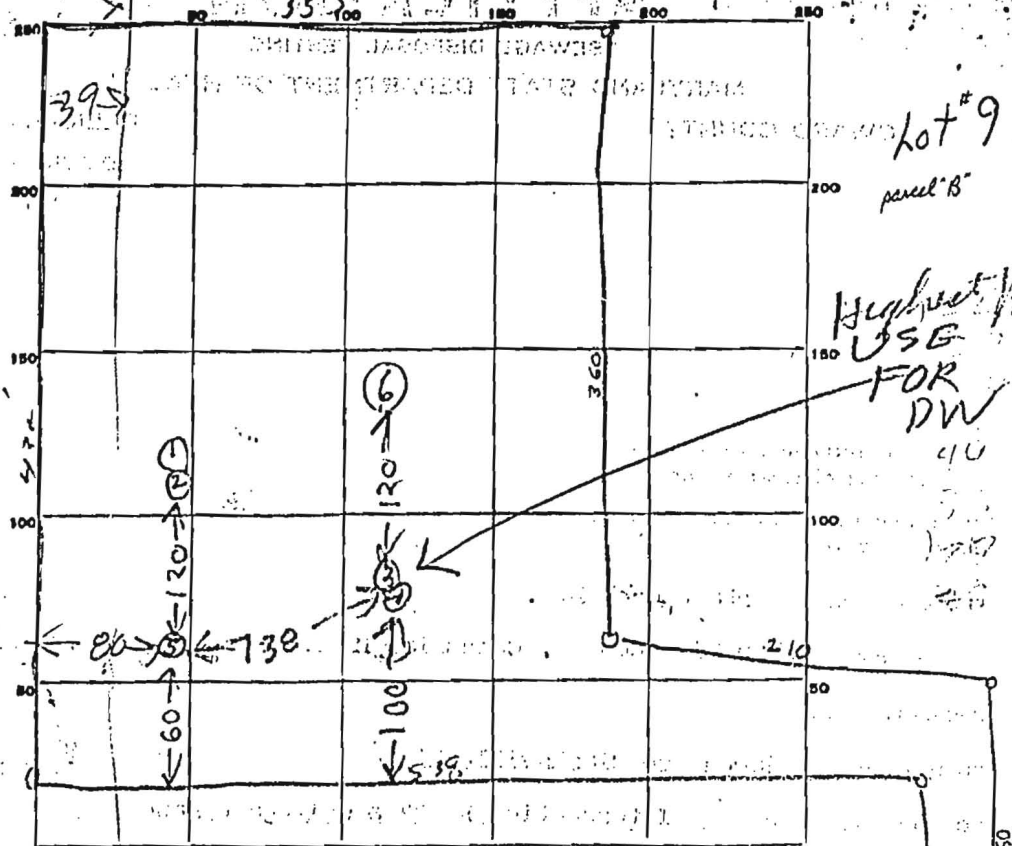

INDICATE NORTH. - NAME ADJOINING ROADWAY AS BASE LINE.

DATE	TEST NO.	DEPTH	PRE-WET		TEST - 1" DROP		TIME
			START	STOP	START	STOP	
10/17/72	1	5	1228	1229	1229	1231	2
	2	12 1/2	1229	1227	1227	1249	12
	3	4	1240	1242	1242	1243	1
10/17/72	4	12	100	103	103	110	7
	5	11	ALL SAND		1227		
10/17/72	6	11	TOP SF7 LAY		AND		
			BOT SF7				


Max depth
5F7
Antenna
6mm

SOIL AUGER FINDING

TESTED BY *K. Hodges*

REMARKS

Lot #9

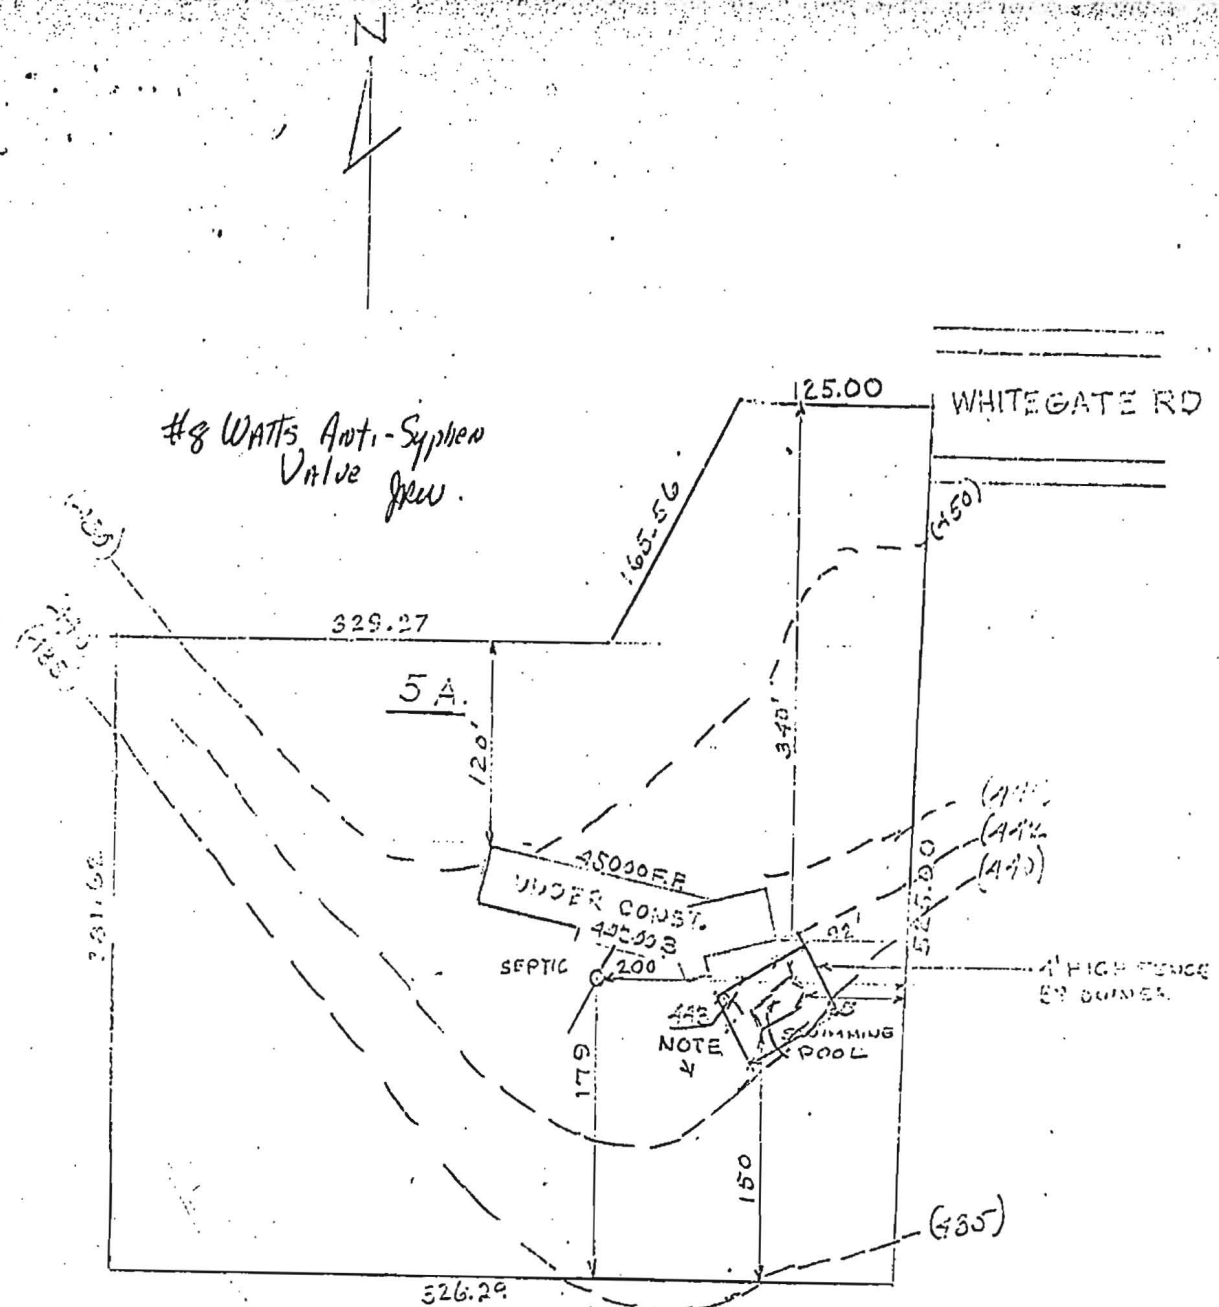

NOTE: ELEVATION OF POOL
(443.00).
DECK SLOPE 1/4"=1'-0"

PARCEL 3
CLARKSVILLE MEADOWS
5TH. DIST. HO. CO. MD.
OWNER GILBERT. MOBLEY
24756

AQUARIUS POOLS INC.
P.O. BOX 2680
W. FRIENDS RD 21794
442-2138.
SCALE 1"=100'00"