

OSF
4/19/76 approved F.E.

PERMIT

SEWAGE DISPOSAL SYSTEM

MARYLAND STATE DEPARTMENT OF HEALTH

HOWARD COUNTY

INDEXED

ELLICOTT CITY

DISTRICT 5th

DATE 4/2/76

P 2307/
A 17507

Pat Londrim

IS PERMITTED TO INSTALL X ALTER

ADDRESS 14010 Forsythe Road, Sykesville, Maryland 21784 PHONE 442-2416

A SEWAGE DISPOSAL SYSTEM LOCATED AT

SUBDIVISION Clarksville Meadows ROAD 6735 Whitegate Road LOT Parcel B

PROPERTY OWNER Mr. and Mrs. Gilbert Nobley

ADDRESS Woodward Road, Savage, Maryland Phone: 792-0090

SPECIFICATIONS 4 bedrooms

DRAIN FIELD DEPTH FEET, BOTTOM AREA SQ. FT.

SEEPAGE PITS ABSORBENT SIDE-WALL AREA SQ. FT.

SEPTIC TANK CAPACITY 1250 GALLONS

FOR GARBAGE GRINDER, INCREASE DISPOSAL AREA 22% & TANK CAPACITY 50%

OTHER Dry well - 480 sq. ft. sidewall area below the inlet with the inlet no deeper than 4 ft. and the bottom of the dry well no deeper than 12 ft. Place the dry well 179 ft. from

the lot line which is 526.29 ft. long and 200 ft. from the lot line which is 525.00 ft. long.

NOTE: ALL PIPE FROM HOUSE TO DISPOSAL AREA MUST BE CAST IRON.

PERMIT VOID AFTER THREE YEARS.

NOTE: INSTALL STAND PIPE ON SEPTIC TANK AND DRY WELL. STAND PIPE MUST BE 6" IN DIA., CAST IRON, CONCRETE OR TERRA COTTA ACCEPTED.


PLANS APPROVED BY Raymond Hodges

DATE 6/24/74

FILL SEPTIC TANK AND DISTRIBUTION BOX WITH WATER BEFORE CALLING FOR AN INSPECTION. COVER NO WORK UNTIL INSPECTED AND APPROVED.

NEITHER THE HOWARD COUNTY COMMISSIONERS NOR THE HEALTH DEPARTMENT IS RESPONSIBLE FOR THE SUCCESSFUL OPERATION OF ANY SYSTEM.

A 17507

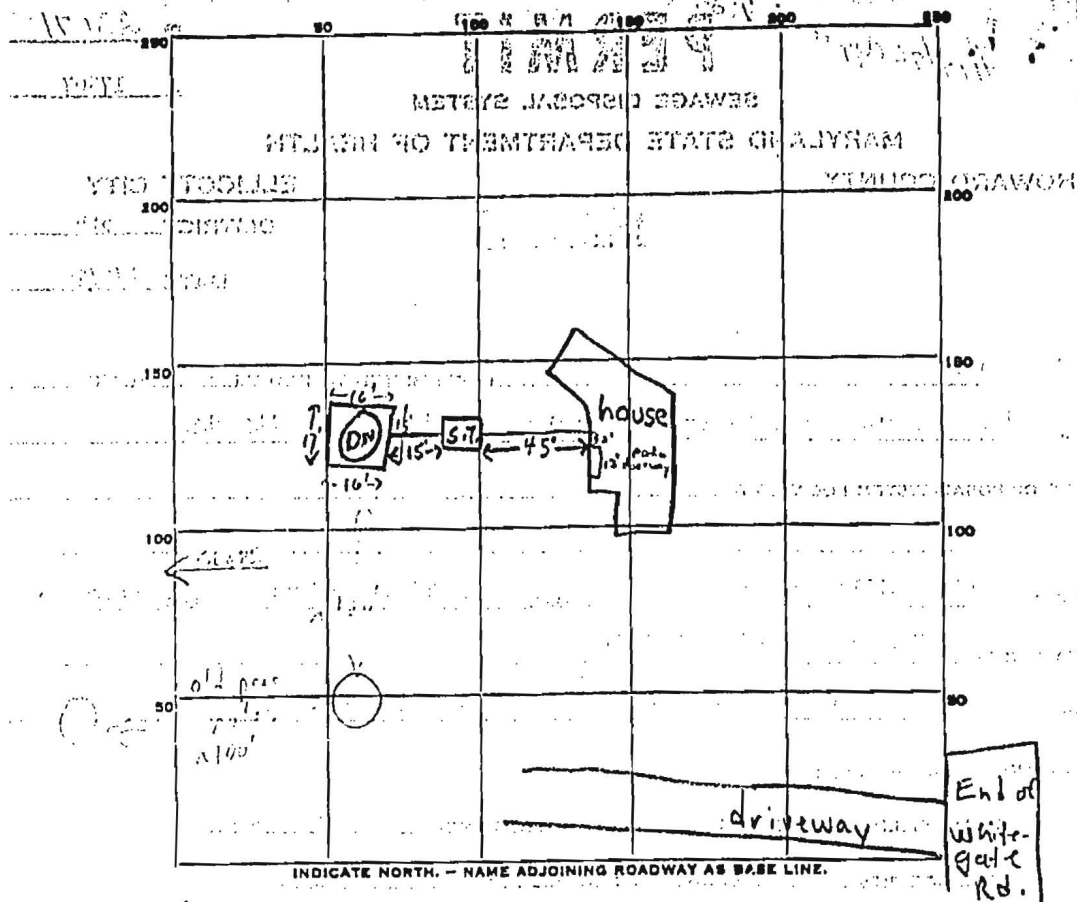

PERMIT CARD verbal approval to proceed site D.W. | S.T.
 SEPTIC TANK, LEVEL ✓ 1250 gal. CLEANOUTS O.K. | O.K.
 DISTRIBUTION BOX, LEVEL _____
 TILE FIELD, DEPTH _____ FT. TRENCH WIDTH _____ FT.
 GRAVEL DEPTH _____ IN. TOTAL LENGTH _____ FT.
 NUMBER OF TRENCHES _____ TOTAL BOTTOM AREA _____
 OUTSIDE PERIMETER 64 FT. DEPTH BELOW INLET 8 FT.
 ABSORBENT AREA ± 512 SQ. FT.
 REMARKS 4/19/76 Drywell location O.K. old perc. holes for d.w. & s.t.

DATE SYSTEM APPROVED 4/19/76 INSPECTOR F Skinner