



Walk Thru Building Permit Application

Howard County Maryland
Department of Inspections, Licenses and Permits
3430 Court House Drive
Permits: 410-313-2455
www.howardcountymd.gov

Date Received: _____

Permit No.: _____

Building Address: 1945 SYCAMORE SPRING CT
City: COOKSVILLE State: MD Zip Code: 21723
Suite/Apt. # _____ SDP/WP/BA #: _____
Census Tract: _____ Subdivision: _____
Section: _____ Area: _____ Lot: _____
Tax Map: 0008 Parcel: 0096 Grid: 0022
Zoning: _____ Map Coordinates: _____ Lot Size: _____

Existing Use: _____
Proposed Use: _____
Estimated Construction Cost: \$ 50,000.-
Description of Work: BUILD IN GROUND CONCRETE
Swimming Pool
Occupant or Tenant: _____
Was tenant space previously occupied? ☐ Yes ☐ No
Contact Name: _____
Address: _____
City: _____ State: _____ Zip Code: _____
Phone: _____ Fax: _____
Email: _____

Commercial Building Characteristics	Residential Building Characteristics
Height:	<input type="checkbox"/> SF Dwelling <input type="checkbox"/> SF Townhouse
No. of stories:	<u>Depth</u> <u>Width</u>
Gross area, sq. ft./floor:	1 st floor:
	2 nd floor:
Area of construction (sq. ft.):	Basement:
	<input type="checkbox"/> Finished Basement
Use group:	<input type="checkbox"/> Unfinished Basement
	<input type="checkbox"/> Crawl Space
<u>Construction type:</u>	<input type="checkbox"/> Slab on Grade
<input type="checkbox"/> Reinforced Concrete	No. of Bedrooms:
<input type="checkbox"/> Structural Steel	<u>Multi-family Dwelling</u>
<input type="checkbox"/> Masonry	No. of efficiency units:
<input type="checkbox"/> Wood Frame	No. of 1 BR units:
<input type="checkbox"/> State Certified Modular	No. of 2 BR units:
	No. of 3 BR units:
	Other Structure:
	Dimensions:
<input checked="" type="checkbox"/> <u>Roadside Tree Project Permit</u>	Footings:
<input type="checkbox"/> Yes <input type="checkbox"/> No	Roof:
<u>Roadside Tree Project Permit #</u>	<input type="checkbox"/> State Certified Modular
	<input type="checkbox"/> Manufactured Home

Property Owner's Name: MISTY MORENO
Address: 1945 SYCAMORE SPRING CT
City: COOKSVILLE State: MD Zip Code: 21723
Phone: _____ Fax: _____
Email: _____
Applicant's Name & Mailing Address, (If other than stated herein)
Applicant's Name: TATE Galloway
Address: 11710 OLD FREDERICK RD
City: MARBLETSVILLE State: MD Zip Code: 21104
Phone: 410-442-5805 Fax: Galloway.Paul@AOL.com
Email: _____

Contractor Company: Galloway Pools
Contact Person: TATE Galloway
Address: 11710 OLD FREDERICK RD
City: MARBLETSVILLE State: MD Zip Code: 21104
License No.: _____
Phone: 410-442-5805 Fax: _____
Email: _____

Engineer/Architect Company: _____
Responsible Design Prof.: _____
Address: _____
City: _____ State: _____ Zip Code: _____
Phone: _____ Fax: _____
Email: _____

Utilities	
<u>Water Supply</u>	
<input type="checkbox"/> Public	
<input checked="" type="checkbox"/> Private	
<u>Sewage Disposal</u>	
<input type="checkbox"/> Public	
<input checked="" type="checkbox"/> Private	
Electric: <input checked="" type="checkbox"/> Yes <input type="checkbox"/> No	
Gas: <input type="checkbox"/> Yes <input checked="" type="checkbox"/> No	
<u>Heating System</u>	
<input checked="" type="checkbox"/> Electric <input type="checkbox"/> Oil	
<input type="checkbox"/> Natural Gas <input type="checkbox"/> Propane Gas	
<input type="checkbox"/> Other:	
<u>Sprinkler System:</u>	
<input type="checkbox"/> Yes <input type="checkbox"/> No	
<u>Grading Permit Number:</u>	
<u>Building Shell Permit Number:</u>	

THE UNDERSIGNED HEREBY CERTIFIES AND AGREES AS FOLLOWS: (1) THAT HE/SHE IS AUTHORIZED TO MAKE THIS APPLICATION; (2) THAT THE INFORMATION IS CORRECT; (3) THAT HE/SHE WILL COMPLY WITH ALL REGULATIONS OF HOWARD COUNTY WHICH ARE APPLICABLE THERETO; (4) THAT HE/SHE WILL PERFORM NO WORK ON THE ABOVE REFERENCED PROPERTY NOT SPECIFICALLY DESCRIBED IN THIS APPLICATION; (5) THAT HE/SHE GRANTS COUNTY OFFICIALS THE RIGHT TO ENTER ONTO THIS PROPERTY FOR THE PURPOSE OF INSPECTING THE WORK PERMITTED AND POSTING NOTICES.

Applicant's Signature

Email Address

Title/Company

Print Name

Date

Checks Payable to: DIRECTOR OF FINANCE OF HOWARD COUNTY

PLEASE WRITE NEATLY & LEGIBLY

-FOR OFFICE USE ONLY-

AGENCY	DATE	SIGNATURE OF APPROVAL
State Highways		
Building Officials		
PSZA (Zoning)		
PSZA (Engineering)		
Health		

Is Sediment Control approval required for issuance? ☐ Yes ☐ No
☐ CONTINGENCY CONSTRUCTION START

DPZ SETBACK INFORMATION
Front:
Rear:
Side:
Side St.:
All minimum setbacks met? <input type="checkbox"/> Yes <input type="checkbox"/> No
Is Entrance Permit Required? <input type="checkbox"/> Yes <input type="checkbox"/> No
Historic District? <input type="checkbox"/> Yes <input type="checkbox"/> No
Lot Coverage for New Town Zone:
SDP/Red-line approval date:

Filing Fee	\$
Permit Fee	\$
Tech Fee	\$
Excise Tax	\$
PSFS	\$
Guaranty Fund	\$
Add'l per Fee	\$
Total Fees	\$
Sub-Total Paid	\$
Balance Due	\$
Check	#


Distribution of Copies: White: Building Officials

Green: PSZA,Zoning

Yellow: PSZA,Engineering


Pink: Health

Gold: SHA

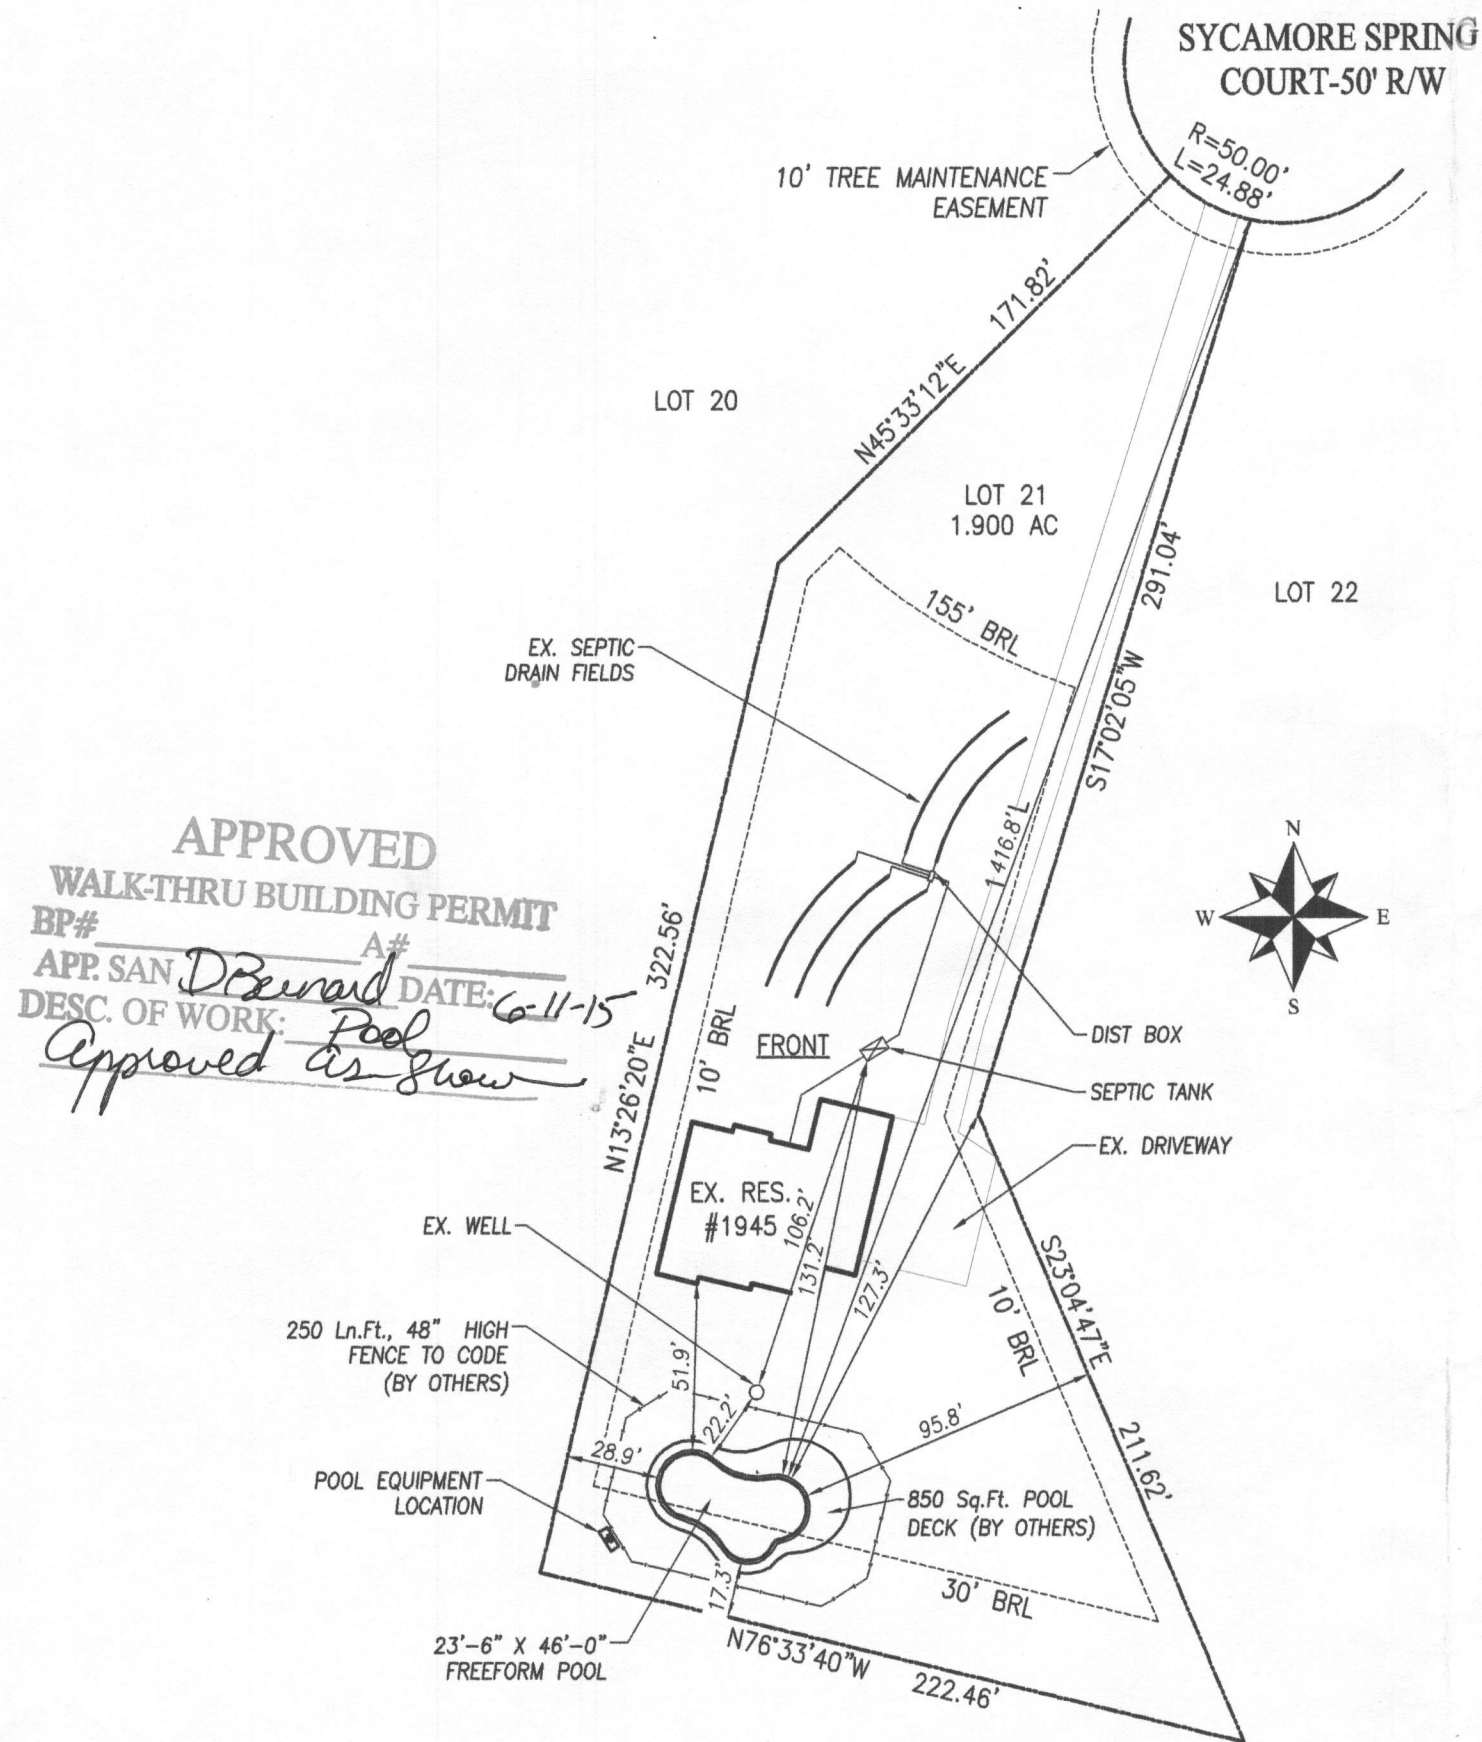

APPROVED
WALK-THRU BUILDING PERMIT
BP# _____ A# _____
APP. SAN. *DBernard* DATE: *6-11-15*
DESC. OF WORK: *Pool*
Approved as shown

VICINITY MAP

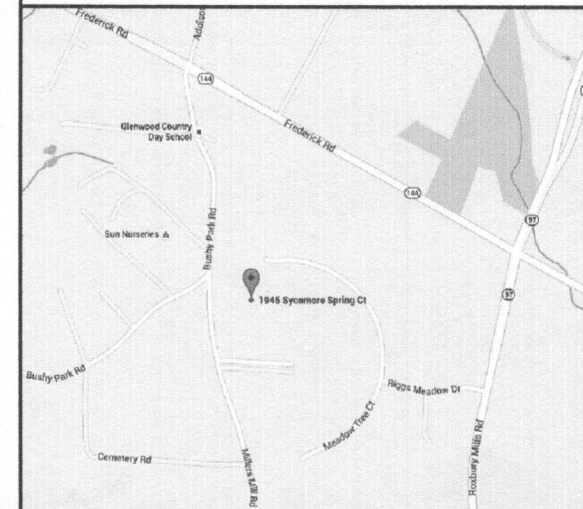

DIRECTIONS TO SITE

I-70 WEST TO EXIT 76, RT-97 SOUTH TOWARD OLNEY. FOLLOW ½ MILE TO R/T ON RIGGS MEADOW DR. FOLLOW TO R/T ON SYCAMORE SPRING COURT. FOLLOW TO SITE AT END ON LEFT. 1945 SYCAMORE SPRING COURT.

POOL DATA

DIMENSIONS	23'-6" X 46'-0" BAHIA
PERIMETER	119 Ln.Ft.
SURFACE AREA	800 Sq.Ft.
GALLONAGE	33,000 Gallons
DEPTHS	3'-6" TO 5'-0" TO 8'-6"
FILTER RATE	69 GPM
TURNOVER TIME	8 HOURS
POOL DECK AREA	850 Sq.Ft.

JOB NOTES

PROPERTY OWNER: MISTY MORENO
PROPERTY OWNER ADDRESS: 1945 SYCAMORE SPRING COURT
COOKSVILLE, MD 21723

HOME PHONE:
OFFICE PHONE:
CELL PHONE:

LOT NUMBER: 21
SUBDIVISION NAME: RIGGS MEADOW
TAX MAP: 8
GRID & PARCEL: GRID 22, PARCEL 96
TAX ACCOUNT NUMBER: 360389

ELECTION DISTRICT: 4

ZONING:

UTILITIES: PRIVATE WELL & PRIVATE SEPTIC

SITE PLAN

REVISIONS

Galloway Pool Service, Inc.

11710 Old Frederick Road
Mariottsville, Maryland 21104

410-442-5005 (P)
866-000-0000 (F)
443-506-7043 (C)

Tieman Residence

1945 Sycamore Spring Court
Cooksville, Maryland 21723
4th Election District, Howard County

Date: 6/10/2015

Scale: 1"=60'

Drawn: JEK

Job: GPS2015-0118

Sheet: Of:

1

1