


LANDTECH ASSOCIATES, INC.

4100 RAIN HIGHWAY N.W. SUITE 7B GLEN BURNIE, MD 21061
410 768-2121 FAX 410 553-9081
NOTE: NOT TO BE USED FOR THE ISSUANCE OF PERMITS.

REVISED
Date: 6/10/15
Comments: B14001163
CHANGE DECK SIZE
FROM 20'x46' TO
30'x48'

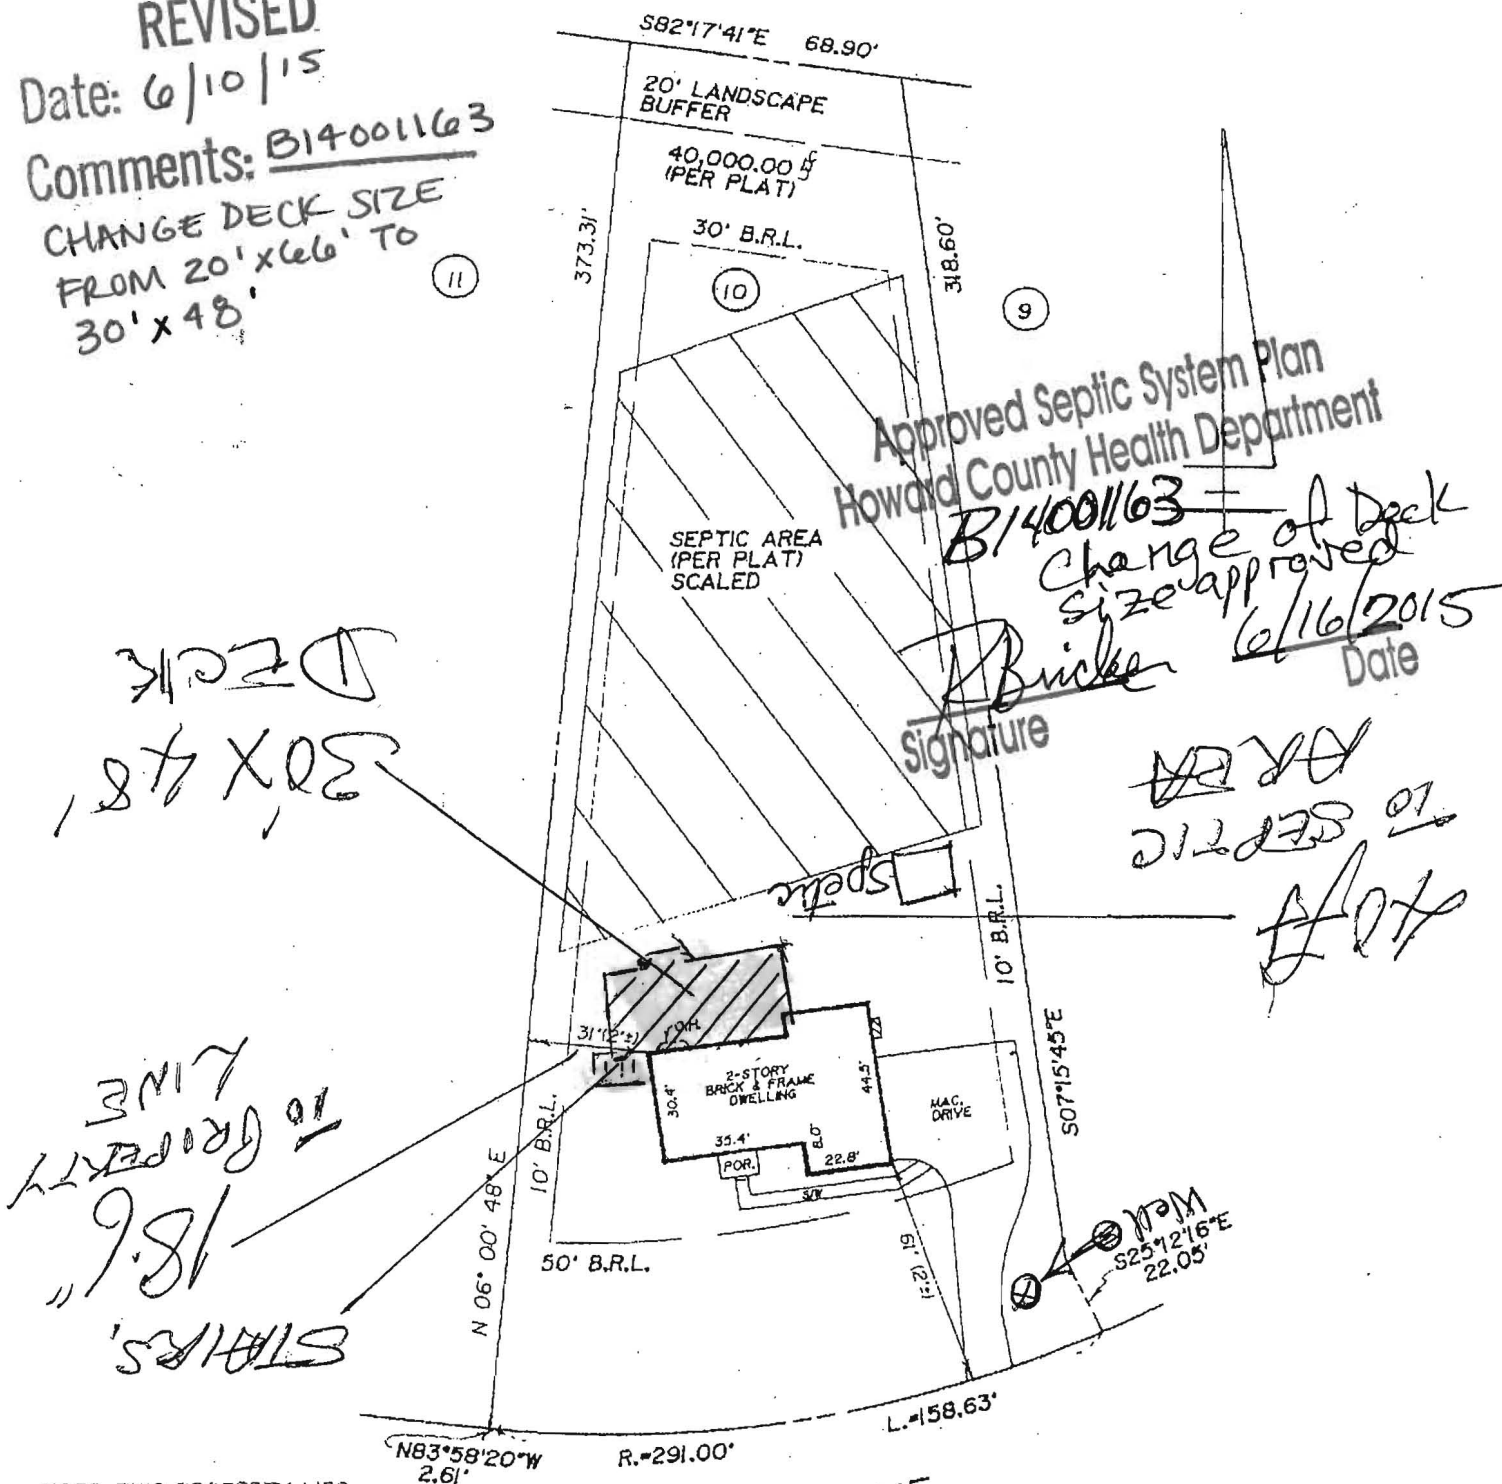

NOTE: THIS PROPERTY LIES IN FLOOD ZONE C, AN AREA OF MINIMAL FLOODING, AS DELINEATED ON THE MAPS OF THE NATIONAL FLOOD INSURANCE PROGRAM

PRESTWICK DRIVE

Notes:

- 1) This plat is of benefit to a consumer only insofar as it is required by a lender or a title insurance company or its agent in connection with contemplated transfer, financing or re-financing
- 2) This plat is not to be relied upon for the establishment or location of fences, garages, buildings, or other existing or future improvements.
- 3) This plat does not provide for the accurate identification of property boundary lines, but such identification may not be required for the transfer of title or securing financing or refinancing
- 4) No title report furnished

Certification: This is to certify that the improvements indicated hereon are located as shown

GRADEN A. ROGERS - Propri. L.S. MD Lic. No. 119

LIBER 1 FOLIO

LOT 10 BLOCK SECT PLAT

PLAT ENTITLED WINDY KNOLLS

RECORDED IN HOWARD CO.

PLAT BOOK 12228 FOLIO

6441 PRESTWICK DRIVE

SCALE 1"=50' CASE NO. 2100846R

DATE 3-29-2001 JOB NO. TW-101105

Name: Geoffrey Kiragin
Street Address: 6441 RICHARDSON FARM LANE
City, State, Zip: CLARKSVILLE MD, 21029
Date: 6/10/15

Amendment, Permit # B14001163

Ms. Debbie Whalen
Division of Plan Review
Department of Inspections, Licenses and Permits
Howard County Government
3430 Court House Dr
Ellicott City, MD 21043

RECEIVED

JUN 10 2015

LICENSES & PERMITS
DIVISION

Dear Ms. Whalen:

I am requesting to amend Permit # B14001163 at
6441 RICHARDSON FARM LANE to
CHANGE FROM 20X66 DECK TO
30 X 48 DECK 'AS BUILT'

Enclosed:

☒ Fee: 25.00 INV # 404711
☒ Plot Plans MO # 47-023059565
☐ Sets of Construction Drawings
☐ Other: _____

If there is anything we can do to assist you, please let me know.

Sincerely,

CC: DPZ
Heath

Revision approved
6/16/2015

Name: Geoffrey Kiragin
Title: owner
Phone: 240-277-2027
Email: gkiragin@fisstaffing.com

MAIL TO OWNER

Amendment Letter