

Bureau of Environmental Health
7178 Gateway Drive Columbia, MD 21046
(410) 313-2640 Fax (410) 313-2648
TDD (410) 313-2323 Toll Free 1-866-313-6300
website: www.hchealth.org

Maura J. Rossman, M.D., Acting Health Officer

APPLICATION

FOR PERCOLATION TESTING AND SITE EVALUATION

A545115

PROPERTY LOCATION

SUBDIVISION/PROPERTY NAME _____ LOT # _____

PROPERTY ADDRESS 14647 Roxbury RD Glencely ZIP _____
STREET TOWN

TAX ACCOUNT # _____ TAX MAP _____ GRID _____ PARCEL _____ ZONING DESIGNATION _____

PROPERTY OWNER(S) Bill Brum

DAYTIME PHONE 410 489-9197 CELL 443 474 5998 EMAIL _____

MAILING ADDRESS 14647 Roxbury RD Glencely MD ZIP _____
STREET CITY, STATE

APPLICANT Hatfield's Equipment RELATIONSHIP TO OWNER: contractor

DAYTIME PHONE 301-490-4289 CELL 410-984-0077 EMAIL _____

MAILING ADDRESS PO Box 519 Annapolis Junction MD 20701 ZIP _____
STREET CITY, STATE

I HEREBY APPLY FOR THE NECESSARY TESTING/EVALUATION PRIOR TO ISSUANCE OF SEWAGE DISPOSAL SYSTEM PERMIT(S):

BUILDING:

- ☐ RESIDENTIAL WITH 3 EXISTING OR PROPOSED BEDROOMS IN THE COMPLETED STRUCTURE
☐ COMMERCIAL (PROVIDE DETAIL OF TYPE OF USE AND NUMBERS OF EMPLOYEES/CUSTOMERS ON ACCOMPANYING PLAN)

PROPERTY:

- ☐ SUBDIVISION: NUMBER OF LOTS INCLUDING RESIDUE: _____
☐ CONSTRUCT NEW OSDS ON UNDEVELOPED LOT
☒ REPAIR OR REPLACE FAILING OSDS
☐ UPGRADE EXISTING OSDS

IS THE PROPERTY WITHIN 2500 FEET OF ANY RESERVOIR?

- ☐ YES
☒ NO

AS APPLICANT, I UNDERSTAND THE FOLLOWING:

- THIS APPLICATION IS VALID FOR TWO(2) YEARS FROM DATE OF FEE PAYMENT AND APPROVAL IS BASED UPON HEALTH OFFICER SIGNATURE OF A PERC CERTIFICATION PLAN PRIOR TO EXPIRATION OF THIS PERMIT.
- THE APPLICATION FEE IS NON-REFUNDABLE
- THIS APPLICATION MUST BE ACCOMPANIED BY ALL APPLICABLE FEES AND A SUITABLE SITE PLAN IN ORDER TO BE PROCESSED
- THIS IS A PUBLIC DOCUMENT

I declare and affirm that to the best of my knowledge, the information contained herein is correct. I declare that I am the owner of the property or duly authorized to make this application on behalf of the owner. I agree to comply with all applicable state and county regulations.

By signature of this application, I hereby grant Howard County Health Department officials the right to enter onto the property for the purpose of inspecting the property as directly related to the requested permit/service.

SIGNATURE OF APPLICANT

DATE

8-5-13

A

2.53

- C/Loan

3.5.4

5-5,5

Cl Loan-Sa Loan

Saloon-Loamy Sa
15-2070

13'

14,5

25-30% Rock

③

6.5

Fine Red
Sa Loam

Beige
Loamy Sa

2590

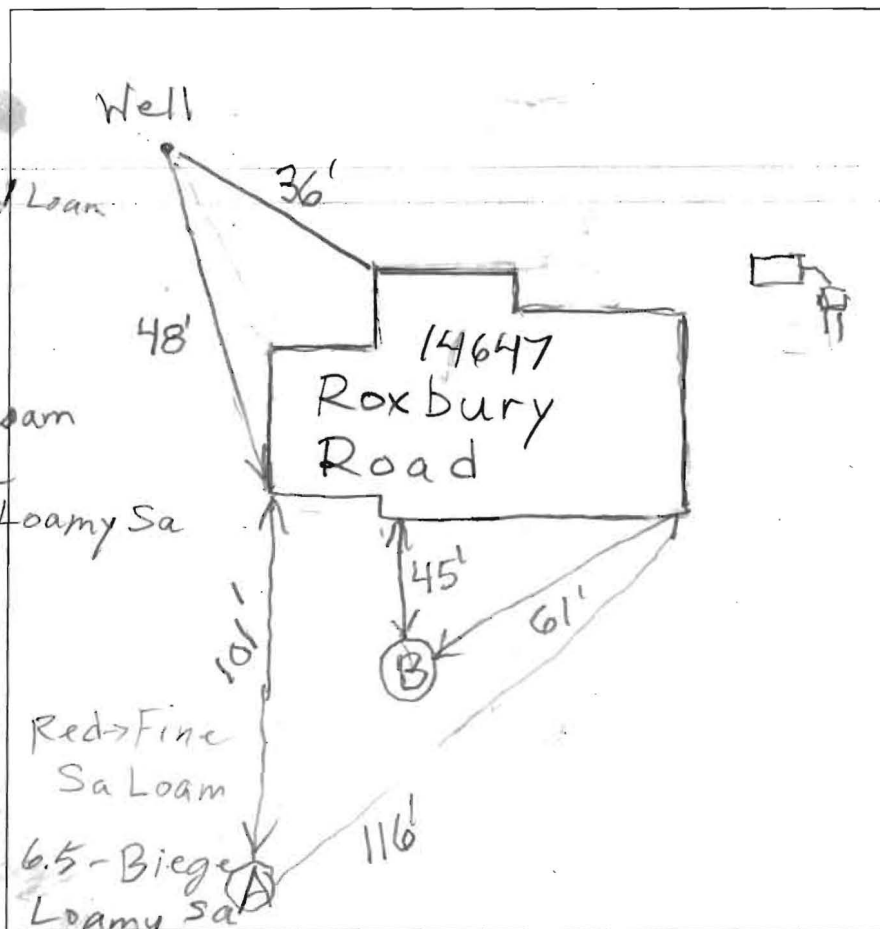
Dark

Rock
very Dark

15% Rat

Deeper

13.5'

[illegible]

REMARKS _____

SANITARIAN	BACKHOE	OTHERS
1	1	1
2	2	2
3	3	3
100	100	100

TEST HOLES USED IN SDA	AVG. PERC TIME	SQ. FT/BR
1		
2		
3		
TRENCH WIDTH _____ INLET DEPTH _____ MAX. BOT DEPTH _____ EFFECTIVE S/W _____