

*Final approval F.S.
4/15/75 - before lunch*

PERMIT

SEWAGE DISPOSAL SYSTEM

P 21349
A 19030

MARYLAND STATE DEPARTMENT OF HEALTH
HOWARD COUNTY

ELLICOTT CITY

DISTRICT 5th

INDEXED

DATE 4/16/75

Jack Fyock

IS PERMITTED TO INSTALL X ALTER

ADDRESS Ten Oaks Road, Glenelg, Maryland PHONE 286-2939

A SEWAGE DISPOSAL SYSTEM LOCATED AT

SUBDIVISION ROAD 3900 Sharp Road LOT

PROPERTY OWNER Charles Howard

ADDRESS 8013 Crest Road, Laurel, Maryland Phone: 776-7439

SPECIFICATIONS 3 bedrooms

DRAIN FIELD DEPTH FEET, BOTTOM AREA SQ. FT.

SEEPAGE PITS ABSORBENT SIDE-WALL AREA SQ. FT.

SEPTIC TANK CAPACITY 1000 GALLONS

FOR GARBAGE GRINDER, INCREASE DISPOSAL AREA 22% & TANK CAPACITY 50%.

OTHER TRENCH - 11 ft. deep, 8 ft. stone, 70 ft. long. Locate trench 150 ft. from rear property line and 20 ft. from right side line as seen from Sharp Road. Call for inspection before gravel is installed.

NOTE: ALL PIPE FROM HOUSE TO DISPOSAL AREA MUST BE CAST IRON.
PERMIT VOID AFTER THREE YEARS. NOTE: INSTALL STANT PIPE ON SEPTIC TANK. STAND PIPES MUST BE 6 INCHES IN DIAMETER. CAST IRON, CONCRETE OR TERPA COTTA ACCEPTED.


PLANS APPROVED BY Robert Torre & Fred Frommelt DATE 10/17/73 & 4/16/75

FILL SEPTIC TANK AND DISTRIBUTION BOX WITH WATER BEFORE CALLING FOR AN INSPECTION. COVER NO WORK UNTIL INSPECTED AND APPROVED.

NEITHER THE HOWARD COUNTY COMMISSIONERS NOR THE HEALTH DEPARTMENT IS RESPONSIBLE FOR THE SUCCESSFUL OPERATION OF ANY SYSTEM.

A-19030

51030

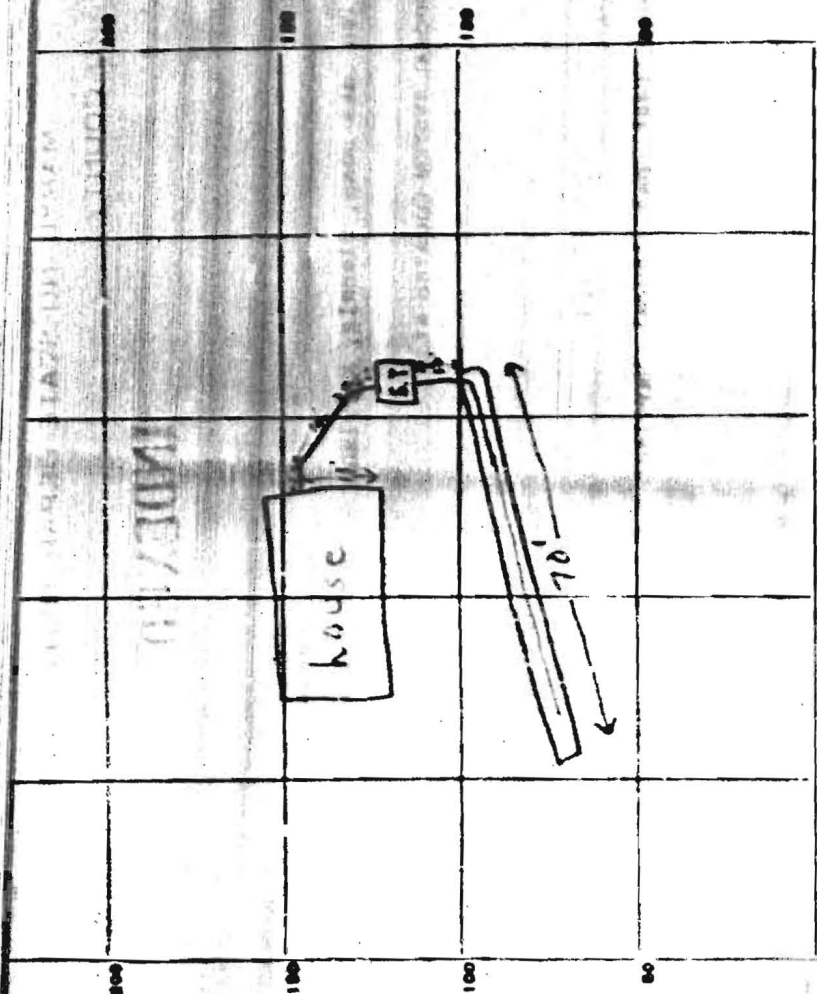

INDICATE NORTH NAME ADJOINING ROADWAY AS BASE LINE.

PERMIT CARD Shady Lane

SEPTIC TANK, LEVEL 1000 gal S.T. CLEANOUTS ✓

DISTRIBUTION BOX, LEVEL ---

TRENCH, DEPTH 11 1/2 FT. TRENCH WIDTH 8 FT.

GRAVEL DEPTH 8 IN. TOTAL LENGTH 70 FT.

NUMBER OF TRENCHES 1 TOTAL BOTTOM AREA 560 sq ft

DEEPAGE PITS, INSIDE DIAMETER --- FT. DEPTH BELOW INLET 8 1/2' min

ABSORBENT AREA 560 SQ. FT. inlet at 3'

REMARKS ---