

APPLICATION

SEWAGE DISPOSAL TESTING

STATE OF MARYLAND - DEPARTMENT OF HEALTH AND MENTAL HYGIENE

A 30497

P _____

HOWARD COUNTY HEALTH DEPARTMENT
ENVIRONMENTAL HEALTH SERVICES

P.O. BOX 476 ELLICOTT, MARYLAND 21043
TELEPHONE: 992-2330

*Septic tank 3 bedroom - 1000 gal.
4 bedroom 1250 gal.*

DISTRICT FIFTH

DATE JAN. 20, 1980

*Dry well - 150 sq ft asphalt sidewalk
area per bedroom to begin just 4 ft of
original grade. Max depth permitted for DW is 11 ft below
original grade.*

*Place DW 25 ft from the 309.2' part of rear lot
line (S54°54'00"E) and 195 ft from left sideline 681.70'
(N30°49'14"E)*

TO: THE COUNTY HEALTH OFFICER
ELLICOTT CITY, MARYLAND

I, HEREBY, APPLY FOR THE NECESSARY TEST IN ORDER TO CONSTRUCT (OR RECONSTRUCT) A SEWAGE DISPOSAL SYSTEM.

PROPERTY OWNER ABE W. WEISSBRODT

ADDRESS 1614 - 20TH STREET N.W. WASH. D.C. 20009 PHONE 461 2857

PROPERTY LOCATION:

SUBDIVISION PROPERTY OF ABE WEISSBRODT LOT NO. 1

ROAD AND DESCRIPTION 3800'± NORTH EAST FROM INTERSECTION OF HOWARD ROAD AND
TEN OAKS ROAD SEE ATTACHED SKETCH

SIZE OF LOT 6.947 Ac.± TYPE BLDG. SINGLE FAMILY

THE SYSTEM INSTALLED UNDER THIS APPLICATION IS ACCEPTABLE ONLY UNTIL PUBLIC FACILITIES BECOME AVAILABLE.

I FULLY UNDERSTAND THE FEE CONNECTED WITH THE FILING OF THIS PERC TEST APPLICATION IS NON-REFUNDABLE UNDER

ANY CIRCUMSTANCES.

SIGNATURE OF APPLICANT Chas. J. Crow

APPROVED BY J. Stayer FOR drywell DATE 2/26/80

REJECTED BY _____ FOR _____ DATE _____

HOLD PENDING FURTHER TESTS _____ DATE _____

REASONS FOR REJECTION OR HOLDING 1/25/80 Hold - cancelled @ site by Mr. Crow
No tests done. C.B.D. Heavy snow

THIS IS NOT A PERMIT

TYPE OF SOIL


REMARKS

~~Turned off on Rd #3 - 1st
left lane - road for curve with new plot identified before~~

ALSO PRESENT

DATE	TEST NO	DEPTH	PRE-WET START	STOP	START	TEST - 1" DROP STOP	TIME
2/21/80	15	4	9:44	9:53	9:53	9:57	4
	4D	13	9:49	9:54	9:54	9:58	4
	25	4	10:00	10:08	10:08	10:21	13
	2D	13	10:02	10:05	10:05	10:18	7
	35	4	10:06	- pulled - 25 min wait finish			13
	3D	13	10:10	10:20	10:20	10:33	13
	45	4	10:36	10:45	10:45	11:12	27
	4D	12	10:36	10:43	10:43	10:50	7
	3M	5	10:40	10:47	10:47	11:02	15

INDICATE NORTH - NAME ADJOINING ROADWAY AS BASE LINE.

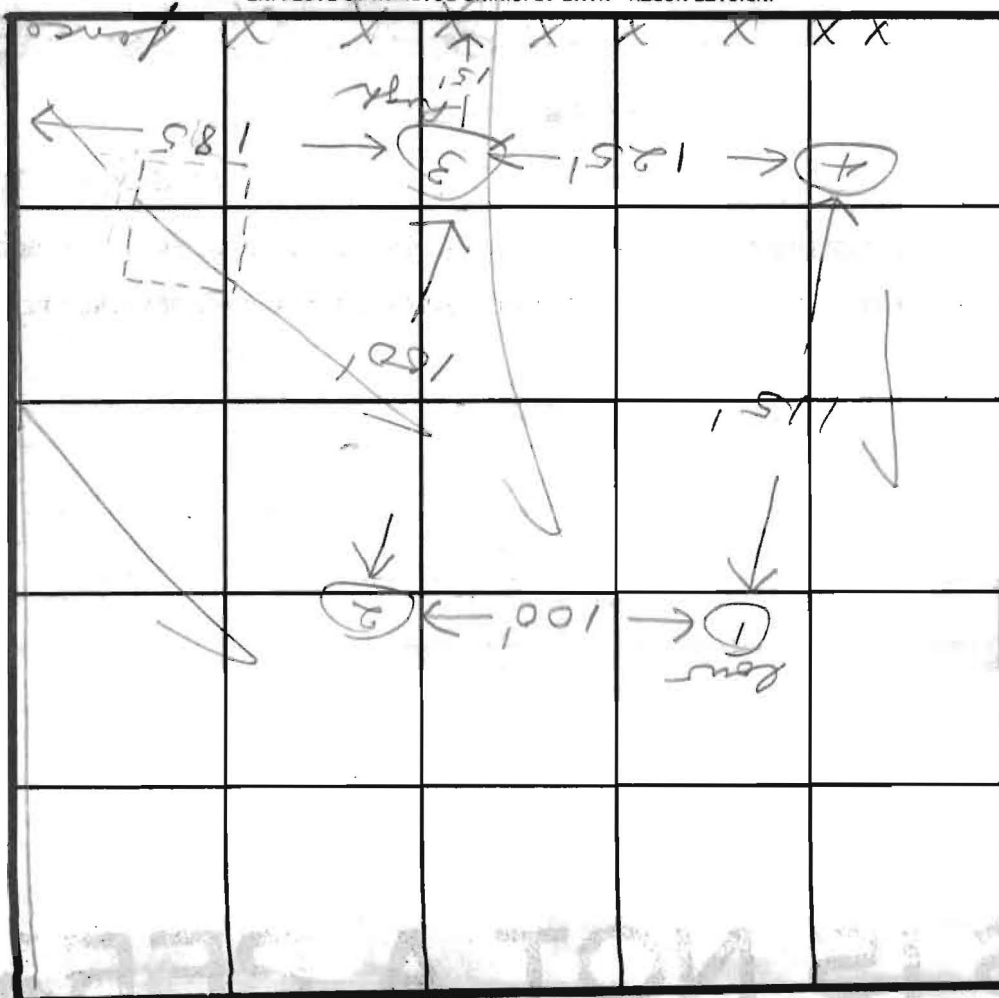

SOIL PROFILE

12

0-3
day, acid
3-13
mucal
indoly form